


EXISTING OVERHEAD HIGH VOLTAGE AND COMMUNICATION LINES IN PROXIMITY TO PROJECT SITE. EXERCISE CAUTION WHEN INSTALLING NEW EQUIPMENT.

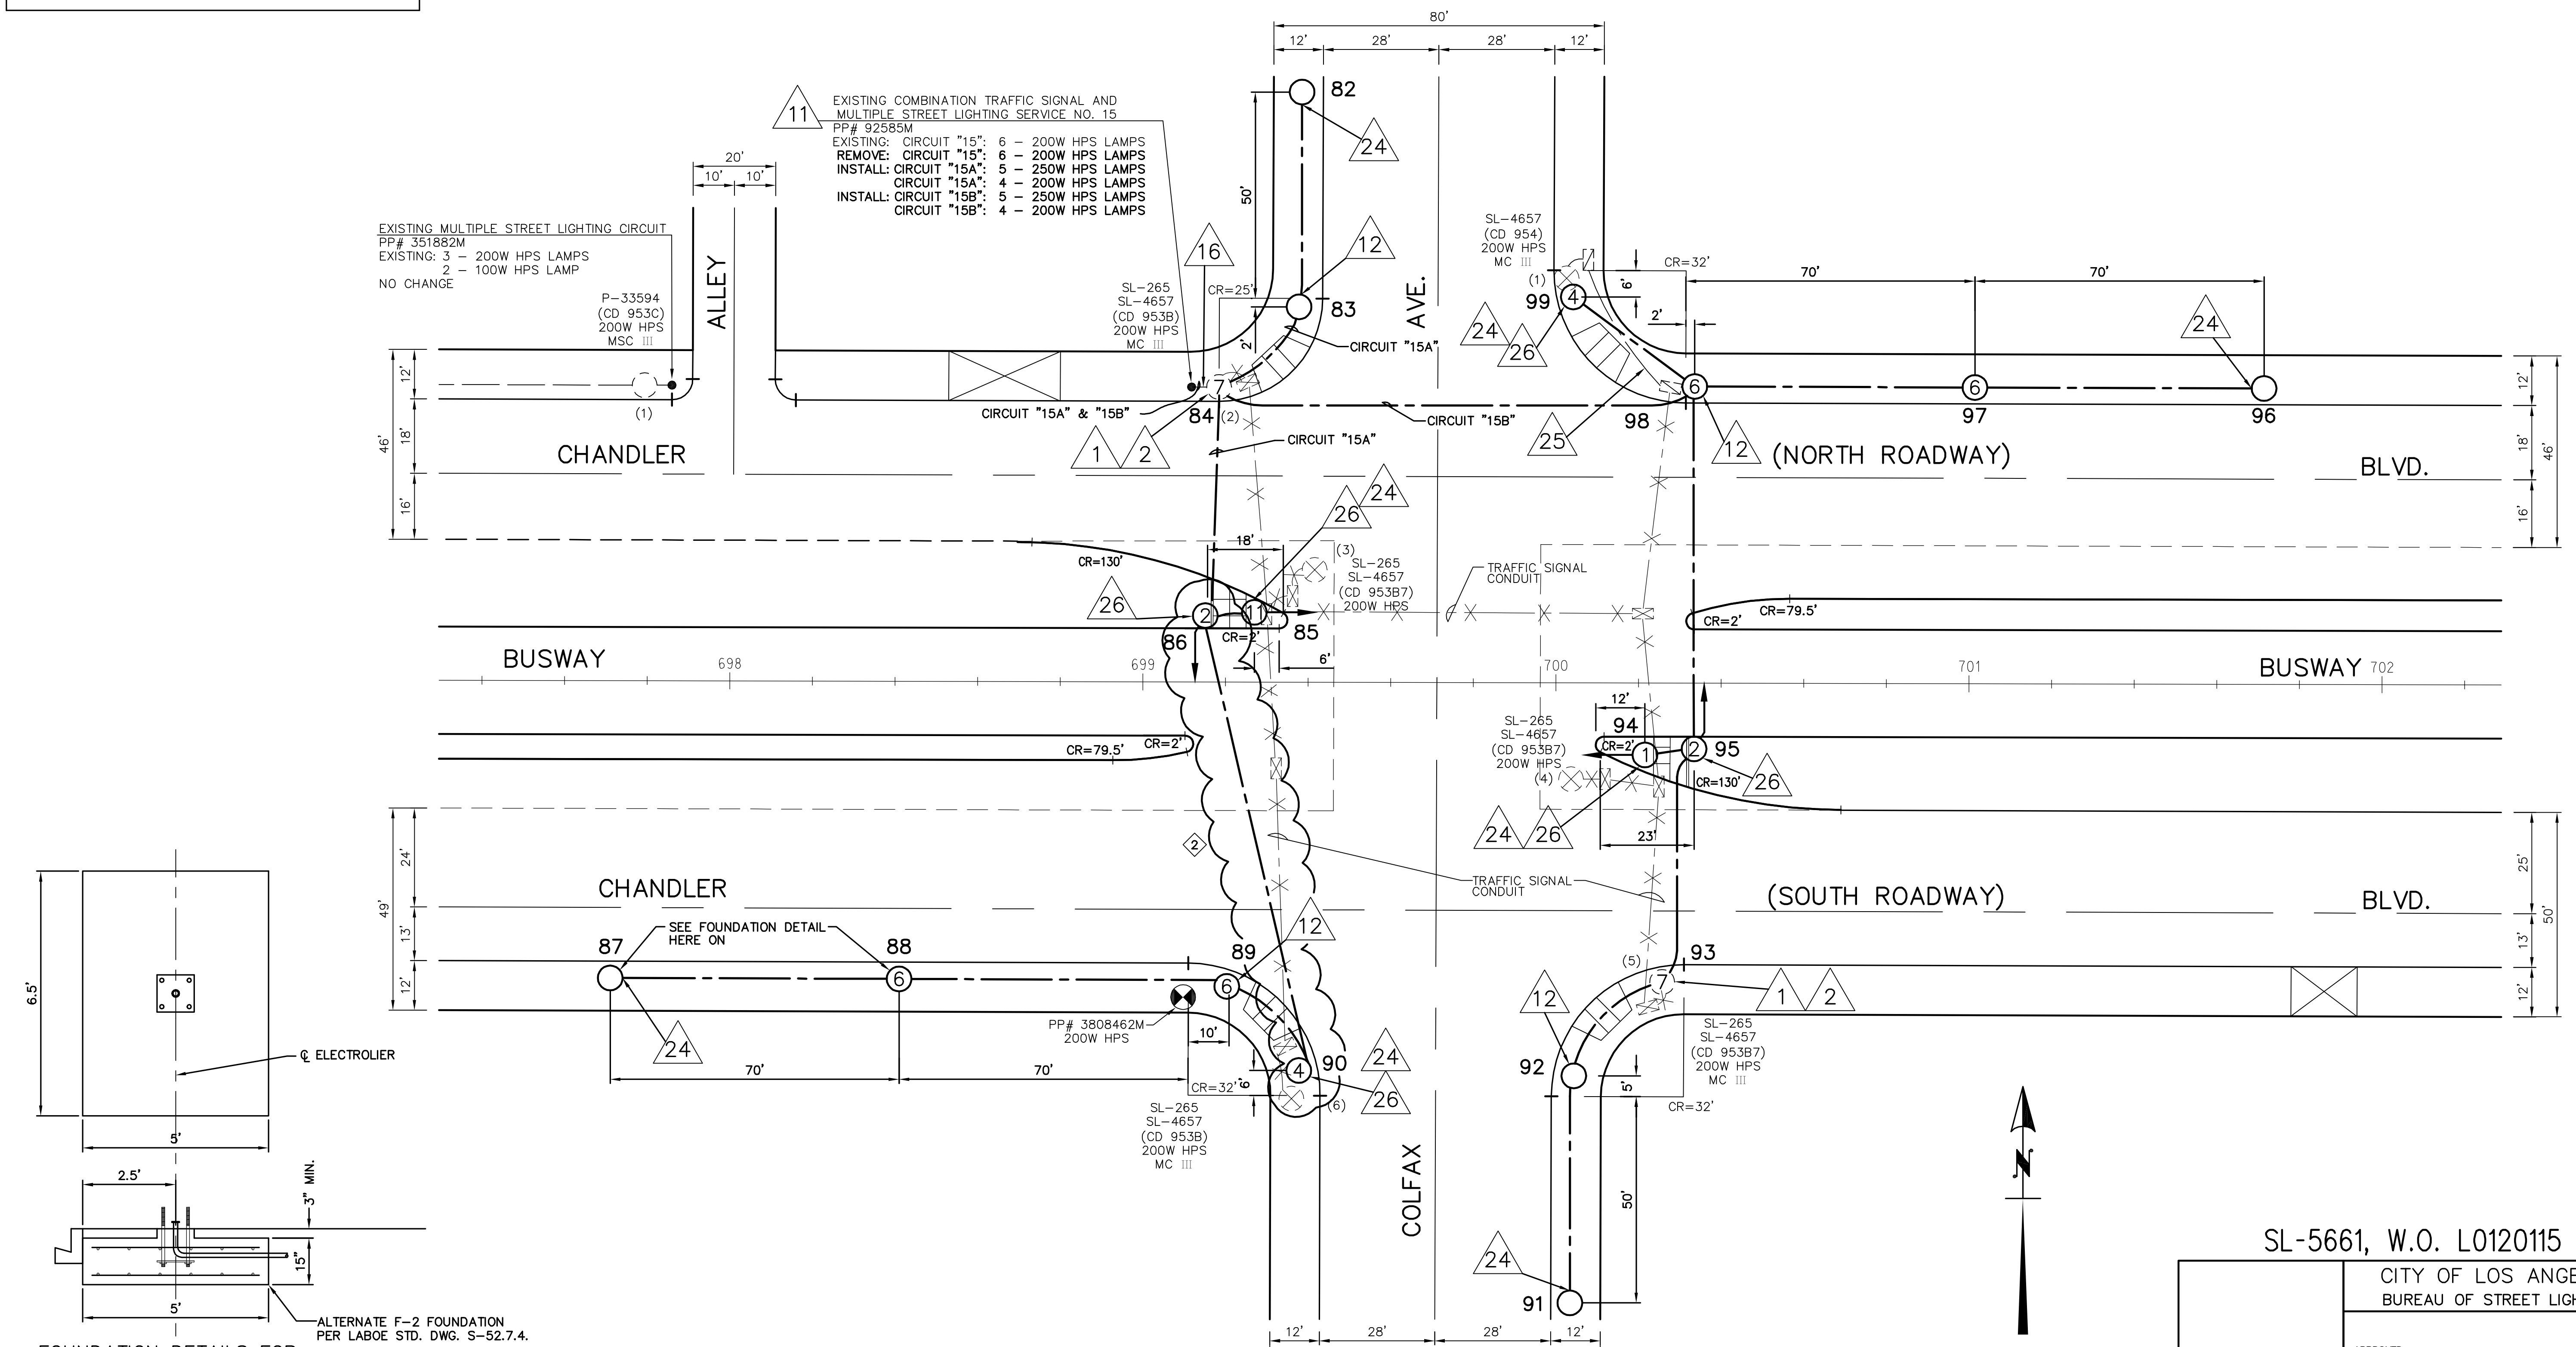

FOUNDATION DETAILS FOR
ELECTROLIERS NO. 87 & 88.
(NO SCALE)

AS-BUILT RECORD DRAWING

SL-5661, W.O. L0120115


CITY OF LOS ANGELES
BUREAU OF STREET LIGHTING

APPROVED _____ 20____

BY _____
DIRECTOR BUREAU OF STREET LIGHTING

2	02-10-06	AXK					AS-BUILT RECORD DRAWING
1	10-15-04	EKO	WJO	52655	12/31/06	WALTER J. OKITSU	CHANGES PER UTILITY CONFLICT - IFC
0	02-26-04	EKO	WJO	52655	12/31/06	WALTER J. OKITSU	ISSUED FOR CONSTRUCTION
REV	DATE	BY	APP	REG NO	EXPIRES	SEAL HOLDER	DESCRIPTION

DESIGNED BY	E. OKITSU
DRAWN BY	J. BERNAL
CHECKED BY	D. YEH
IN CHARGE	W. OKITSU
DATE	

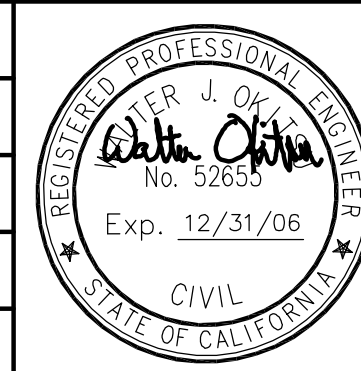

LOS ANGELES COUNTY METROPOLITAN TRANSPORTATION AUTHORITY
SAN FERNANDO VALLEY EAST-WEST BRT PROJECT



 **Katz, Okitsu & Associates**
Traffic Engineers & Transportation Planners
1055 Corporate Center Drive, Suite 300
Monterey Park, California 91754-7642
Tel: (323) 280-4703 Fax: (323) 280-4705

NORTH HOLLYWOOD TO WARNER CENTER
GROUP 1 INTERSECTIONS
RESTORATION STREET LIGHTING
CHANDLER BLVD. & COLFAX AVE.
(SHEET 10 OF 13)

SEGMENT NO C0675	
DRAWING NO G1SL-010	REV 2
SCALE 1" = 20'	
SHEET NO	