

(E) = EXISTING
* For reference only, see Street Lighting sheet
** CIDH PILE Foundation as per Caltrans Standard Plans.

Plan view of the proposed intersection. The diagram shows the intersection of an existing road (top) and a proposed road (bottom). Key features include:

- Stationing:** The existing road has stationing 1+00, 1+20, 1+40, and 1+60. The proposed road has stationing 1+00, 1+20, 1+40, 1+60, 1+80, 2+00, 2+20, 2+40, 2+60, 2+80, 3+00, 11

REGISTERED PROFESSIONAL ENGINEER
DOUG K. YEH
No. 1900
Exp. 06-30-05
TRAFFIC
STATE OF CALIFORNIA

NOTICE TO CONTRACTOR
SEE DWG. NO. C1TS-000A


NOTES :

1. SEMI-ACTUATED OPERATION (ATSAC 2070 CONTROLLER WITH TRANSIT PRIORITY IN 332 CABINET)
 - 01 - CHANDLER BLVD E/B LT
 - 02 - CHANDLER BLVD W/B & N/S PED XING
 - 03 - COLFAX AVE N/B LT (APPROACH)
 - 04 - COLFAX AVE S/B (APPROACH) & W/S PED XING
 - 05 - CHANDLER BLVD W/B LT.
 - 06 - CHANDLER BLVD E/B. & S/S PED XING
 - 07 - COLFAX AVE S/B LT (APPROACH)
 - 08 - COLFAX AVE N/B (APPROACH) & E/S PED XING

OLA (#1 & #8) - COLFAX AVE NB (DEPARTURE)
OLB (#4 & #5) - COLFAX AVE SB (DEPARTURE)
OLC (#3) - COLFAX AVE NB LT (DEPARTURE)
OLD (#7) - COLFAX AVE. SB LT (DEPARTURE)
BRT A - BUSWAY W/B
BRT B - BUSWAY E/B

VICTORY CORRIDOR EAST ATSAC SYSTEM
DIRECT WIRE (CABLE) INTERCONNECT

- 2 REMOVE CONTROLLER, 337 CABINET, TYPE 8 STANDARD AND FOUNDATION; ABANDON CONDUITS.
- 3 INSTALL ATSC 2070 CONTROLLER IN 332 CABINET. THE CONTRACTOR SHALL PROVIDE A COMPLETE FUNCTIONING CONTROLLER ASSEMBLY AND CABINET CONFORMING TO THE LATEST LADOT SPECIFICATION FOR 2070 CONTROLLER. CONTRACTOR TO DELIVER COMPLETELY ASSEMBLED CONTROLLER FOR TESTING TO THE DEPARTMENT OF TRANSPORTATION GENERAL SHOP, PIPER TECHNICAL CENTER, 555 RAMIREZ STREET THIRTY (30) DAYS PRIOR TO INSTALLATION. CONTRACTOR TO PICK UP AND INSTALL CONTROLLER ASSEMBLY ON F-332 FOUNDATION. INSTALL TRANSIT PRIORITY SENSOR UNITS IN THE NEW 332 CABINET.
- 4 REMOVE TRAFFIC SIGNAL EQUIPMENT, STANDARD, AND FOUNDATION. ABANDON CONDUITS.
- 5 REPLACE EXISTING SERVICE WIRES WITH 2 #6 WIRES. INSTALL A 60 AMP FUSE IN AN IN-LINE WATERPROOF FUSEHOLDER IN THE PULLBOX PER LADOT STD. DWG. No. S-79.8. WORK ON ANY ELECTRICAL EQUIPMENT TO BE DONE ONLY IN CONJUNCTION WITH THE DWP PERSONNEL. CONTACT DWP AT (213) 367-3003 SEVEN (7) WORKING DAYS PRIOR TO BEGINNING OF WORK
- 6 INSTALL PV HEAD AT 14' HEIGHT.
- 7 CONTRACTOR SHALL PROVIDE AND INSTALL LARGE STREET NAME SIGN PER LADOT STD. DWGS. No. S-457.0 & S-486.0.
- 8 REMOVE TRAFFIC SIGNAL EQUIPMENT AND STANDARD. REUSE EXISTING FOUNDATION.
- 9 JOIN CONDUIT AND EXTEND TO THE NEW PULLBOX.
- 10 CONTRACTOR TO USE PELCO ASTRO BRACK OR EQUIVALENT TO INSTALL THE 3 SECTION VEHICLE HEAD BACK TO BACK ON THE M.A.

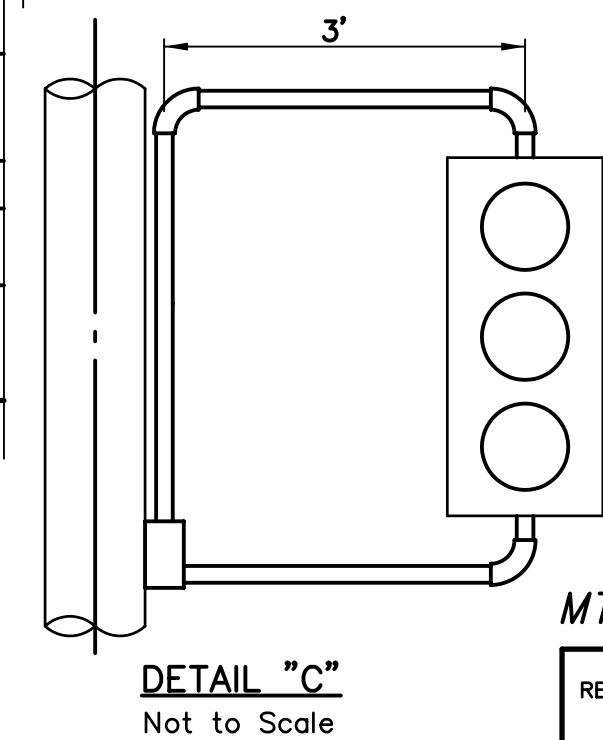

NOTES (CONT'D):

11. INSTALL STRIPING, SIGNS AND PAVEMENT MARKINGS PER LADOT DWG. No. A-3920 FOR THIS PROJECT. REMOVE ALL CONFLICTING STRIPING AND PAVEMENT MARKINGS.
12. SEE STREET LIGHTING SHEET FOR WORK ON STREET LIGHTING FACILITIES.
13. INSTALL TRANSIT PRIORITY LOOPS PER LADOT STD. DWG. No. S-70.1F AND VEHICLE LOOPS PER STD. DWG. No. S-70.1A.
14. ALL NEW VEHICLE AND PEDESTRIAN TRAFFIC SIGNALS SHALL BE LED MODULES, PER LADOT SPECIFICATION 92-088-03 (LATEST EDITION).

AS-BUILT RECORD DRAWING

LOS ANGELES COUNTY METROPOLITAN TRANSPORTATION AUTHORITY
SAN FERNANDO VALLEY EAST-WEST BRT PROJECT

 **WASHINGTON**




Katz, Okitsu & Associates
 Traffic Engineers & Transportation Planners
 1055 Corporate Center Drive, Suite 300
 Monterey Park, California 91754-7642
 Tel: (323) 260-4703 Fax: (323) 260-4705

MTA – SAN FERNANDO VALLEY RAPID BUS SYSTEM (SIGNAL RESTORATION)

REVIEWED <u>June 24, 20 04</u> Ina Van Der Laan Transportation Engineer	RECOMMENDED <u>June 24, 20 04</u> Judy Wong Senior Transportation Engineer	ACCEPTED <u>June 24, 20 04</u> Thomas L. Jones Principal Transportation Engineer			
AS BUILT Date of Installation: <u>11-18-05</u> LADOT Inspector: <u>Algebra</u> Condition As Of: <u>11-18-05</u> LADOT Engineer: <u>J.P.</u> District EAST VALLEY Thomas Guide 562-H12 References ATSCA VICTORY EAST PROJECT			CITY OF LOS ANGELES DEPARTMENT OF TRANSPORTATION WAYNE K. TANDA, GENERAL MANAGER TITLE CHANDLER BLVD.,COLFAX AVE. & BUSWAY File Name 32790-P1.DWG Intersection No. 32790 Project No. 74720 NOTICE: IF PLAN HAS NOT BEEN IMPLEMENTED WITHIN TWO (2) YEARS OF THE ACCEPTANCE DATE, IT MUST BE RESUBMITTED TO LADOT SIGNAL DESIGN SECTION FOR REVIEW AND APPROVAL.		
NORTH HOLLYWOOD TO WARNER CENTER GROUP 1 INTERSECTIONS RESTORATION TRAFFIC SIGNAL CHANDLER BLVD.,COLFAX AVE. AND BUSWAY			SEGMENT NO C-0675 DRAWING NO G1TS-008 SCALE 1" = 20' SHEET NO		