



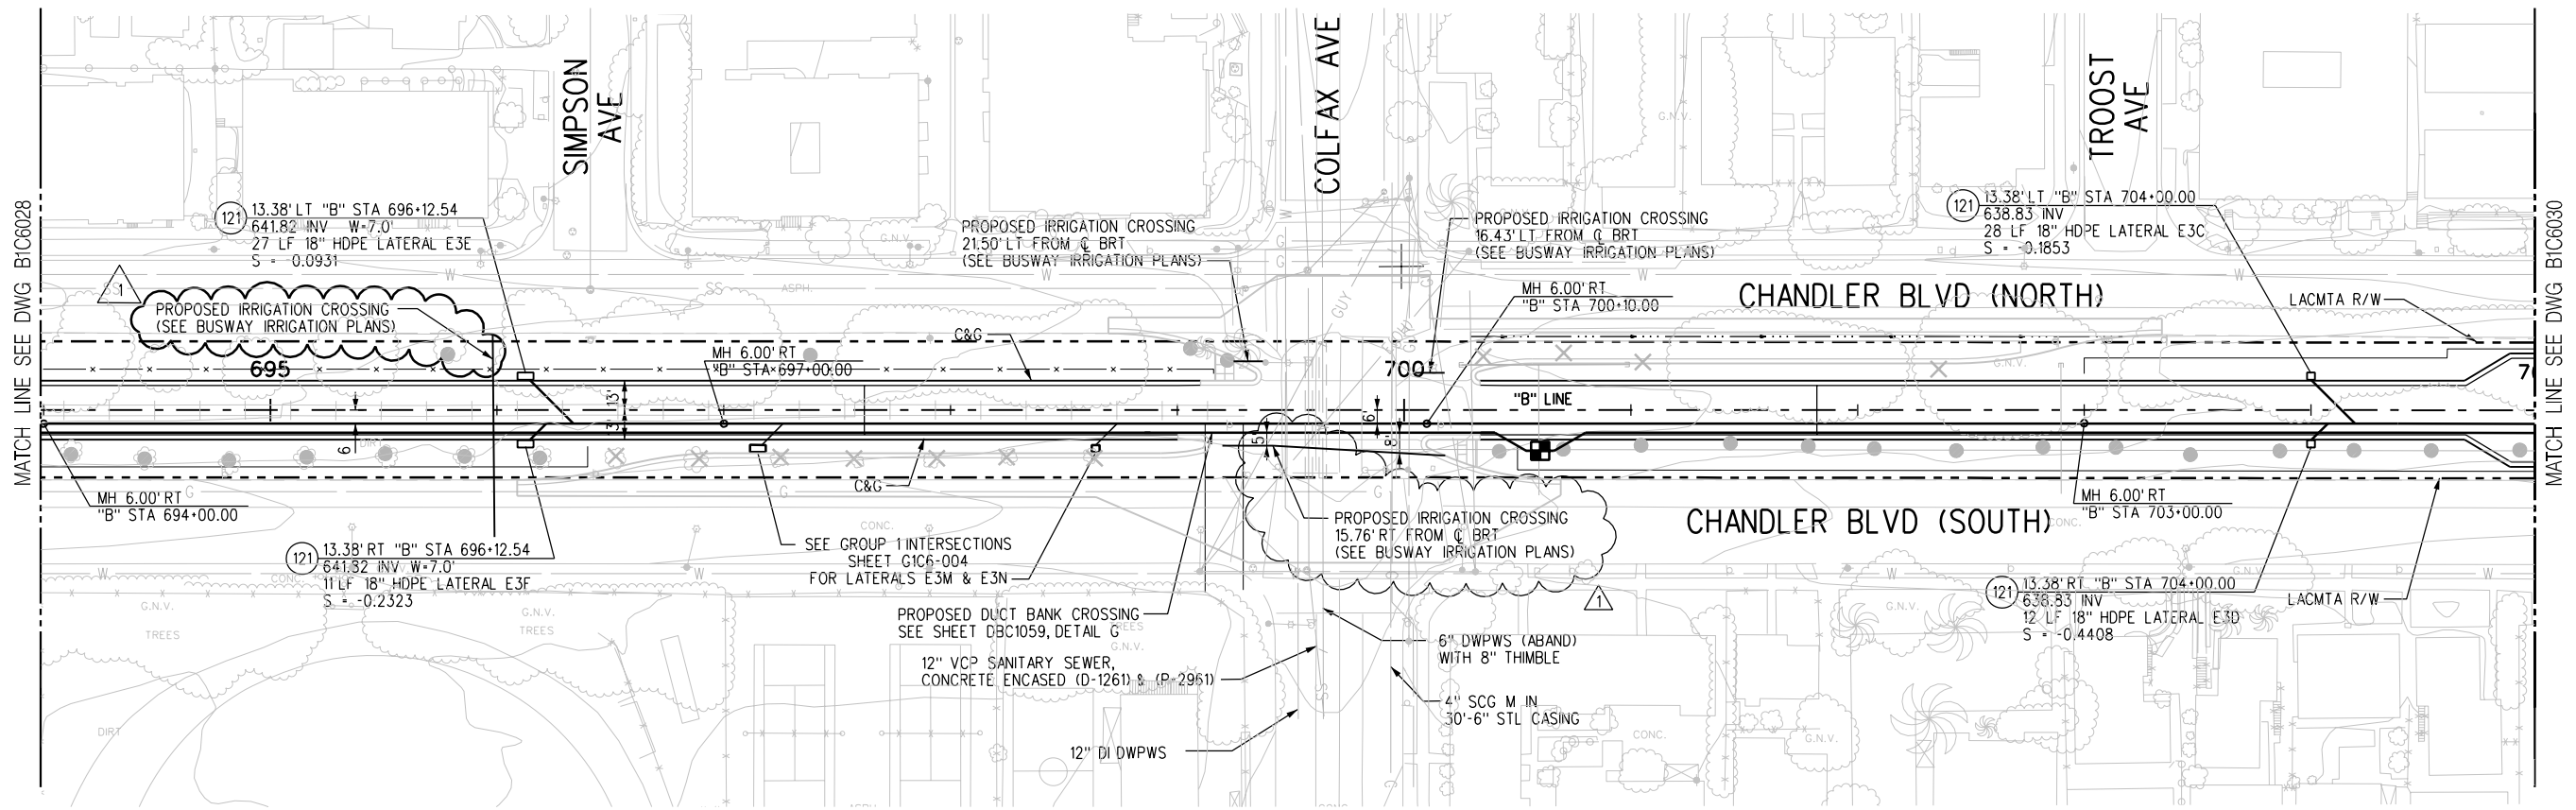

PLAN

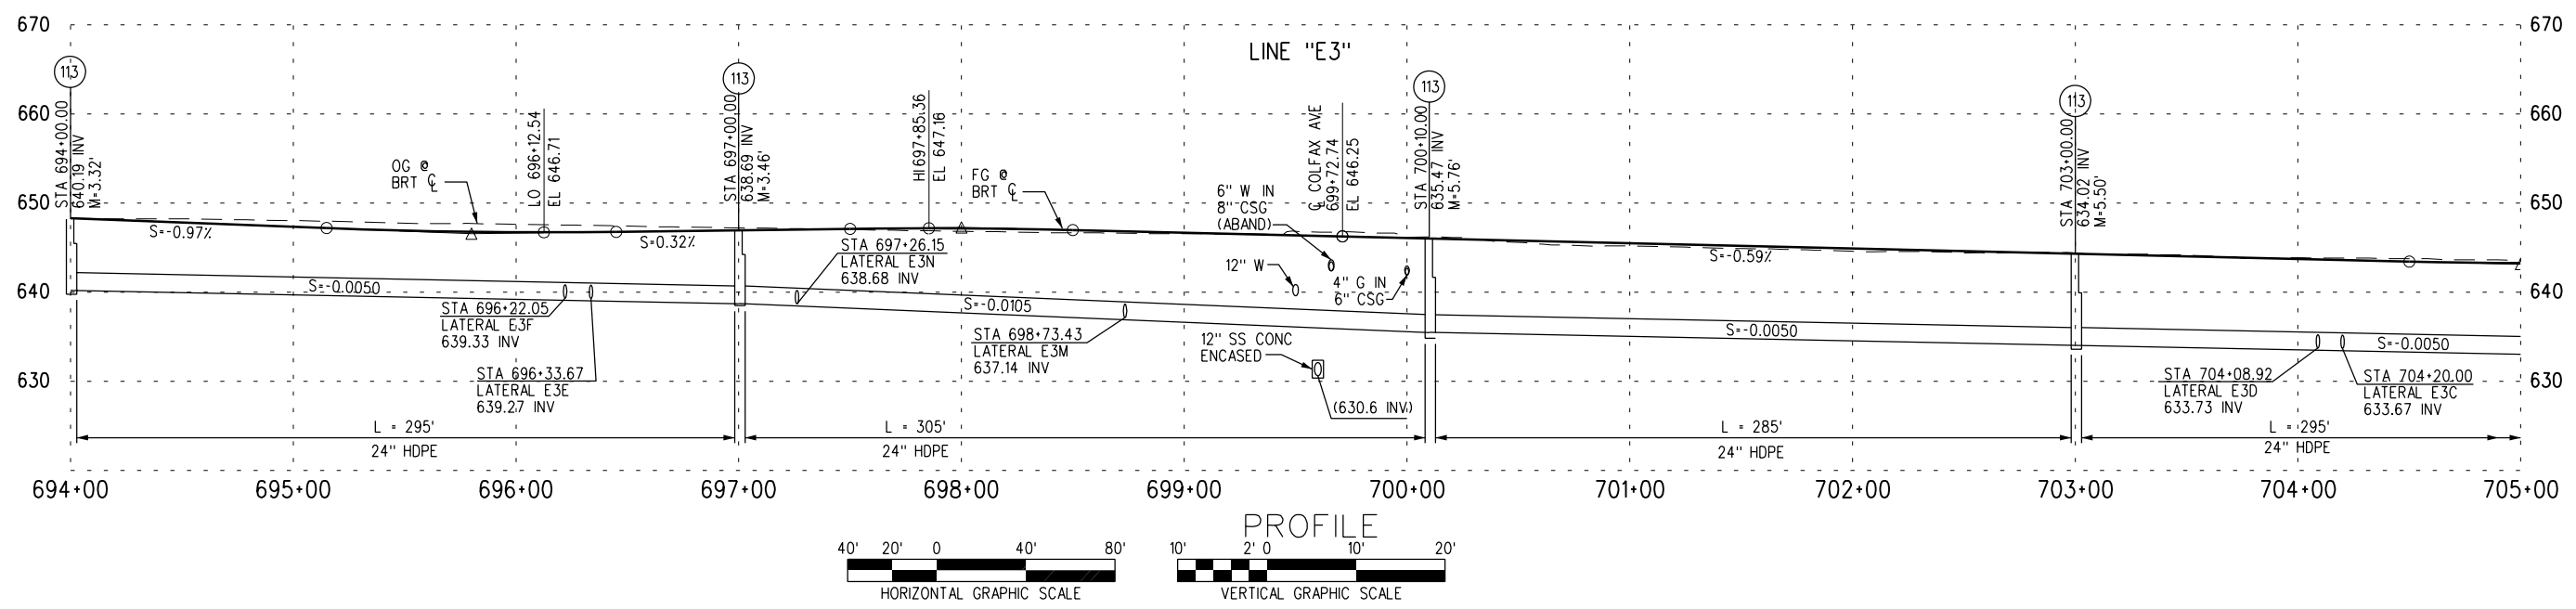

PROFILE



REV	DATE	BY	APP	REG NO	EXPIRES	SEAL HOLDER	DESCRIPTION
1	12/08/03	BEJ	DO	C59517	12/31/05	BRETT E. JONES	RESUBMITTAL IFC
0	11/7/03	DTC	DO	C59517	12/31/05	BRETT E. JONES	ISSUED FOR CONSTRUCTION

DESIGNED BY
H. BULLOCK
DRAWN BY
A. GOMEZ
CHECKED BY
D. CONYERS
IN CHARGE
B. JONES
DATE
11/07/03



LOS ANGELES COUNTY METROPOLITAN TRANSPORTATION AUTHORITY
SAN FERNANDO VALLEY EAST-WEST BRT PROJECT

Washington Group International
5805 SEPULVEDA BLVD., SUITE 500
VAN NUYS, CA 91411

SHIMMICK
OBAYASHI, JV
5805 SEPULVEDA BLVD., SUITE 500
VAN NUYS, CA 91411

BUSWAY SEGMENT 1 EAST
DRAINAGE PLAN & PROFILE
STA 694+00 TO STA 705+00
SHEET 17 OF 20

CONTRACT NO	C0675
DRAWING NO	B1C6029
SCALE	HORIZ 1"=40' VERT 1"=10'
SHEET NO	17