


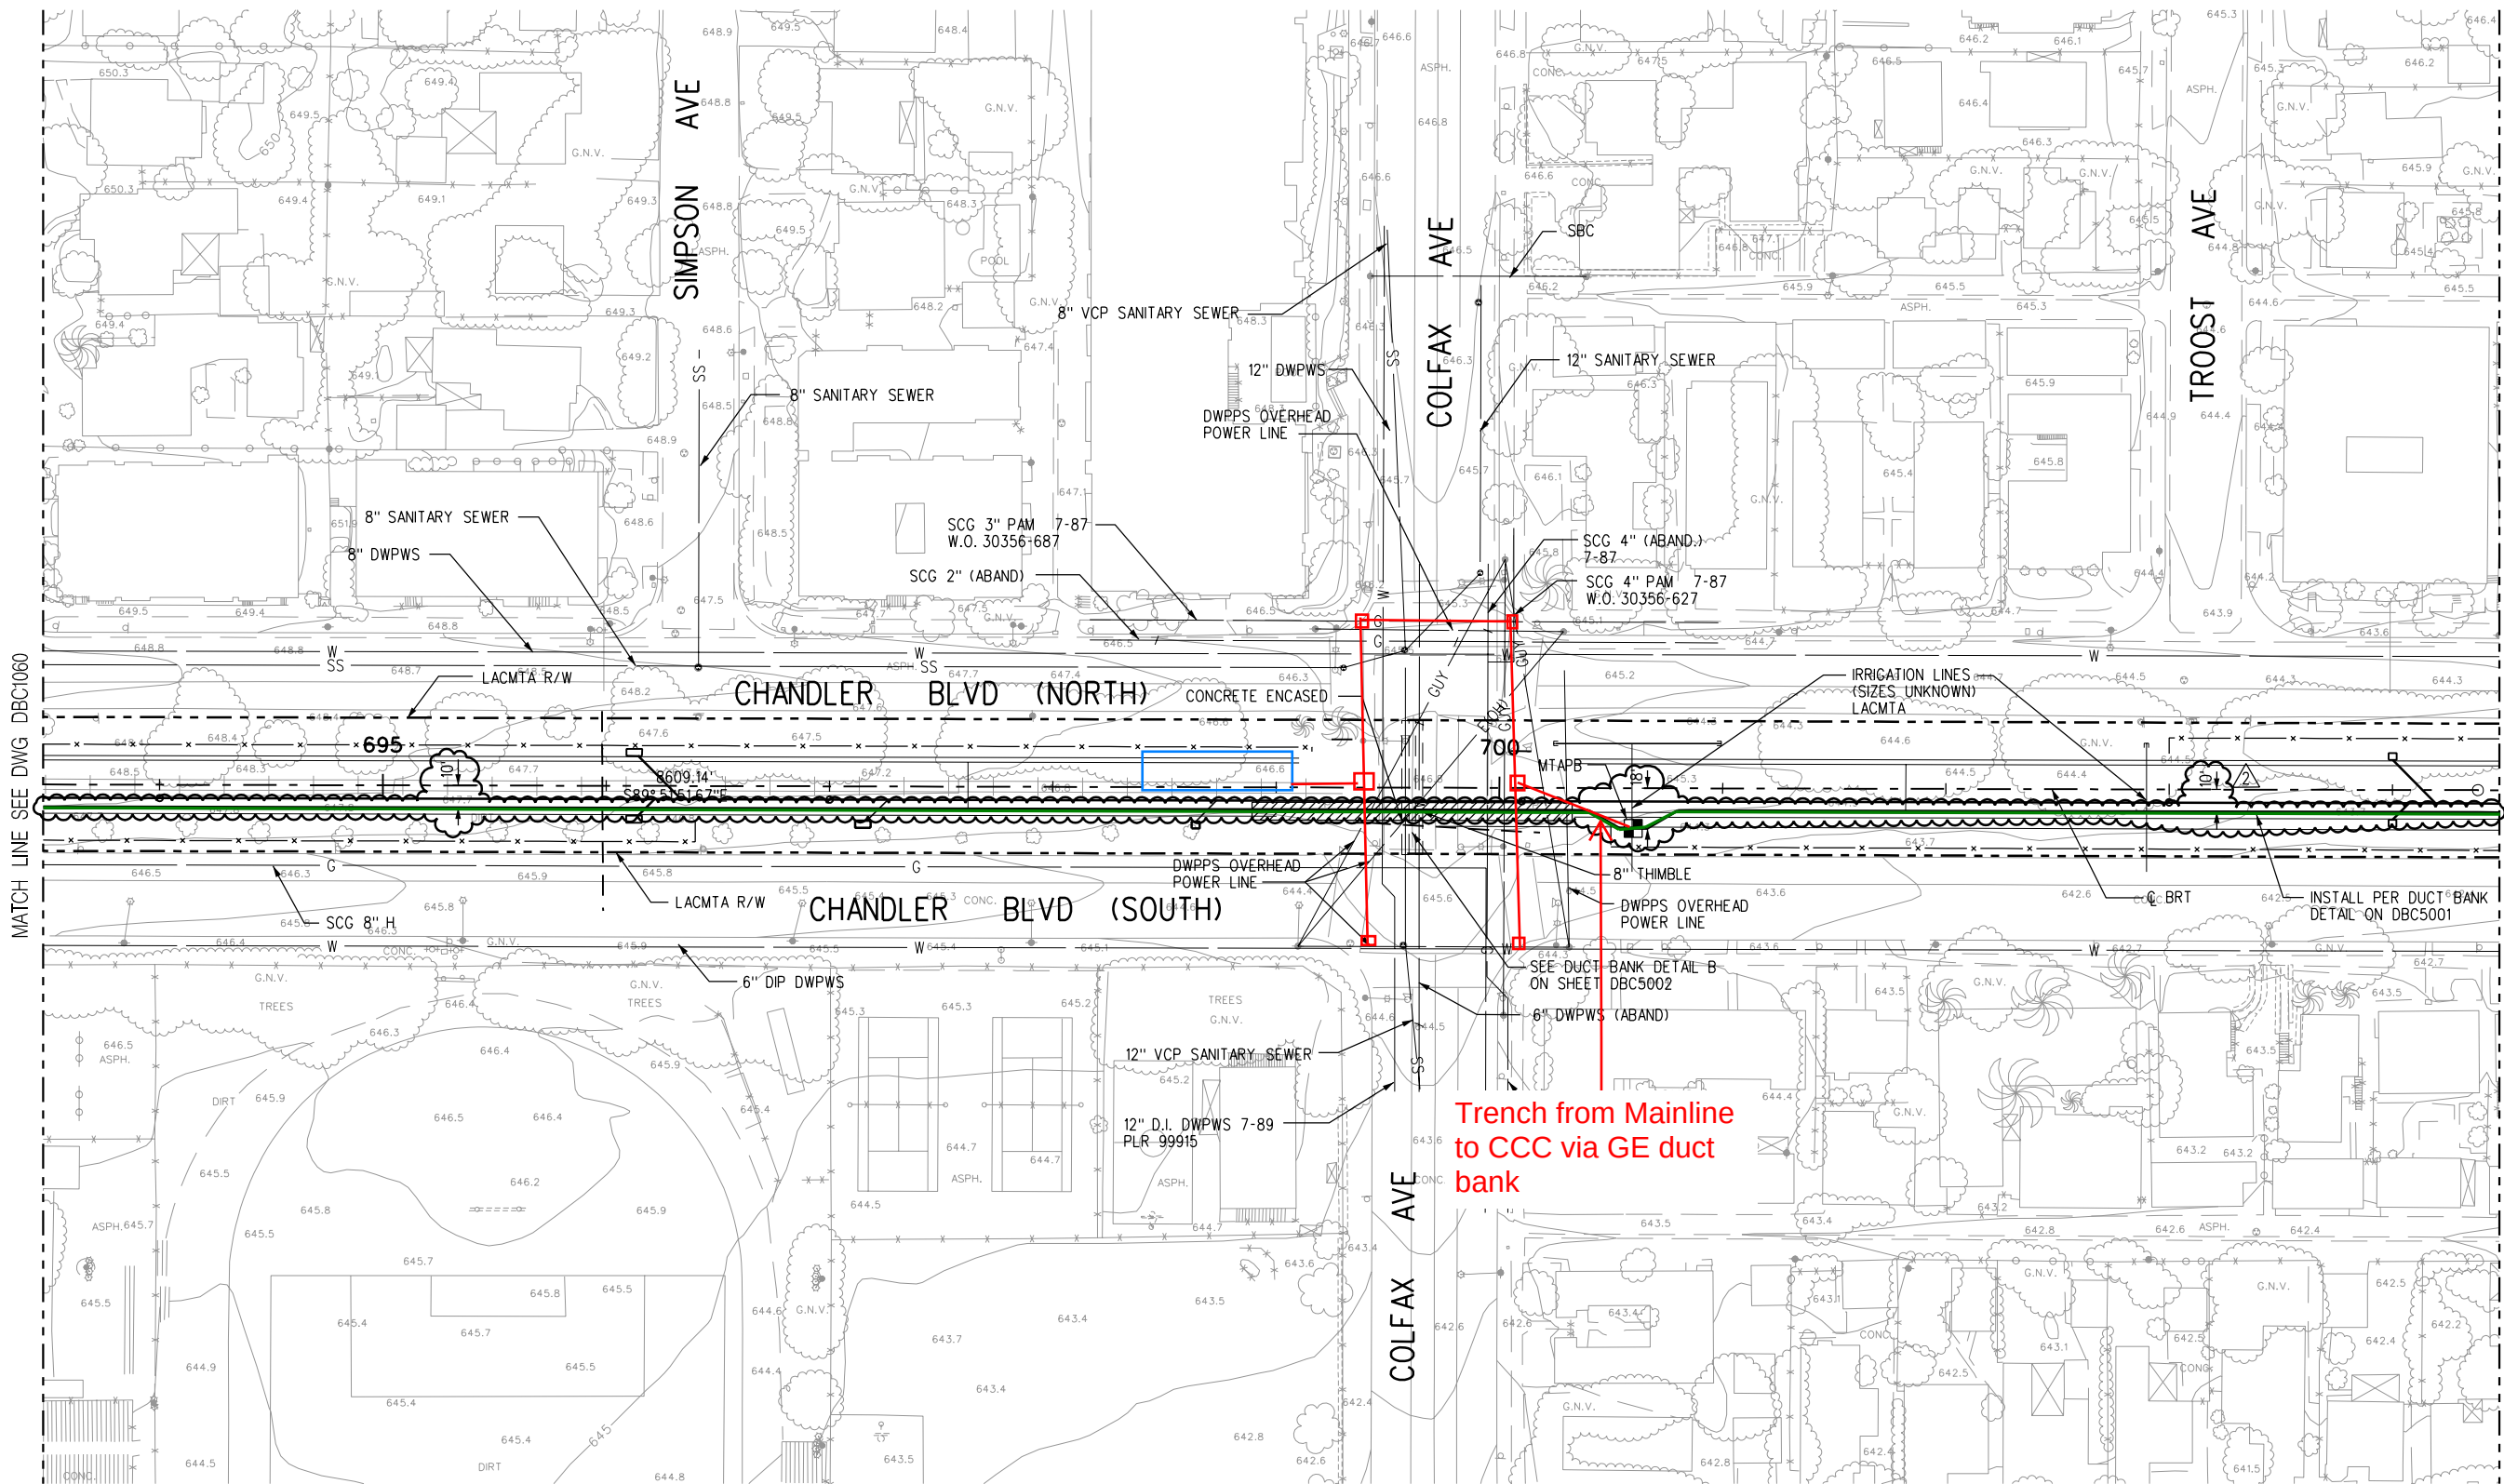

MATCH LINE SEE DWG DBC1060

MATCH LINE SEE DWG DBC1062




AS-BUILT RECORD DRAWING

REVIEWED AND APPROVED BY: GARRY J. JESS - PROJECT MANAGER
WASHINGTON GROUP INTERNATIONAL

REV	DATE	BY	APP	REG NO	EXPIRES	SEAL HOLDER	DESCRIPTION
2	11/28/05	AU	TG				AS-BUILT RECORD DRAWING
1	3/10/04	AKJ	BEJ	C59517	12/31/04	BRETT E. JONES	INCORPORATED MTA COMMENTS - IFC
0	11/7/03	YX	BEJ	C59517	12/31/03	BRETT E. JONES	ISSUED FOR CONSTRUCTION

DESIGNED BY
S. KASSISIEH
DRAWN BY
A. GOMEZ
CHECKED BY
P. ANTICH
IN CHARGE
B. JONES
DATE
11/07/03

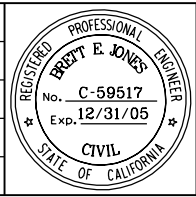

LOS ANGELES COUNTY METROPOLITAN TRANSPORTATION AUTHORITY
SAN FERNANDO VALLEY EAST-WEST BRT PROJECT

Washington Group International
WASHINGTON GROUP INTERNATIONAL, INC.
5805 SEPULVEDA BLVD., SUITE 500
VAN NUYS, CA 91411

SHIMMICK
OBAYASHI, JV
5805 SEPULVEDA BLVD., SUITE 500
VAN NUYS, CA 91411

NORTH HOLLYWOOD TO
WARNER CENTER
MAIN LINE DUCT BANK
STA 693+48 TO STA 704+48

CONTRACT NO	C0675
DRAWING NO	DBC1061
SCALE	HORIZ. 1"=40'
SHEET NO	2