
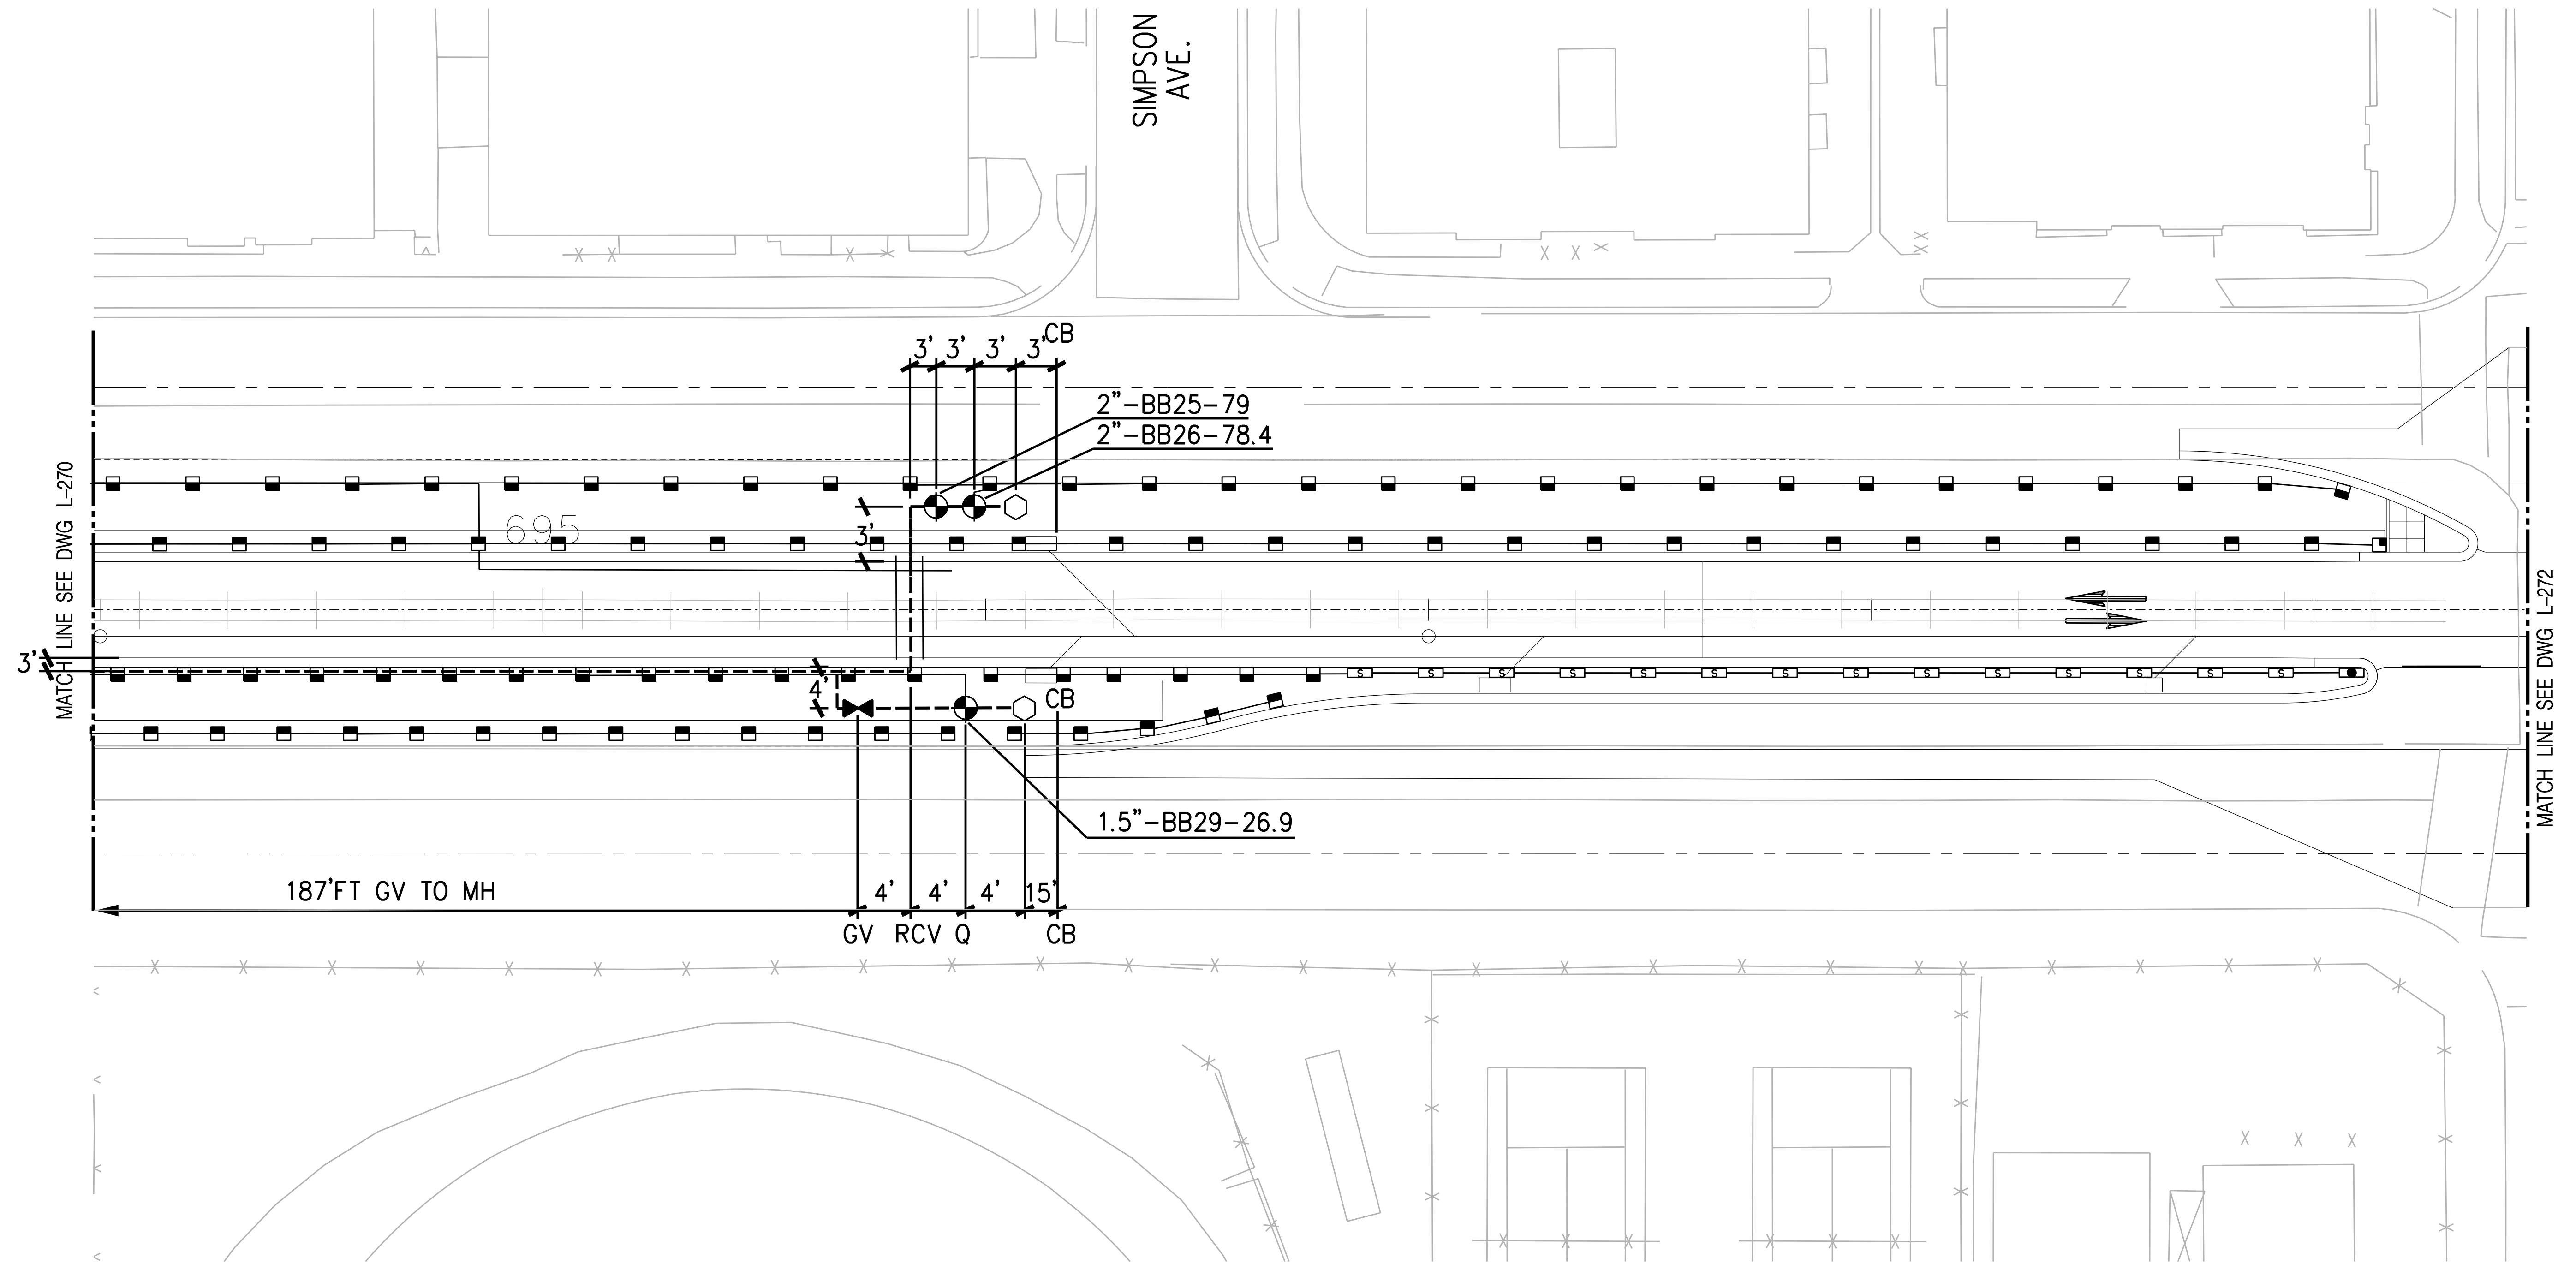


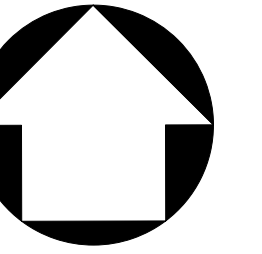

ISSUE FOR CONSTRUCTION

								DESIGNED BY MG		 LOS ANGELES COUNTY METROPOLITAN TRANSPORTATION AUTHORITY SAN FERNANDO VALLEY EAST-WEST BRT PROJECT				NORTH HOLLYWOOD TO WARNER CENTER IRRIGATION PLAN STA 694+00 TO STA 699+50 SHEET 129 OF 136				CONTRACT NO C0675	
								DRAWN BY T&P										DRAWING NO L- 271	
								CHECKED BY KLS		TATSUMI AND PARTNERS, INC. LANDSCAPE ARCHITECTURE • PLANNING • DESIGN 5 CORPORATE PARK, SUITE 200 BURNING WOOD, CA 91306-5866 949/250-9890 FAX 949/250-9891 SUBMITTED BY: _____ DATE: _____ DAVID H. TATSUMI								SCALE 1"=20'	
								IN CHARGE DT										SHEET NO	
								DATE 5/23/2005											
REV	DATE	BY	APP	REG NO	EXPIRES	SEAL HOLDER	DESCRIPTION												
	3/12/08						AS-BUILTS												
0	5/23/05						ISSUE FOR CONSTRUCTION												

Mike. G