



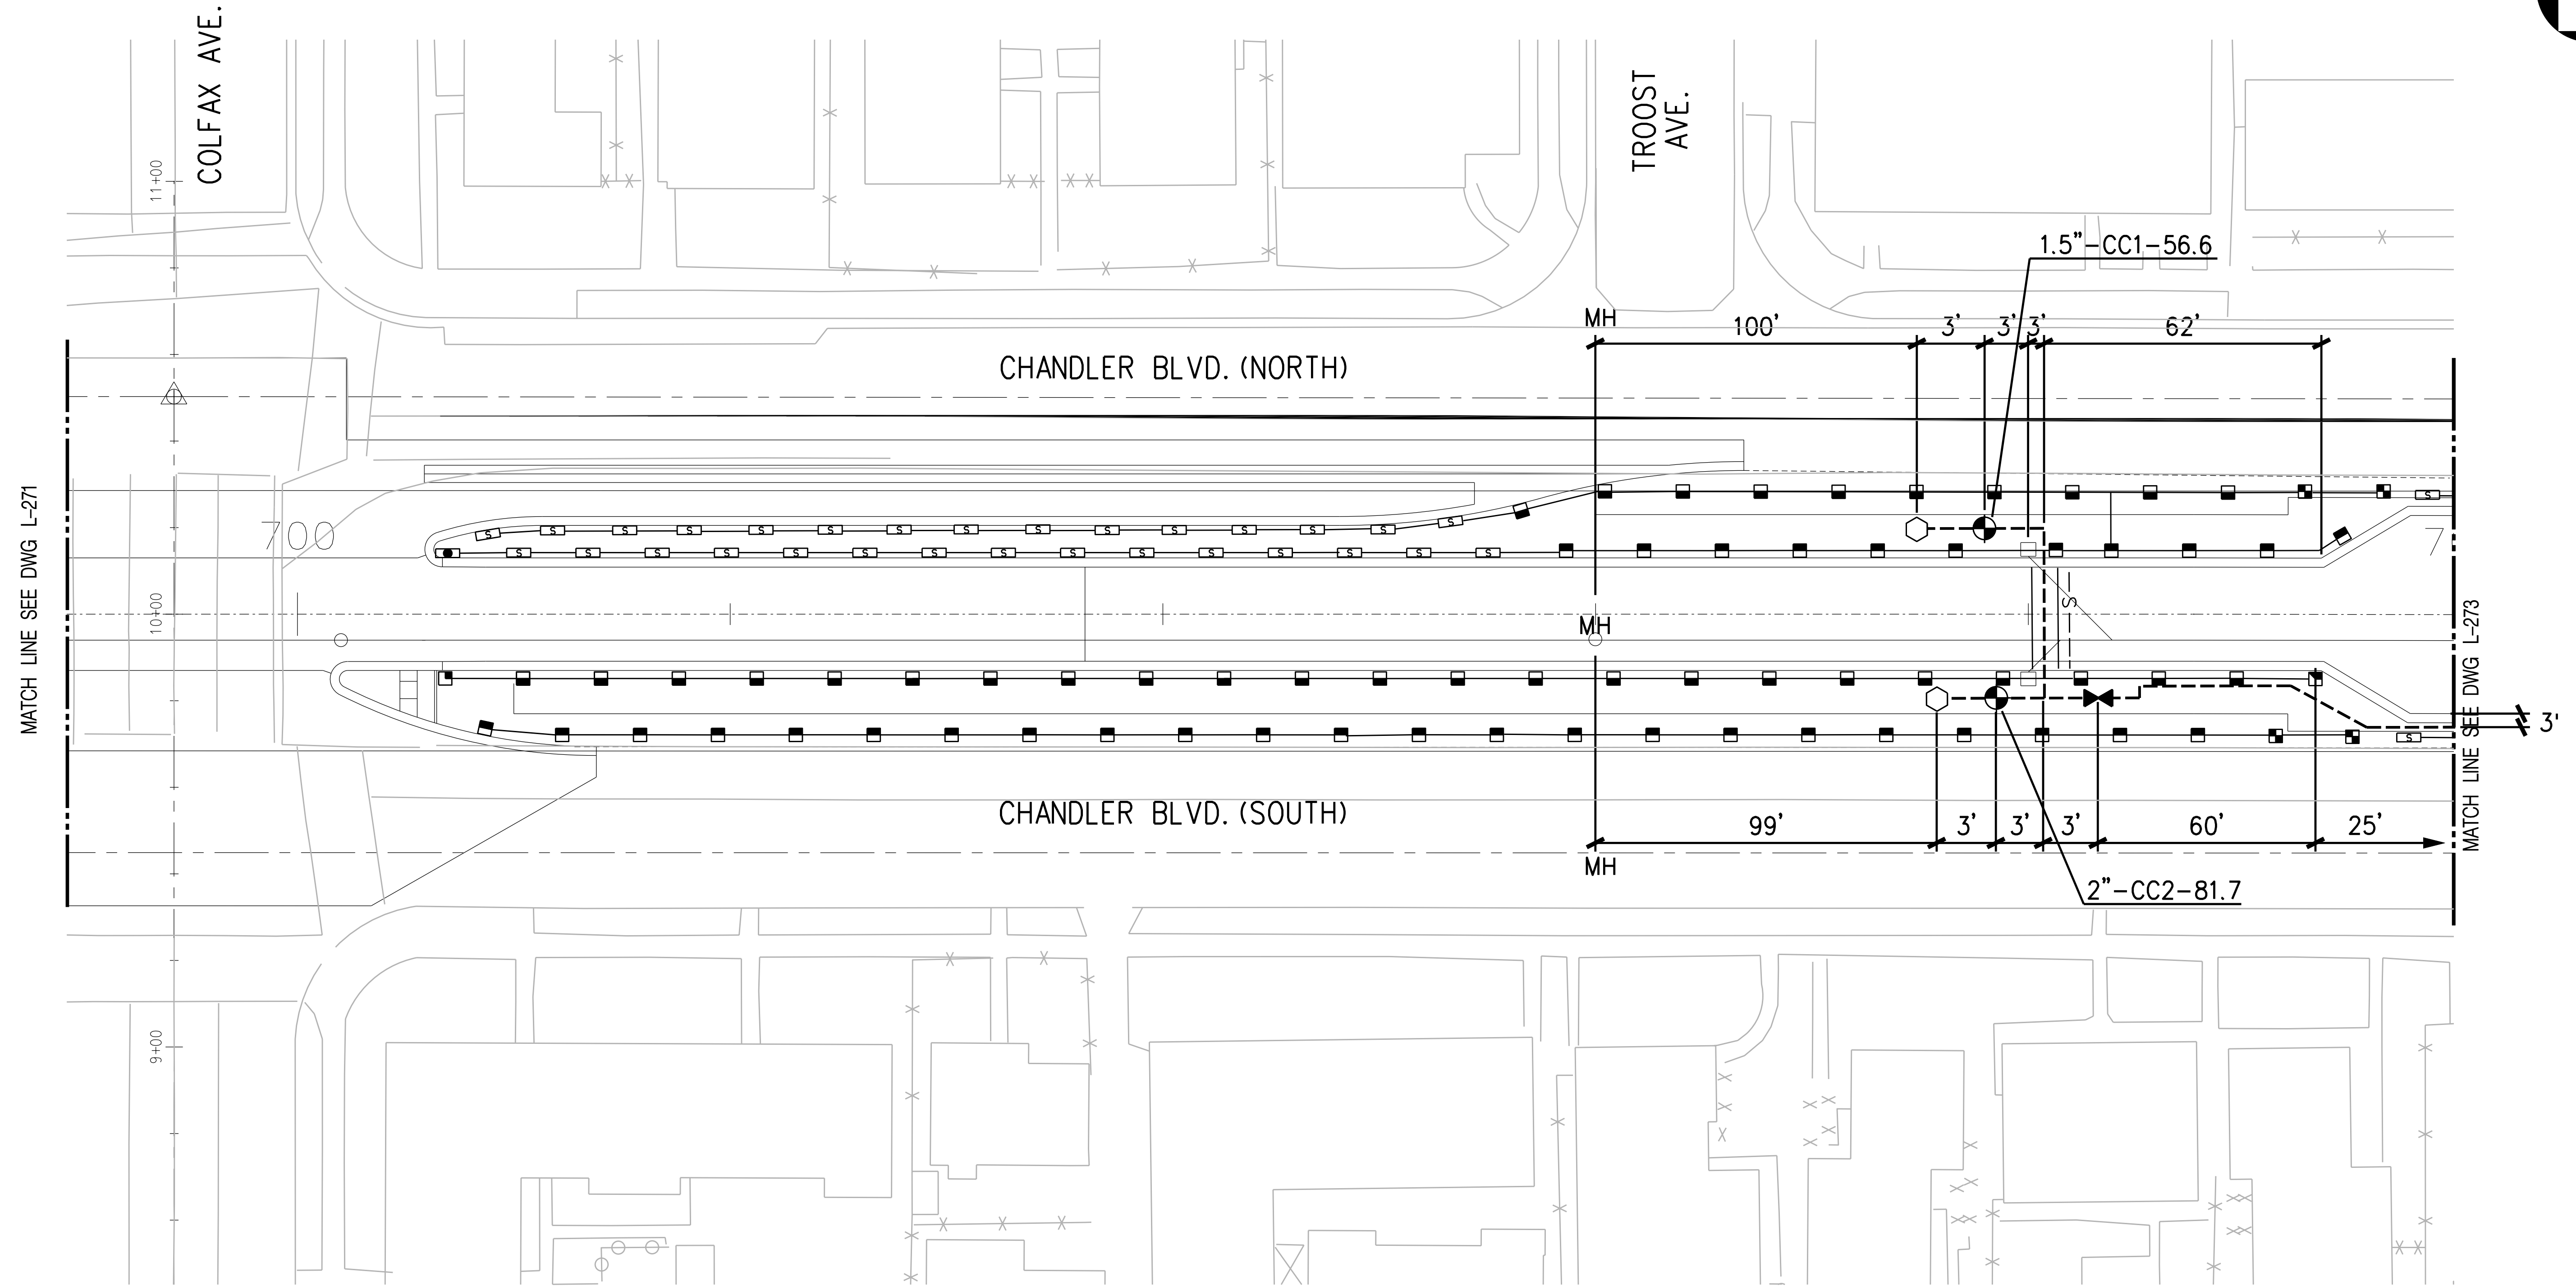

ValleyCrest
Landscape Development
AS-BUILT DOCUMENTS

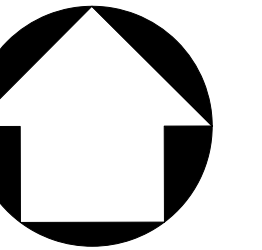

ISSUE FOR CONSTRUCTION

							DESIGNED BY MG		 LOS ANGELES COUNTY METROPOLITAN TRANSPORTATION AUTHORITY SAN FERNANDO VALLEY EAST-WEST BRT PROJECT TATSUMI AND PARTNERS, INC. LANDSCAPE ARCHITECTURE • PLANNING • DESIGN 5 CORPORATE PARK, SUITE 200 BURNING WOOD, CA 91306-5866 949/250-9890 FAX 949/250-9891		NORTH HOLLYWOOD TO WARNER CENTER IRRIGATION PLAN STA 699+50 TO STA 705+00 SHEET 130 OF 136		CONTRACT NO C0675	
							DRAWN BY T&P						DRAWING NO L- 272	REV 0
							CHECKED BY KLS						SCALE 1"=20'	SHEET NO
							IN CHARGE DT							
							DATE 5/23/2005							
REV	DATE	BY	APP	REG NO	EXPIRES	SEAL HOLDER	DESCRIPTION							
	3/12/08						AS-BUILTS							
0	5/23/05						ISSUE FOR CONSTRUCTION							

Mike. G