
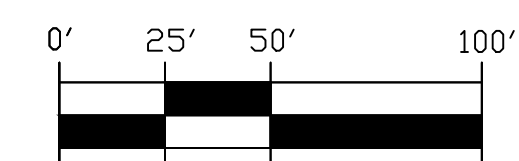
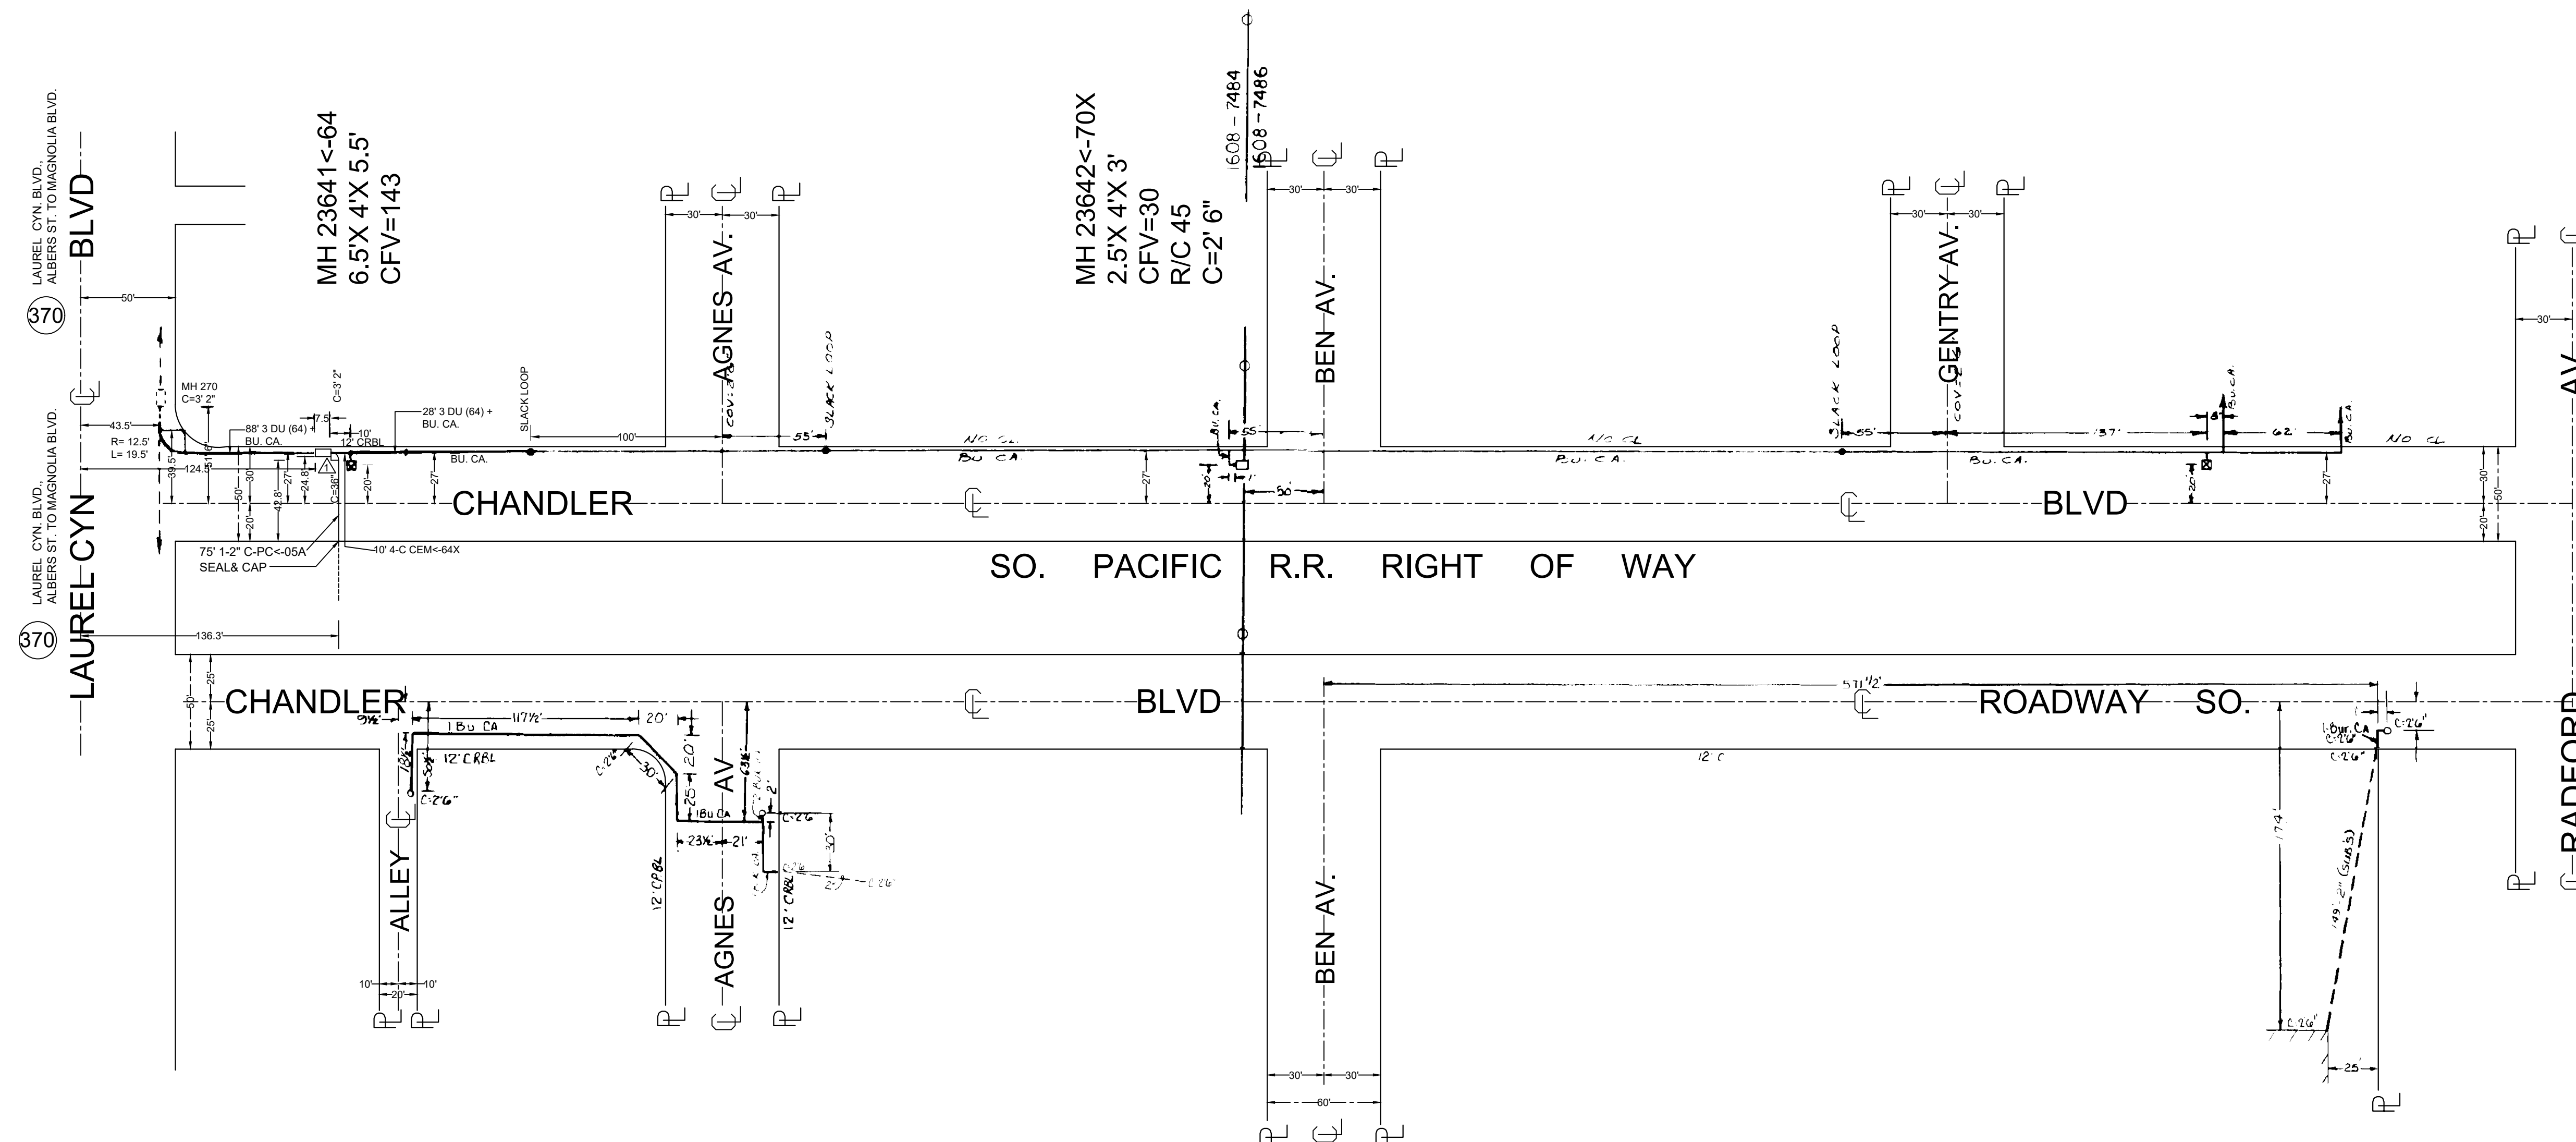


CONDUIT CURVE DATA			
	ANGLE	RADIUS	LENGTH
①	90° 00' 00"	4'	6.28'
②	00° 00' 00"	00'	0.0'
③	00° 00' 00"	0'	0.0'

[illegible]

ISSUE DATE	4-17-2008
SEG NO.	1606-7490
R/C	4C
EXCEPT AS NOTED	

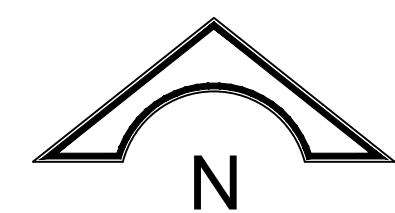


EXCHANGE	NORTH HOLLYWOOD
C.O. AREA	MAGNOLIA
GEO-CO CODE	B2-09

LOCATION
CHANDLER BLVD.
LAUREL CYN BLVD TO RADFORD AV

FILENAME	B209_NHWDCA02_151.dwg
----------	-----------------------

SCALE	RECORD NO.
1"=50'	B209_NHWDCA02_151

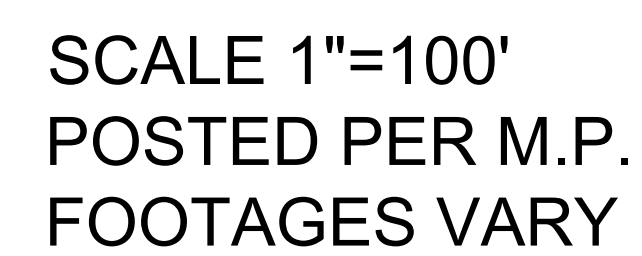

	
ISSUE DATE	6-4-2008
SEG NO.	1608-7484
R/C	4C EXCEPT AS NOTED
	
EXCHANGE	NORTH HOLLYWOOD
C.O. AREA	MAGNOLIA
GEO-CO CODE	B2-09
LOCATION LAUREL CYN. BLVD. ALBERS ST. TO MAGNOLIA BLVD.	
FILENAME B209_NHWDCA02_370.dwg	
SCALE	RECORD NO.
1"=100'	B209_NHWDCA02_370

CONDUIT CURVE DATA

$$\triangle I = 60^\circ$$
$$R = 10'$$
$$L = 10'$$
$$\triangle 2 = 90^\circ$$
$$R = 5'$$
$$L = 8'$$

FORM NO. 4		
IN EFFECT		10-79
REVISED		
MO.-YR.	AUTHORIZATION	
4-79	1035R	
89A	78 79 T	

YR | AUTH | AC

95B | B28319W |

