


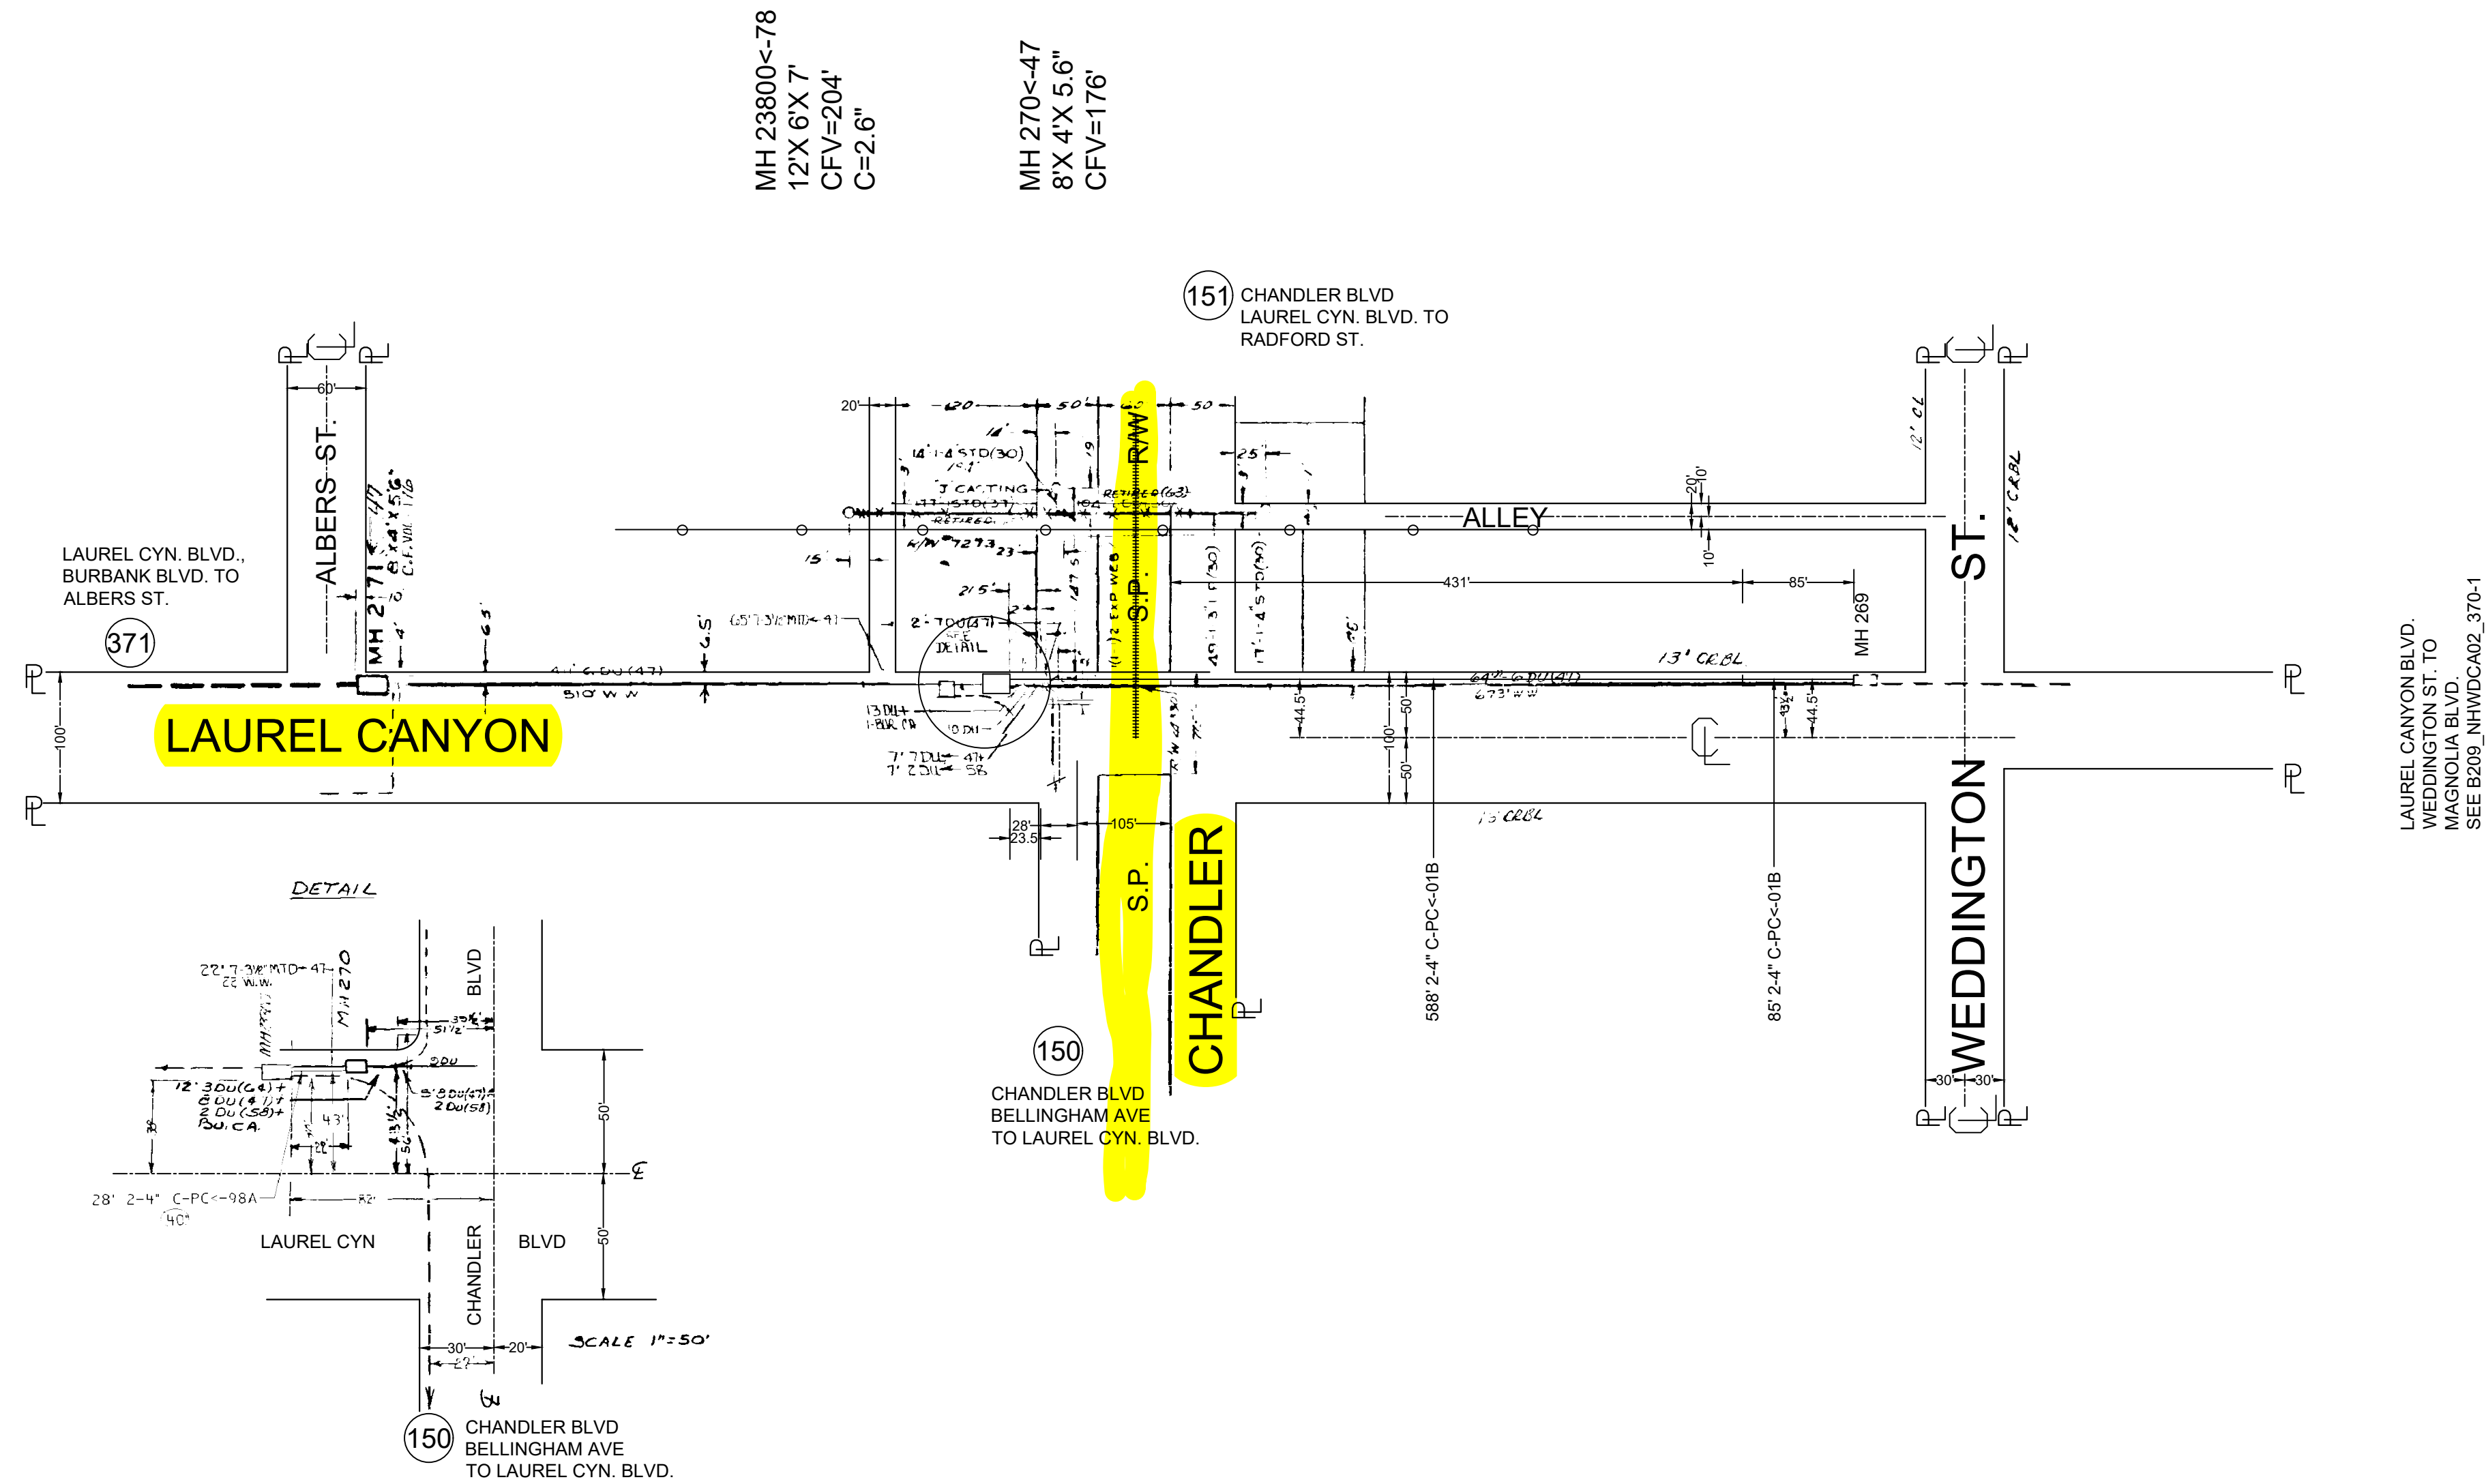

SCALE 1"=100'
POSTED PER M.P.
FOOTAGES VARY

IN EFFECT: 3-59

SUPERCEDES:

REVISION		
YEAR	PROJECT	ACT IDENT
5-61	86239	
12-61	86638	
4-62	86865	
7-64	86339	
1-65	86690	
6-65	86691	
6-30-65	INV	
1-68	88145	
12-31-69	INV	
4-70	86128	
4-71	86357	
2-72	88831	
	45C CONV	
4-79	1035R	
10-79	A888-B625	
98A	1338R	
2001B	B21425R	



ISSUE DATE 6-4-2008

SEG NO. 1608-7484

R/C 4C EXCEPT AS NOTED



EXCHANGE NORTH HOLLYWOOD

C.O. AREA MAGNOLIA

GEO-CO CODE B2-09

LOCATION
LAUREL CYN. BLVD.
ALBERS ST. TO MAGNOLIA BLVD.

FILENAME
B209_NHWDC A02_370.dwg

SCALE	RECORD NO.
1"=100'	B209_NHWDC A02_370