
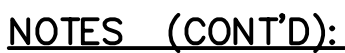
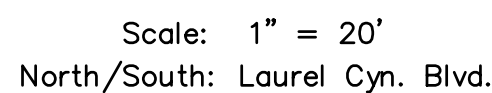


(E) = EXISTING
 * For reference only; see Street Lighting sheet
 ** CIDH PILE Foundation as per Caltrans Standard Plans.
 *** CIDH PILE Foundation as per LADOT Std. Dwg. No. S-52.14B

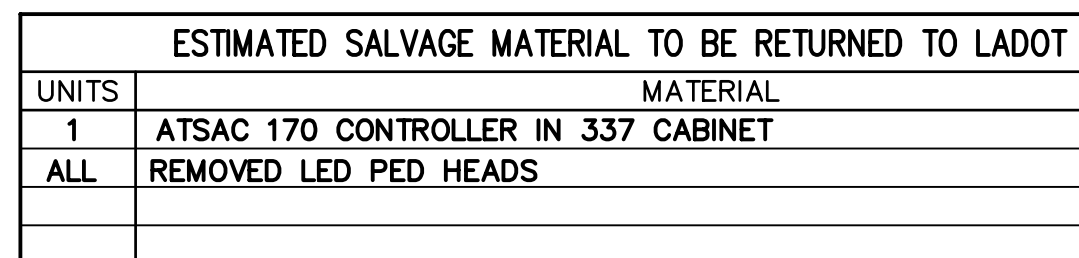

10. CONTRACTOR SHALL PROVIDE AND INSTALL LARGE STREET NAME SIGNS PER LADOT STD. DWGS. No. S-457.0 & S-486.0.
11. INSTALL CONDUIT INTO EXISTING PULLBOX AS SHOWN.
12. CONTRACTOR TO USE PELCO ASTRO BRACK OR EQUIVALENT TO INSTALL THE 3 SECTION VEHICLE HEAD BACK TO BACK ON THE M.A.
13. INSTALL STRIPING, SIGNS AND PAVEMENT MARKINGS PER LADOT DWG. No. A-3920 FOR THIS PROJECT. REMOVE ALL CONFLICTING STRIPING AND PAVEMENT MARKINGS.
14. SEE STREET LIGHTING SHEET FOR WORK ON STREET LIGHTING FACILITIES.
15. INSTALL TRANSIT PRIORITY LOOPS PER LADOT STD. DWG. No. S-70.1F AND VEHICLE LOOPS PER STD. DWG. No. S-70.1A.
16. ALL NEW VEHICLE AND PEDESTRIAN TRAFFIC SIGNALS SHALL BE LED MODULES, PER LADOT SPECIFICATION 92-088-03 (LATEST EDITION).

[illegible]

(E) = Existing

NOTICE TO CONTRACTOR
SEE DWG. NO. G1TS-009A

NOTES:

1. SEMI-ACTUATED OPERATION WITH ATASC CAMERA (ATASC 2070 CONTROLLER WITH TRANSIT PRIORITY IN 332 CABINET)
- 01 - CHANDLER BLVD EB LT
02 - CHANDLER BLVD WB & N/S PED XING
03 - LAUREL CYN BLVD NB LT (APPROACH)
04 - LAUREL CYN SB (APPROACH) & W/S PED XING
05 - CHANDLER BLVD WB LT.
06 - CHANDLER BLVD EB & S/S PED XING
07 - LAUREL CYN BLVD SB LT (APPROACH)
08 - LAUREL CYN BLVD NB (APPROACH) & E/S PED XING
OLA (04 & 08) - LAUREL CYN BLVD. NB (DEPARTURE)
OLB (04 & 05) - LAUREL CYN BLVD. SB (DEPARTURE)
OLC (03) - LAUREL CYN BLVD. NB LT (DEPARTURE)
OLD (07) - LAUREL CYN BLVD. SB LT (DEPARTURE)
BRT A - BUSWAY WB
BRT B - BUSWAY EB
- VICTORY CORRIDOR EAST ATASC SYSTEM
DIRECT WIRE (CABLE) INTERCONNECT
2. REMOVE CONTROLLER, 337 CABINET, TYPE 8 STANDARD AND FOUNDATION; ABANDON CONDUITS. RELOCATE FIBER OPTIC VIDEO/DATA TRANSMITTER SYSTEM TO CONTROLLER AT LOCATION ①.
3. INSTALL ATASC 2070 CONTROLLER IN 332 CABINET. THE CONTRACTOR SHALL PROVIDE A COMPLETE FUNCTIONING CONTROLLER ASSEMBLY AND CABINET CONFORMING TO THE LATEST LADOT SPECIFICATION FOR 2070 CONTROLLER. CONTRACTOR TO DELIVER COMPLETELY ASSEMBLED CONTROLLER FOR TURNING TO THE DEPARTMENT OF TRANSPORTATION GENERAL SHOP, PIPER TECHNICAL CENTER, 555 RAMIREZ STREET THIRTY (30) DAYS PRIOR TO INSTALLATION. CONTRACTOR TO PICK UP AND INSTALL CONTROLLER ASSEMBLY ON F-332 FOUNDATION. INSTALL TRANSIT PRIORITY SENSOR UNITS IN THE NEW 332 CABINET.
4. REMOVE TRAFFIC SIGNAL EQUIPMENT, STANDARD, FOUNDATION AND PULL BOX. ABANDON CONDUITS.
5. REPLACE EXISTING SERVICE WIRES WITH 2 #6 WIRES. INSTALL A 60 AMP USE-IT-UP IN-LINE WATERPROOF FUSEHOLDER IN THE PULLBOX PER LADOT STD. DWG. NO. S-79.8. WORK ON ANY ELECTRICAL EQUIPMENT TO BE DONE ONLY IN CONJUNCTION WITH THE DWP PERSONNEL. CONTACT DWP AT (213) 367-3003 SEVEN (7) WORKING DAYS PRIOR TO BEGINNING OF WORK
6. RELOCATE C-2 POLE TO LOCATION ⑥. INSTALL MASTER ARM PER SIGNAL STANDARD SCHEDULE. REMOVE TEMPORARY PLATFORM FOUNDATION AND OVERHEAD CABLES. CONTRACTOR TO TAKE EXTREME CARE IN THE RELOCATION OF THE POLE. DAMAGED, UNACCEPTABLE EQUIPMENT AS DETERMINE BY LADOT SIGNAL INSPECTOR SHALL BE REPLACED WITH NEW EQUIPMENT AT CONTRACTOR'S SOLE EXPENSE.
7. INSTALL PV HEAD AT 14' HEIGHT.
8. INTERCEPT CONDUIT AND INSTALL PULLBOX
9. REMOVE TRAFFIC SIGNAL EQUIPMENT AND STANDARD. REUSE EXISTING FOUNDATION.

MTA – SAN FERNANDO VALLEY RAPID BUS SYSTEM (SIGNAL RESTORATION)			
REVIEWED <u>January 30, 20 04</u> <u>Aziz Mashian</u> Transportation Engineer	RECOMMENDED <u>January 30, 20 04</u> <u>Pean Skehan</u> Senior Transportation Engineer	ACCEPTED <u>January 30, 20 04</u> <u>Thomas L. Jones</u> Principal Transportation Engineer	
AS BUILT		CITY OF LOS ANGELES DEPARTMENT OF TRANSPORTATION WAYNE K. TANDA, GENERAL MANAGER	
Date of Installation: <u>11-18-05</u> LADOT Inspector: <u>Algebra</u> Condition As Of: <u>11-18-05</u> LADOT Engineer: <u>J.P.</u>		TITLE CHANDLER BLVD., LAUREL CYN. BLVD. & BUSWAY	
District EAST VALLEY Thomas Guide 562-62			
References	File Name 32780-P2.DWG	Intersection No. 32780	Project No. 74720
NOTICE: IF PLAN HAS NOT BEEN IMPLEMENTED WITHIN TWO (2) YEARS OF THE ACCEPTANCE DATE, IT MUST BE RESUBMITTED TO LADOT SIGNAL DESIGN SECTION FOR REVIEW AND APPROVAL.			

NORTH HOLLYWOOD TO WARNER CENTER
GROUP 1 INTERSECTIONS
RESTORATION TRAFFIC SIGNAL
CHANDLER BLVD., LAUREL CYN BLVD.
AND BUSWAY

SEGMENT NO	
C-0675	
DRAWING NO	REV
G1TS-006	1
SCALE	
1" = 20'	
SHEET NO	



1	02-10-06	AXK						AS-BUILT RECORD DRAWING
0	01/28/04	JB	WJO	52655	12/31/04	WALTER J. OKITSU		ISSUED FOR CONSTRUCTION
REV	DATE	BY	APP	REG NO	EXPIRES	SEAL HOLDER		DESCRIPTION

DESIGNED BY J. BERNAL
DRAWN BY J. BERNAL
CHECKED BY D. YEY
IN CHARGE W. OKITSU
DATE 01-28-04



WASHINGTON



Katz, Okitsu & Associates
Traffic Engineers & Transportation Planners
1055 Corporate Center Drive, Suite 300
Monterey Park, California 91754-7642
Tel: (323) 260-4703 Fax: (323) 260-4705