

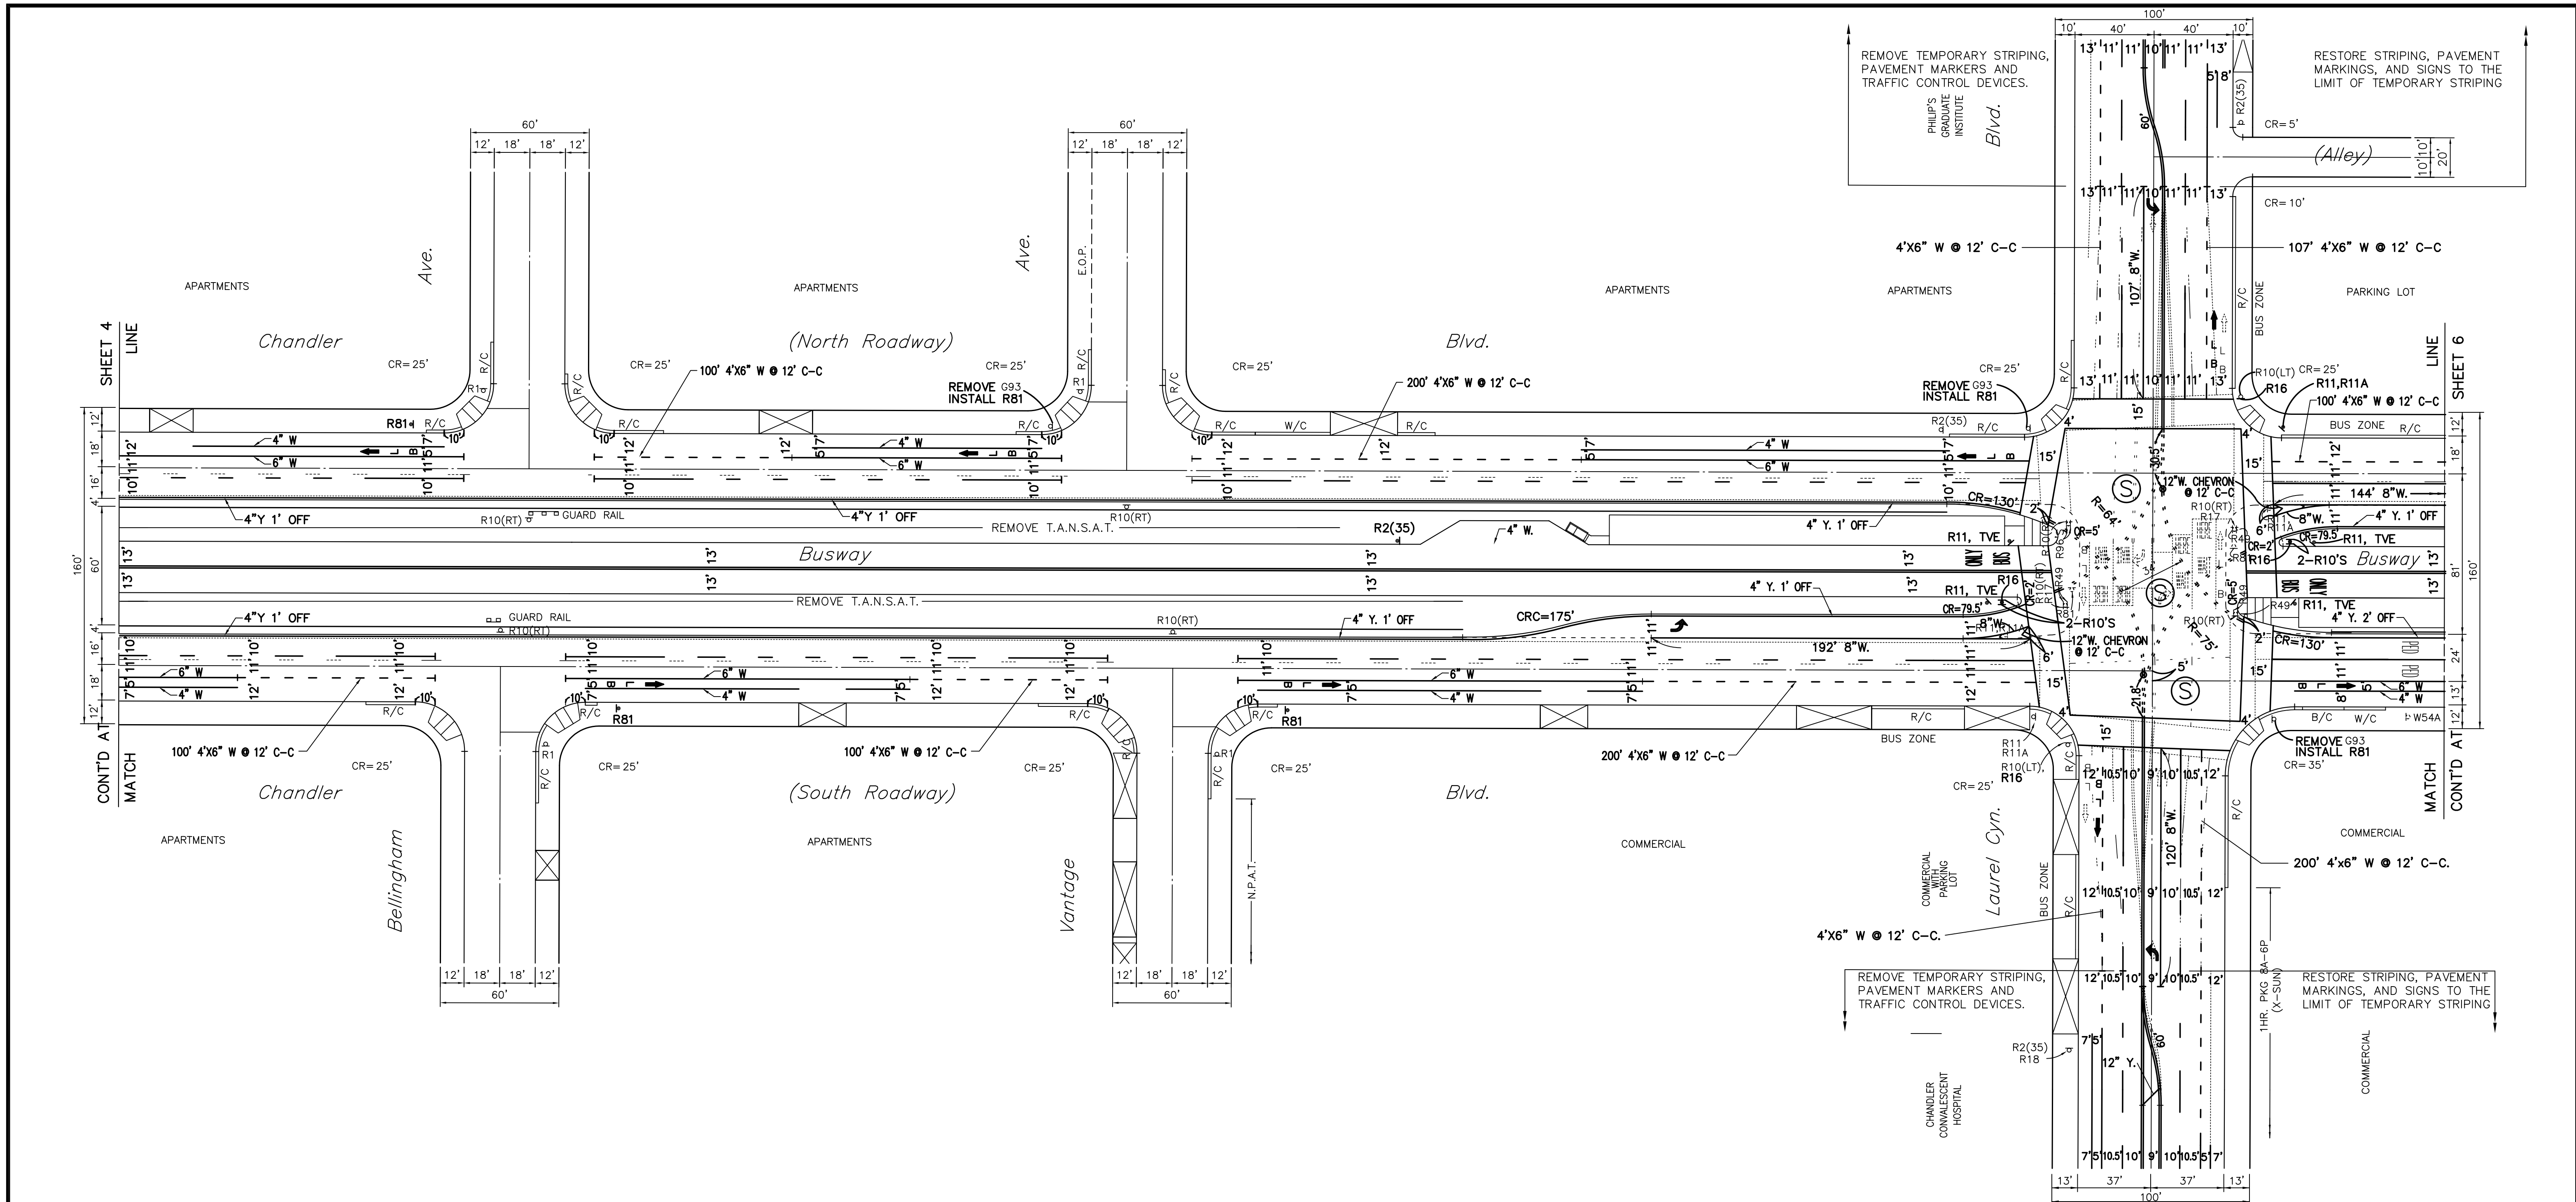


|                                                                                        |                                                   |                                                                                    |
|----------------------------------------------------------------------------------------|---------------------------------------------------|------------------------------------------------------------------------------------|
| MTA- SAN FERNANDO VALLEY RAPID BUS SYSTEM                                              |                                                   |                                                                                    |
| REVIEWED: January 29, 2004<br>Jim Conger<br>Transportation Engineer                    | RECOMMENDED: 20<br>Senior Transportation Engineer | ACCEPTED: January 29, 2004<br>Thomas L. Jones<br>Principal Transportation Engineer |
| CITY OF LOS ANGELES<br>DEPARTMENT OF TRANSPORTATION<br>WAYNE K. TANDA, GENERAL MANAGER |                                                   |                                                                                    |
| CHANDLER BLVD.<br>COLDWATER CYN BLVD. TO LANKERSIM BLVD.                               |                                                   |                                                                                    |
| Thomas Guide<br>562,G2                                                                 | District<br>E.V.                                  | PROJECT NO.<br>74720<br>DRAWING NO.<br>A-3920<br>1/1                               |

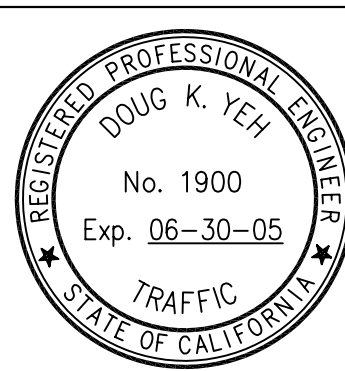

| REV | DATE     | BY  | APP | REG NO | EXPIRES  | SEAL HOLDER      | DESCRIPTION             |
|-----|----------|-----|-----|--------|----------|------------------|-------------------------|
| 1   | 02-10-06 | AXK |     |        |          |                  | AS-BUILT RECORD DRAWING |
| 0   | 01/28/04 | APC | WJO | 52655  | 12/31/04 | WALTER J. OKITSU | ISSUED FOR CONSTRUCTION |

DESIGNED BY  
A. CALDERON  
DRAWN BY  
J. BERNAL  
CHECKED BY  
D. YEH  
IN CHARGE  
W. OKITSU  
DATE  
01-28-04

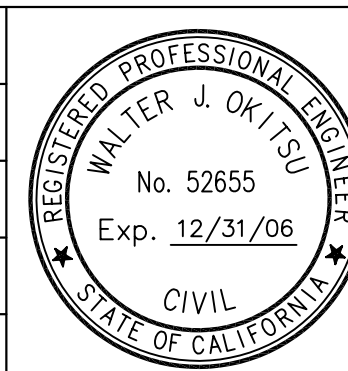

LOS ANGELES COUNTY METROPOLITAN TRANSPORTATION AUTHORITY  
SAN FERNANDO VALLEY EAST-WEST BRT PROJECT

WASHINGTON

SHIMMICK  
OBAYASHI, JV

Katz, Okitsu & Associates  
Traffic Engineers & Transportation Planners  
1055 Corporate Center Drive, Suite 300  
Monterey Park, California 91754-7642  
Tel: (323) 260-4703 Fax: (323) 260-4705

|                                                                                                                                                         |                   |
|---------------------------------------------------------------------------------------------------------------------------------------------------------|-------------------|
| NORTH HOLLYWOOD TO WARNER CENTER<br>GROUP 1 INTERSECTIONS<br>RESTORATION SIGNING & STRIPING<br>CHANDLER BLVD.<br>COLDWATER CYN BLVD. TO LANKERSIM BLVD. |                   |
| SEGMENT NO.<br>C-0675                                                                                                                                   | REV<br>1          |
| DRAWING NO.<br>G1SS-005                                                                                                                                 | SCALE<br>1" = 40' |
| SHEET NO.                                                                                                                                               |                   |