



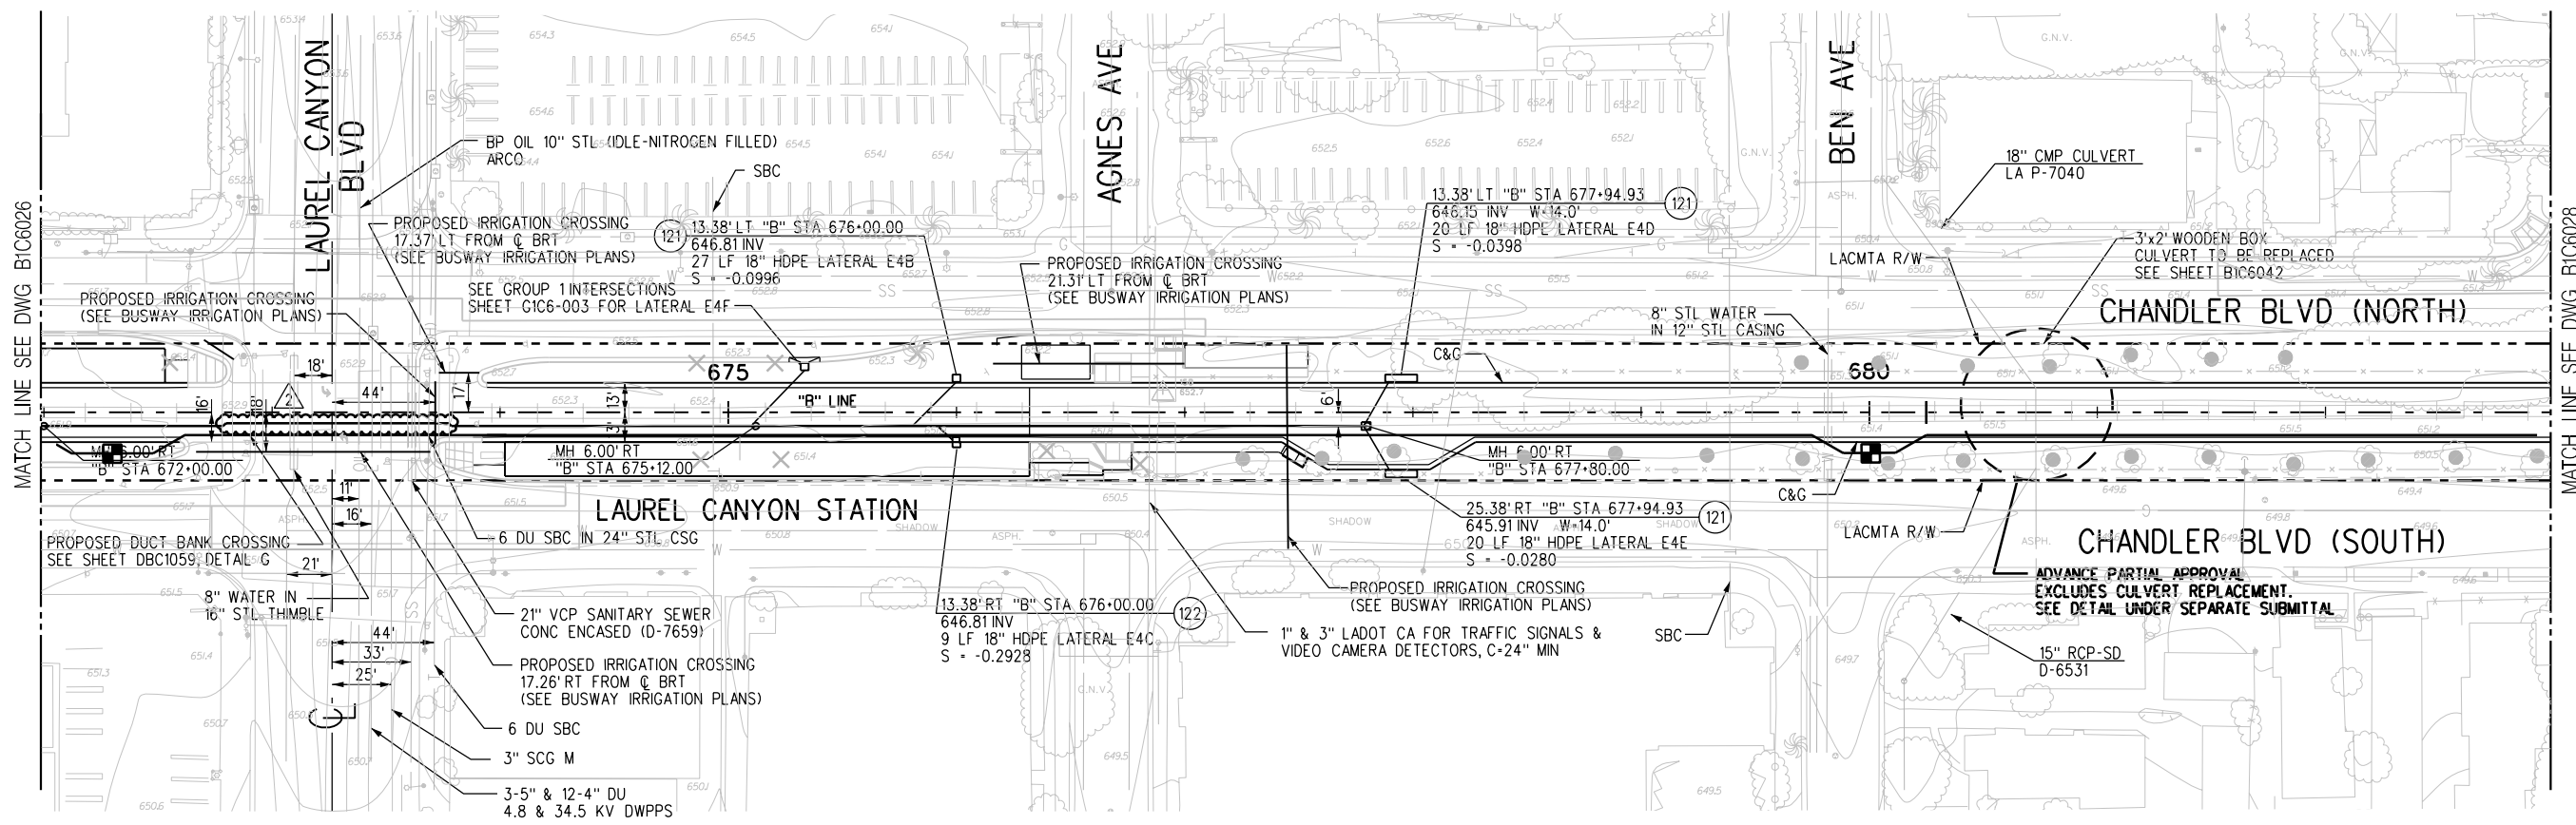

PLAN

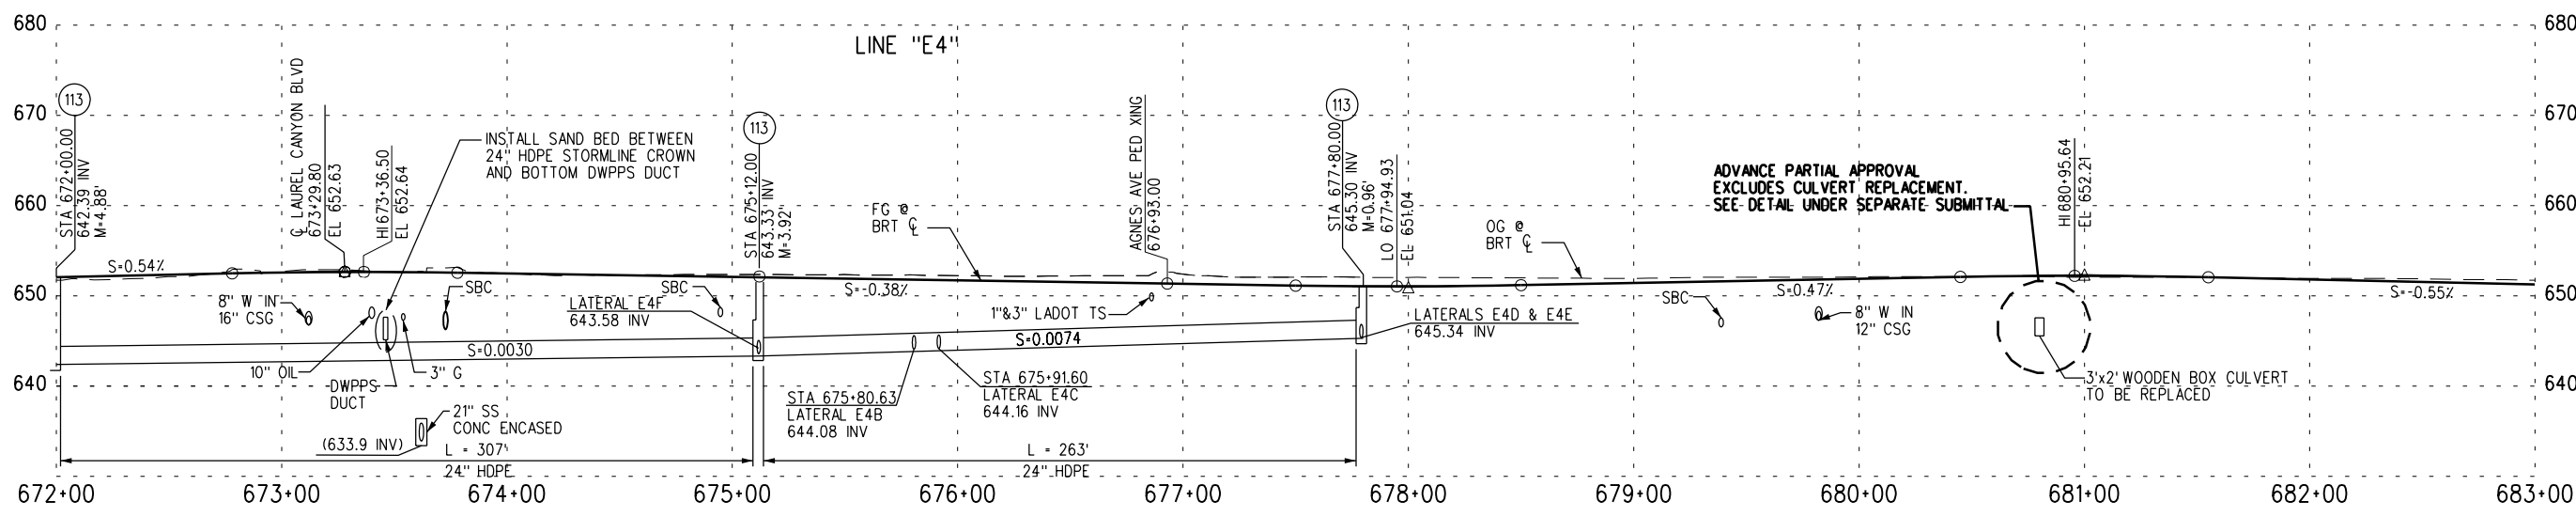

PROFILE



AS-BUILT RECORD DRAWING

REVIEWED AND APPROVED BY: *Garry J. Jess*
GARRY J. JESS, PROJECT MANAGER
WASHINGTON GROUP INTERNATIONAL

REV	DATE	BY	APP	REG NO	EXPIRES	SEAL HOLDER	DESCRIPTION
2	10/19/05	AU	TG				AS-BUILT RECORD DRAWING
1	12/09/03	BEJ	DO	C59517	12-31-05	BRETT E. JONES	RESUBMITTAL IFC
0	11/7/03	DTC	DO	C59517	12/31/05	BRETT E. JONES	ISSUED FOR CONSTRUCTION

DESIGNED BY
H. BULLOCK
DRAWN BY
A. GOMEZ
CHECKED BY
D. CONYERS
IN CHARGE
B. JONES
DATE
11/07/03



LOS ANGELES COUNTY METROPOLITAN TRANSPORTATION AUTHORITY
SAN FERNANDO VALLEY EAST-WEST BRT PROJECT

WASHINGTON GROUP INTERNATIONAL, INC.
5805 SEPULVEDA BLVD., SUITE 500
VAN NUYS, CA 91411

SHIMMICK
OBAYASHI, JV
5805 SEPULVEDA BLVD., SUITE 500
VAN NUYS, CA 91411

BUSWAY SEGMENT 1 EAST
DRAINAGE PLAN & PROFILE
STA 672+00 TO STA 683+00
SHEET 15 OF 20

CONTRACT NO	C0675
DRAWING NO	BIC6027
SCALE	HORIZ 1"=40' VERT 1"=10'
SHEET NO	2