
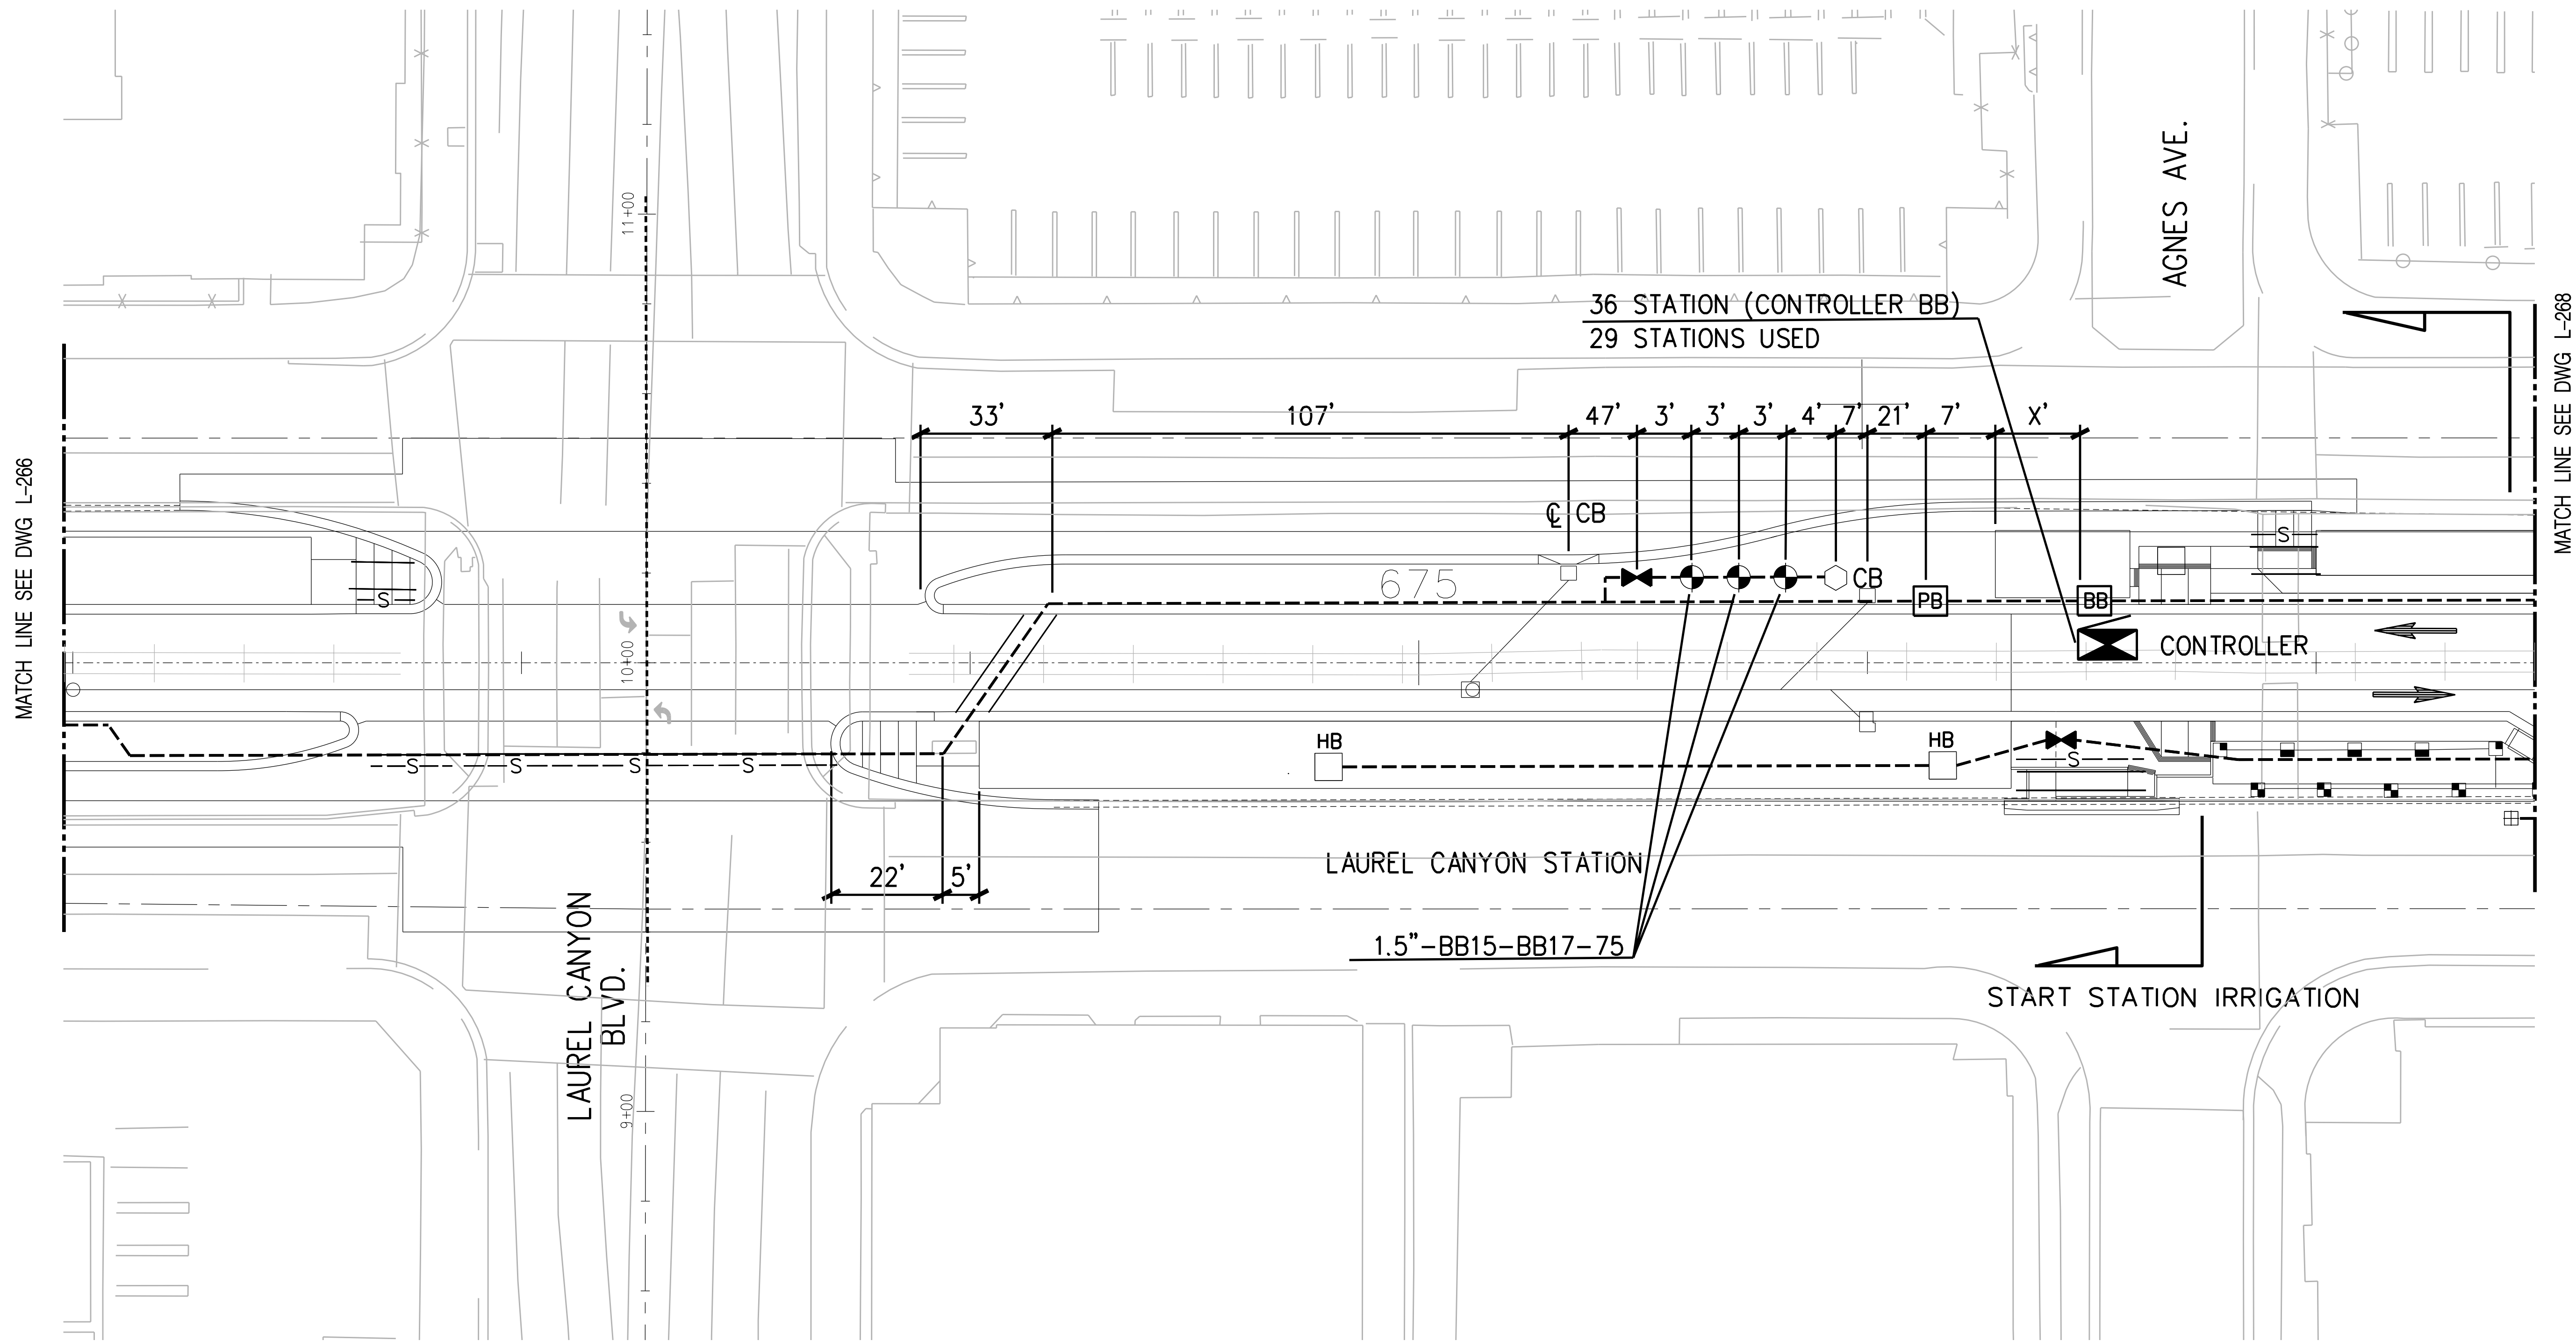


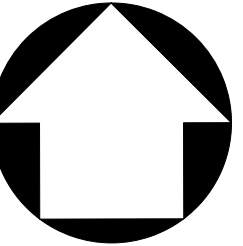

ISSUE FOR CONSTRUCTION

								DESIGNED BY MG		 LOS ANGELES COUNTY METROPOLITAN TRANSPORTATION AUTHORITY SAN FERNANDO VALLEY EAST-WEST BRT PROJECT		 TATSUMI AND PARTNERS, INC. LANDSCAPE ARCHITECTURE • PLANNING • DESIGN 5 CORPORATE PARK, SUITE 200 BURNING WOOD, CA 92506-5866 949/250-9890 FAX 949/250-9891		NORTH HOLLYWOOD TO WARNER CENTER IRRIGATION PLAN STA 672+00 TO STA 677+50 SHEET 125 OF 136		CONTRACT NO C0675	
								DRAWN BY T&P								DRAWING NO L- 267	REV 0
								CHECKED BY KLS								SCALE 1"=20'	
								IN CHARGE DT								SHEET NO	
REV	DATE	BY	APP	REG NO	EXPIRES	SEAL HOLDER	DESCRIPTION	DATE 5/23/2005									
	3/12/08						AS-BUILTS										
0	5/23/05						ISSUE FOR CONSTRUCTION										

Mike. G