


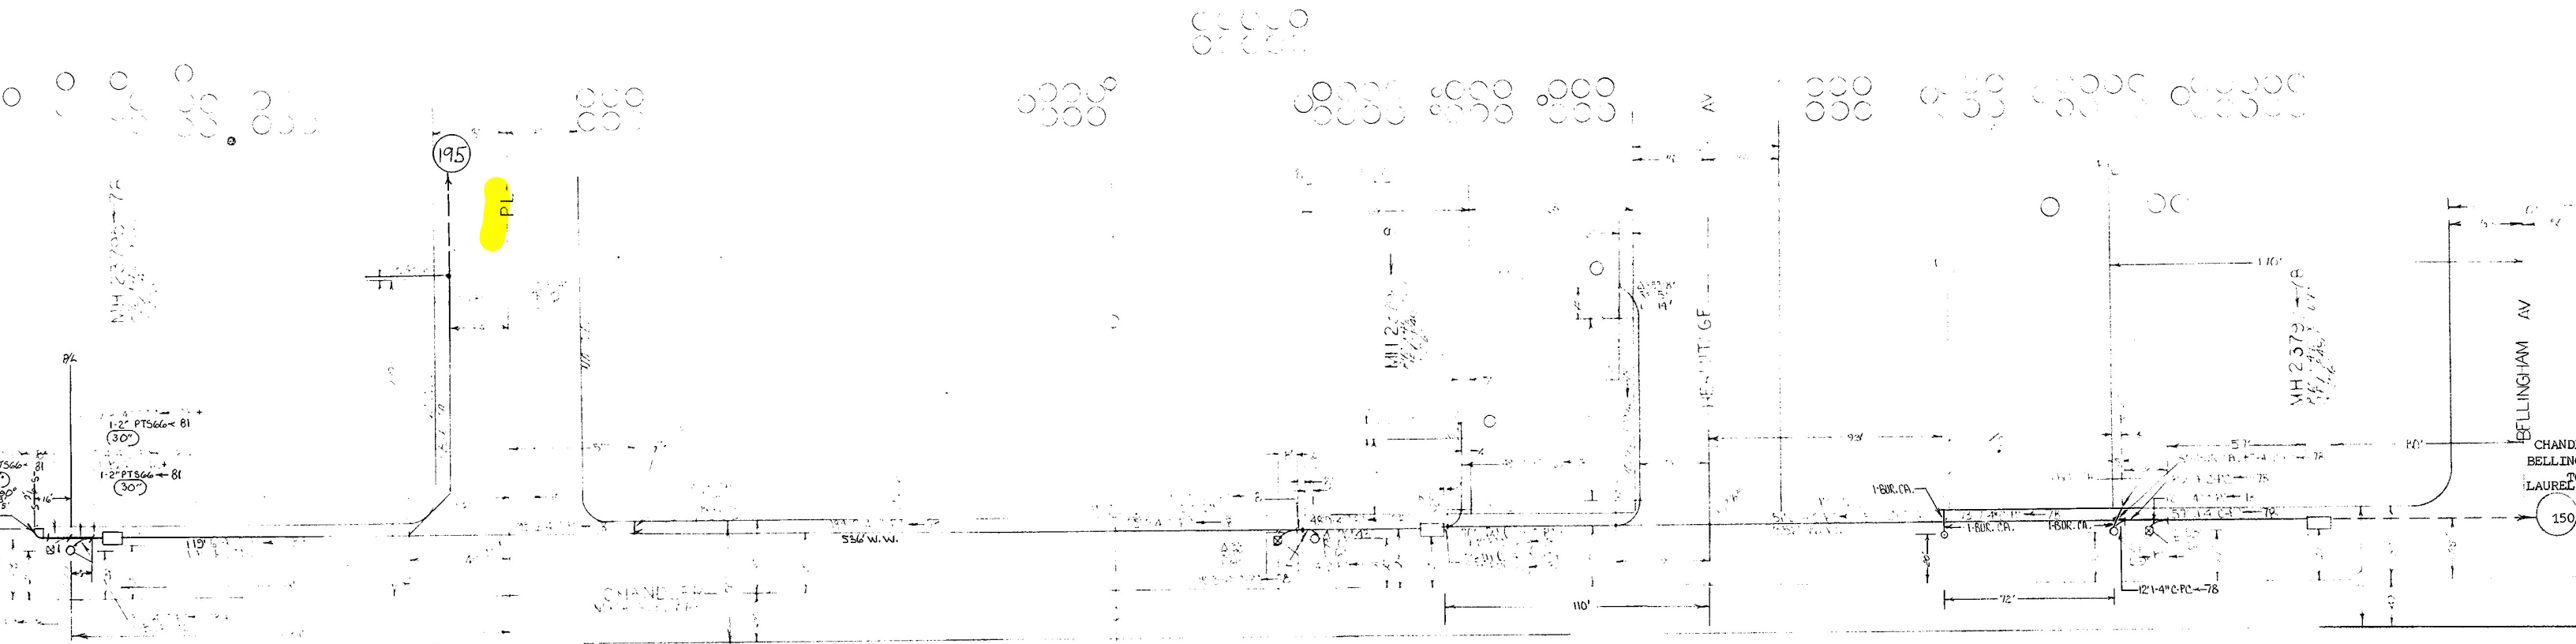

CORTEEN

1603-7482
1603-7484

**OBSOLETE
SCANNED**

SUPERSEDES:
PORT. OF CHANDLER BL. ISOLATED SCALE:
PORT. OF CHANDLER BL. ISOLATED (4-72) (2-60) 1" = 40'

R/C4 EX
THE F
EXCHANG
C.O. AREA
GEO-C.O.
CHAND
CORTEEN