

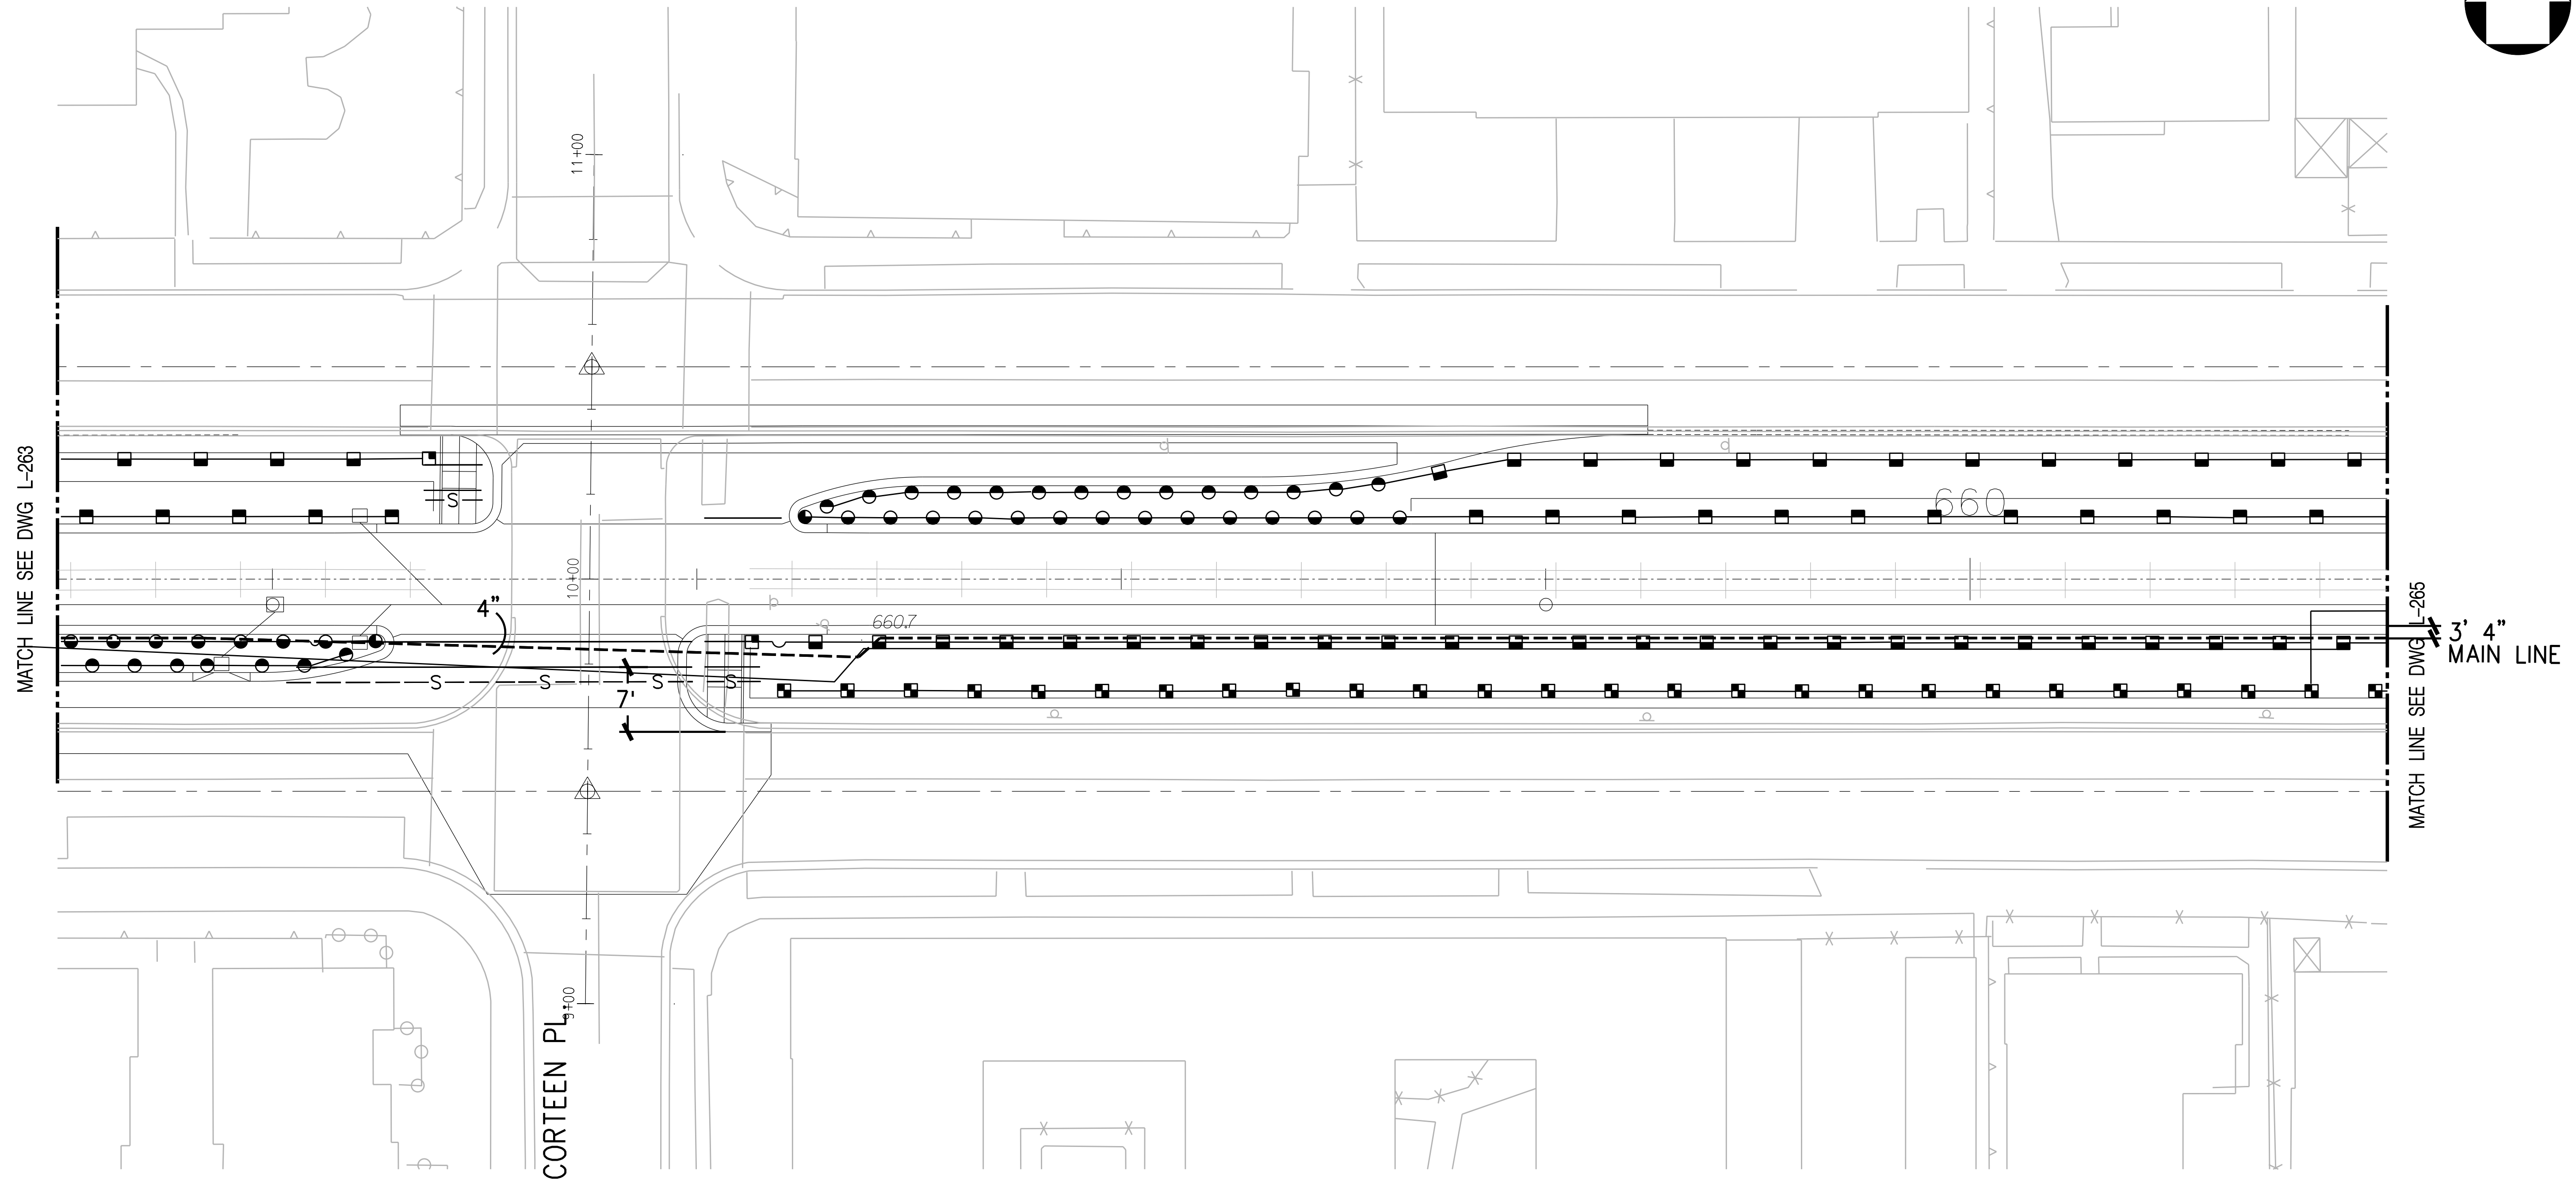


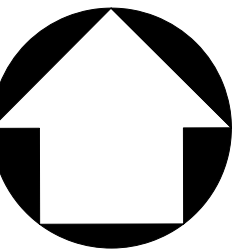

ISSUE FOR CONSTRUCTION

REV	DATE	BY	APP	REG NO	EXPIRES	SEAL HOLDER	DESCRIPTION
0	5/23/05						AS-BUILTS
							ISSUE FOR CONSTRUCTION

DESIGNED BY	MG
DRAWN BY	T&P
CHECKED BY	KLS
IN CHARGE	DT
DATE	5/23/2005

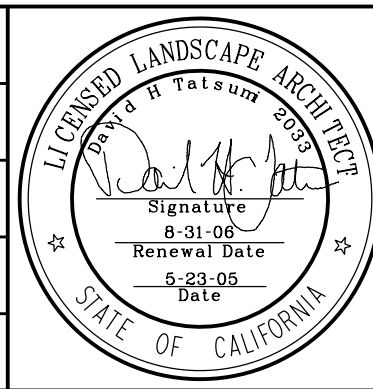



LOS ANGELES COUNTY METROPOLITAN TRANSPORTATION AUTHORITY
SAN FERNANDO VALLEY EAST-WEST BRT PROJECT



TATSUMI AND PARTNERS, INC.
LANDSCAPE ARCHITECTURE • PLANNING • DESIGN
5 CORPORATE PARK, SUITE 200
BURNING WOOD, CA 92506-5866
949/250-9890 FAX 949/250-9891

SUBMITTED BY:  DATE: _____
DAVID H. TATSUMI

NORTH HOLLYWOOD TO
WARNER CENTER
IRRIGATION PLAN
STA 655+50 TO STA 661+00
SHEET 122 OF 136

CONTRACT NO	C0675
DRAWING NO	L-264
SCALE	1"=20'
SHEET NO	

Mike. G

\$REQUEST \$TIME \$