


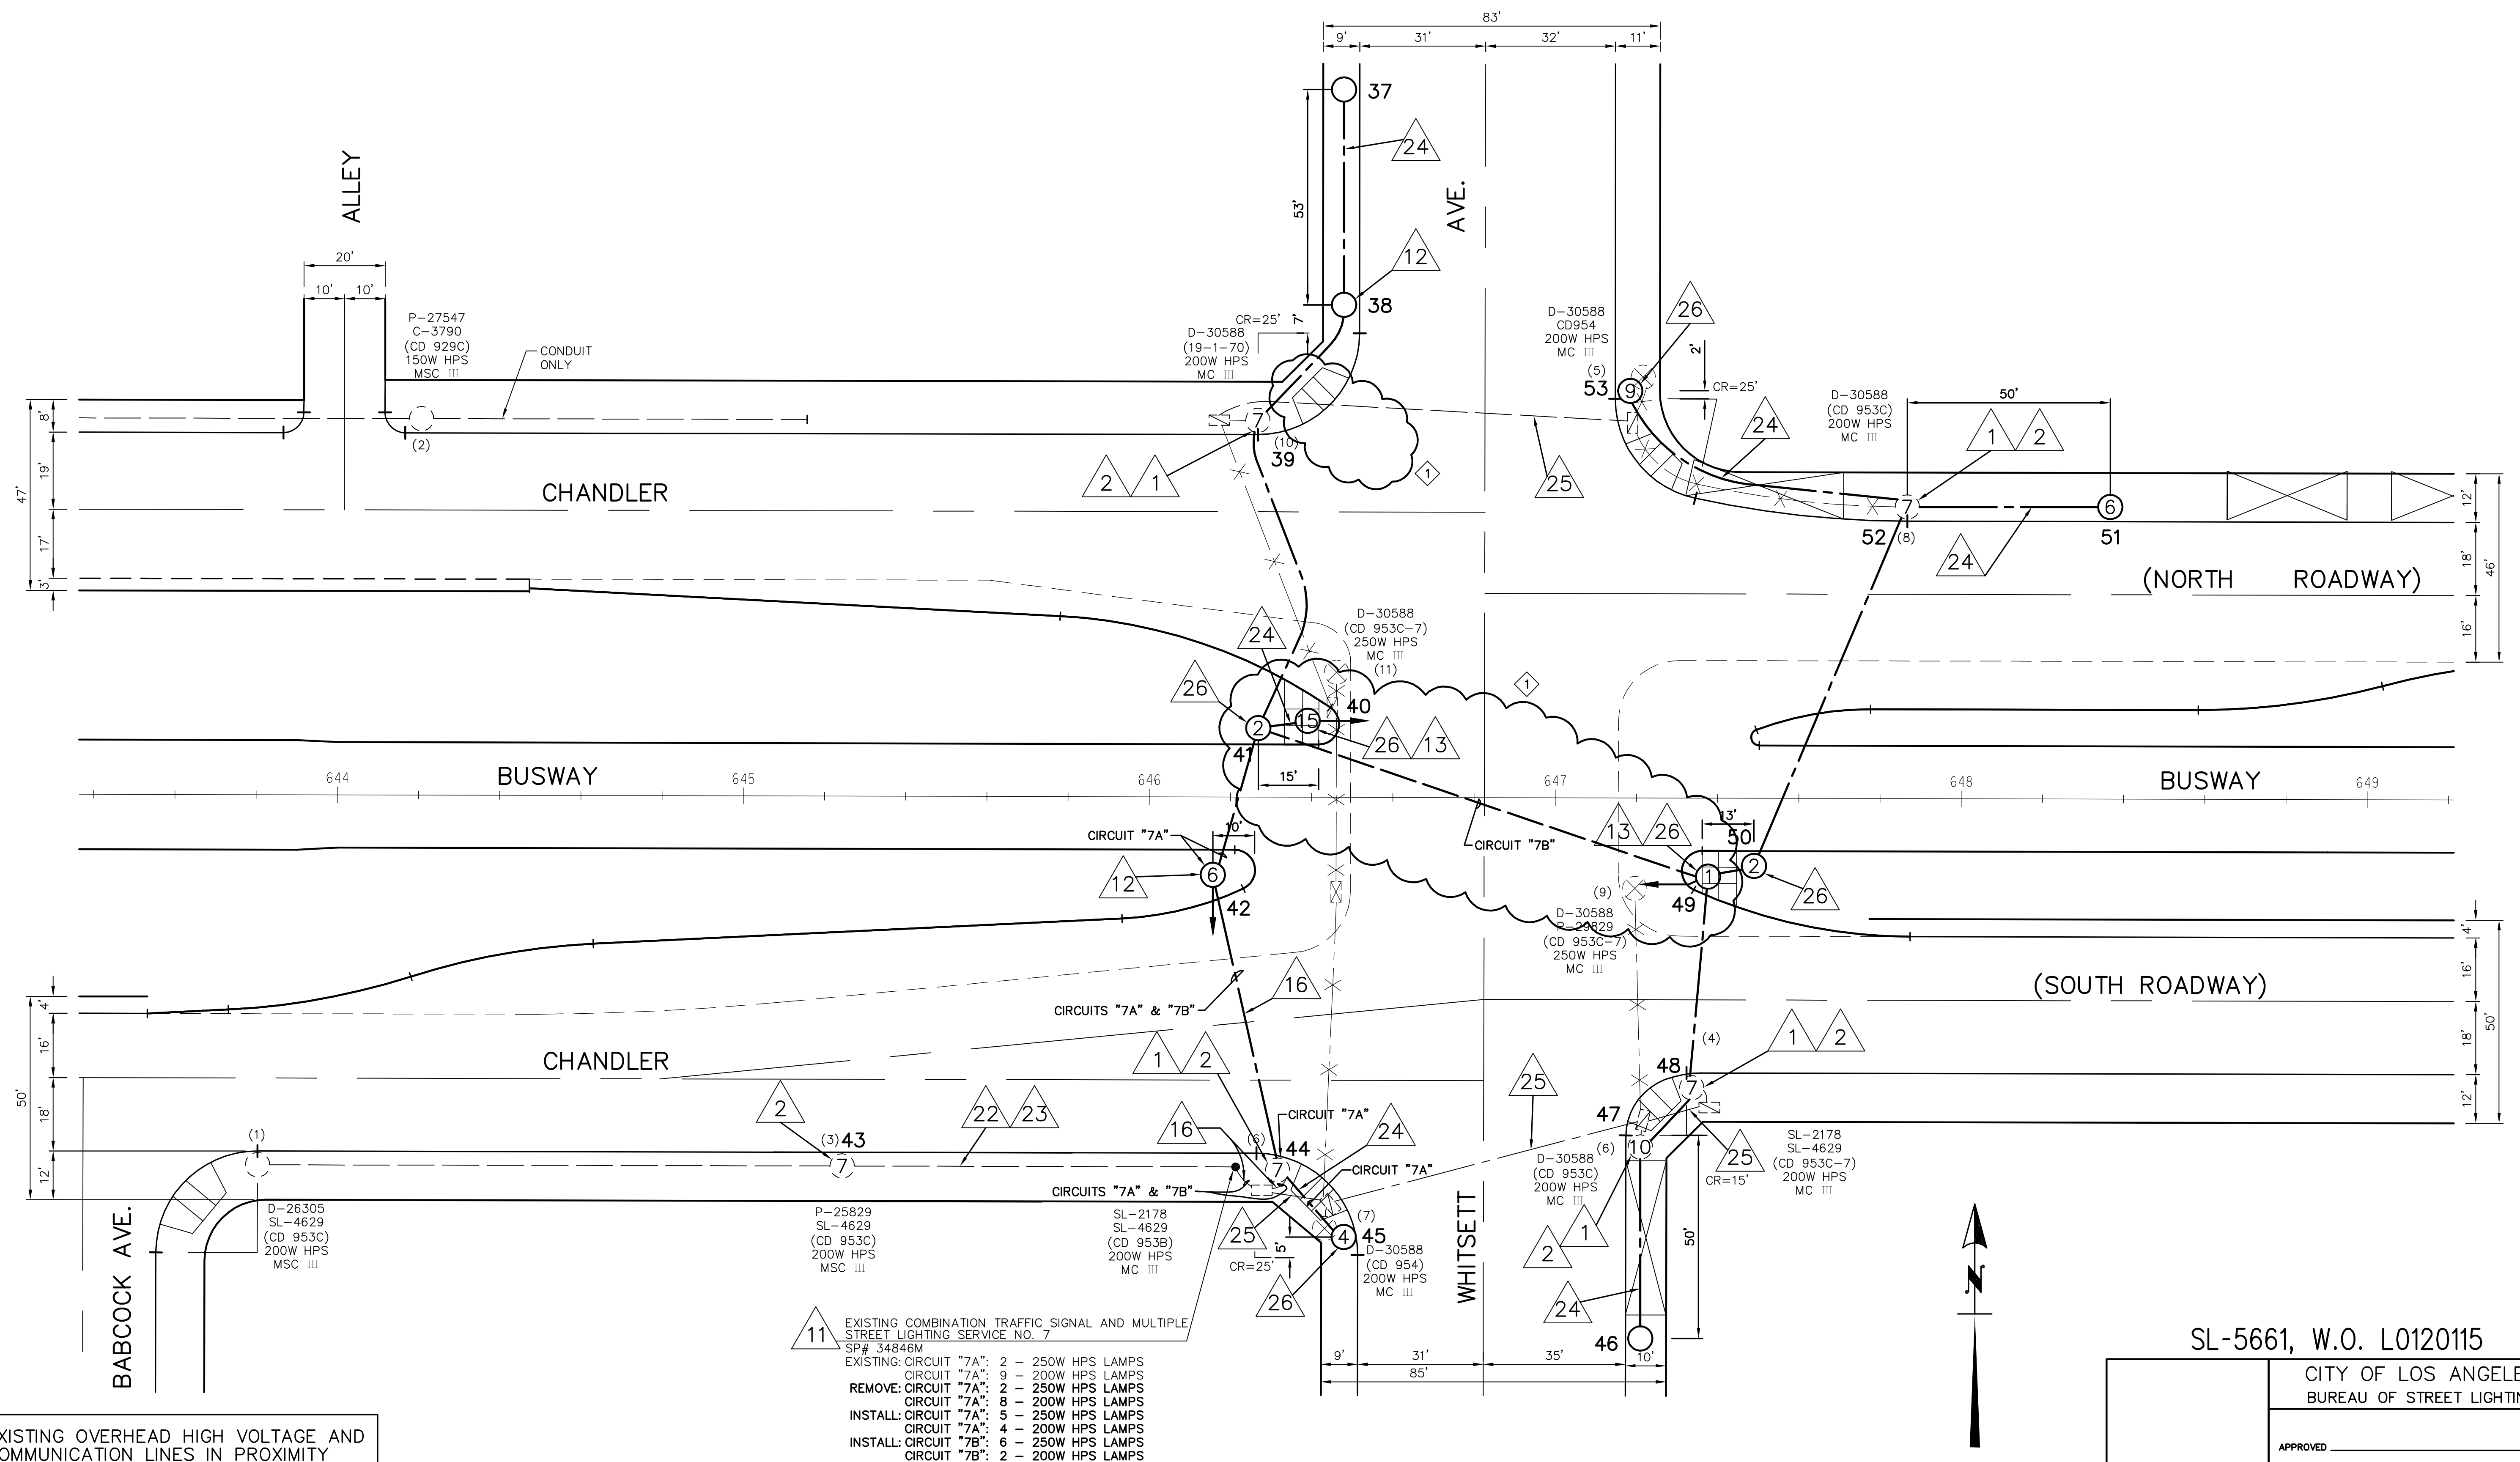

EXISTING OVERHEAD HIGH VOLTAGE AND COMMUNICATION LINES IN PROXIMITY TO PROJECT SITE. EXERCISE CAUTION WHEN INSTALLING NEW EQUIPMENT.

- 11 EXISTING COMBINATION TRAFFIC SIGNAL AND MULTIPLE STREET LIGHTING SERVICE NO. 7
- EXISTING: CIRCUIT "7A": 2 - 250W HPS LAMPS
CIRCUIT "7A": 9 - 200W HPS LAMPS
REMOVE: CIRCUIT "7A": 2 - 250W HPS LAMPS
CIRCUIT "7A": 8 - 200W HPS LAMPS
INSTALL: CIRCUIT "7A": 5 - 250W HPS LAMPS
CIRCUIT "7A": 4 - 200W HPS LAMPS
INSTALL: CIRCUIT "7B": 6 - 250W HPS LAMPS
CIRCUIT "7B": 2 - 200W HPS LAMPS

AS-BUILT RECORD DRAWING

LOS ANGELES COUNTY METROPOLITAN TRANSPORTATION AUTHORITY
SAN FERNANDO VALLEY EAST-WEST BRT PROJECT



Katz, Okitsu & Associates
Traffic Engineers & Transportation Planners
1055 Corporate Center Drive, Suite 300
Monterey Park, California 91754-7642
Tel: (323) 260-4703 Fax: (323) 260-4705

NORTH HOLLYWOOD TO WARNER CENTER
GROUP 1 INTERSECTIONS
RESTORATION STREET LIGHTING
CHANDLER BLVD. & WHITSETT BLVD.
(SHEET 6 OF 13)

SL-5661, W.O. L0120115

CITY OF LOS ANGELES
BUREAU OF STREET LIGHTING

APPROVED _____ 20

BY _____
DIRECTOR BUREAU OF STREET LIGHTING

REV	DATE	BY	APP	REG NO	EXPIRES	SEAL HOLDER	DESCRIPTION
1	02-10-06	AXK					AS-BUILT RECORD DRAWING
0	01/28/04	EKO	WJO	52655	12/31/06	WALTER J. OKITSU	ISSUED FOR CONSTRUCTION

DESIGNED BY
E. OKITSU
DRAWN BY
J. BERNAL
CHECKED BY
D. YEH
IN CHARGE
W. OKITSU
DATE
01-28-04

SEGMENT NO
C0675
DRAWING NO
G1SL-006
SCALE
1" = 20'
SHEET NO