

SIGNAL STANDARD SCHEDULE					
No.	TYPE	FOUND. TYPE	PED. PUSH BUTN TYPE	PHASE	REMARKS
(1) 332 CAB.	F-332(E)				ATSAC 2070 CONTROLLER IN 332 CAB.
(2) 19-1-70	CIDH**				25' M.A., INSTALL PPB
(3) 1A	F-1(E)				
(4) CD953C*					
(5) CD954	F-2(E)				20' M.A.
(6) 1	F-1				
(7) 1A	F-1				
(8) CD954	F-2				CUSTOM 12' M.A. & SIGN DETAIL "B"
(9) 29-5-80	CIDH**				50' M.A., F1=15', F2=12' & SIGN DETAIL "A"
(10) 7	F-7		PTM		
(11) 1	F-1				
(12) CD953C-7	F-2				15' M.A., INSTALL PPB
(13) CD953C*					
(14) CD954	F-2(E)				20' M.A.
(15) CD953C*					INSTALL PPB
(16) CD953C*					
(17) CD954	F-2				CUSTOM 12' M.A. & SIGN DETAIL "B"
(18) 26-4-80	CIDH**				40' M.A., F1=15', F2=12' & SIGN DETAIL "A"
(19) 7	F-7		PTM		
(20) 1	F-1				

(E) = EXISTING
 * For reference only; see Street Lighting sheet
 ** CIDH Pile Foundation as per Caltrans Standard Plans.

BUS
COMING

LED SIGN
DETAIL "A"
Not to Scale
LED SIGN SHALL BE PER
LADOT Std. Dwg. No. S-58.13A

ESTIMATED MATERIAL FURNISHED BY LADOT	
UNITS	MATERIAL
1	ATSAC 170 CONTROLLER IN 332 CABINET
ALL	REMOVED LED PED HEADS


ESTIMATED SALVAGE MATERIAL TO BE RETURNED TO LADOT	
UNITS	MATERIAL
1	ATSAC 170 CONTROLLER IN 332 CABINET
ALL	REMOVED LED PED HEADS

CONDUCTOR SCHEDULE	
SIZE No.	CABLE / WIRE
5	CONDUCTOR CABLE 5 X #14
9	CONDUCTOR CABLE 8 X #14 & 1 X #12 (COM)
12	CONDUCTOR CABLE 11 X #14 & 1 X #12 (COM)
28	CONDUCTOR CABLE 27 X #14 & 1 X #10 (COM)
6	SERVICE
14	PED PUSH BUTTON
16	DLC (2 PAIR)
12	BUS DLC (1 PAIR)
22	INTERCONNECT (12 PAIR)
22	INTERCONNECT (12 PAIR)(E)
CONDUIT SIZE	
(E) = Existing	

- NOTES :
- SEMI-ACTUATED OPERATION (ATSAC 2070 CONTROLLER WITH TRANSIT PRIORITY IN 332 CABINET)
 #1- CHANDLER BLVD EB LT
 #2 - CHANDLER BLVD WB & N/S PED XING
 #3 - WHITSETT AVE NB LT (APPROACH)
 #4 - WHITSETT AVE SB (APPROACH) & W/S PED XING
 #5 - CHANDLER BLVD WB LT.
 #6 - CHANDLER BLVD EB & S/S PED XING
 #7 - WHITSETT AVE SB LT (APPROACH)
 #8 - WHITSETT AVE NB (APPROACH) & E/S PED XING
 OLA (#1 & #8) - WHITSETT AVE NB (DEPARTURE)
 OLB (#4 & #5) - WHITSETT AVE SB (DEPARTURE)
 OLC (#3) - WHITSETT AVE NB LT (DEPARTURE)
 OLD (#7) - WHITSETT AVE SB LT (DEPARTURE)
 BRT A - BUSWAY WB
 BRT B - BUSWAY EB
 VICTORY CORRIDOR EAST ATSAC SYSTEM
 DIRECT WIRE (CABLE) INTERCONNECT
 - REMOVE CONTROLLER AND 332 CABINET. RETAIN F-332 FOUNDATION.
 - INSTALL ATSAC 2070 CONTROLLER IN 332 CABINET. THE CONTRACTOR SHALL PROVIDE A COMPLETE FUNCTIONING CONTROLLER ASSEMBLY AND CABINET CONFORMING TO THE LATEST LADOT SPECIFICATION FOR 2070 CONTROLLER. CONTRACTOR TO DELIVER COMPLETELY ASSEMBLED CONTROLLER FOR TESTING TO THE DEPARTMENT OF TRANSPORTATION GENERAL SHOP, PIPER TECHNICAL CENTER, 555 RAMIREZ STREET THIRTY (30) DAYS PRIOR TO INSTALLATION. CONTRACTOR TO PICK UP AND INSTALL CONTROLLER ASSEMBLY ON EXISTING F-332 FOUNDATION. INSTALL TRANSIT PRIORITY SENSOR UNITS IN THE NEW 332 CABINETS.
 - REMOVE TRAFFIC SIGNAL EQUIPMENT, STANDARD, FOUNDATION AND PULL BOX. ABANDON CONDUITS.
 - REPLACE EXISTING SERVICE WIRES WITH 2 #6 WIRES. INSTALL A 60 AMP FUSE IN AN IN-LINE WATERPROOF FUSEHOLDER IN THE PULLBOX PER LADOT STD. DWG. NO. S-79.8. WORK ON ANY ELECTRICAL EQUIPMENT TO BE DONE ONLY IN CONJUNCTION WITH THE DWP PERSONNEL. CONTACT DWP AT (213) 367-3003 SEVEN (7) WORKING DAYS PRIOR TO BEGINNING OF WORK.
 - INTERCEPT EXISTING CONDUIT AND INSTALL PULLBOX.
 - JOIN CONDUIT & EXTEND TO THE NEW PULLBOX.
 - CONTRACTOR SHALL PROVIDE AND INSTALL LARGE STREET NAME SIGNS PER LADOT STD. DWGS. No. S-457.0 & S-466.0.
 - REMOVE TRAFFIC SIGNAL EQUIPMENT & STANDARD. REUSE FOUNDATIONS.
 - INSTALL PV HEAD AT 14' HEIGHT.
 - CONTRACTOR TO USE PELCO ASTRO BRACK OR EQUIVALENT TO INSTALL THE 3 SECTION VEHICLE HEAD BACK TO BACK ON THE M.A.
 - INSTALL STRIPING, SIGNS AND PAVEMENT MARKINGS PER LADOT DWG. No. A-3920 FOR THIS PROJECT. REMOVE ALL CONFLICTING STRIPING AND PAVEMENT MARKINGS.
 - SEE STREET LIGHTING SHEET FOR WORK ON STREET LIGHTING FACILITIES.
 - INSTALL TRANSIT PRIORITY LOOPS PER LADOT STD. DWG. No. S-70.1F AND VEHICLE LOOPS PER STD. DWG No. S-70.1A.
 - ALL NEW VEHICLE AND PEDESTRIAN TRAFFIC SIGNALS SHALL BE LED MODULES, PER LADOT SPECIFICATION 92-088-03 (LATEST EDITION).

MTA - SAN FERNANDO VALLEY RAPID BUS SYSTEM (SIGNAL RESTORATION)


REVIEWED <u>January 29, 20 04</u> <u>Ina Van Der Laan</u> Transportation Engineer	RECOMMENDED <u>January 29, 20 04</u> <u>Judy Wong</u> Senior Transportation Engineer	ACCEPTED <u>January 29, 20 04</u> <u>Thomas L. Jones</u> Principal Transportation Engineer
AS BUILT Date of Installation: <u>11-18-05</u> LADOT Inspector: <u>Alegria</u> Condition As Of: <u>11-18-05</u> LADOT Engineer: <u>J.P.</u> District: <u>EAST VALLEY</u> Thomas Guide: <u>562-F2</u>		
CITY OF LOS ANGELES DEPARTMENT OF TRANSPORTATION WAYNE K. TANDA, GENERAL MANAGER		
TITLE CHANDLER BLVD., WHITSETT AVE. & BUSWAY		
File Name 32770-P1.DWG	Intersection No. 32770	Project No. 74720
NOTICE: IF PLAN HAS NOT BEEN IMPLEMENTED WITHIN TWO (2) YEARS OF THE ACCEPTANCE DATE, IT MUST BE RESUBMITTED TO LADOT SIGNAL DESIGN SECTION FOR REVIEW AND APPROVAL.		

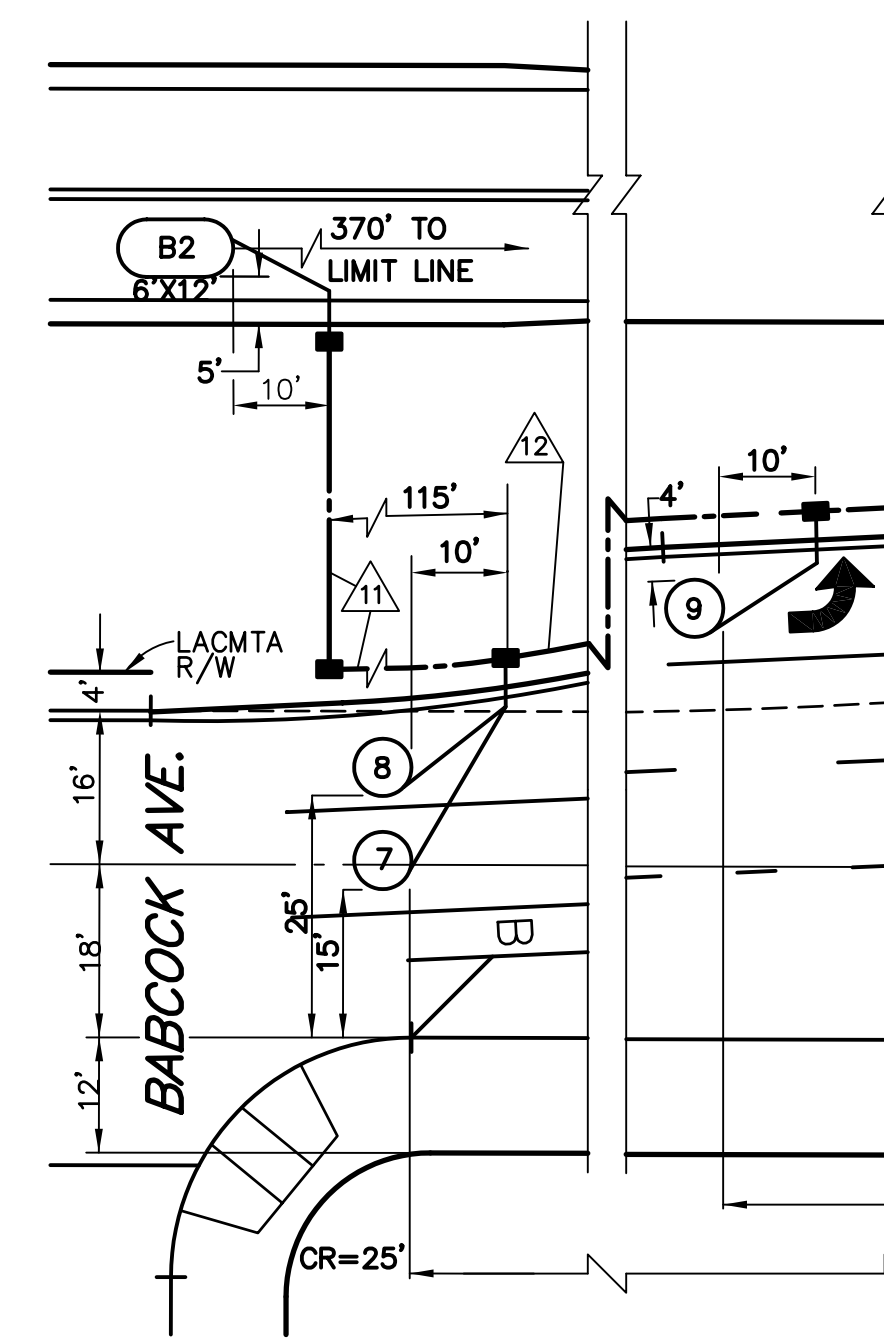

24"X18"
BUS
SIGNAL

4" CAPITAL SERIES D LETTERS
BLACK LEGEND (TYPE 7 DIAMOND GRADE/VP) ON WHITE BACKGROUND (TYPE 3 HIGH INTENSITY, REFLECTORIZED)

PROPOSED PHASE DIAGRAM

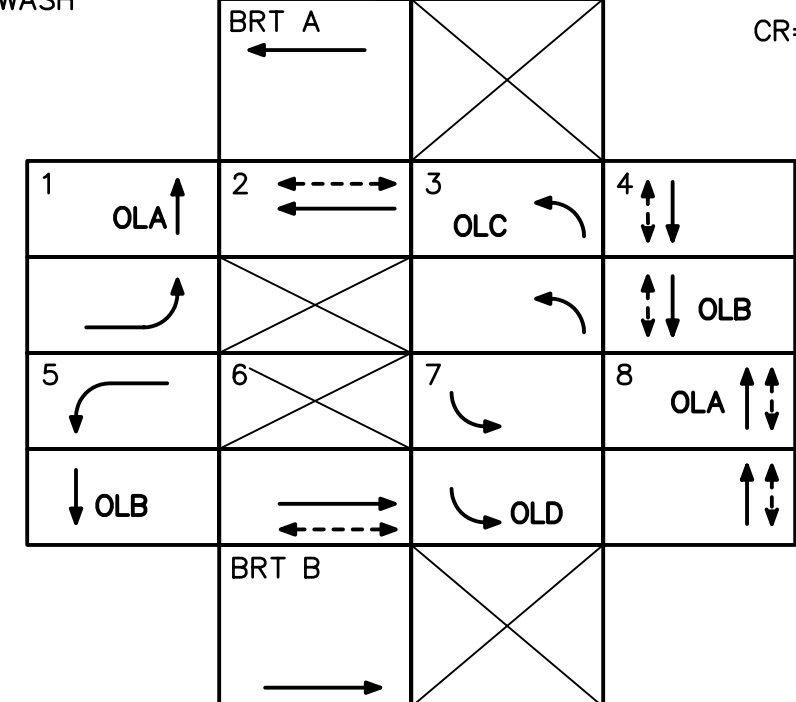

Scale: 1" = 20'
North/South: Whitsett Ave.



REV	DATE	BY	APP	REG NO	EXPIRES	SEAL HOLDER	DESCRIPTION
1	02-10-06	AXK					AS-BUILT RECORD DRAWING
0	01/28/04	JB	WJO	52655	12/31/04	WALTER J. OKITSU	ISSUED FOR CONSTRUCTION

DESIGNED BY
G. FIGUEROA
DRAWN BY
G. FIGUEROA
CHECKED BY
D. YEH
IN CHARGE
W. OKITSU
DATE
01-28-04



LOS ANGELES COUNTY METROPOLITAN TRANSPORTATION AUTHORITY
SAN FERNANDO VALLEY EAST-WEST BRT PROJECT

WASHINGTON

SHIMMICK OYASHI, JV

Katz, Okitsu & Associates
 Traffic Engineers & Transportation Planners
 1055 Corporate Center Drive, Suite 300
 Monterey Park, California 91754-7642
 Tel: (323) 260-4703 Fax: (323) 260-4705

NORTH HOLLYWOOD TO WARNER CENTER
GROUP 1 INTERSECTIONS
RESTORATION TRAFFIC SIGNAL
CHANDLER BLVD., WHITSETT AVE. AND BUSWAY

SEGMENT NO
C-0675

DRAWING NO
GITS-004

SCALE
1" = 20'

SHEET NO
1