



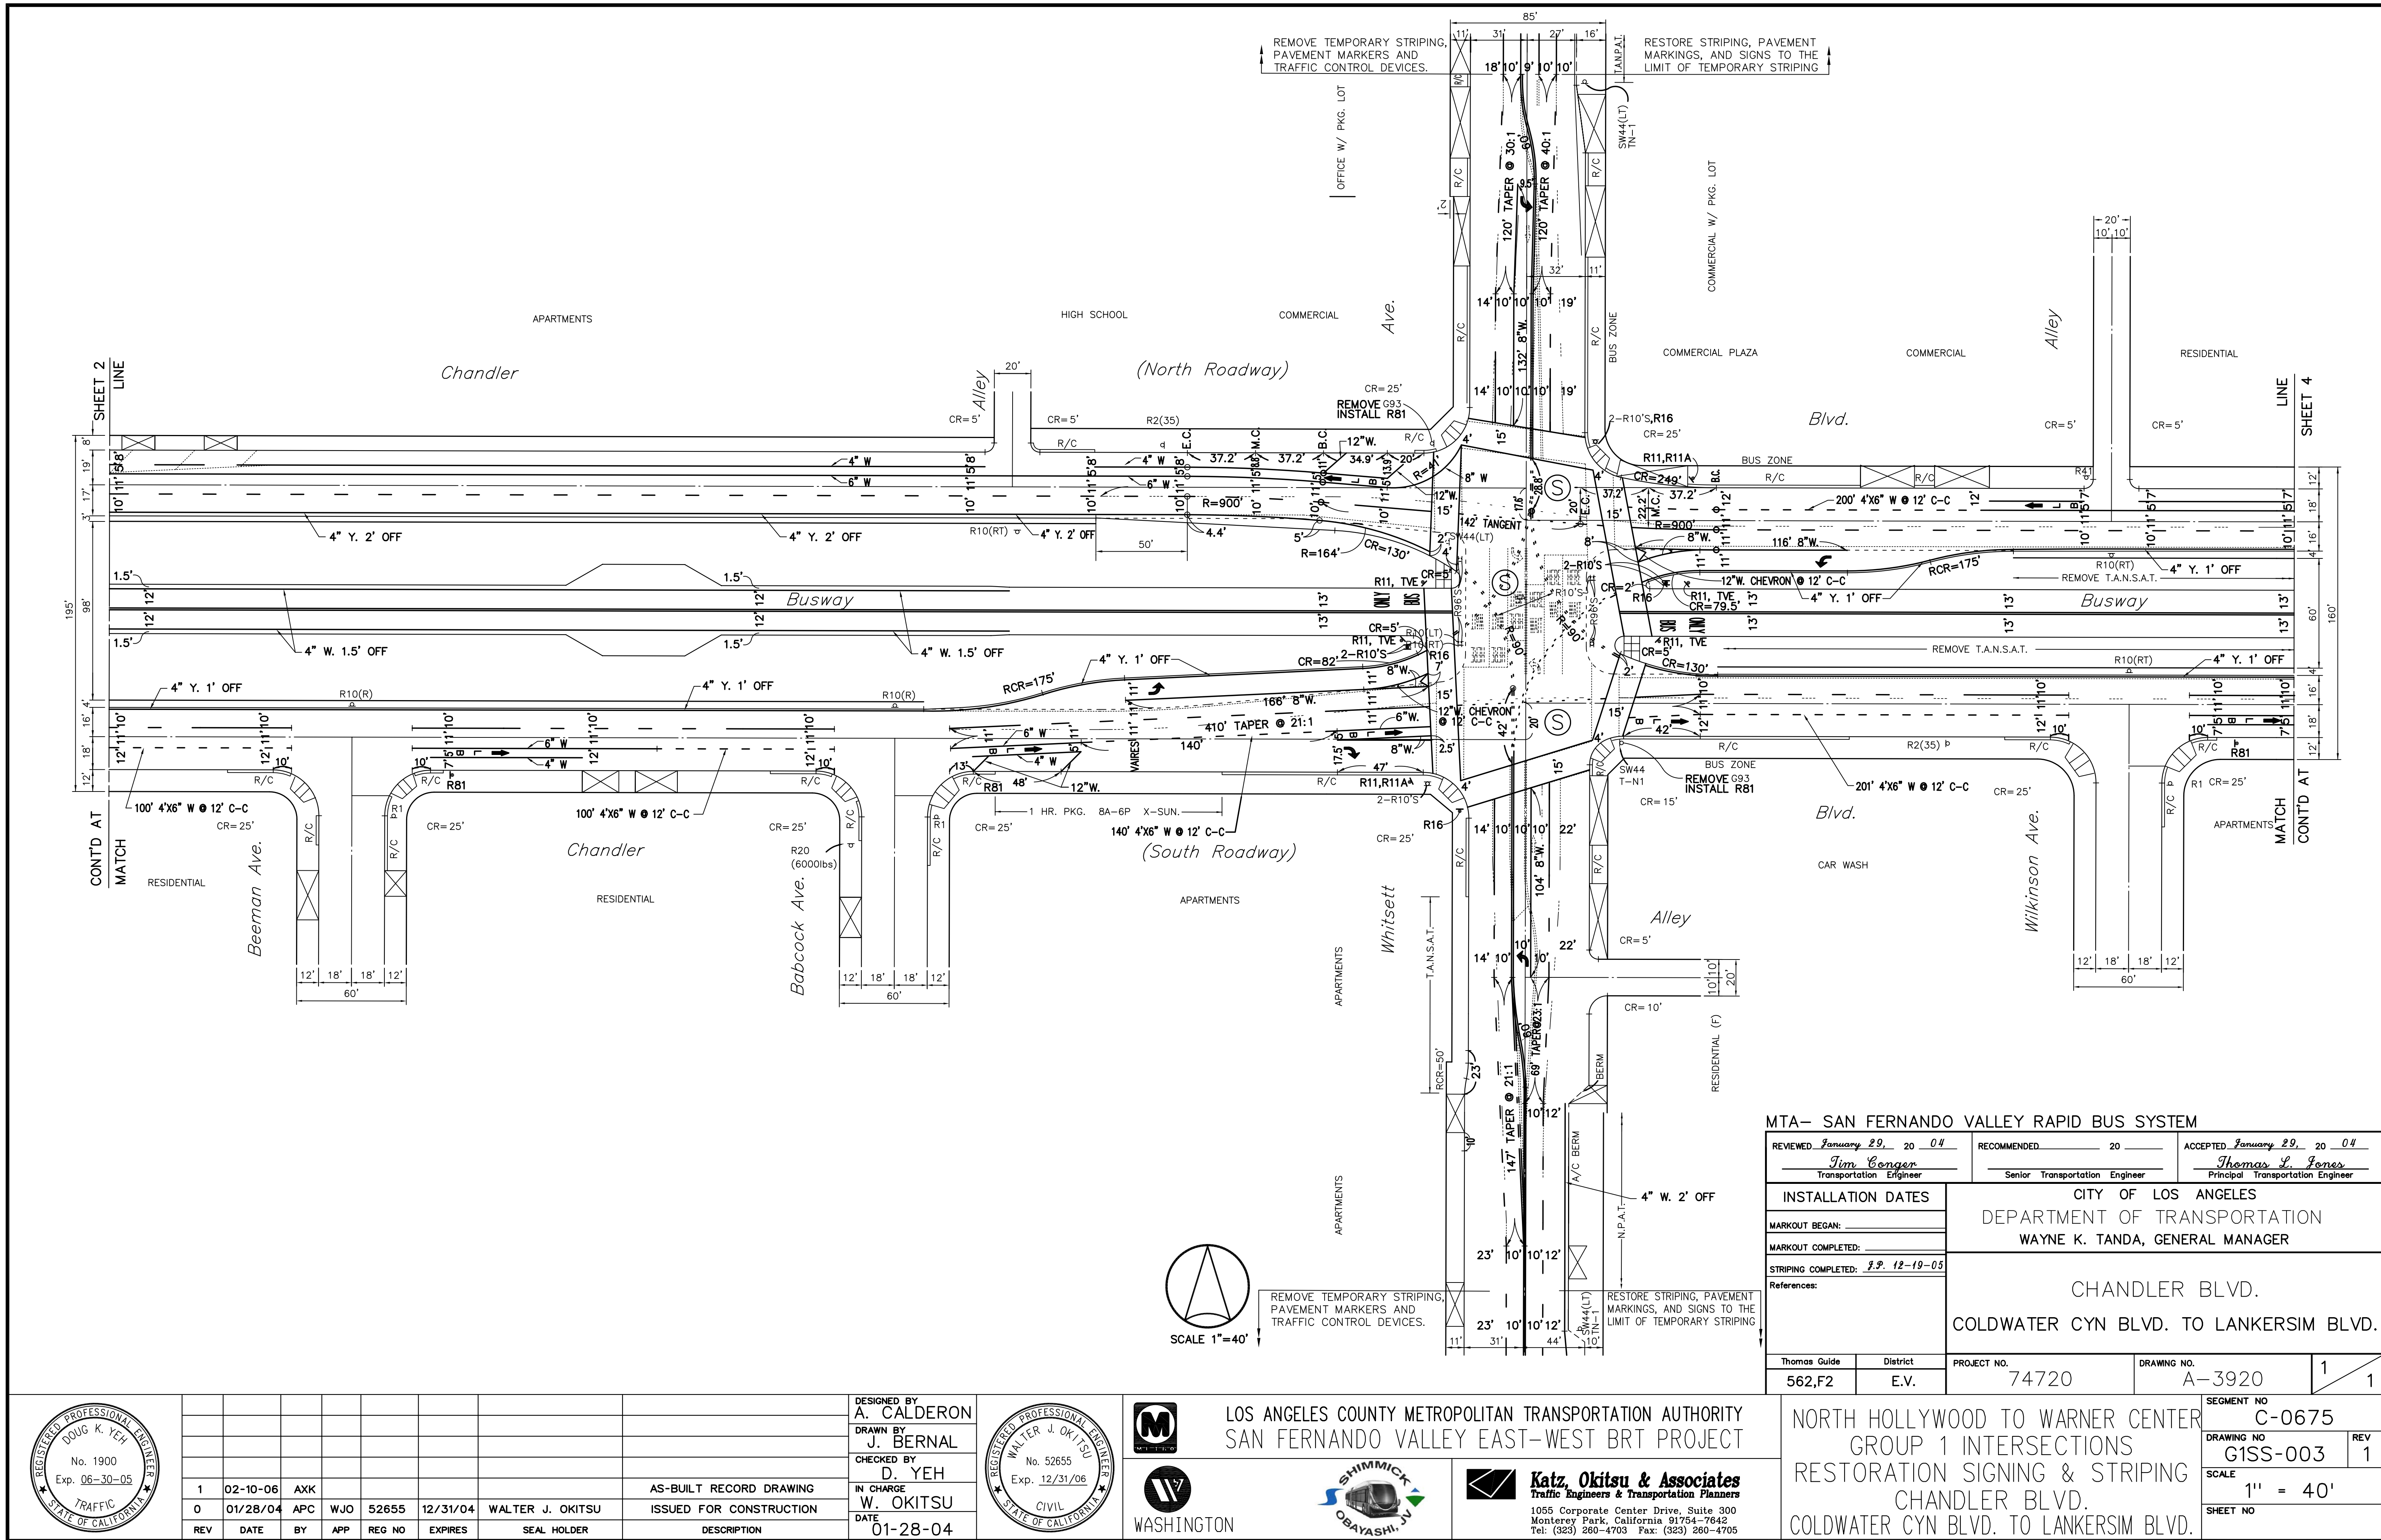

REV	DATE	BY	APP	REG NO	EXPIRES	SEAL HOLDER	DESCRIPTION
1	02-10-06	AXK					AS-BUILT RECORD DRAWING
0	01/28/04	APC	WJO	52655	12/31/04	WALTER J. OKITSU	ISSUED FOR CONSTRUCTION

DESIGNED BY
A. CALDERON
DRAWN BY
J. BERNAL
CHECKED BY
D. YEH
IN CHARGE
W. OKITSU
DATE
01-28-04

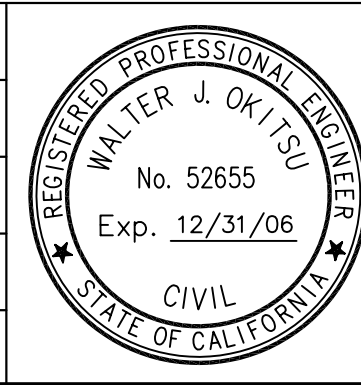

LOS ANGELES COUNTY METROPOLITAN TRANSPORTATION AUTHORITY
SAN FERNANDO VALLEY EAST-WEST BRT PROJECT



Katz, Okitsu & Associates
Traffic Engineers & Transportation Planners
1055 Corporate Center Drive, Suite 300
Monterey Park, California 91754-7642
Tel: (323) 260-4703 Fax: (323) 260-4705

MTA- SAN FERNANDO VALLEY RAPID BUS SYSTEM			
REVIEWED January 29, 20 04 Jim Conger Transportation Engineer	RECOMMENDED 20 Senior Transportation Engineer	ACCEPTED January 29, 20 04 Thomas L. Jones Principal Transportation Engineer	
INSTALLATION DATES		CITY OF LOS ANGELES DEPARTMENT OF TRANSPORTATION WAYNE K. TANDA, GENERAL MANAGER	
MARKOUT BEGAN:			
MARKOUT COMPLETED:			
STRIPING COMPLETED: 8.8. 12-19-05		CHANDLER BLVD. COLDWATER CYN BLVD. TO LANKERSIM BLVD.	
References:			
Thomas Guide	District	PROJECT NO.	DRAWING NO.
562,F2	E.V.	74720	A-3920
		SEGMENT NO.	REV
		C-0675	1
		DRAWING NO.	
		GISS-003	
		SCALE	
		1" = 40'	
		SHEET NO.	