


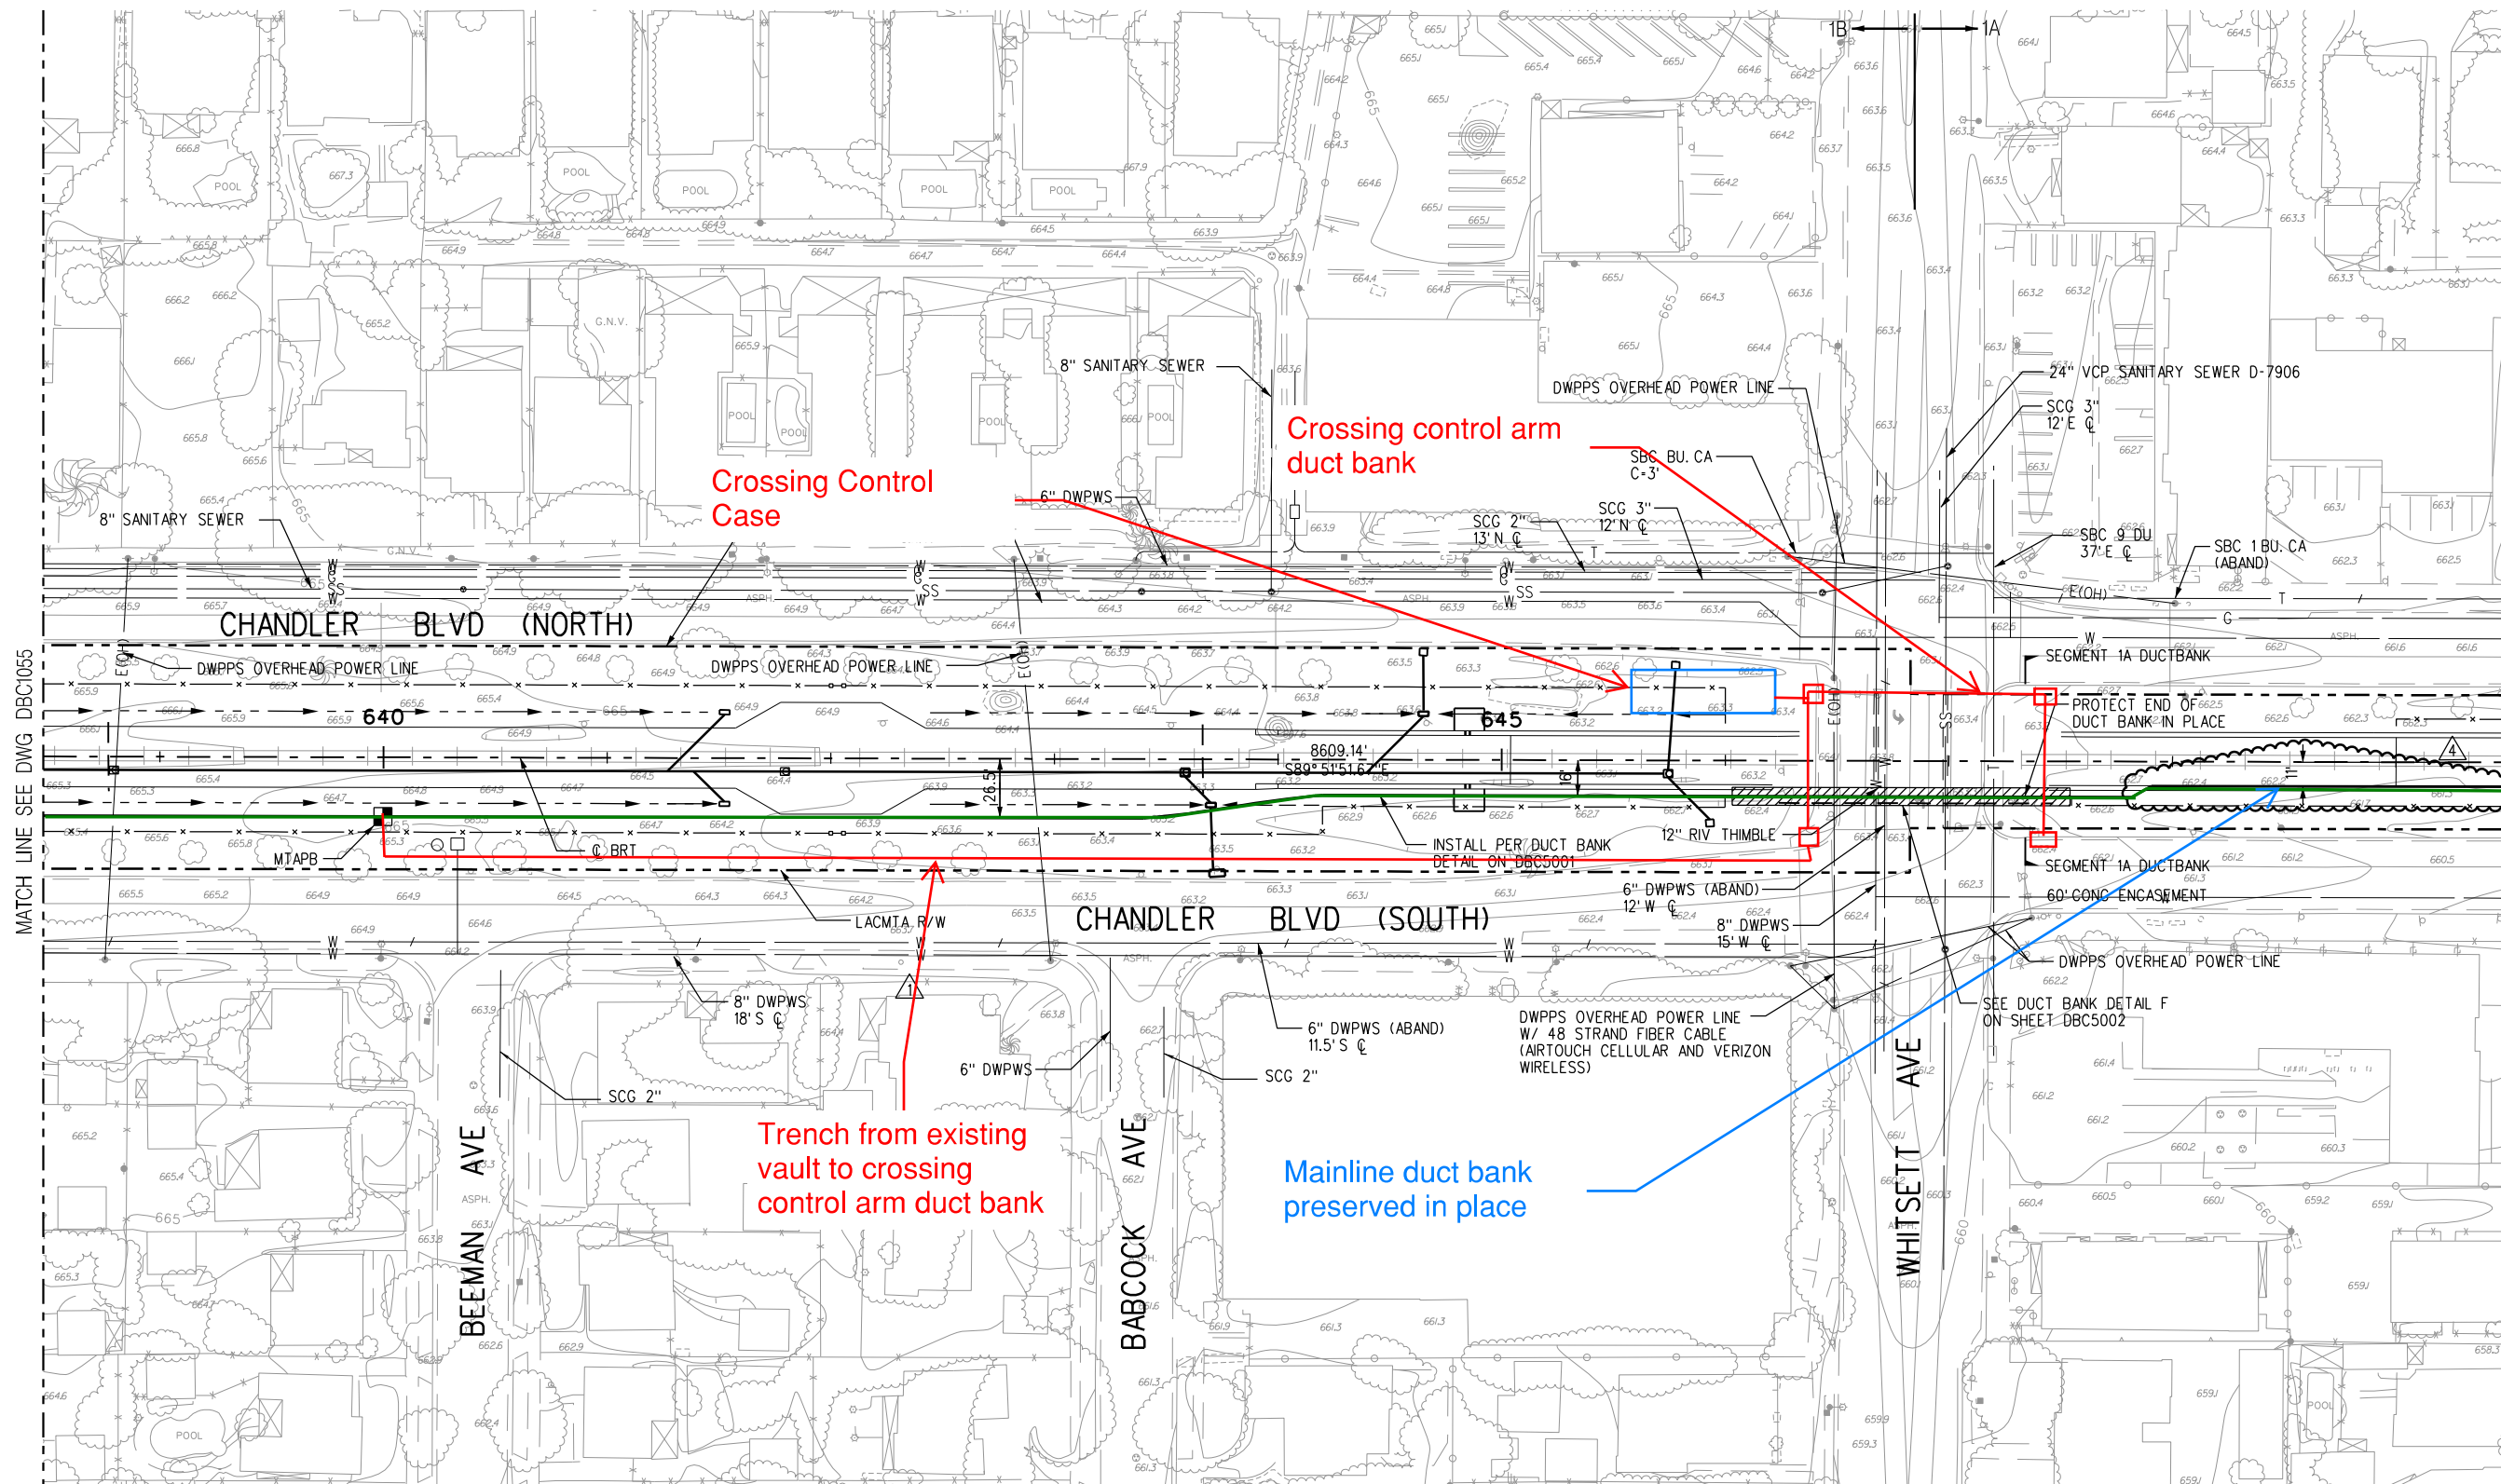


AS-BUILT RECORD DRAWING

REVIEWED AND APPROVED BY: *Garry J. Jess*
GARRY J. JESS - PROJECT MANAGER
WASHINGTON GROUP INTERNATIONAL

REV	DATE	BY	APP	REG NO	EXPIRES	SEAL HOLDER	DESCRIPTION
4	11/23/05	AU	TG				AS-BUILT RECORD DRAWING
3	3/10/04	AKJ	BEJ	C59517	12/31/04	BRETT E. JONES	INCORPORATED MTA COMMENTS - IFC
2	1/22/04	YX	BEJ	C59517	12/31/05	BRETT E. JONES	ISSUED FOR CONSTRUCTION - 1B
1	12/15/03	YX	BEJ	C59517	12/31/05	BRETT E. JONES	RESUBMITTAL IFC
0	11/7/03	YX	BEJ	C59517	12/31/03	BRETT E. JONES	ISSUED FOR CONSTRUCTION

DESIGNED BY
S. YOUSEFIAN
DRAWN BY
A. GOMEZ
CHECKED BY
D. CONYERS
IN CHARGE
B. JONES
DATE
11/12/03

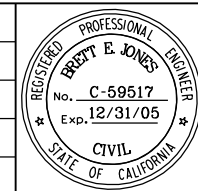

LOS ANGELES COUNTY METROPOLITAN TRANSPORTATION AUTHORITY
SAN FERNANDO VALLEY EAST-WEST BRT PROJECT

Washington Group International
WASHINGTON GROUP INTERNATIONAL, INC.
5805 SEPULVEDA BLVD., SUITE 500
VAN NUYS, CA 91411

SHIMMICK
OBAYASHI, JV
5805 SEPULVEDA BLVD., SUITE 500
VAN NUYS, CA 91411

NORTH HOLLYWOOD TO WARNER CENTER	
MAIN LINE DUCT BANK	
STA 638+48 TO STA 649+48	
CONTRACT NO	C0675
DRAWING NO	DBC1056
SCALE	HORIZ. 1"=40'
SHEET NO	4

m:\bri\irvine\AS-BUILT\TS (Merged)\MTA (WGI)\DBC\dbc1056_AS-BUILT.rpt 09/30/05 09:38:57 PM tim.groom