



Mike. G

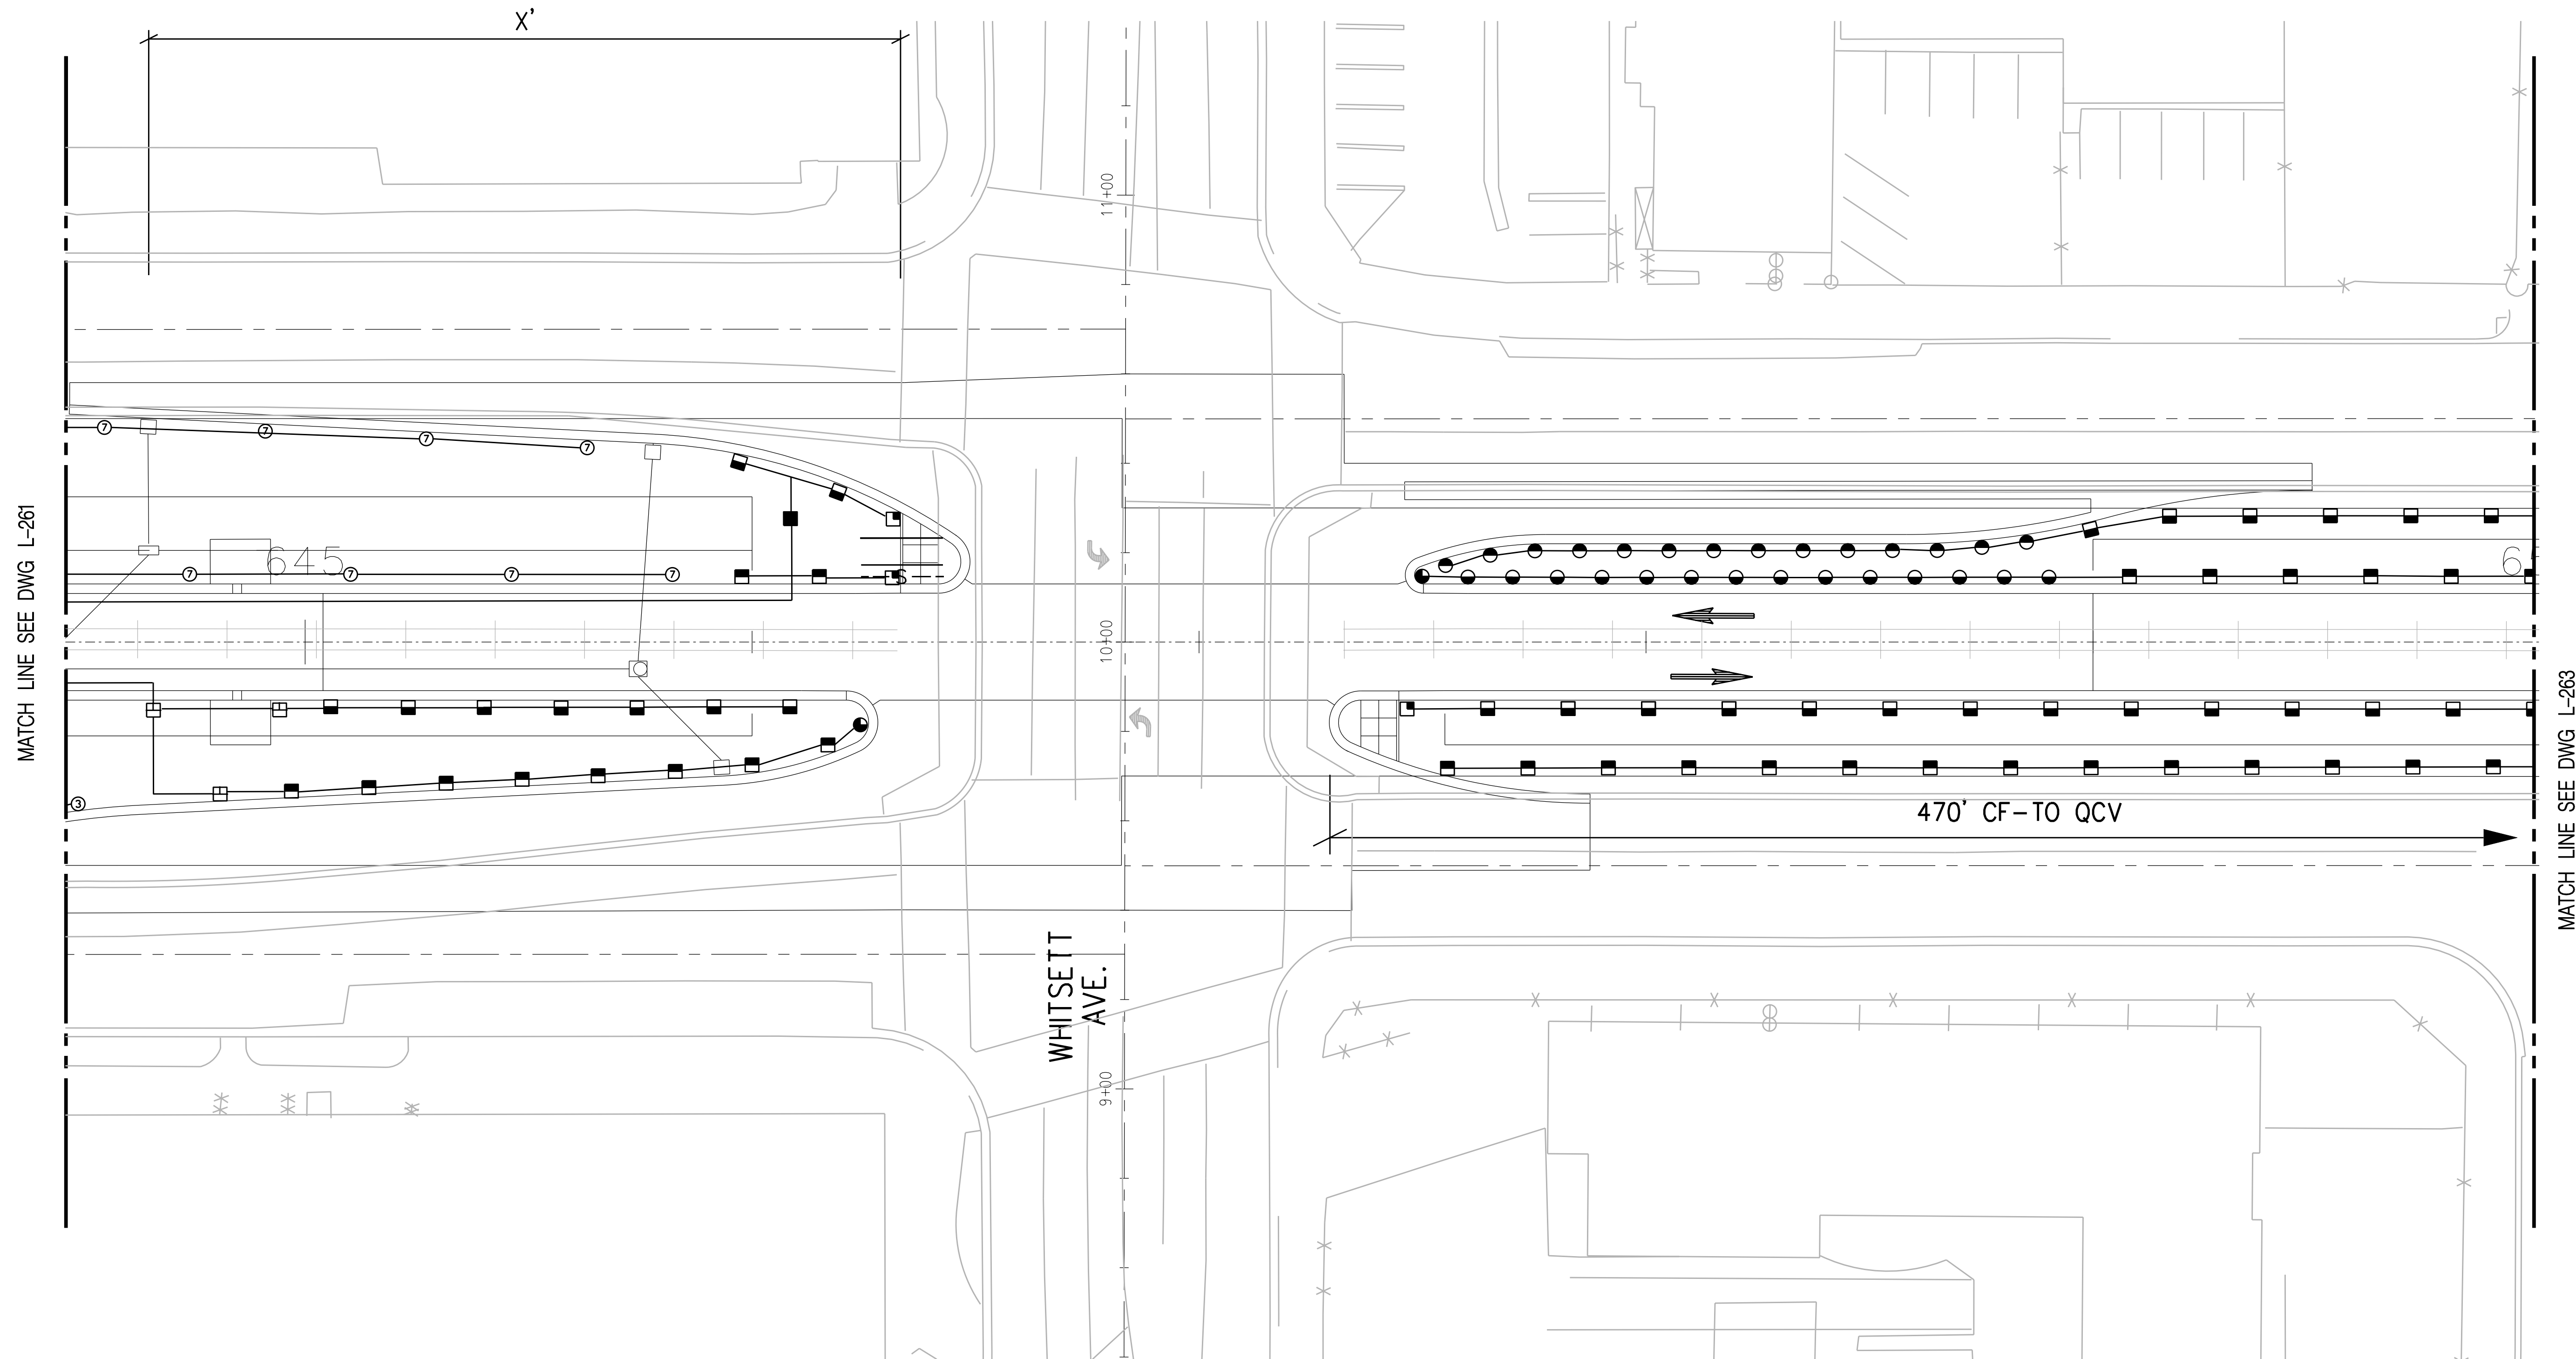

	3/12/08						AS-BUILTS
0	5/23/05						ISSUE FOR CONSTRUCTION
REV	DATE	BY	APP	REG NO	EXPIRES	SEAL HOLDER	DESCRIPTION

DESIGNED BY	MG
DRAWN BY	T&P
CHECKED BY	KLS
IN CHARGE	DT
DATE	5/23/2005

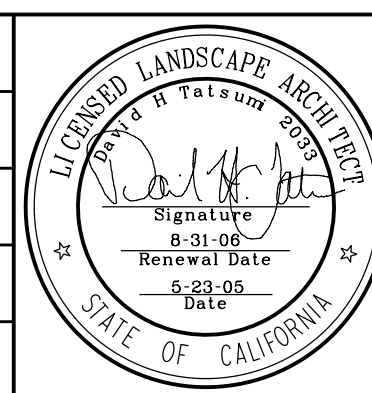

	LOS ANGELES COUNTY METROPOLITAN TRANSPORTATION AUTHORITY
	SAN FERNANDO VALLEY EAST-WEST BRT PROJECT
TATSUMI AND PARTNERS, INC.	
LANDSCAPE ARCHITECTURE • PLANNING • DESIGN	
5 CORPORATE PARK, SUITE 200 BIRME, CA 92506-5866 949/250-9890 FAX 949/250-9891	
SUBMITTED BY: 	DATE: _____
DAVID H. TATSUMI	

NORTH HOLLYWOOD TO
WARNER CENTER
IRRIGATION PLAN
STA 644+50 TO STA 650+00
SHEET 120 OF 136

CONTRACT NO		C0675
DRAWING NO	L - 262	REV 0
SCALE 1" = 20'		
SHEET NO		