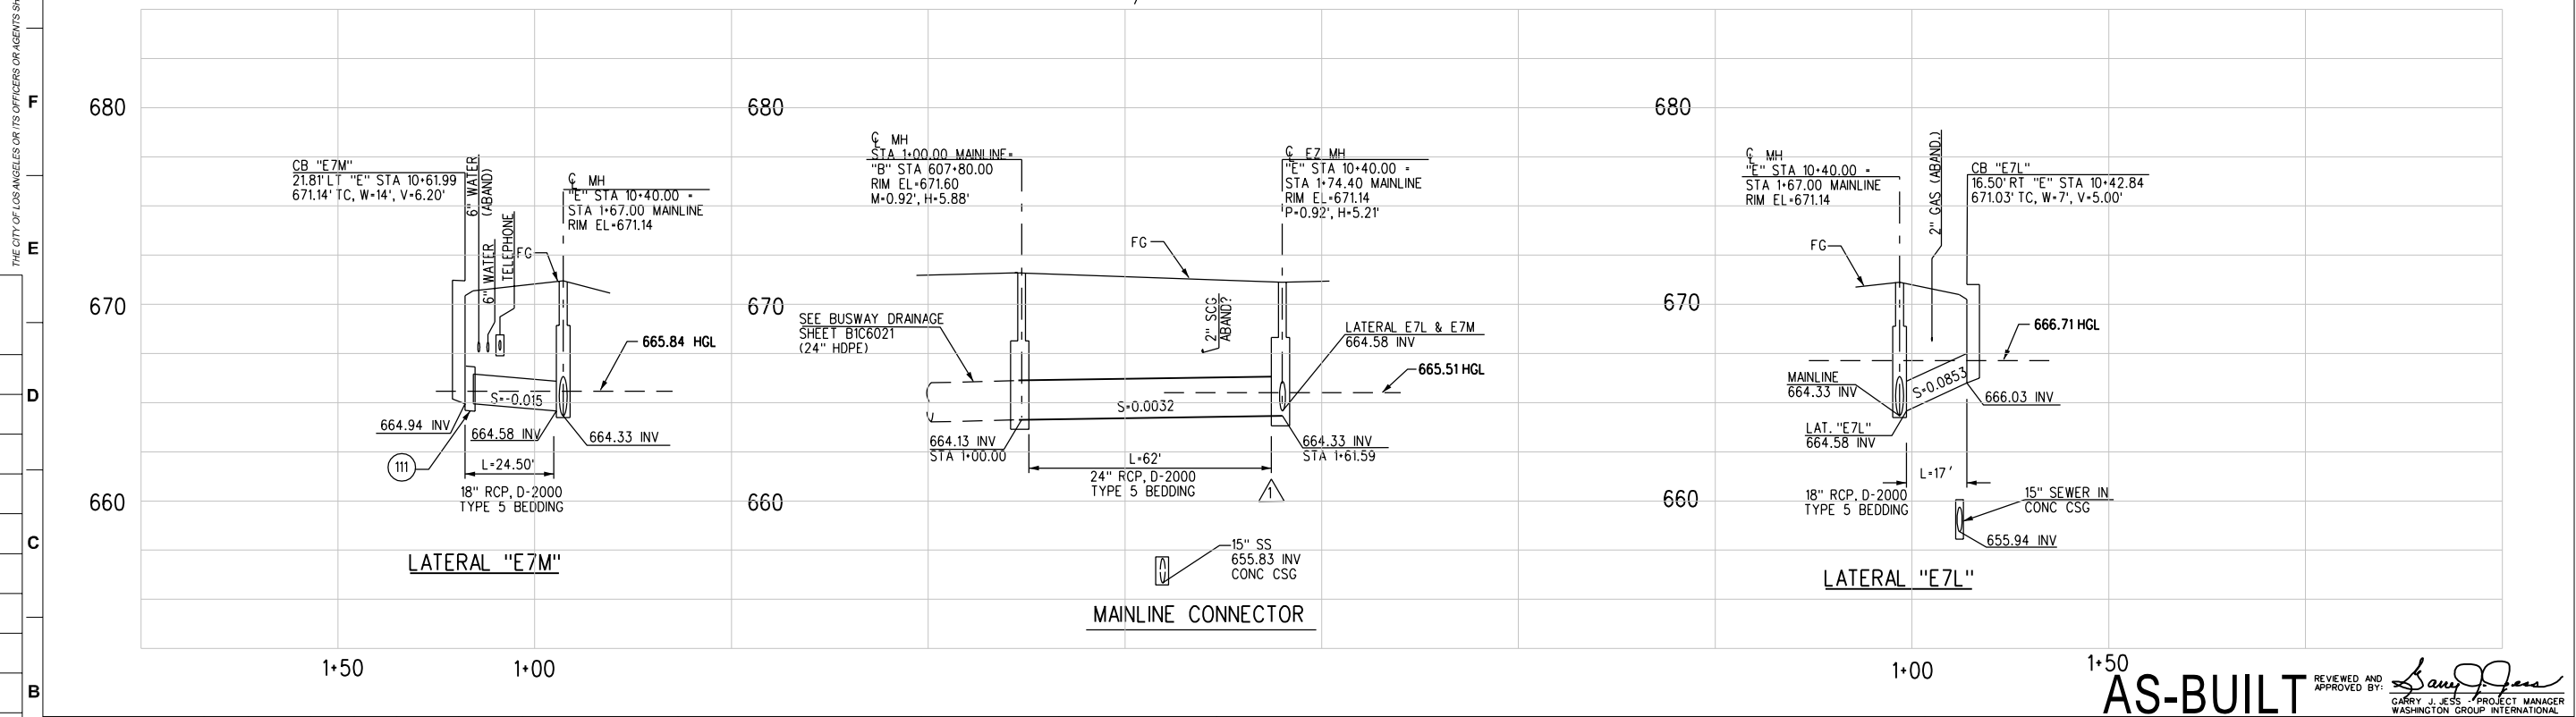
 


[illegible]

CITY OF LOS ANGELES DEPARTMENT OF PUBLIC WORKS BUREAU OF ENGINEERING			
VERTICAL CONTROL: NAV/008, 1989 ADJ HORIZONTAL CONTROL: NAD83 EPOCH 1995.0	GARY LEE MOORE, P.E. CITY ENGINEER ACCEPTED BY:		
SHEET TITLE: PLANS	DATE		
PROJECT: SAN FERNANDO VALLEY EAST-WEST PROJECT	PLAN CHECKER		
ADDRESS:	DIVISION / DISTRICT ENGINEER		
PROJECT NO.			
DRAWING NO.			
3			
SHEET 3 OF 8 SHEETS			
LA DPW ENGINEERING Sustainable Planning & Design Dedicated to the Future DATE: 6/09/04 BY: HAB			
NO. 0 REVISIONS: ISSUED FOR CONSTRUCTION 1 INCORPORATED SOJV COMMENTS-IFC 2 AS-BUILT 11/29/05 WJ WORK ACCEPTED DATE: 6/09/04 BY: HAB			
APPROVALS: ST TREES DIV. ST LIGHTING D.C.T. DATE: BY:			
INDEX NO. B - PERMITS BD/BC			