


THE CITY OF LOS ANGELES OR ITS OFFICERS OR AGENTS SHALL NOT BE RESPONSIBLE FOR THE ACCURACY OR COMPLETENESS OF ELECTRONIC COPIES OF THIS PLAN SHEET.

REVISION DATES  
(DESIGN STAGE ONLY)


Sheet Version 2.01

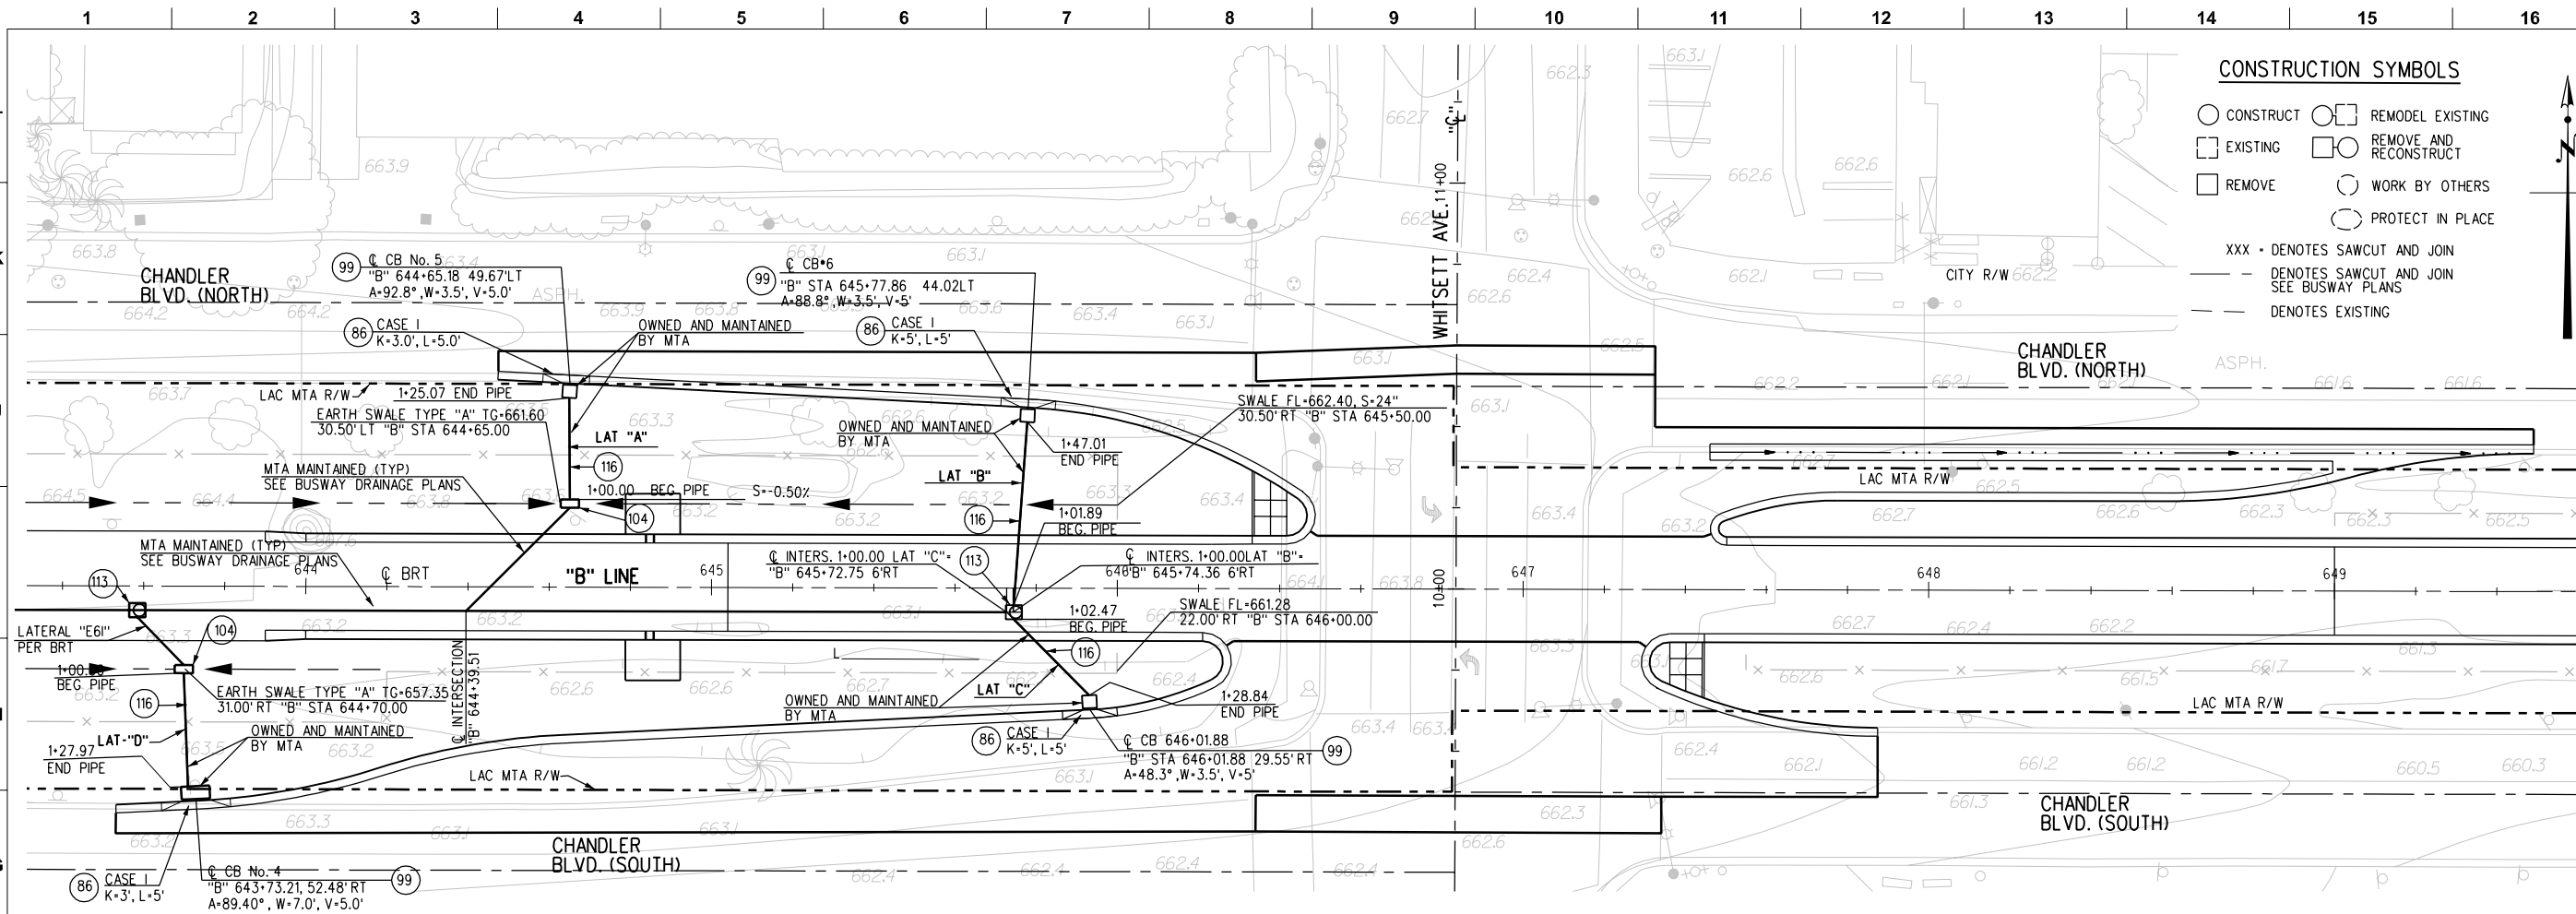

### CONSTRUCTION SYMBOLS

- CONSTRUCT
- EXISTING
- REMOVE
- REMODEL EXISTING
- REMOVE AND RECONSTRUCT
- WORK BY OTHERS
- PROTECT IN PLACE

XXX - DENOTES SAWCUT AND JOIN  
--- DENOTES SAWCUT AND JOIN  
--- SEE BUSWAY PLANS  
--- DENOTES EXISTING

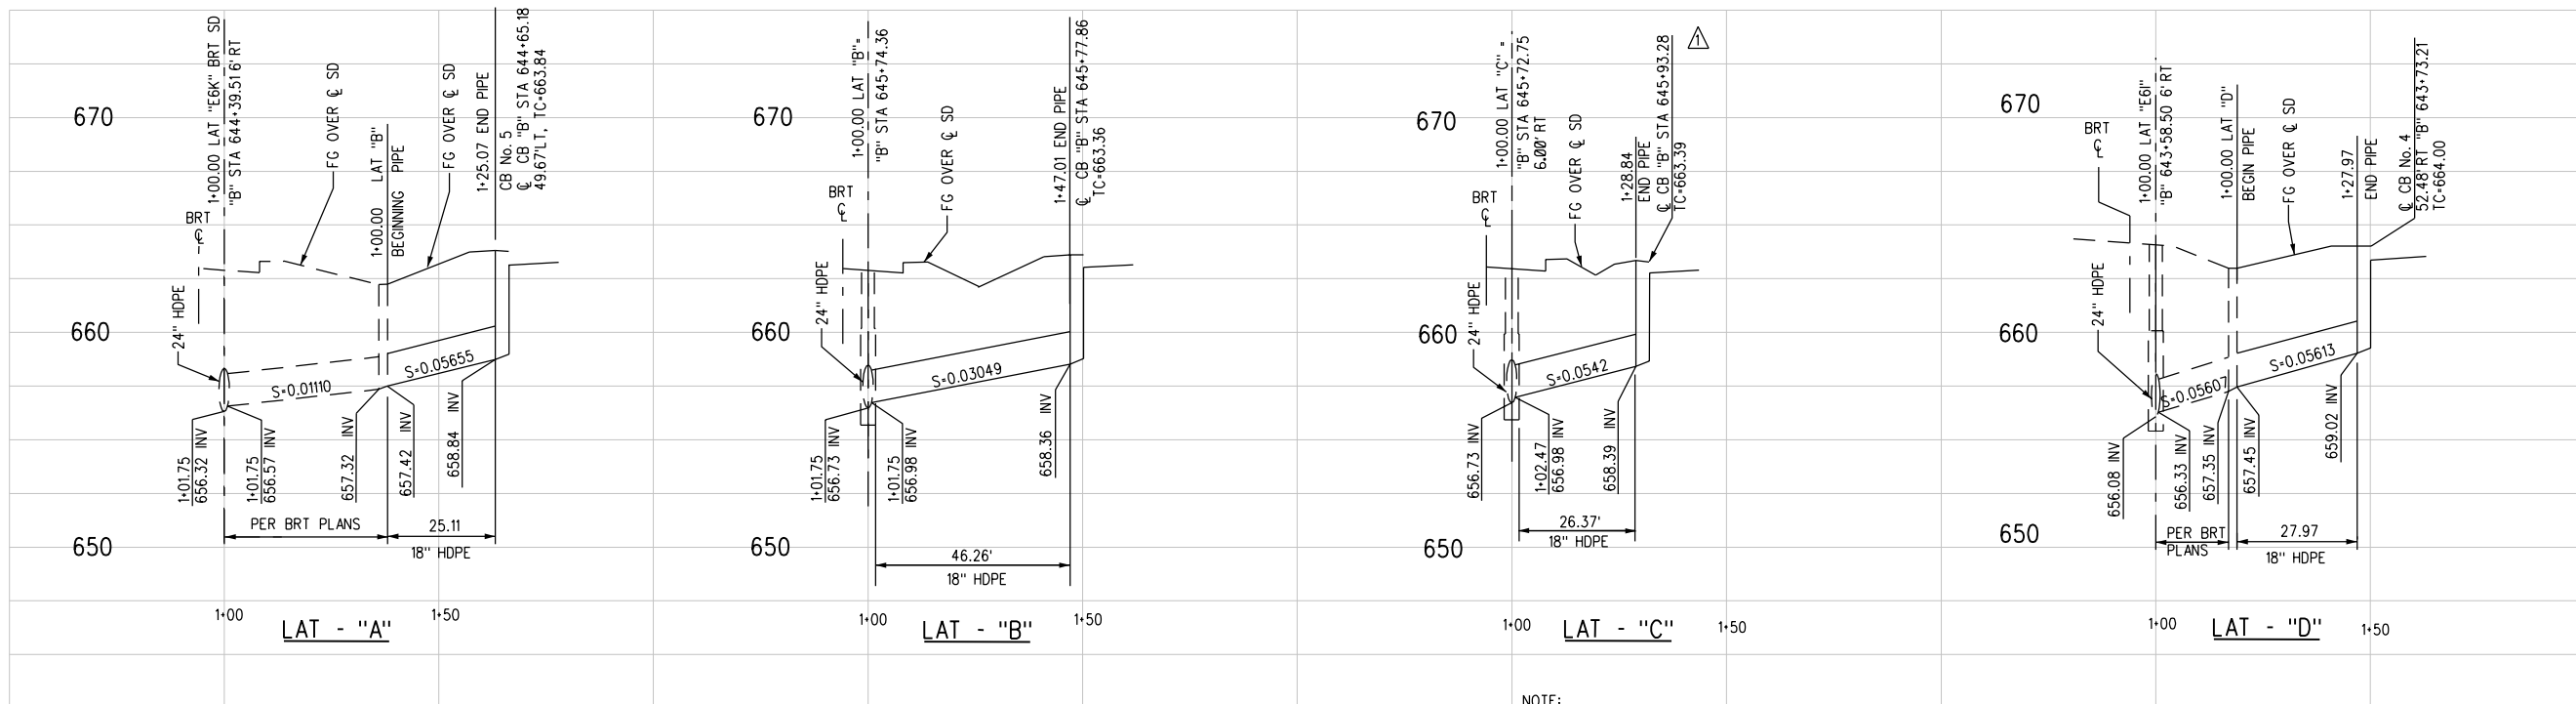


NOTE:  
ALL STORM DRAIN FACILITIES OWNED  
AND MAINTAINED BY LACO MTA

## UNCHANGED AS-BUILT

REVIEWED AND  
APPROVED BY: *Garry Lee Moore*  
GARRY J. MOORE, PROJECT MANAGER  
WASHINGTON GROUP INTERNATIONAL

| REV | DATE    | BY  | APP | REG NO | EXPIRES | SEAL HOLDER    | DESCRIPTION                     |
|-----|---------|-----|-----|--------|---------|----------------|---------------------------------|
| 0   | 1/14/04 | DAO | BEJ | C56818 | 6/30/05 | DAVID A. ORTIZ | ISSUE FOR GROUP 1 IFC - SD ONLY |

DESIGNED BY  
T. BASHLEM  
DRAWN BY  
H. BULLOCK  
CHECKED BY  
D. ORTIZ  
IN CHARGE  
B. E. JONES  
DATE  
10-17-03

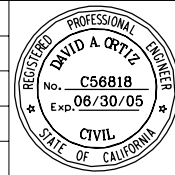

LOS ANGELES COUNTY METROPOLITAN TRANSPORTATION AUTHORITY  
SAN FERNANDO VALLEY EAST-WEST BRT PROJECT

Washington Group International  
WASHINGTON GROUP INTERNATIONAL, INC.  
5805 SEPULVEDA BLVD., SUITE 500  
VAN NUYS, CA 91411

SHIMMICK  
OBAYASHI, JV  
5805 SEPULVEDA BLVD., SUITE 500  
VAN NUYS, CA 91411

STREET IMPROVEMENTS GROUP I

STORM DRAIN PLANS & PROFILES  
CHANDLER BLVD AT WHITSETT AVE

|             |                                            |
|-------------|--------------------------------------------|
| CONTRACT NO | C0675                                      |
| DRAWING NO  | G1C6-004                                   |
| REV         | 0                                          |
| SCALE       | HORIZ. SCALE: 1"=20'<br>VERT. SCALE: 1"=4' |
| SHEET NO    |                                            |

CITY OF LOS ANGELES DEPARTMENT OF PUBLIC WORKS BUREAU OF ENGINEERING



| DATE    | BY  |
|---------|-----|
| 1/14/04 | DAO |
| 9/6/05  | TC  |

| NO | REVISIONS                       |
|----|---------------------------------|
| 0  | ISSUE FOR GROUP 1 IFC - SD ONLY |
| 1  | AS-BUILT                        |

| APPROVALS      | DATE | BY |
|----------------|------|----|
| ST. TREES DIV. |      |    |
| ST. LIGHTING   |      |    |
| D.O.T.         |      |    |

| WORK ACCEPTED | SERIAL NO. | B - PERMITS |
|---------------|------------|-------------|
|               |            | BD/BC       |

| INDEX NO. |
|-----------|
|           |

| DATE | BY |
|------|----|
|      |    |

| DATE | BY |
|------|----|
|      |    |

| DATE | BY |
|------|----|
|      |    |

| PROJECT                                  | PLAN CHECKER | DATE |
|------------------------------------------|--------------|------|
| SAN FERNANDO VALLEY<br>EAST-WEST PROJECT |              |      |

| PROJECT NO. | DIVISION / DISTRICT ENGINEER |
|-------------|------------------------------|
|             |                              |

| PROJECT NO. | DIVISION / DISTRICT ENGINEER |
|-------------|------------------------------|
|             |                              |

| DRAWING NO. | SHEET |
|-------------|-------|
|             | 4     |

| SHEET | OF | SHEETS |
|-------|----|--------|
| 4     | 9  |        |