

SIGNAL STANDARD SCHEDULE					
No.	TYPE	FOUND. TYPE	PED. PUSH BUT. TYPE	PHASE	REMARKS
(E) 1	332 CAB.	F-332			ATSAC 2070 CONTROLLER IN 332 CAB.
(E) 2	1A	F-1 (E)			
(E) 3	CD929*	*	6"	8	
(E) 4	1	F-1			
(E) 5	CD953C*	*			
(E) 6	CD954	F-2			CUSTOM 12' M.A. & SIGN DETAIL "B"
(E) 7	CD954	F-2			20' M.A. & SIGN DETAIL "A"
(E) 8	7	F-7	PTM	8	
(E) 9	1	F-1			
(E) 10	CD929C-7	F-2			15' M.A.
(E) 11	7	F-7	PTM	8	
(E) 12	1A	F-1 (E)			
(E) 13	1A	F-1 (E)			
(E) 14	CD929*	*	6"	4	
(E) 15	1	F-1			
(E) 16	CD953C*	*			
(E) 17	CD954	F-2			CUSTOM 12' M.A. & SIGN DETAIL "B"
(E) 18	CD954	F-2			20' M.A. & SIGN DETAIL "A"
(E) 19	7	F-7	PTM	4	
(E) 20	1	F-1			
(E) 21	CD929C-7	F-2			15' M.A.
(E) 22	1A	F-1 (E)			

(E) = EXISTING
* For reference only, see Street Lighting sheet

ESTIMATED MATERIAL FURNISHED BY LADOT	
UNITS	MATERIAL

ESTIMATED SALVAGE MATERIAL TO BE RETURNED TO LADOT	
UNITS	MATERIAL
1	ATSAC 170 CONTROLLER IN 337 CABINET
ALL	REMOVED LED PED HEADS

		CONDUCTOR SCHEDULE																																																			
SIZE No.	CABLE / WIRE	R U N																																																			
		1	2	3	4	5	6	7	8	9	10	11	12	13	14	15	16	17	18	19	20	21	22	23	24	25	26	27	28	29	30	31	32	33	34	35	36	37	38	39	40	41	42	43	44	45	46	47	48	49	50		
MULTI	5 CONDUCTOR CABLE 5 X #14	1	1	1	2		3	1	2	3													1		3	2	1	6								1						2	2										
	9 CONDUCTOR CABLE 8 X #14 & 1 X #12 (COM)						1				1	1														1	1								1	1							1				1						
	12 CONDUCTOR CABLE 11 X #14 & 1 X #12 (COM)																								1	1							1																				
	28 CONDUCTOR CABLE 27 X #14 & 1 X #10 (COM)						1	1	1		1	1	1	1															1	1					1	2			2	2			1	2			2						
	6 SERVICE																																															2	2				
14	PED PUSH BUTTON	2	3	3																														2															2	2			
16	DLC (2 PAIR)						1	1			1	1	2					1	2				1	2		3	4	4						4	9			9	9		1		10		10								
12	BUS DLC (1 PAIR)													1	1		1	1	1			1	1	1		1	1	2					2	4			4	4								4		4					
22	INTERCONNECT (12 PAIR) (RECALL)																																														1		1				
22	INTERCONNECT (12 PAIR)																												1	1	1																	1		1			
CONDUIT SIZE		E	E	E	E	E	3"	2"	2"	2"	3"	2"	3"	2"	2"	2"	2"	2"	2"	2"	2"	2"	2"	2"	2"	2"	2"	2"	2"	2"	2"	2"	2"	2"	2"	2"	2"	2"	2"	2"	2"	2"	2"	2"	2"	2"	2"	2"	2"	2"	2"	2"	2"

(E) = Existing

NOTICE TO CONTRACTOR
SEE DWG. NO. G1TS-009A

NOTES :



- SEMI-ACTUATED OPERATION (ATSAC 2070 CONTROLLER WITH TRANSIT PRIORITY IN 332 CABINET)
01 - CHANDLER BLVD EB LT
02 - CHANDLER BLVD WB & N/S PED XING
03 - TIMING ONLY
04 - BELLAIRE AVE SB (APPROACH) & W/S PED XING
05 - CHANDLER BLVD WB LT
06 - CHANDLER BLVD EB & S/S PED XING
07 - TIMING ONLY
08 - BELLAIRE AVE NB (APPROACH) & E/S PED XING
OLA - (04, 05 & 07) - BALLAIRE AVE SB (DEPARTURE)
OLB - (01, 03 & 08) - BALLAIRE AVE NB (DEPARTURE)
OLC (05 & 07) - BALLAIRE AVE SB LT (DEPARTURE)
OLD - (01 & 03) - BALLAIRE AVE NB LT (DEPARTURE)
BRT A - BUSWAY WB
BRT B - BUSWAY EB
VICTORY CORRIDOR EAST ATSAC SYSTEM
DIRECT WIRE (CABLE) INTERCONNECT
- REMOVE CONTROLLER, 337 CABINET, TYPE 8 STANDARD AND FOUNDATION; ABANDON CONDUITS.
- INSTALL ATSAC 2070 CONTROLLER IN 332 CABINET. THE CONTRACTOR SHALL PROVIDE A COMPLETE FUNCTIONING CONTROLLER ASSEMBLY AND CABINET CONFORMING TO THE LATEST LADOT SPECIFICATION FOR 2070 CONTROLLER. CONTRACTOR TO DELIVER COMPLETELY ASSEMBLED CONTROLLER FOR TESTING TO THE DEPARTMENT OF TRANSPORTATION GENERAL SHOP, PIPER TECHNICAL CENTER, 555 RAMIREZ STREET THIRTY (30) DAYS PRIOR TO INSTALLATION. CONTRACTOR TO PICK UP AND INSTALL CONTROLLER ASSEMBLY ON F-332 FOUNDATION. INSTALL TRANSIT PRIORITY SENSOR UNITS IN THE NEW 332 CABINET.
- REMOVE TRAFFIC SIGNAL EQUIPMENT, STANDARD, FOUNDATION AND PULL BOX. ABANDON CONDUITS.
- REPLACE EXISTING SERVICE WIRES WITH 2 #6 WIRES. INSTALL A 60 AMP FUSE IN AN IN-LINE WATERPROOF FUSEHOLDER IN THE PULLBOX PER LADOT STD. DWG. No. S-79.8. WORK ON ANY ELECTRICAL EQUIPMENT TO BE DONE ONLY IN CONJUNCTION WITH THE DWP PERSONNEL. CONTACT DWP AT (213) 367-3003 SEVEN (7) WORKING DAYS PRIOR TO BEGINNING OF WORK
- INSTALL PV HEAD AT 14' HEIGHT.
- REMOVE TRAFFIC SIGNAL EQUIPMENT, STANDARD. REUSE EXISTING FOUNDATION.
- CONTRACTOR SHALL PROVIDE AND INSTALL LARGE STREET NAME SIGNS PER LADOT STD. DWGS. No. S-457.0 & S-486.0.
- INSTALL STRIPING, SIGNS AND PAVEMENT MARKINGS PER LADOT DWG. No. A-3920 FOR THIS PROJECT. REMOVE ALL CONFLICTING STRIPING AND PAVEMENT MARKINGS.
- SEE STREET LIGHTING SHEET FOR WORK ON STREET LIGHTING FACILITIES.
- INSTALL TRANSIT PRIORITY LOOPS PER LADOT STD. DWG. No. S-70.1F AND VEHICLE LOOPS PER STD. DWG No. S-70.1A.
- ALL NEW VEHICLE AND PEDESTRIAN TRAFFIC SIGNALS SHALL BE LED MODULES, PER LADOT SPECIFICATION 92-088-03 (LATEST EDITION).

MTA - SAN FERNANDO VALLEY RAPID BUS SYSTEM (SIGNAL RESTORATION)

REVIEWED February 19, 20 04 Ina Van Der Laan Transportation Engineer	RECOMMENDED February 19, 20 04 Fudy Wong Senior Transportation Engineer	ACCEPTED February 19, 20 04 Thomas L. Jones Principal Transportation Engineer
AS BUILT		
Date of Installation: 11-18-05		
LADOT Inspector: Alegria		
Condition As Of: 11-18-05		
LADOT Engineer: J.P.		
District: EAST VALLEY		
Thomas Guide: 562-E2		
References		
File Name 32760-P1.DWG	Intersection No. 32760	Project No. 74720
NOTICE: IF PLAN HAS NOT BEEN IMPLEMENTED WITHIN TWO (2) YEARS OF THE ACCEPTANCE DATE, IT MUST BE RESUBMITTED TO LADOT SIGNAL DESIGN SECTION FOR REVIEW AND APPROVAL.		

NORTH HOLLYWOOD TO WARNER CENTER
GROUP 1 INTERSECTIONS
RESTORATION TRAFFIC SIGNAL
BELLAIRE AVE., CHANDLER BLVD.
AND BUSWAY

SEGMENT NO C-0675	REV 1
DRAWING NO G1TS-003	
SCALE 1" = 20'	
SHEET NO	

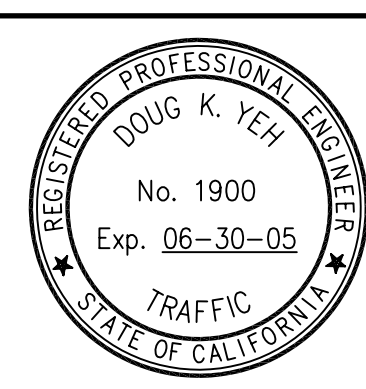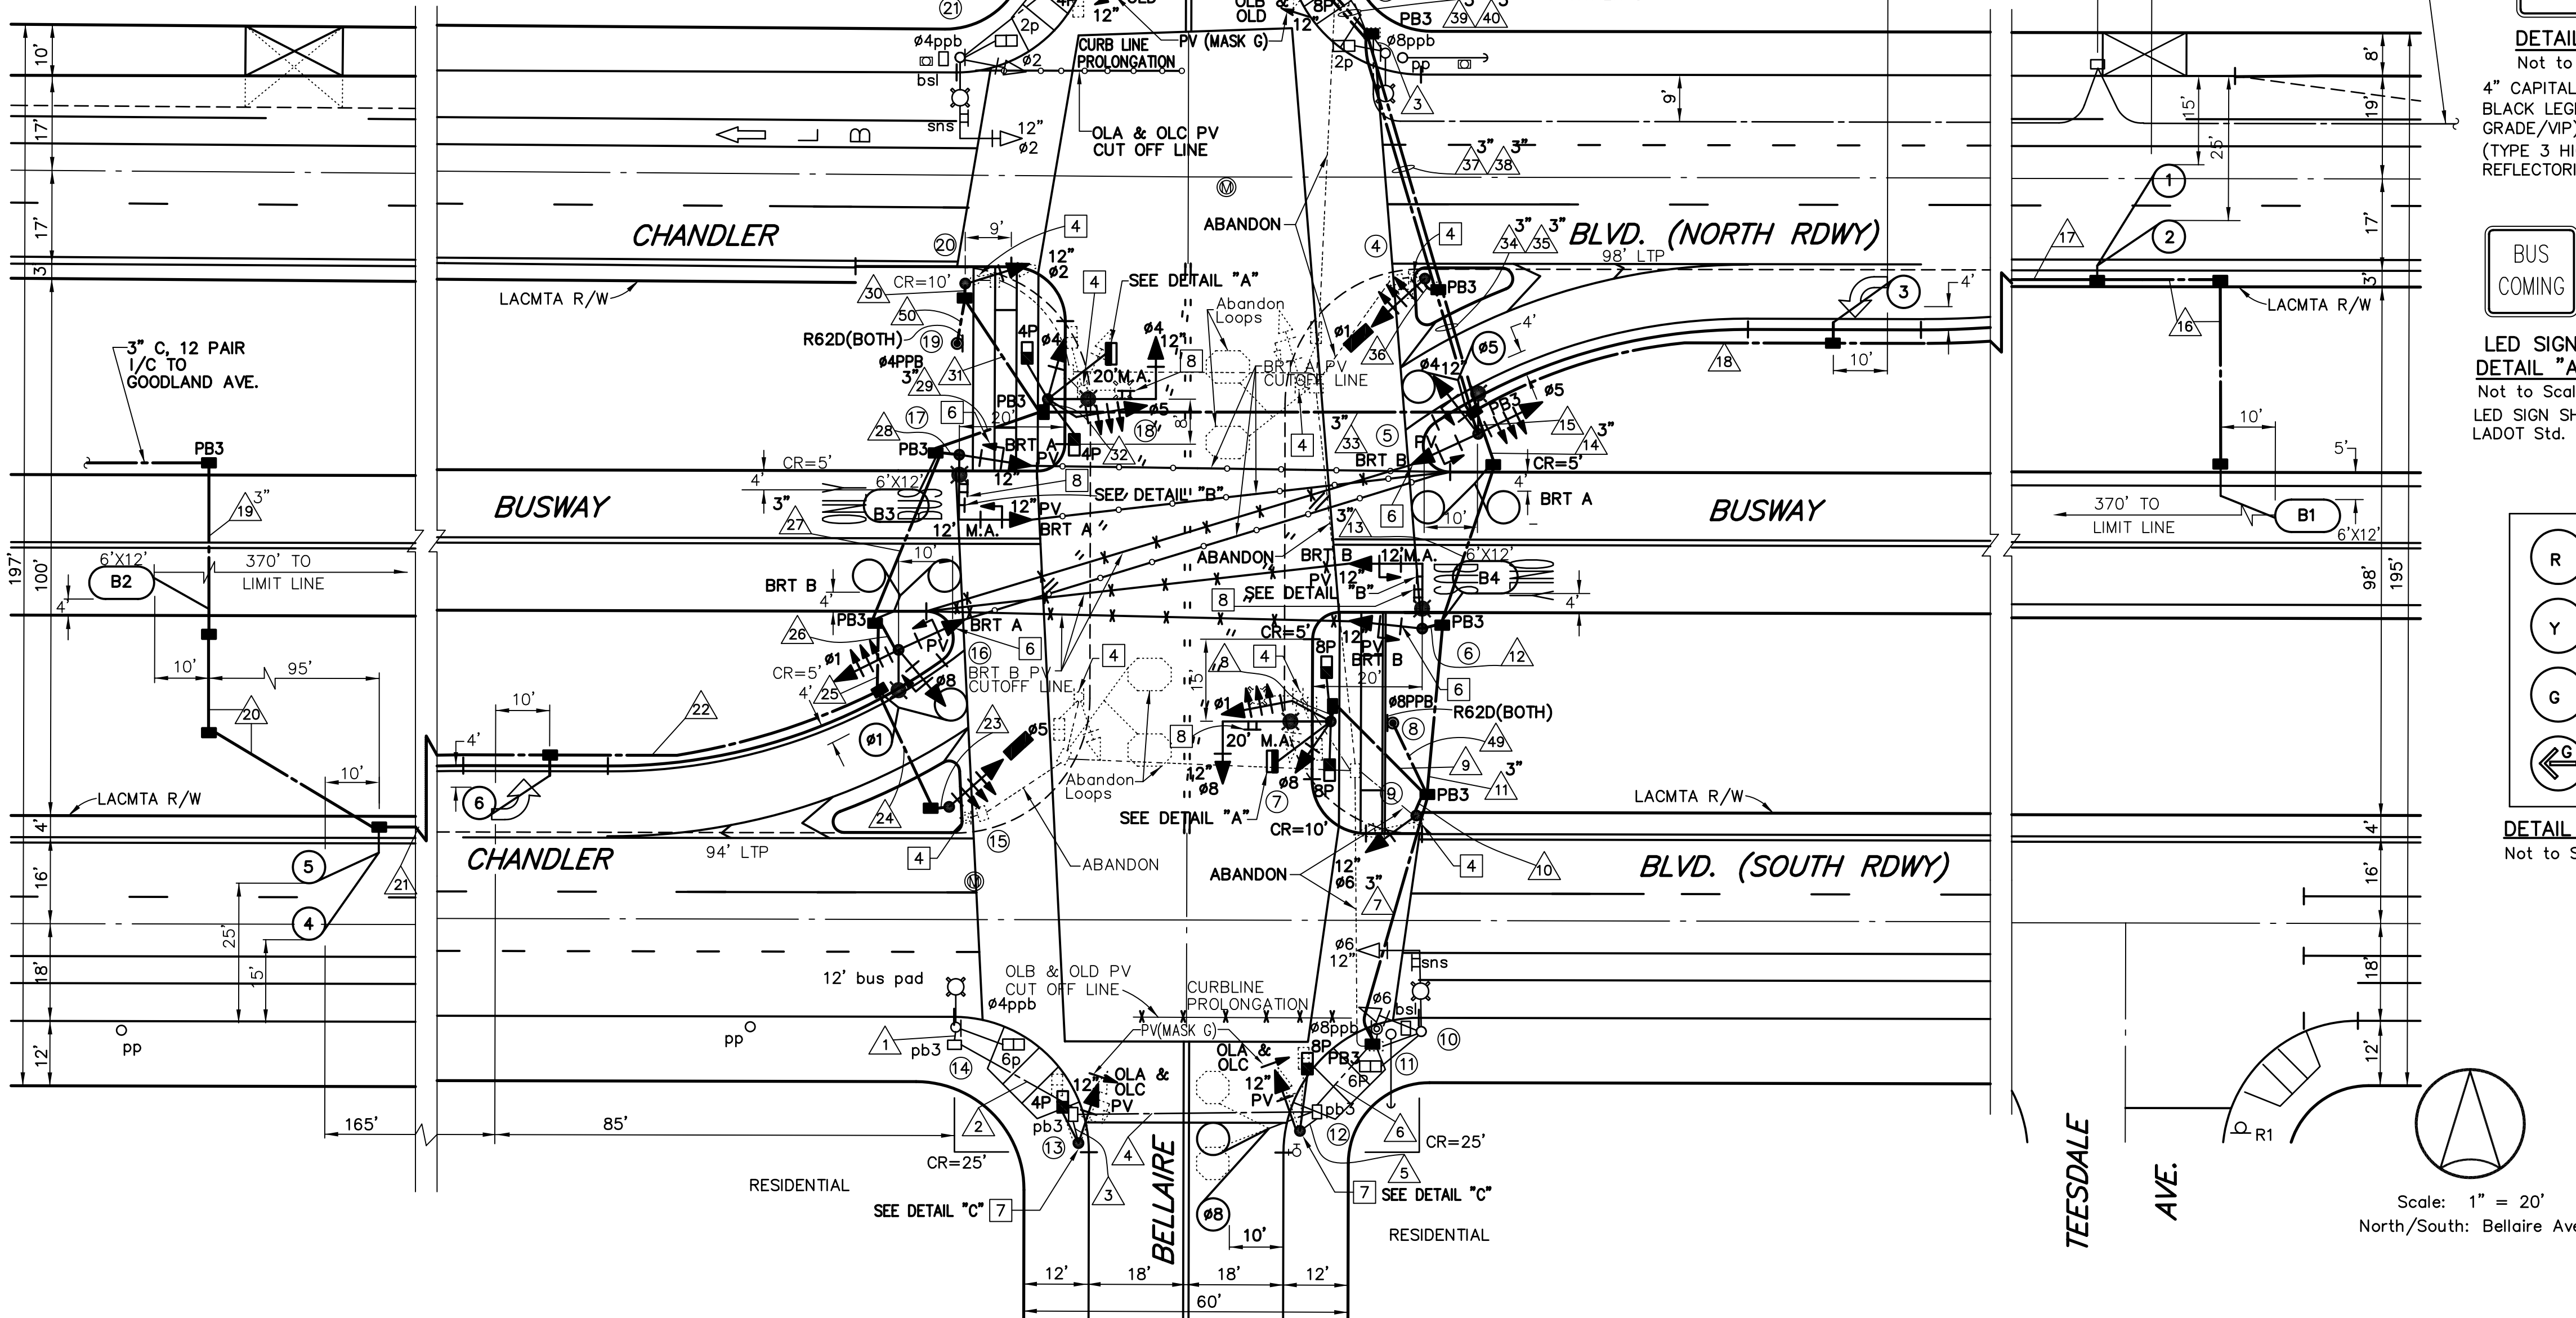

REV	DATE	BY	APP	REG NO	EXPIRES	SEAL HOLDER	DESCRIPTION
1	02-10-06	AXK					AS-BUILT RECORD DRAWING
0	02-19-04	GXF	WJO	52655	12/31/06	WALTER J. OKITSU	ISSUED FOR CONSTRUCTION

DESIGNED BY
G. FIGUEROA
DRAWN BY
G. FIGUEROA
CHECKED BY
D. YEH
IN CHARGE
W. OKITSU
DATE
02-19-04



LOS ANGELES COUNTY METROPOLITAN TRANSPORTATION AUTHORITY
SAN FERNANDO VALLEY EAST-WEST BRT PROJECT

WASHINGTON

SHIMMICK OYASHI, JV

Katz, Okitsu & Associates
Traffic Engineers & Transportation Planners
1055 Corporate Center Drive, Suite 300
Monterey Park, California 91754-7642
Tel: (323) 260-4703 Fax: (323) 260-4705