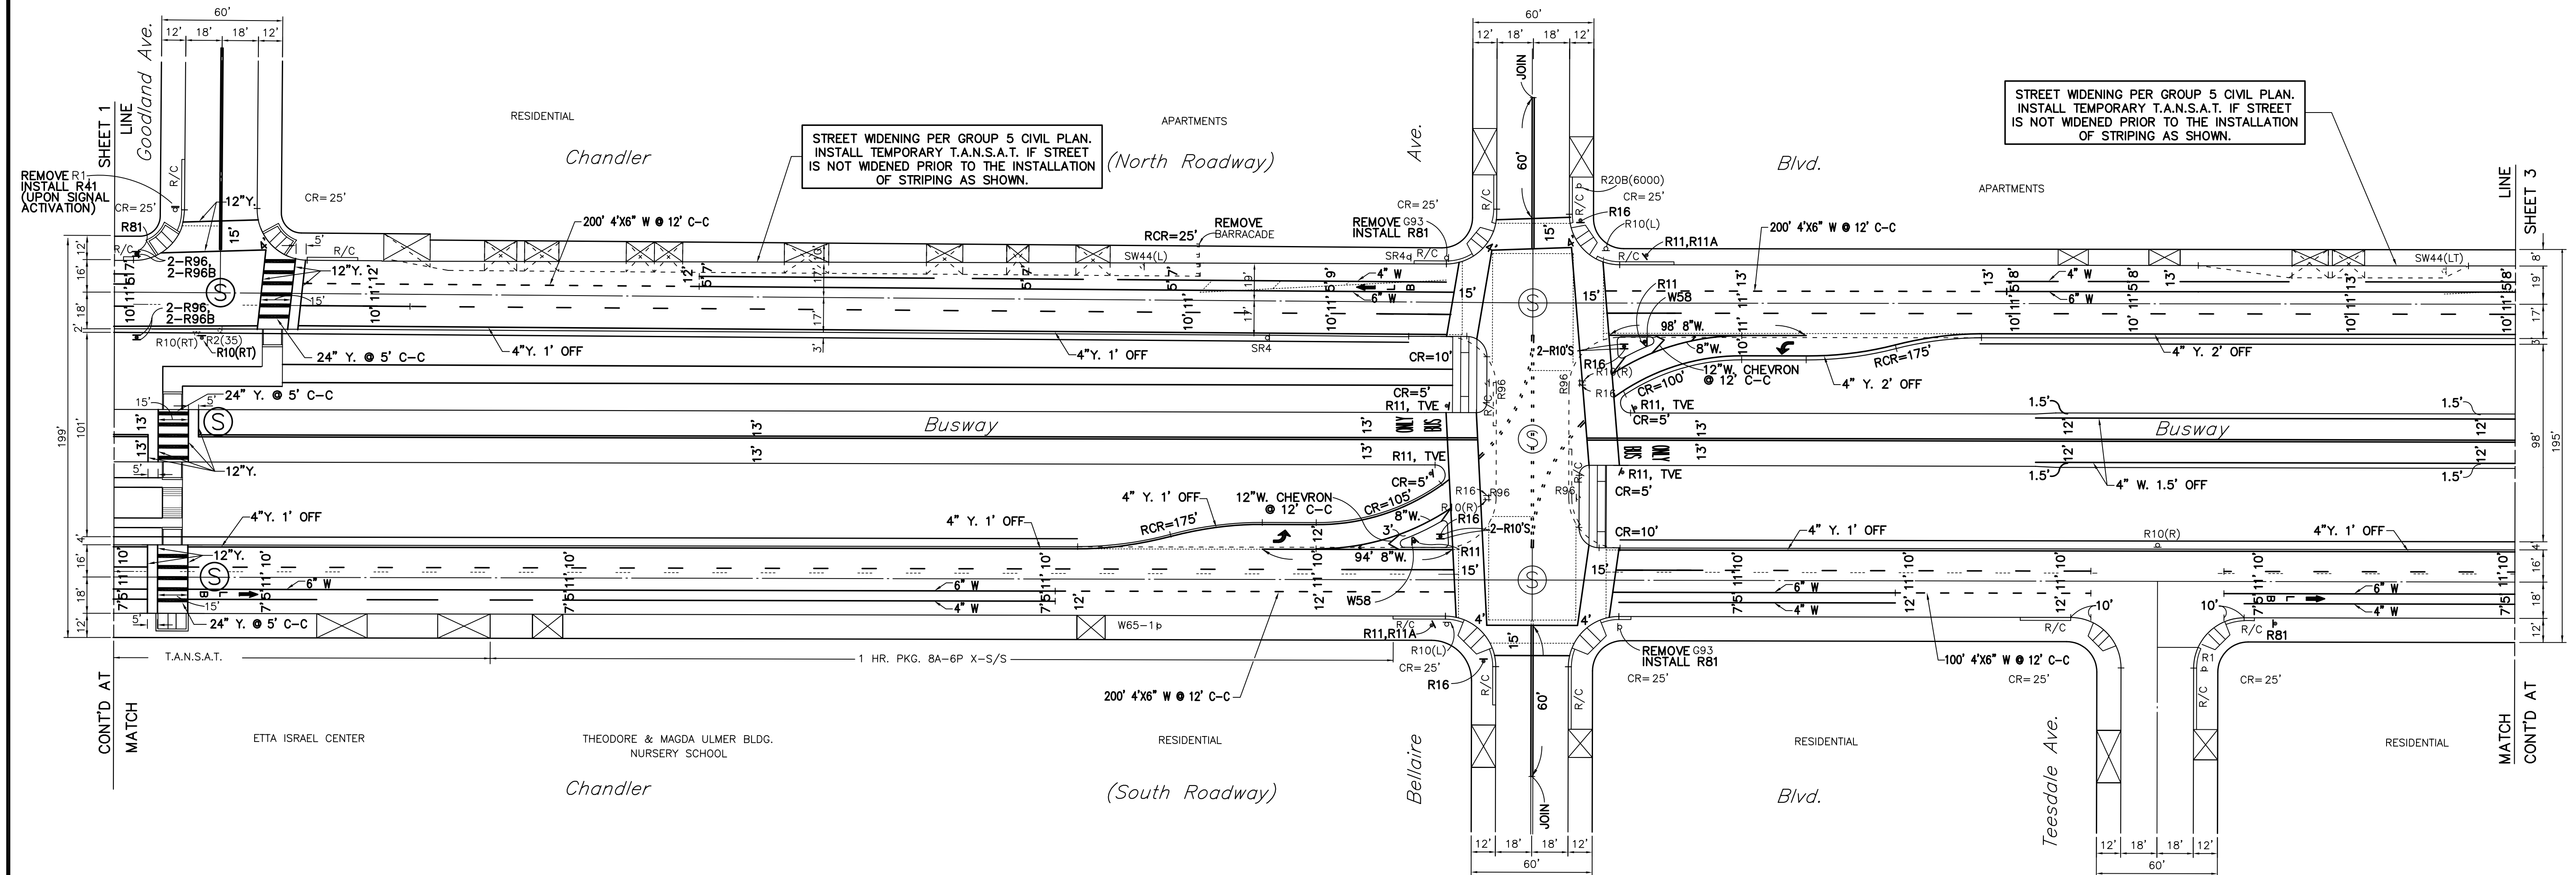


|                                                                       |                                                   |                                                                                        |             |
|-----------------------------------------------------------------------|---------------------------------------------------|----------------------------------------------------------------------------------------|-------------|
| MTA- SAN FERNANDO VALLEY RAPID BUS SYSTEM                             |                                                   |                                                                                        |             |
| REVIEWED: February 18, 20 04<br>Jim Conger<br>Transportation Engineer | RECOMMENDED: 20<br>Senior Transportation Engineer | ACCEPTED: February 19, 20 04<br>Thomas L. Jones<br>Principal Transportation Engineer   |             |
| INSTALLATION DATES                                                    |                                                   | CITY OF LOS ANGELES<br>DEPARTMENT OF TRANSPORTATION<br>WAYNE K. TANDA, GENERAL MANAGER |             |
| MARKOUT BEGAN:                                                        |                                                   | CHANDLER BLVD.<br>COLDWATER CYN BLVD. TO LANKERSIM BLVD.                               |             |
| MARKOUT COMPLETED:                                                    |                                                   |                                                                                        |             |
| STRIPING COMPLETED: 8.8. 12-19-05                                     |                                                   |                                                                                        |             |
| References:                                                           |                                                   |                                                                                        |             |
| Thomas Guide                                                          | District                                          | PROJECT NO.                                                                            | DRAWING NO. |
| 562,E2                                                                | E.V.                                              | 74720                                                                                  | A-3920      |
|                                                                       |                                                   | SEGMENT NO.                                                                            | REV         |
|                                                                       |                                                   | C-0675                                                                                 | 2           |
|                                                                       |                                                   | DRAWING NO.                                                                            |             |
|                                                                       |                                                   | G1SS-002                                                                               |             |
|                                                                       |                                                   | SCALE                                                                                  |             |
|                                                                       |                                                   | 1" = 40'                                                                               |             |
|                                                                       |                                                   | SHEET NO.                                                                              |             |

|                                                                                     |     |          |     |     |        |          |                  |                                 |                            |
|-------------------------------------------------------------------------------------|-----|----------|-----|-----|--------|----------|------------------|---------------------------------|----------------------------|
|  |     |          |     |     |        |          |                  |                                 | DESIGNED BY<br>A. CALDERON |
|                                                                                     |     |          |     |     |        |          |                  |                                 | DRAWN BY<br>J. BERNAL      |
|                                                                                     |     |          |     |     |        |          |                  |                                 | CHECKED BY<br>D. YEH       |
|                                                                                     | 2   | 02-10-06 | AXK |     |        |          |                  | AS-BUILT RECORD DRAWING         | IN CHARGE<br>W. OKITSU     |
|                                                                                     | 1   | 06-22-04 | APC | WJO | 52655  | 12/31/06 | WALTER J. OKITSU | UPDATE CHANGES PER CIVIL DESIGN | DATE<br>02-19-04           |
|                                                                                     | 0   | 02-19-04 | APC | WJO | 52655  | 12/31/06 | WALTER J. OKITSU | ISSUED FOR CONSTRUCTION         |                            |
|                                                                                     | REV | DATE     | BY  | APP | REG NO | EXPIRES  | SEAL HOLDER      | DESCRIPTION                     |                            |

LOS ANGELES COUNTY METROPOLITAN TRANSPORTATION AUTHORITY  
SAN FERNANDO VALLEY EAST-WEST BRT PROJECT

WASHINGTON

SHIMICK  
OBAYASHI JV

**Katz, Okitsu & Associates**  
Traffic Engineers & Transportation Planners  
1055 Corporate Center Drive, Suite 300  
Monterey Park, California 91754-7642  
Tel: (323) 260-4703 Fax: (323) 260-4705