



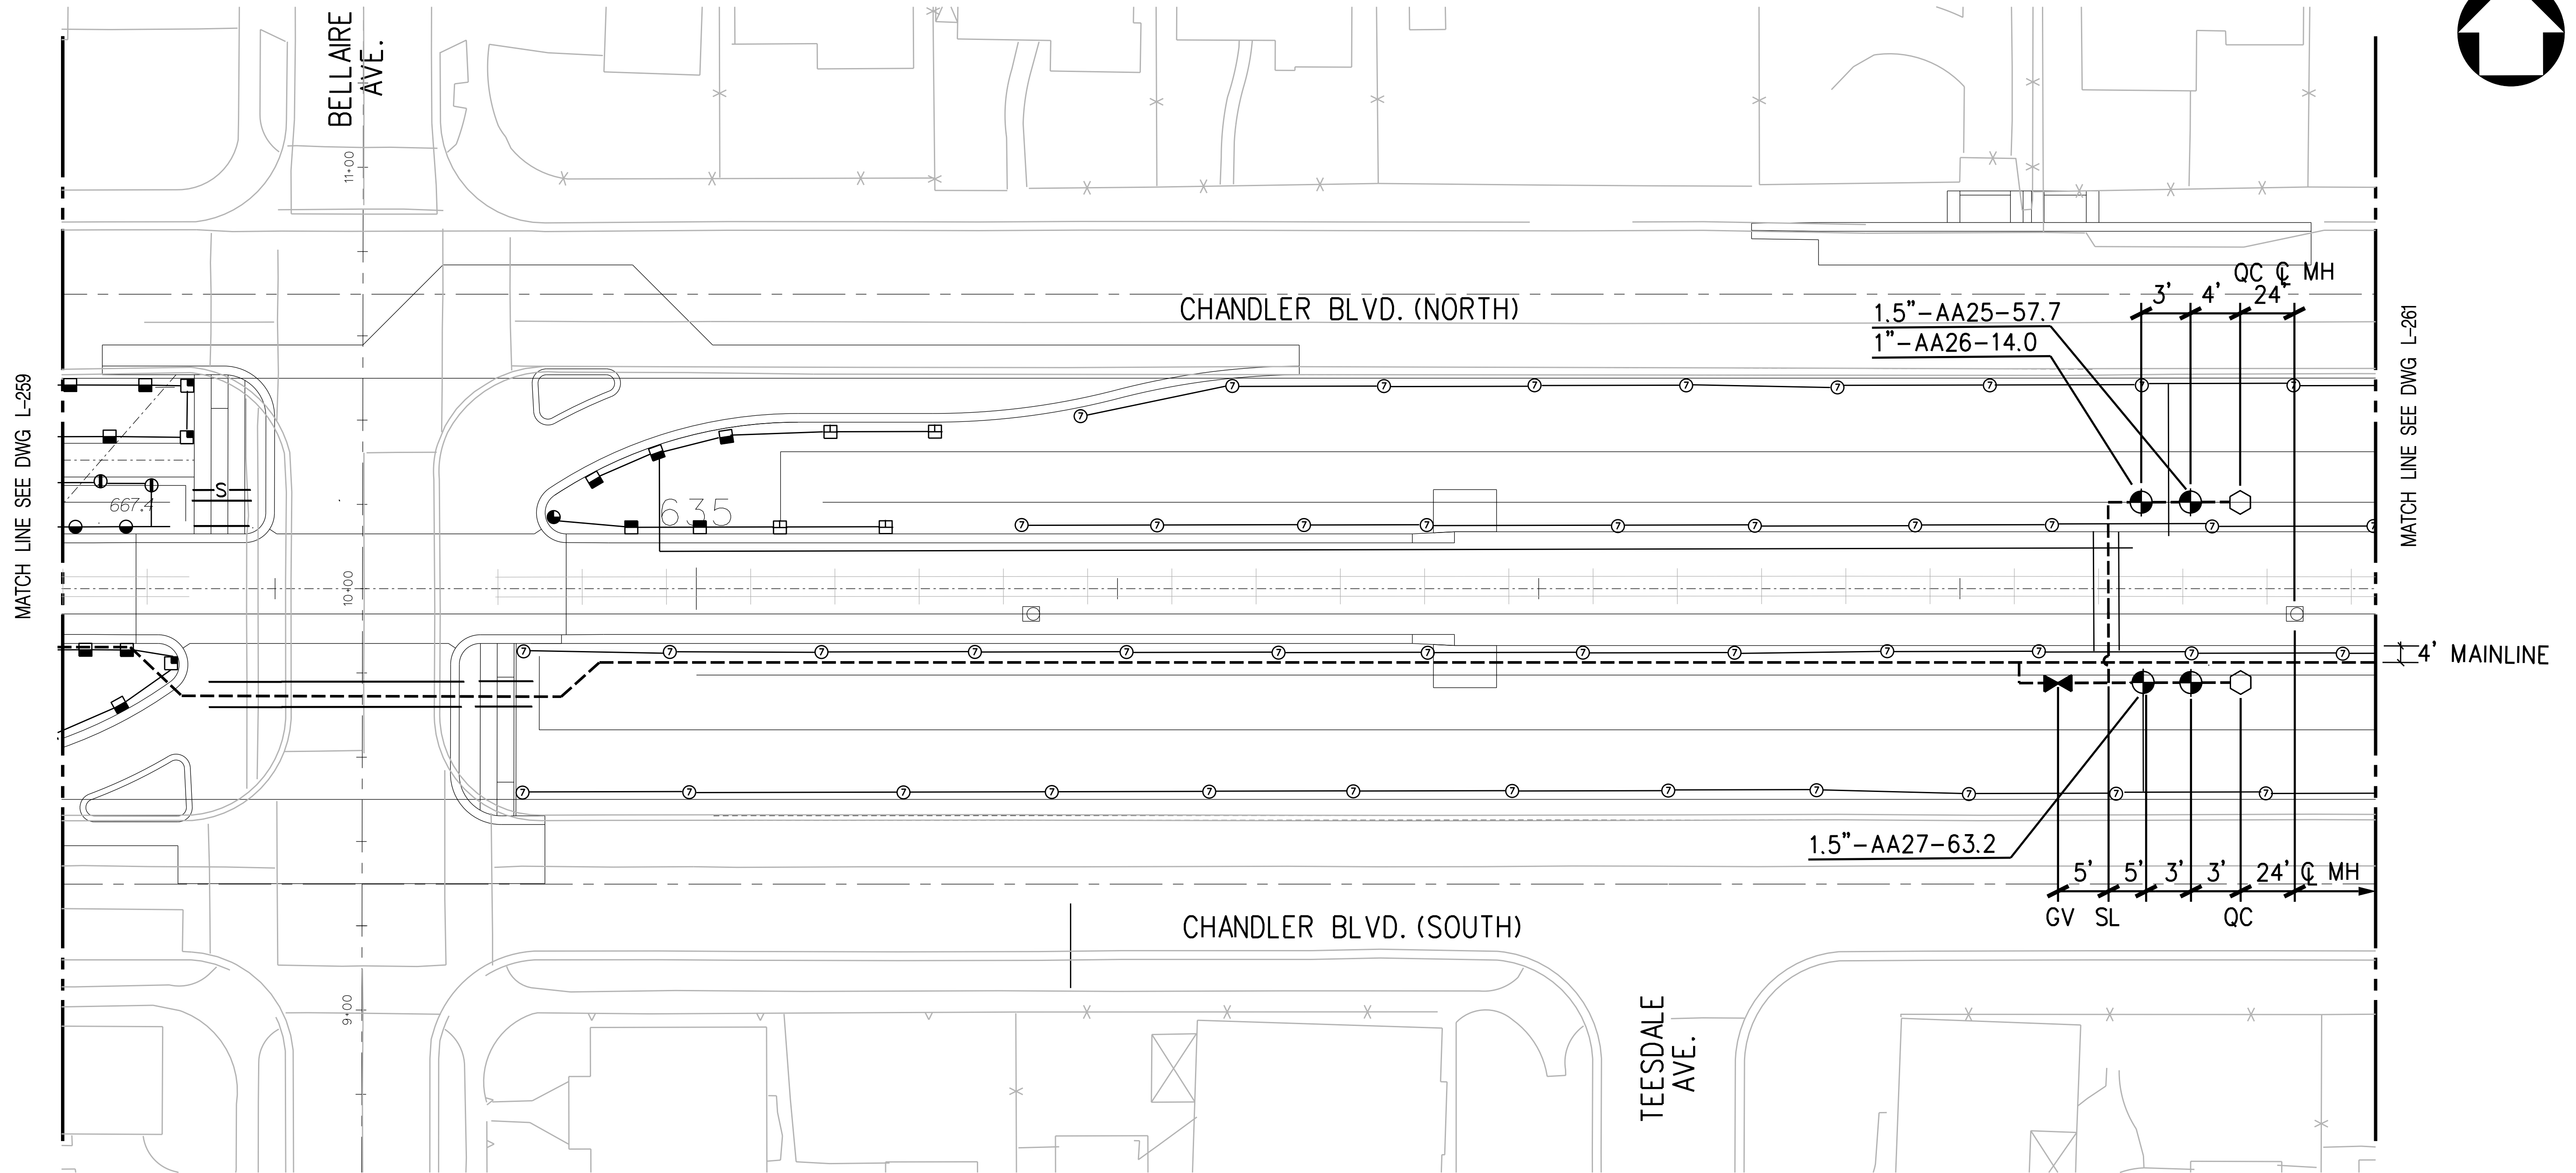


MATCH LINE SEE DWG L-261

MATCH LINE SEE DWG L-259

4' MAINLINE

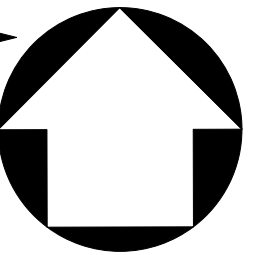

ISSUE FOR CONSTRUCTION

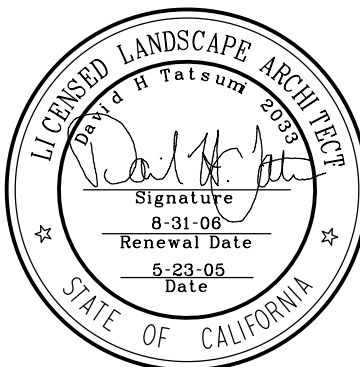								DESIGNED BY MG		 LOS ANGELES COUNTY METROPOLITAN TRANSPORTATION AUTHORITY SAN FERNANDO VALLEY EAST-WEST BRT PROJECT	TATSUMI AND PARTNERS, INC. LANDSCAPE ARCHITECTURE • PLANNING • DESIGN 5 CORPORATE PARK, SUITE 200 BURNING WOOD, CA 92506-5866 949/250-9890 FAX 949/250-9891	 SUBMITTED BY: _____ DATE: _____ DAVID H. TATSUMI	NORTH HOLLYWOOD TO WARNER CENTER IRRIGATION PLAN STA 633+50 TO STA 639+00 SHEET 118 OF 136	CONTRACT NO C0675	DRAWING NO L- 260	REV 0	SCALE 1"=20'	SHEET NO												
								DRAWN BY T&P																						
								CHECKED BY KLS																						
								IN CHARGE DT																						
								DATE 5/23/2005																						
REV	DATE	BY	APP	REG NO	EXPIRES	SEAL HOLDER	DESCRIPTION																							
	3/12/08						AS-BUILTS																							
0	5/23/05						ISSUE FOR CONSTRUCTION																							

Mike. G