
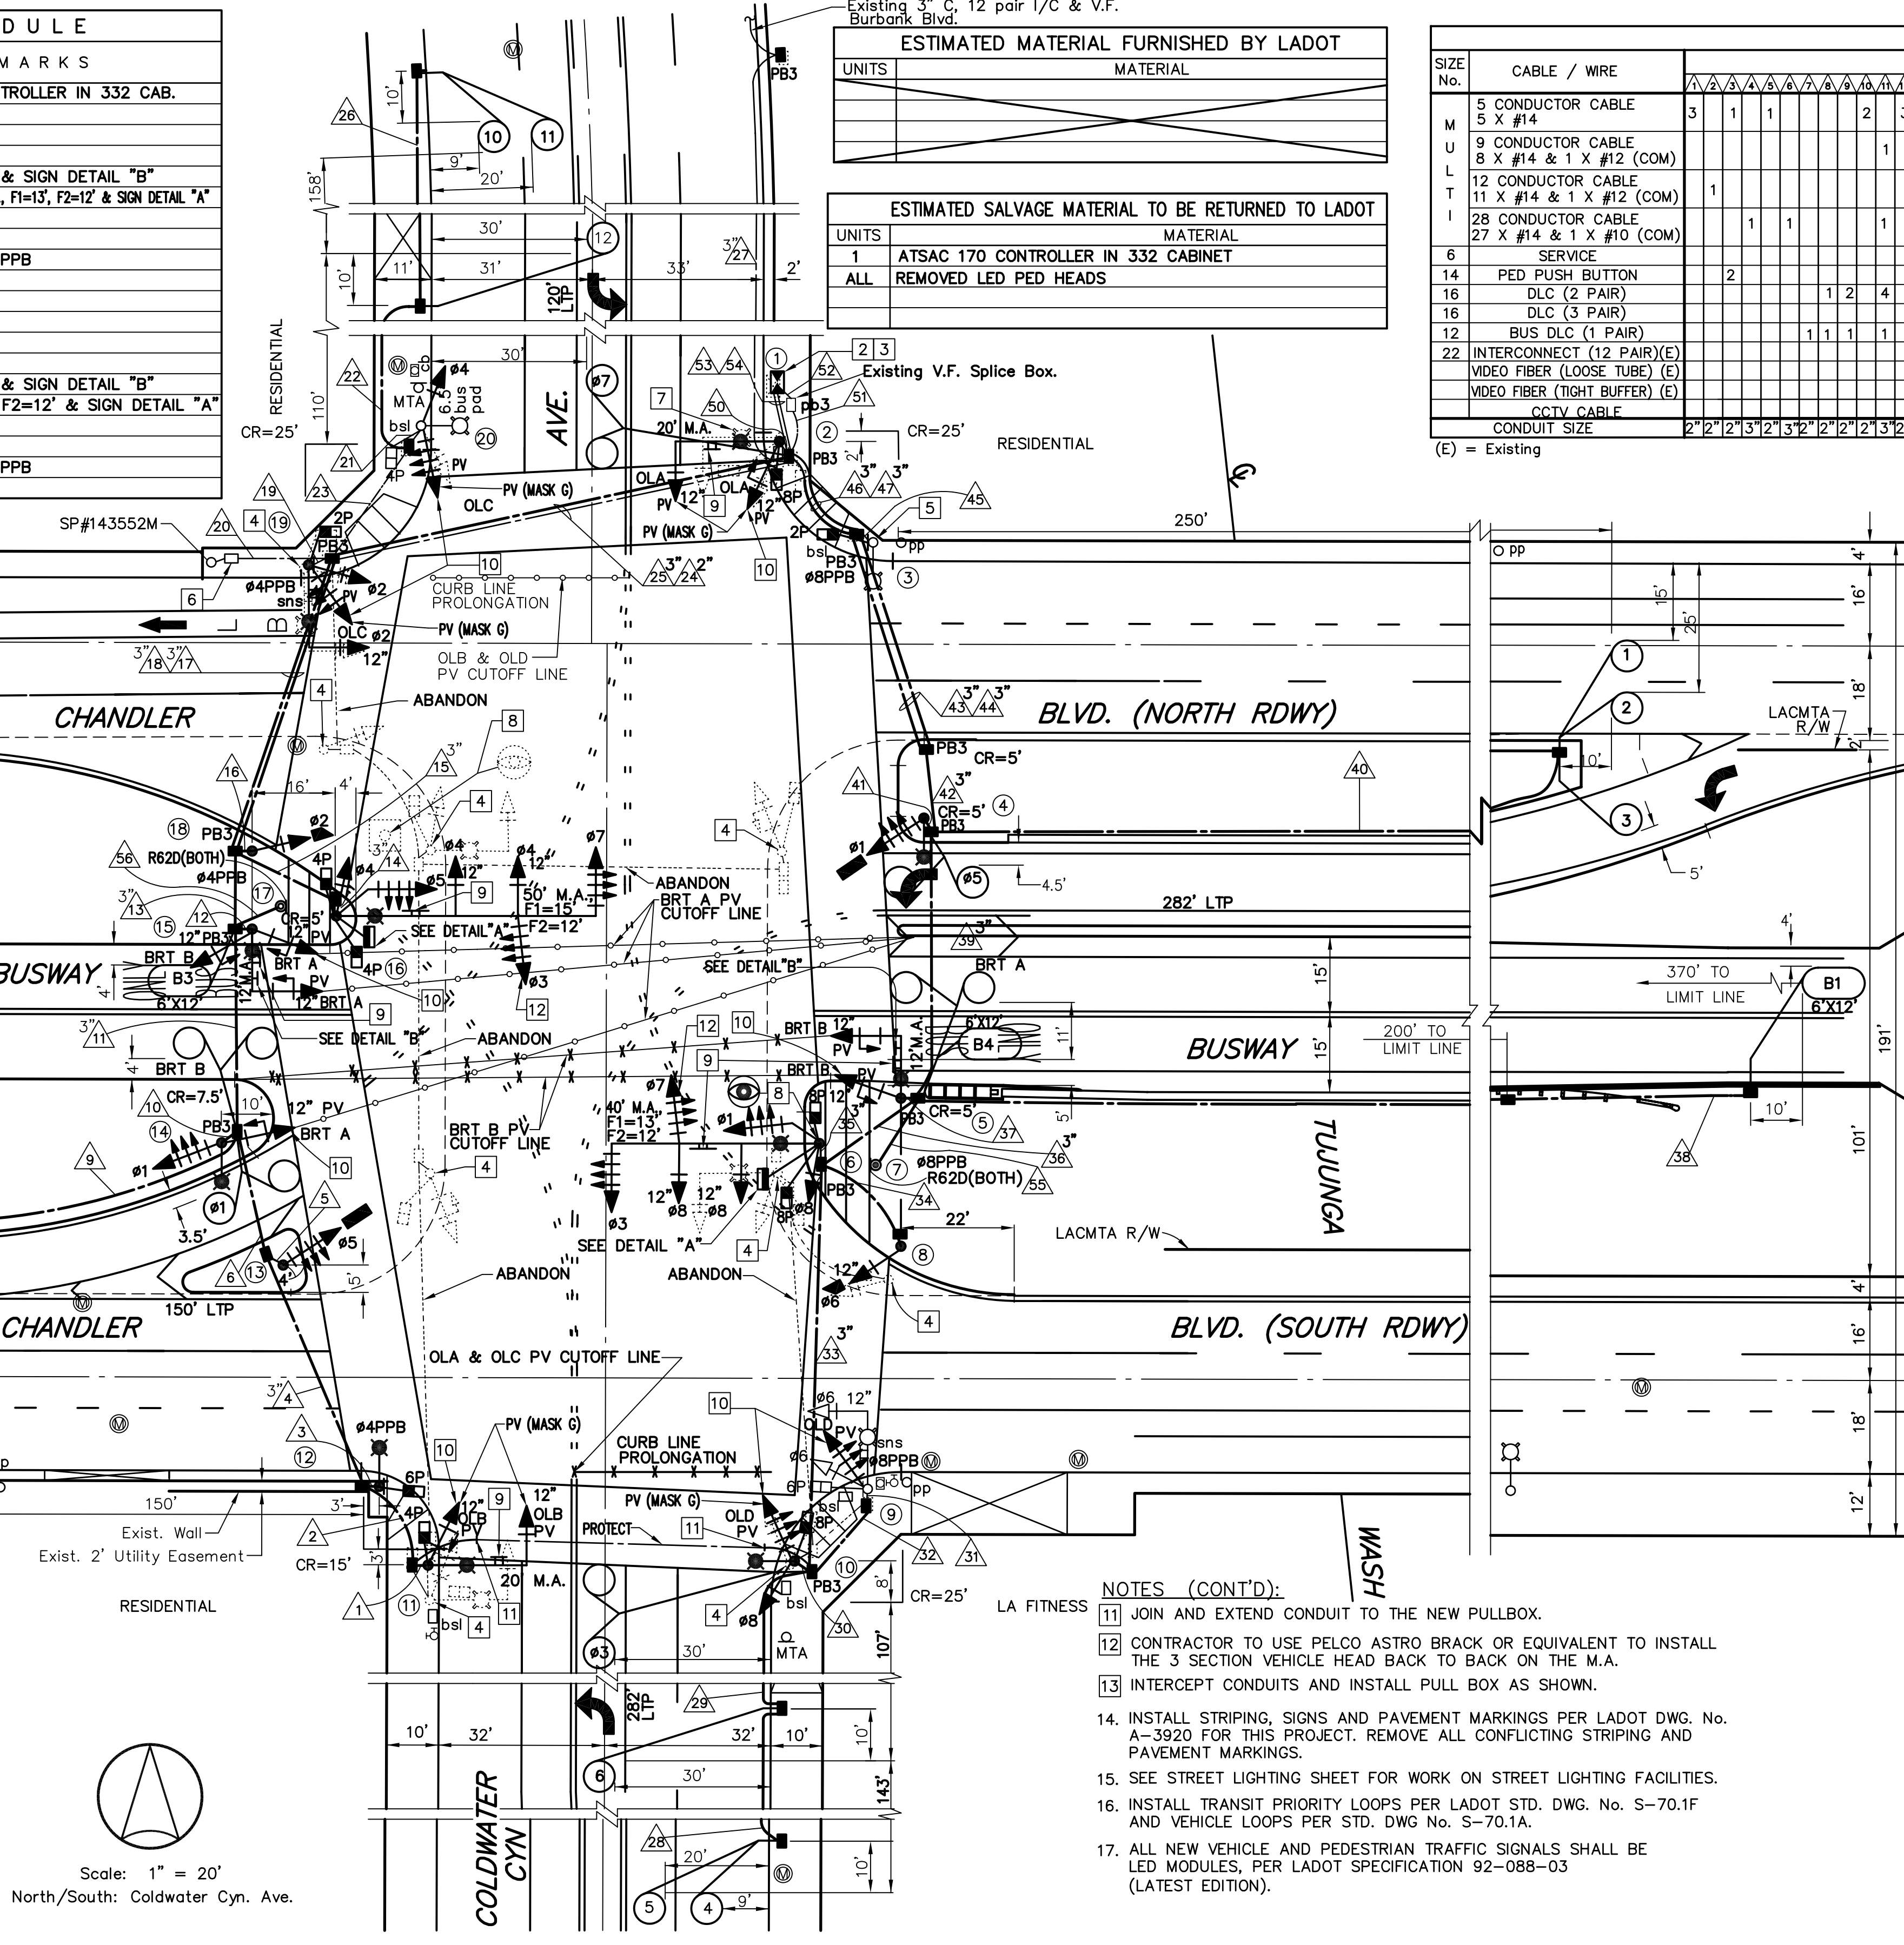
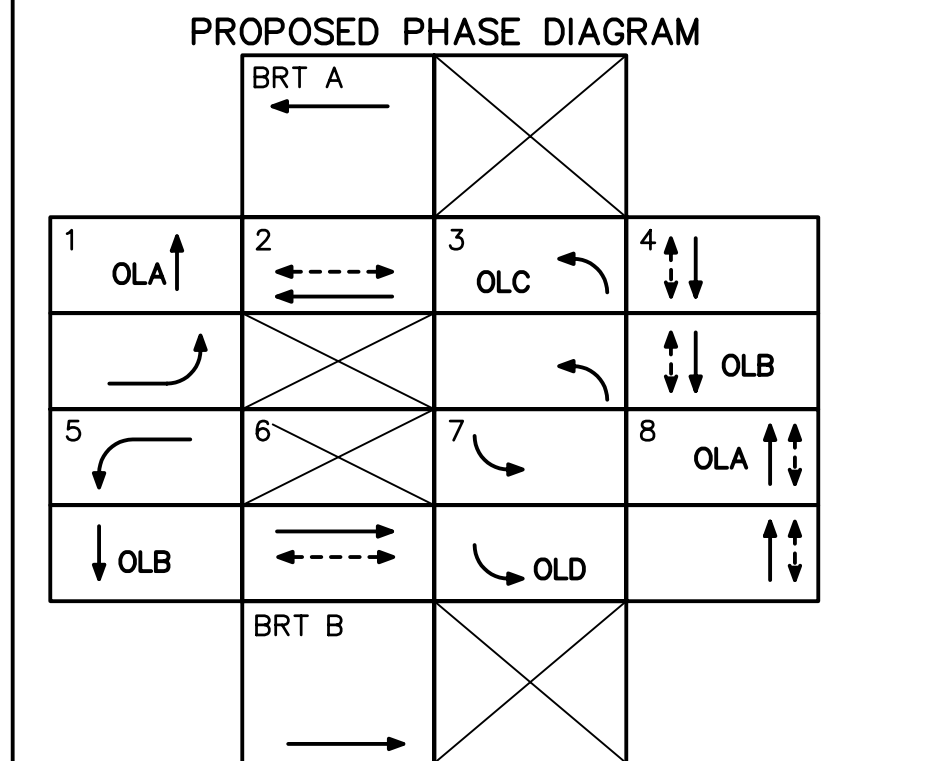


SIGNAL STANDARD SCHEDULE					
No.	TYPE	FOUND. TYPE	PED. PUSH BUTN TYPE	PHASE	REMARKS
(E) 1	332 CAB.	F-332(E)			ATSAC 2070 CONTROLLER IN 332 CAB.
(E) 2	CD954	F-2(E)			20' M.A.
(E) 3	CD953C*	*	6"	8	INSTALL PPB
(E) 4	CD953C*	*			
(E) 5	CD954	F-2			CUSTOM 12' M.A. & SIGN DETAIL "B"
(E) 6	C-2	CIDH***			VIDEO CAMERA, 40' M.A., F1=13', F2=12' & SIGN DETAIL "A"
(E) 7	7	F-7	PTM	8	
(E) 8	1	F-1			
(E) 9	CD953C-7	F-2	6"	8	15' M.A., INSTALL PPB
(E) 10	CD953C*	*			
(E) 11	CD954	F-2			20' M.A.
(E) 12	CD953C*	*	6"	4	
(E) 13	1	F-1			
(E) 14	CD953C*	*			
(E) 15	CD954	F-2			CUSTOM 12' M.A. & SIGN DETAIL "B"
(E) 16	29-5-80	CIDH**			50' M.A., F1=15', F2=12' & SIGN DETAIL "A"
(E) 17	7	F-7	PTM	4	
(E) 18	1	F-1			
(E) 19	CD954	F-2	6"	4	15' M.A., INSTALL PPB
(E) 20	CD953C*	*			

(E) = EXISTING
 * For reference only, see Street Lighting sheet.
 ** CIDH PILE Foundation as per Caltrans Standard Plans.
 *** CIDH PILE Foundation as per LADOT Std. Dwg. No. S-52.1.4B

24"X18" BUS SIGNAL
 LED SIGN DETAIL "A"
 Not to Scale
 LED SIGN SHALL BE PER LADOT Std. Dwg. No. S-58.13A
 4" CAPITAL SERIES D LETTERS
 BLACK LEGEND (TYPE 7 DIAMOND GRADE/VIPO/N)
 WHITE BACKGROUND (TYPE 3 HIGH INTENSITY, REFLECTORIZED)

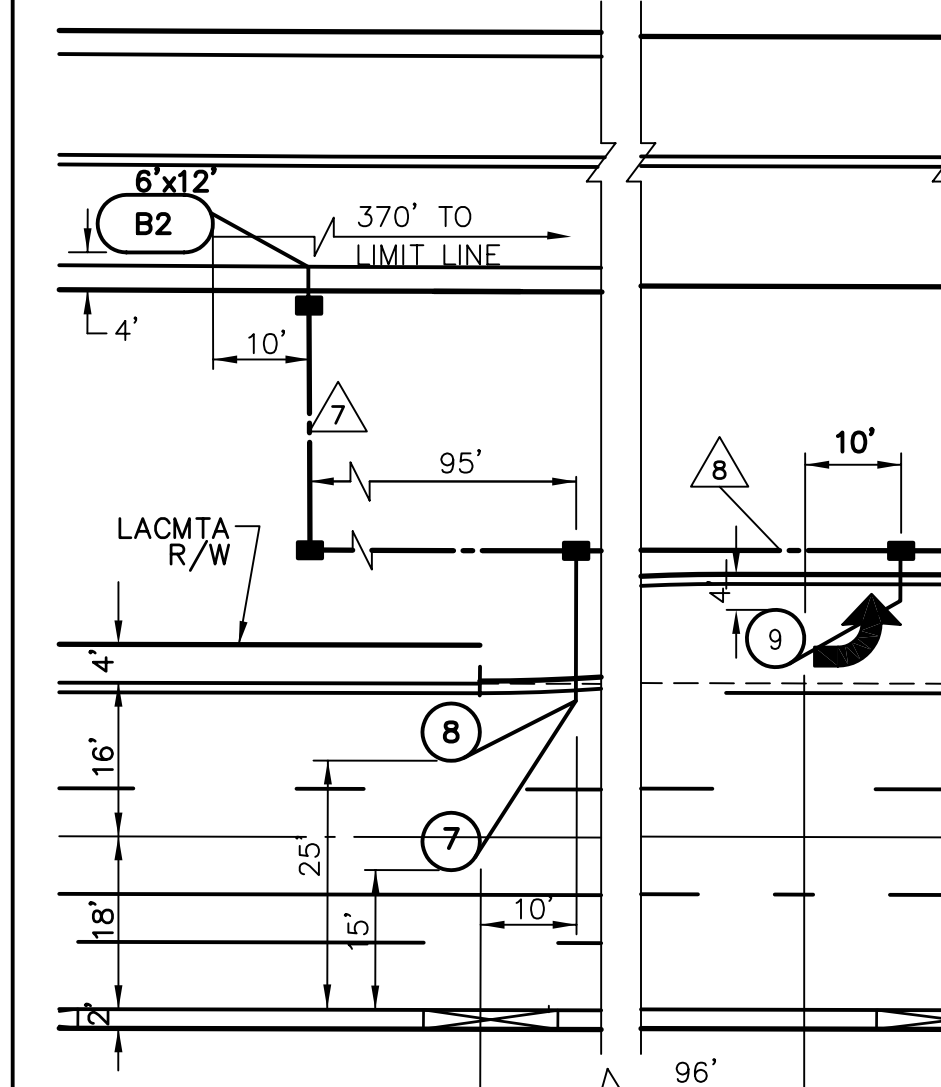

NOTES (CONT'D):
 11 JOIN AND EXTEND CONDUIT TO THE NEW PULLBOX.
 12 CONTRACTOR TO USE PELCO ASTRO BRACK OR EQUIVALENT TO INSTALL THE 3 SECTION VEHICLE HEAD BACK TO BACK ON THE M.A.
 13 INTERCEPT CONDUITS AND INSTALL PULL BOX AS SHOWN.
 14. INSTALL STRIPING, SIGNS AND PAVEMENT MARKINGS PER LADOT DWG. No. A-3920 FOR THIS PROJECT. REMOVE ALL CONFLICTING STRIPING AND PAVEMENT MARKINGS.
 15. SEE STREET LIGHTING SHEET FOR WORK ON STREET LIGHTING FACILITIES.
 16. INSTALL TRANSIT PRIORITY LOOPS PER LADOT STD. DWG. No. S-70.1F AND VEHICLE LOOPS PER STD. DWG. No. S-70.1A.
 17. ALL NEW VEHICLE AND PEDESTRIAN TRAFFIC SIGNALS SHALL BE LED MODULES, PER LADOT SPECIFICATION 92-088-03 (LATEST EDITION).

CONDUCTOR SCHEDULE		RUN		CABLE / WIRE		SIZE		No.	
5 CONDUCTOR CABLE		3		1		1		2	
9 CONDUCTOR CABLE		1		1		1		1	
12 CONDUCTOR CABLE		1		1		1		1	
28 CONDUCTOR CABLE		1		1		1		1	
SERVICE		2		2		2		2	
PED. PUSH BUTTON		2		2		2		2	
DLC (2 PAIR)		1		1		1		1	
DLC (3 PAIR)		1		1		1		1	
BUS DLC (1 PAIR)		1		1		1		1	
INTERCONNECT (12 PAIR)(E)		1		1		1		1	
VIDEO FIBER (LOOSE TUBE) (E)		1		1		1		1	
VIDEO FIBER (TIGHT BUFFER) (E)		1		1		1		1	
CCTV CABLE		1		1		1		1	
CONDUIT SIZE		2"		2"		2"		2"	

(E) = Existing

- NOTES :
- SEMI-ACTUATED OPERATION WITH ATSAC CAMERA (ATSAC 2070 CONTROLLER WITH TRANSIT PRIORITY IN 332 CABINET)
 01 - CHANDLER BLVD EB LT
 02 - CHANDLER BLVD WB & N/S PED XING
 03 - COLDWATER CYN AVE NB LT (APPROACH)
 04 - COLDWATER CYN AVE SB (APPROACH) & W/S PED XING
 05 - CHANDLER BLVD WB LT
 06 - CHANDLER BLVD EB. & S/S PED XING
 07 - COLDWATER CYN AVE SB LT (APPROACH)
 08 - COLDWATER CYN AVE NB (APPROACH) & E/S PED XING
 OLA (01 & 08) - COLDWATER CANYON AVE. NB (DEPARTURE)
 OLB (04 & 05) COLDWATER CANYON AVE. SB (DEPARTURE)
 OLC (03) - COLDWATER CANYON AVE. NB LT (DEPARTURE)
 OLD (07) - COLDWATER CANYON AVE. SB LT (DEPARTURE)
 BRT A - BUSWAY WB
 BRT B - BUSWAY EB
 VICTORY CORRIDOR EAST ATSAC SYSTEM
 DIRECT WIRE (CABLE) INTERCONNECT
 - REMOVE ATSAC 170 CONTROLLER AND 332 CABINET. RELOCATE FIBER OPTIC VIDEO/DATA TRANSMITTER SYSTEM TO CONTROLLER AT LOCATION ①. RETAIN F-332 FOUNDATION.
 - INSTALL ATSAC 2070 CONTROLLER IN 332 CABINET. THE CONTRACTOR SHALL PROVIDE A COMPLETE FUNCTIONING CONTROLLER ASSEMBLY AND CABINET CONFORMING TO THE LATEST LADOT SPECIFICATION FOR 2070 CONTROLLER. CONTRACTOR TO DELIVER COMPLETELY ASSEMBLED CONTROLLER FOR TESTING TO THE DEPARTMENT OF TRANSPORTATION GENERAL SHOP, PIPER TECHNICAL CENTER, 555 RAMIREZ STREET THIRTY (30) DAYS PRIOR TO INSTALLATION. CONTRACTOR TO PICK UP AND INSTALL CONTROLLER ASSEMBLY ON EXISTING F-332 FOUNDATION. INSTALL TRANSIT PRIORITY SENSOR UNITS IN THE NEW CABINET.
 - REMOVE TRAFFIC SIGNAL EQUIPMENT STANDARD AND FOUNDATION, ABANDON CONDUITS.
 - CHIP INTO EXISTING FOUNDATION AND INSTALL NEW CONDUIT.
 - REPLACE EXISTING SERVICE WIRES WITH 2 #6 WIRES. INSTALL A 60 AMP FUSE IN AN IN-LINE, WATERPROOF FUSEHOLDER IN THE PULLBOX PER LADOT STD. DWG. No. S-79.8. WORK ON ANY ELECTRICAL EQUIPMENT TO BE DONE ONLY IN CONJUNCTION WITH THE DWP PERSONNEL. CONTACT DWP AT (213) 367-3003 SEVEN (7) WORKING DAYS PRIOR TO BEGINNING OF WORK
 - REMOVE TRAFFIC SIGNAL EQUIPMENT AND STANDARD. REUSE FOUNDATION.
 - RELOCATE C-2 POLE TO LOCATION ⑦. INSTALL MAST ARM PER SIGNAL STANDARD SCHEDULE. REMOVE TEMPORARY PLATFORM FOUNDATION AND OVERHEAD CABLES. CONTRACTOR TO TAKE EXTREME CARE IN THE RELOCATION OF THE POLE. DAMAGED, UNACCEPTABLE EQUIPMENT AS DETERMINED BY LADOT SIGNAL INSPECTOR SHALL BE REPLACED WITH NEW EQUIPMENT AT CONTRACTOR'S SOLE EXPENSE.
 - CONTRACTOR SHALL PROVIDE AND INSTALL LARGE STREET NAME SIGNS PER LADOT STD. DWGS. No. S-457.0 & S-486.0.
 - INSTALL PV HEAD AT 14' HEIGHT.

MTA - SAN FERNANDO VALLEY RAPID BUS SYSTEM (SIGNAL RESTORATION)

REVIEWED March 4, 20 04 Ina Van Der Laan Transportation Engineer	RECOMMENDED March 4, 20 04 Judy Wong Senior Transportation Engineer	ACCEPTED March 4, 20 04 Thomas L. Jones Principal Transportation Engineer
AS BUILT		
Date of Installation: 11-18-05		
LADOT Inspector: Alegria		
Condition As Of: 11-18-05		
LADOT Engineer: J.P.		
District: EAST VALLEY		
Thomas Guide: 562-E2		
References	File Name: 32750-P2.DWG	Intersection No. 32750
		Project No. 74720
NOTICE: IF PLAN HAS NOT BEEN IMPLEMENTED WITHIN TWO (2) YEARS OF THE ACCEPTANCE DATE, IT MUST BE RESUBMITTED TO LADOT SIGNAL DESIGN SECTION FOR REVIEW AND APPROVAL.		

1	02-10-06	AXK							
0	03-04-04	GXF	WJO	52655	12/31/06	WALTER J. OKITSU	ISSUED FOR CONSTRUCTION		
REV	DATE	BY	APP	REG NO	EXPIRES	SEAL HOLDER	DESCRIPTION		

DESIGNED BY G. FIGUEROA
 DRAWN BY G. FIGUEROA
 CHECKED BY D. YEH
 IN CHARGE W. OKITSU
 DATE 03-04-04

REGISTERED PROFESSIONAL ENGINEER
 WALTER J. OKITSU
 No. 52655
 Exp. 12/31/06
 CIVIL

LOS ANGELES COUNTY METROPOLITAN TRANSPORTATION AUTHORITY
 SAN FERNANDO VALLEY EAST-WEST BRT PROJECT

WASHINGTON

SHIMMICK
 OYASHI, J.

Katz, Okitsu & Associates
 Traffic Engineers & Transportation Planners
 1055 Corporate Center Drive, Suite 300
 Monterey Park, California 91754-7642
 Tel: (323) 260-4703 Fax: (323) 260-4705

NORTH HOLLYWOOD TO WARNER CENTER
 GROUP 1 INTERSECTIONS
 RESTORATION TRAFFIC SIGNAL
 CHANDLER BLVD., COLDWATER CYN AVE.
 AND BUSWAY

SEGMENT NO C-0675
 DRAWING NO GITS-001
 SCALE 1" = 20'
 SHEET NO 1