


CONSTRUCTION NOTES:

1. THE CONTRACTOR SHALL BE RESPONSIBLE FOR LABOR AND MATERIAL INVOLVED IN THE REMOVAL, MARKOUT, AND INSTALLATION OF ALL STRIPING, PAVEMENT MARKINGS, CURB MARKINGS, AND SIGNS SHOWN HEREON. REMOVAL OF MARKINGS SHALL BE PERFORMED BEFORE MARKOUT AND INSTALLATION OF NEW STRIPING, AND SHALL BE BY SANDBLASTING/GRINDING IN ACCORDANCE WITH LADOT SPECIFICATION NO. 76-016-10. MARKOUT SHALL BE BY SPRAY PAINT OR HEAVY PAINT BRUSH MARKINGS OVER A PULLED ROPE IN THE RESPECTIVE WHITE OR YELLOW COLORS OF THE PROPOSED STRIPING. FINAL STRIPING AND PAVEMENT MARKINGS SHALL BE IN HOT APPLIED ALKYD THERMOPLASTIC IN ACCORDANCE WITH LADOT SPECIFICATIONS NOS. 51-005-10 AND 76-012-15.
2. THE INSTALLATION OF THERMOPLASTIC STRIPING MAY PROCEED ONLY AFTER INSPECTION AND APPROVAL OF MARKOUT BY THE LADOT MAJOR CONSTRUCTION TRAFFIC MANAGEMENT DIVISION. THE CONTRACTOR SHALL CORRECT ALL ERRORS IN MARKOUT REQUESTED BY LADOT. UPON APPROVAL OF MARKOUT, THE CONTRACTOR SHALL FULLY INSTALL THE THERMOPLASTIC STRIPING, PAVEMENT MARKINGS, (CURB MARKINGS, AND SIGNS-AS APPLICABLE) WITHIN THE FOLLOWING THREE (3) WORKING DAYS. THE CONTRACTOR SHALL NOTIFY THE LADOT MAJOR CONSTRUCTION TRAFFIC MANAGEMENT IN WRITING, (213) 485-2610 AT THE FOLLOWING POINTS IN TIME, AND FOR THE FOLLOWING PURPOSES:
 - A. TEN (10) WORKING DAYS IN ADVANCE OF MARKOUT.
 - B. UPON COMPLETION OF MARKOUT (INCLUDING ANY MARKOUT CORRECTIONS) FOR INSPECTION AND APPROVAL.
 - C. UPON COMPLETION OF THERMOPLASTIC STRIPING (INCLUDING ANY THERMOPLASTIC STRIPING CORRECTIONS) FOR INSPECTION AND FINAL STRIPING APPROVAL.
3. DURING ALL PHASES OF CONSTRUCTION, TEMPORARY RAISED OVERLAY PAVEMENT MARKERS SHALL BE MAINTAINED ADJACENT TO ANY TEMPORARY CENTERLINE, MARKOUT CENTERLINE, OR SCAR OF THE SANDBLASTED CENTERLINE, AS APPLICABLE, AS PER LADOT STANDARD PLAN NO. S-453.0.
4. THE FIELD CONDITIONS SHOWN AS EXISTING ON THIS PLAN MAY CHANGE BETWEEN THE PLAN APPROVAL DATE AND THE IMPLEMENTATION DATE. THE CONTRACTOR MAY BE REQUIRED TO INSTALL OR REMOVE STRIPING, PAVEMENT MARKINGS, SIGNS, OR OTHER TRAFFIC CONTROL DEVICES BEYOND THOSE INDICATED ON THIS PLAN, IN ORDER TO FACILITATE THESE CHANGES IN FIELD CONDITIONS AND/OR TO BE IN COMPLIANCE WITH LADOT STANDARDS AND SPECIFICATIONS. IF THIS PLAN HAS NOT BEEN INSTALLED WITHIN TWO (2) YEARS OF THE APPROVAL DATE, IT SHALL BE RESUBMITTED TO LADOT GEOMETRIC DESIGN SECTION FOR REAPPROVAL PRIOR TO PROCEEDING TO CONSTRUCTION.

LEGEND

1. = EXISTING STRIPING & MARKINGS TO REMAIN.
 = EXISTING STRIPING & MARKINGS TO BE REMOVED.
 = PROPOSED STRIPING & MARKINGS.
2. = EXISTING SIGN AND POST.
 = EXISTING SIGN AND POST TO BE REMOVED OR RELOCATED.
 = PROPOSED SIGN AND POST.
3. = SIGNALIZED INTERSECTION.
4. = EXISTING RED CURB MARKINGS TO REMAIN.
 = EXISTING RED CURB MARKINGS TO BE REMOVED.
 = PROPOSED RED CURB MARKINGS.
5. = (EXISTING BIKE PATH MARKINGS).
 = (EXISTING BIKE PATH MARKINGS TO BE REMOVED).
 = (PROPOSED BIKE PATH MARKINGS).
6. TVE = "TRANSIT VEHICLE EXEMPT" SIGN.

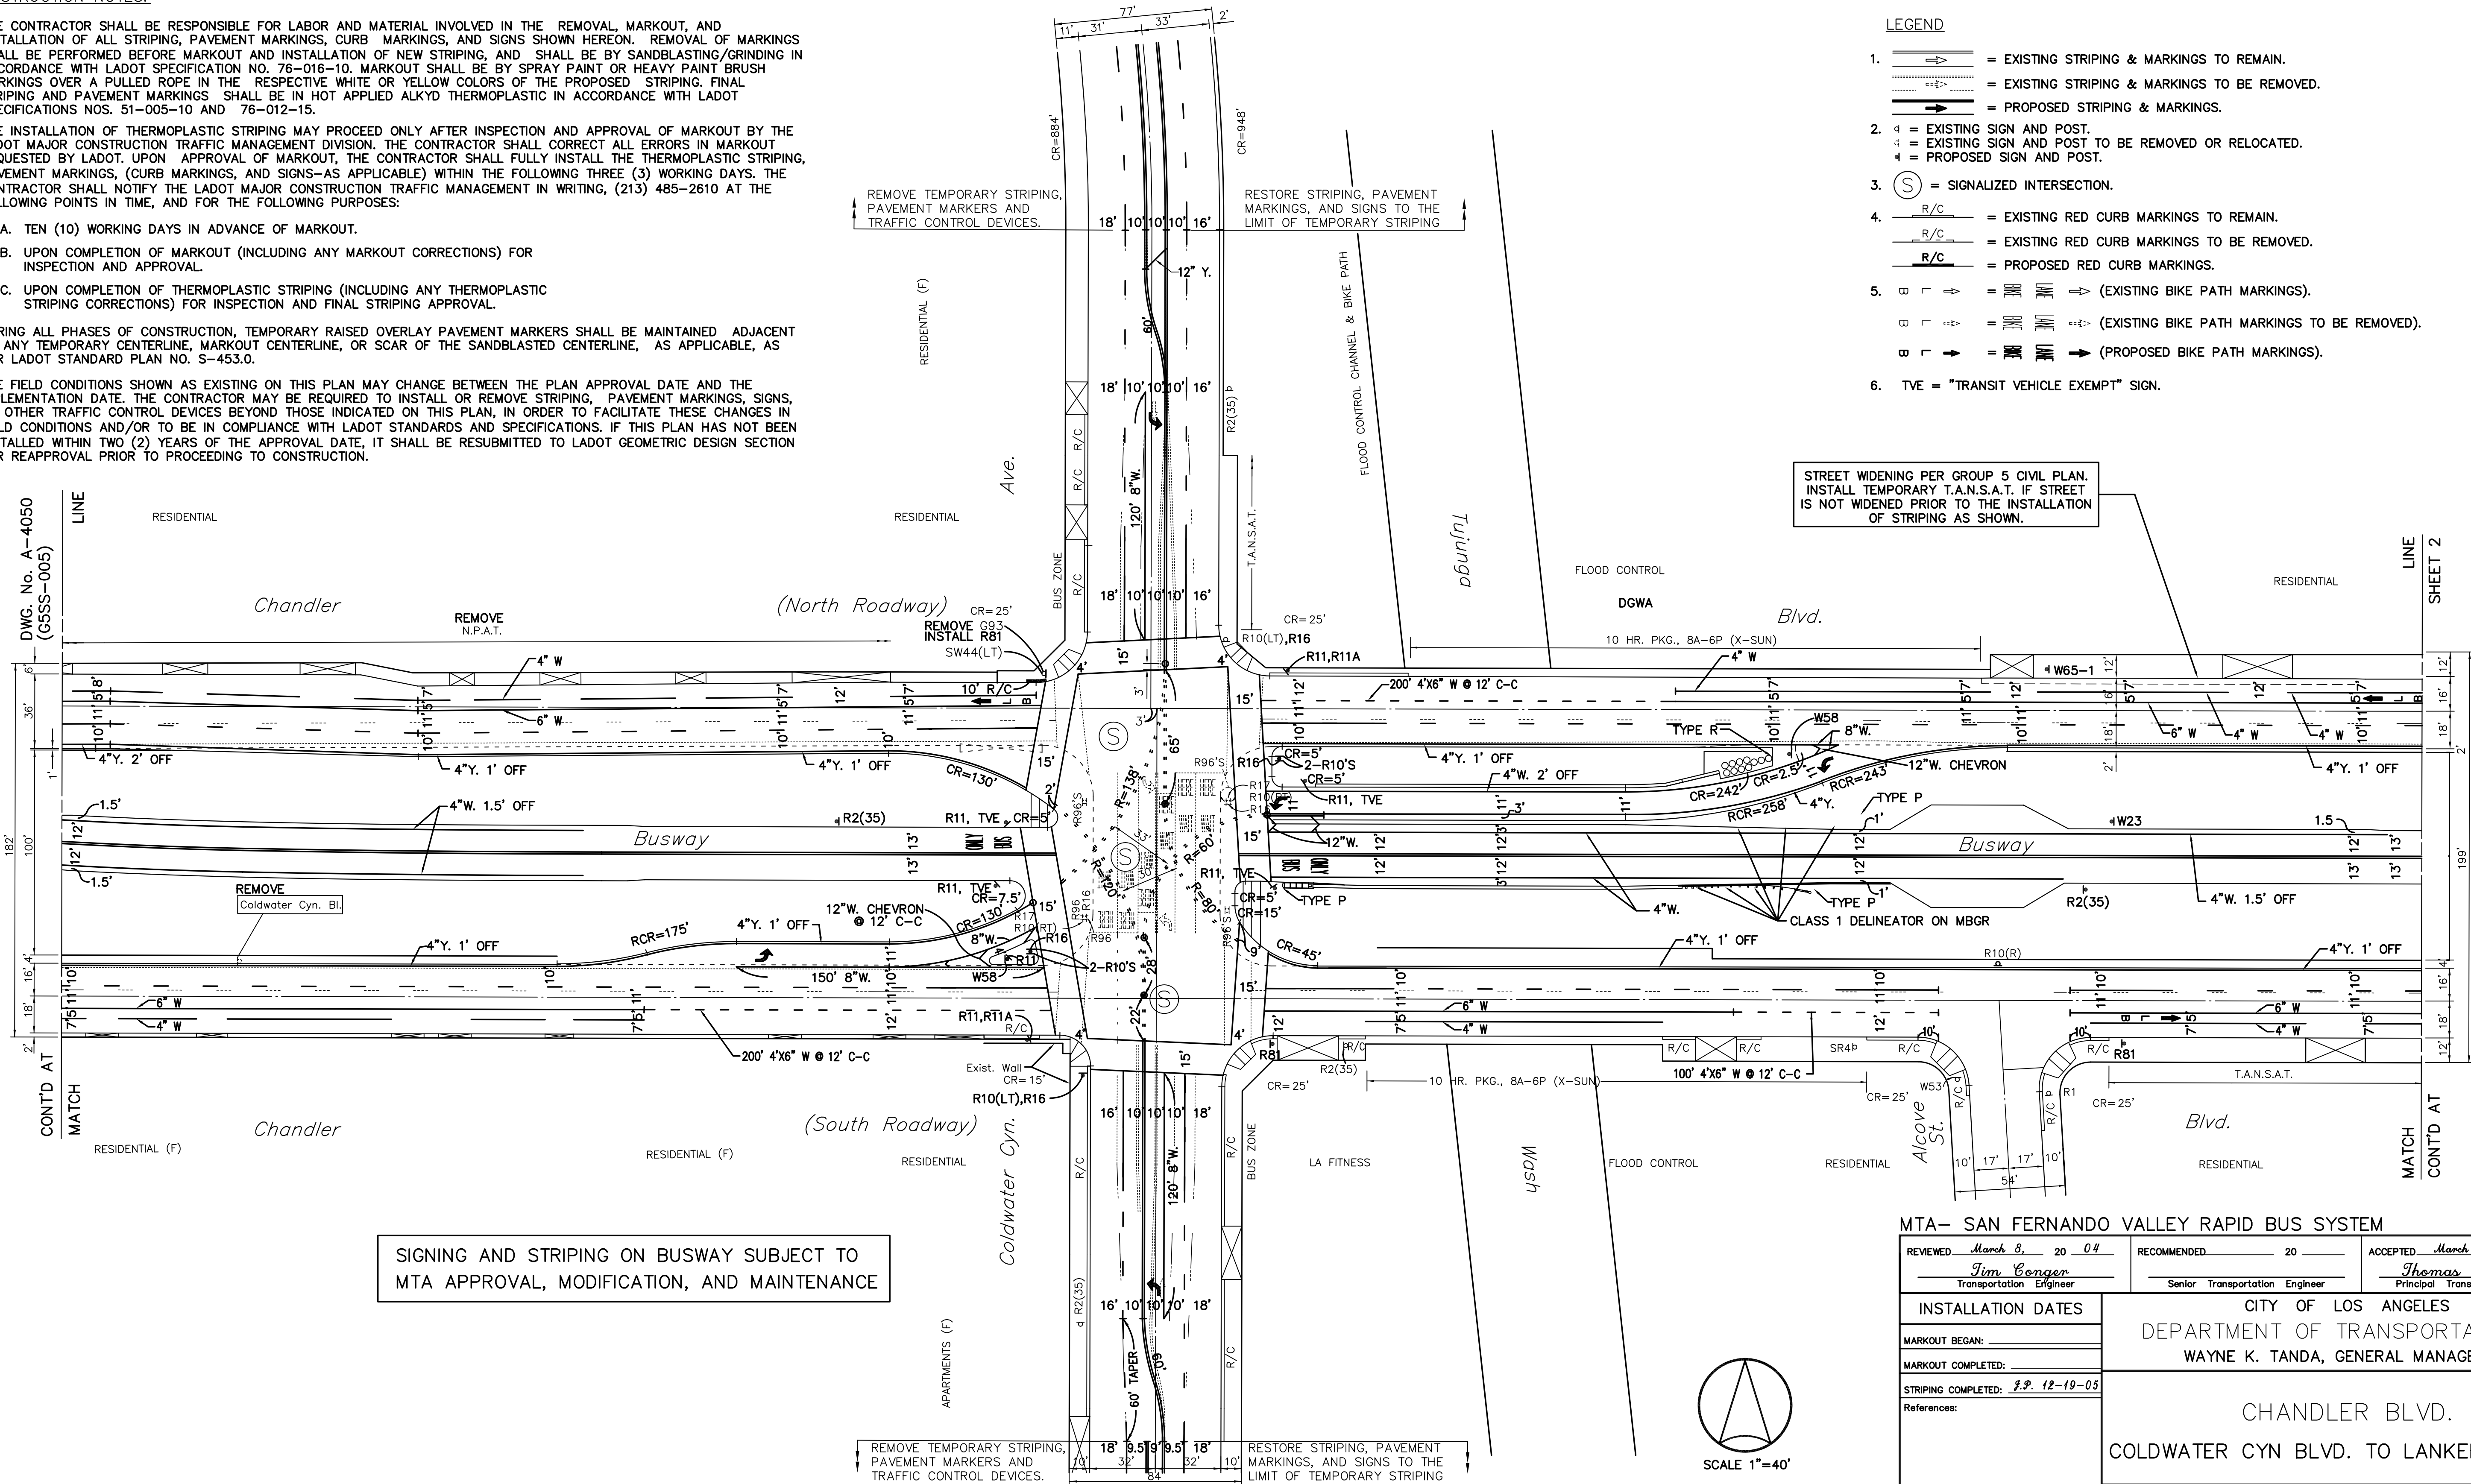

MTA- SAN FERNANDO VALLEY RAPID BUS SYSTEM

REVIEWED <u>March 8, 20 04</u>	RECOMMENDED <u>20</u>	ACCEPTED <u>March 8, 20 04</u>
<u>Jim Conger</u> Transportation Engineer	<u>Senior Transportation Engineer</u>	<u>Thomas L. Jones</u> Principal Transportation Engineer
INSTALLATION DATES		
CITY OF LOS ANGELES DEPARTMENT OF TRANSPORTATION WAYNE K. TANDA, GENERAL MANAGER		
MARKOUT BEGAN:		
MARKOUT COMPLETED:		
STRIPING COMPLETED: <u>8.8. 12-19-05</u>		
References:		
CHANDLER BLVD. COLDWATER CYN BLVD. TO LANKERSIM BLVD.		
Thomas Guide	District	PROJECT NO. 74720
562,E2	E.V.	DRAWING NO. A-3920
		1/1



REV	DATE	BY	APP	REG NO	EXPIRES	SEAL HOLDER	DESCRIPTION
2	02-10-06	AXK					AS-BUILT RECORD DRAWING
1	06-22-04	APC	WJO	52655	12/31/06	WALTER J. OKITSU	UPDATE CHANGES PER CIVIL DESIGN
0	03-04-04	APC	WJO	52655	12/31/06	WALTER J. OKITSU	ISSUED FOR CONSTRUCTION


DESIGNED BY
A. CALDERON
DRAWN BY
J. BERNAL
CHECKED BY
D. YEH
IN CHARGE
W. OKITSU
DATE
03-04-04



LOS ANGELES COUNTY METROPOLITAN TRANSPORTATION AUTHORITY
SAN FERNANDO VALLEY EAST-WEST BRT PROJECT



WASHINGTON

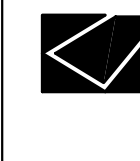

Katz, Okitsu & Associates
Traffic Engineers & Transportation Planners
1055 Corporate Center Drive, Suite 300
Monterey Park, California 91754-7642
Tel: (323) 260-4703 Fax: (323) 260-4705

NORTH HOLLYWOOD TO WARNER CENTER
GROUP 1 INTERSECTIONS
RESTORATION SIGNING & STRIPING
CHANDLER BLVD.
COLDWATER CYN BLVD. TO LANKERSIM BLVD.

SEGMENT NO	C-0675
DRAWING NO	GISS-001
SCALE	1" = 40'
SHEET NO	2