
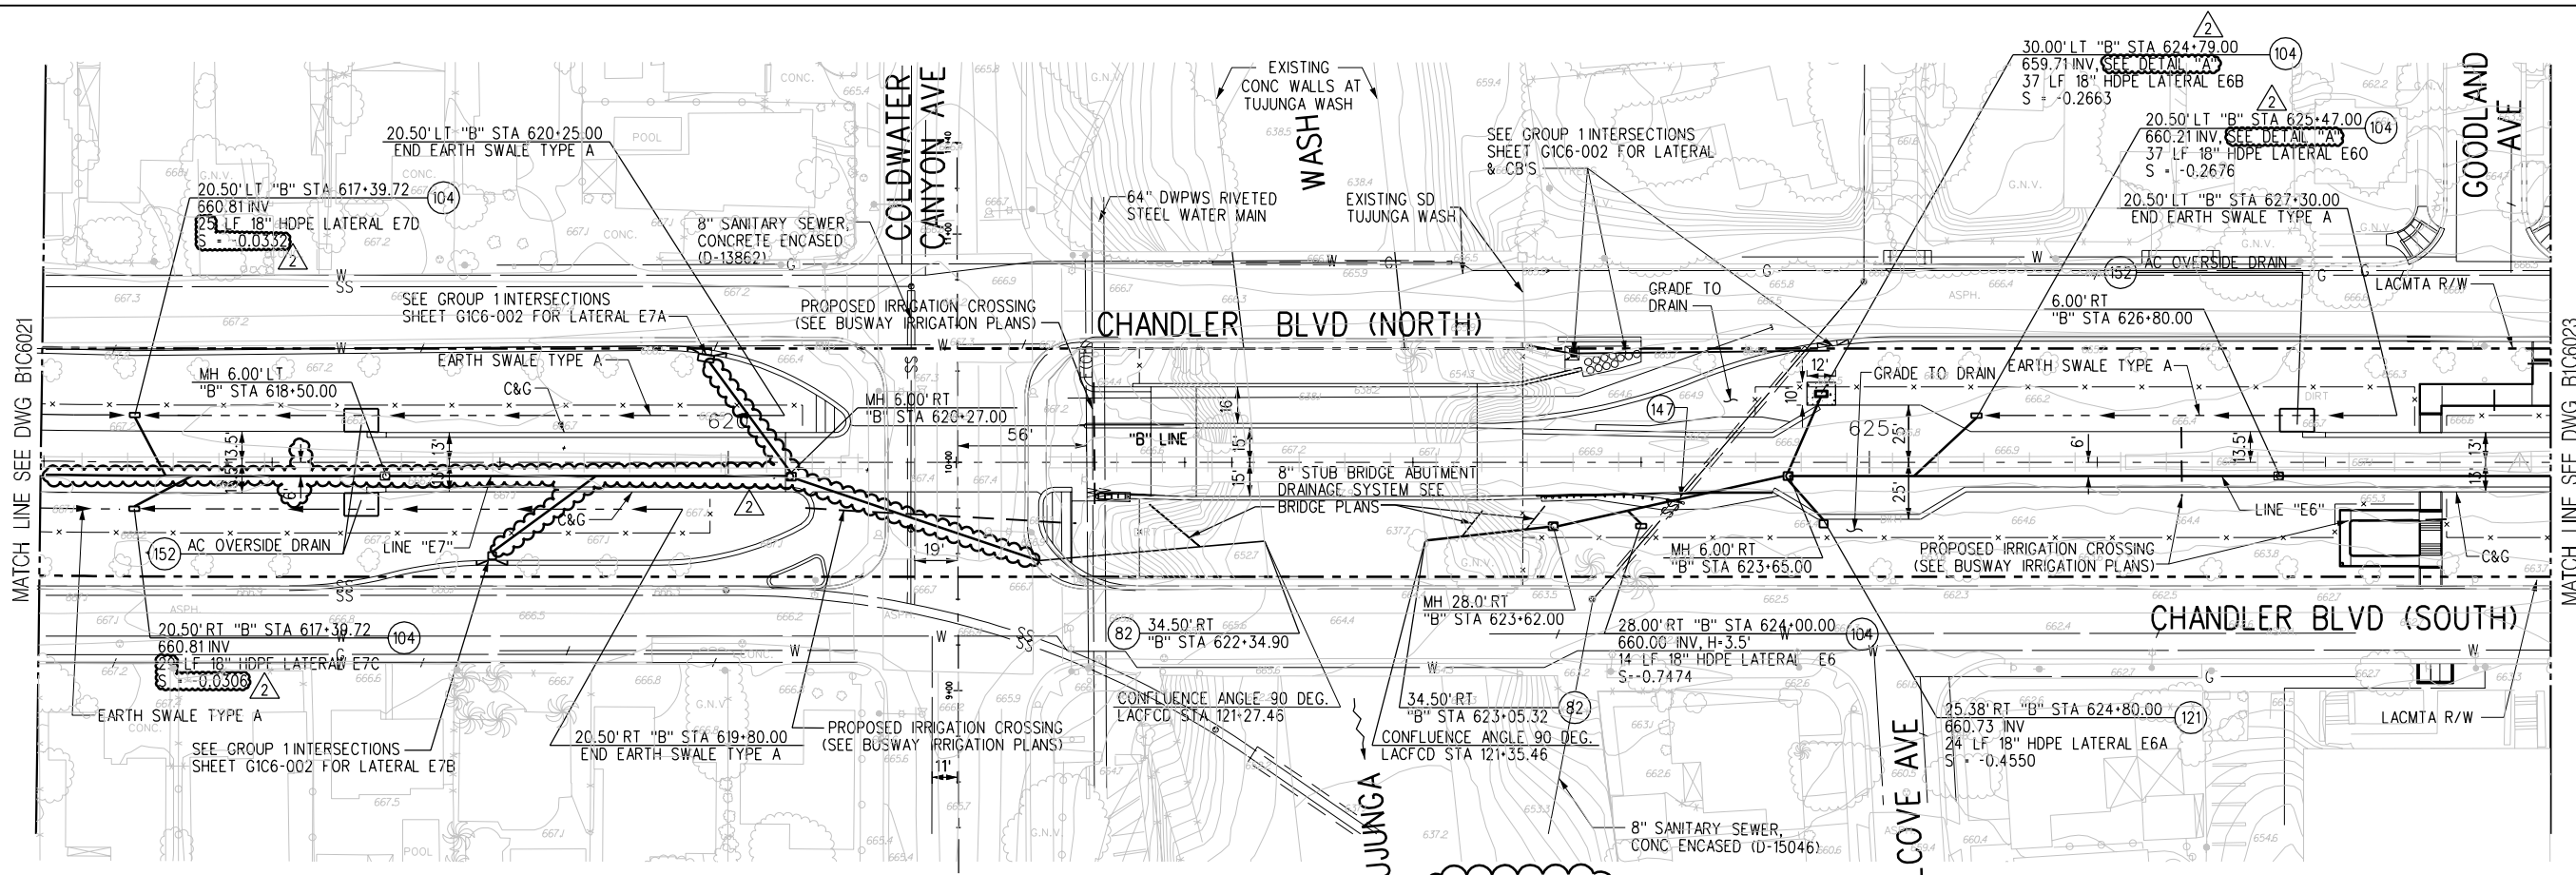


- NOTES:
- IMPROVEMENTS NOT TO BE MAINTAINED BY LACFCD.
 - THE BRT PROJECT DATUM IS NAVD '88 WHICH IN THIS VICINITY IS APPROXIMATELY 2.22' HIGHER THAN LACFCD TUJUNGA WASH AS-BUILT NGVD '29 DATUM.
 - MINIMUM PIPE STIFFNESS FOR THE 24" HDPE PIPE IS 34 PSI/AS SET BY AASHTO M-294. SEE DRAWING NO. B1C6035 FOR BEDDING AND LOADING DETAILS.
 - FOR SWALE AND DITCH SECTIONS SEE DRAINAGE DETAIL SHEETS.

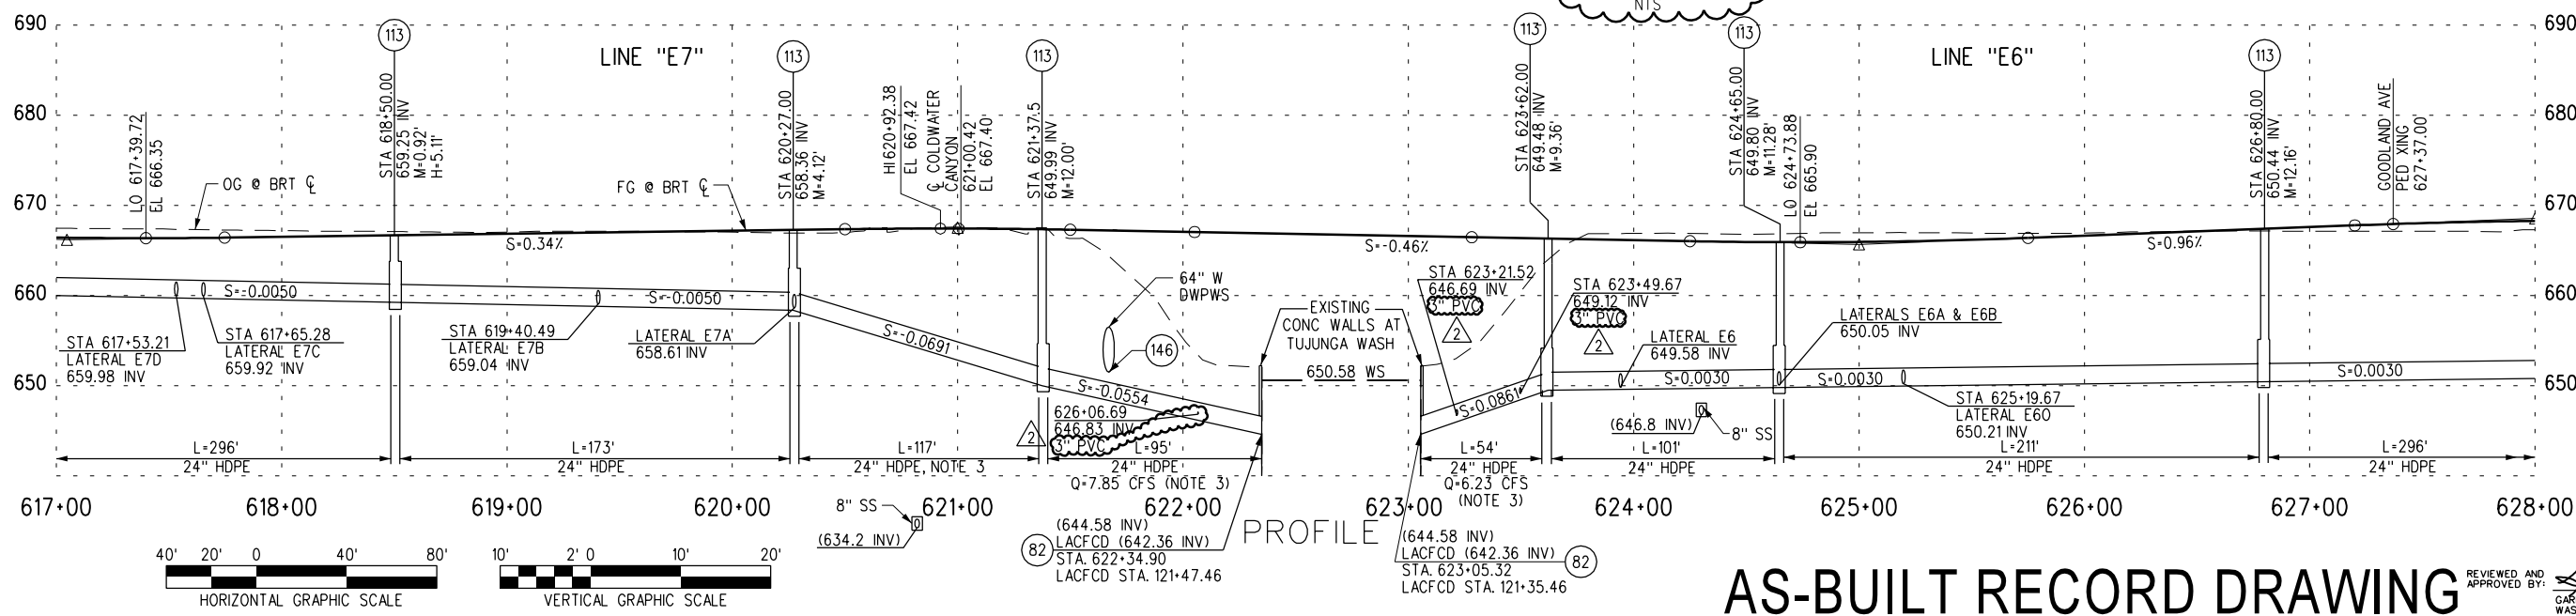

AS-BUILT RECORD DRAWING

REVIEWED AND APPROVED BY: *Garry J. Jess*
GARRY J. JESS, PROJECT MANAGER
WASHINGTON GROUP INTERNATIONAL

REV	DATE	BY	APP	REG NO	EXPIRES	SEAL HOLDER	DESCRIPTION
2	10/18/05	AU	TG				AS-BUILT RECORD DRAWING
1	1/22/04	CC	BEJ	C59517	12/31/05	BRETT E. JONES	ISSUED FOR CONSTRUCTION - 1B
0	12/31/03	CC	BEJ	C59517	12/31/05	BRETT E. JONES	ISSUED FOR CONSTRUCTION

DESIGNED BY
H. BULLOCK
DRAWN BY
A. GOMEZ
CHECKED BY
D. ORTIZ
IN CHARGE
B. JONES
DATE
2/12/04



LOS ANGELES COUNTY METROPOLITAN TRANSPORTATION AUTHORITY
SAN FERNANDO VALLEY EAST-WEST BRT PROJECT

WASHINGTON GROUP INTERNATIONAL, INC.
5805 SEPULVEDA BLVD., SUITE 500
VAN NUYS, CA 91411

SHIMMICK
OBAYASHI, JV
5805 SEPULVEDA BLVD., SUITE 500
VAN NUYS, CA 91411

BUSWAY SEGMENT 1 EAST
DRAINAGE PLAN & PROFILE
STA 617+00 TO STA 628+00
SHEET 10 OF 20

CONTRACT NO	C0675
DRAWING NO	B1C6022
SCALE	HORIZ 1"=40' VERT 1"=10'
SHEET NO	2