


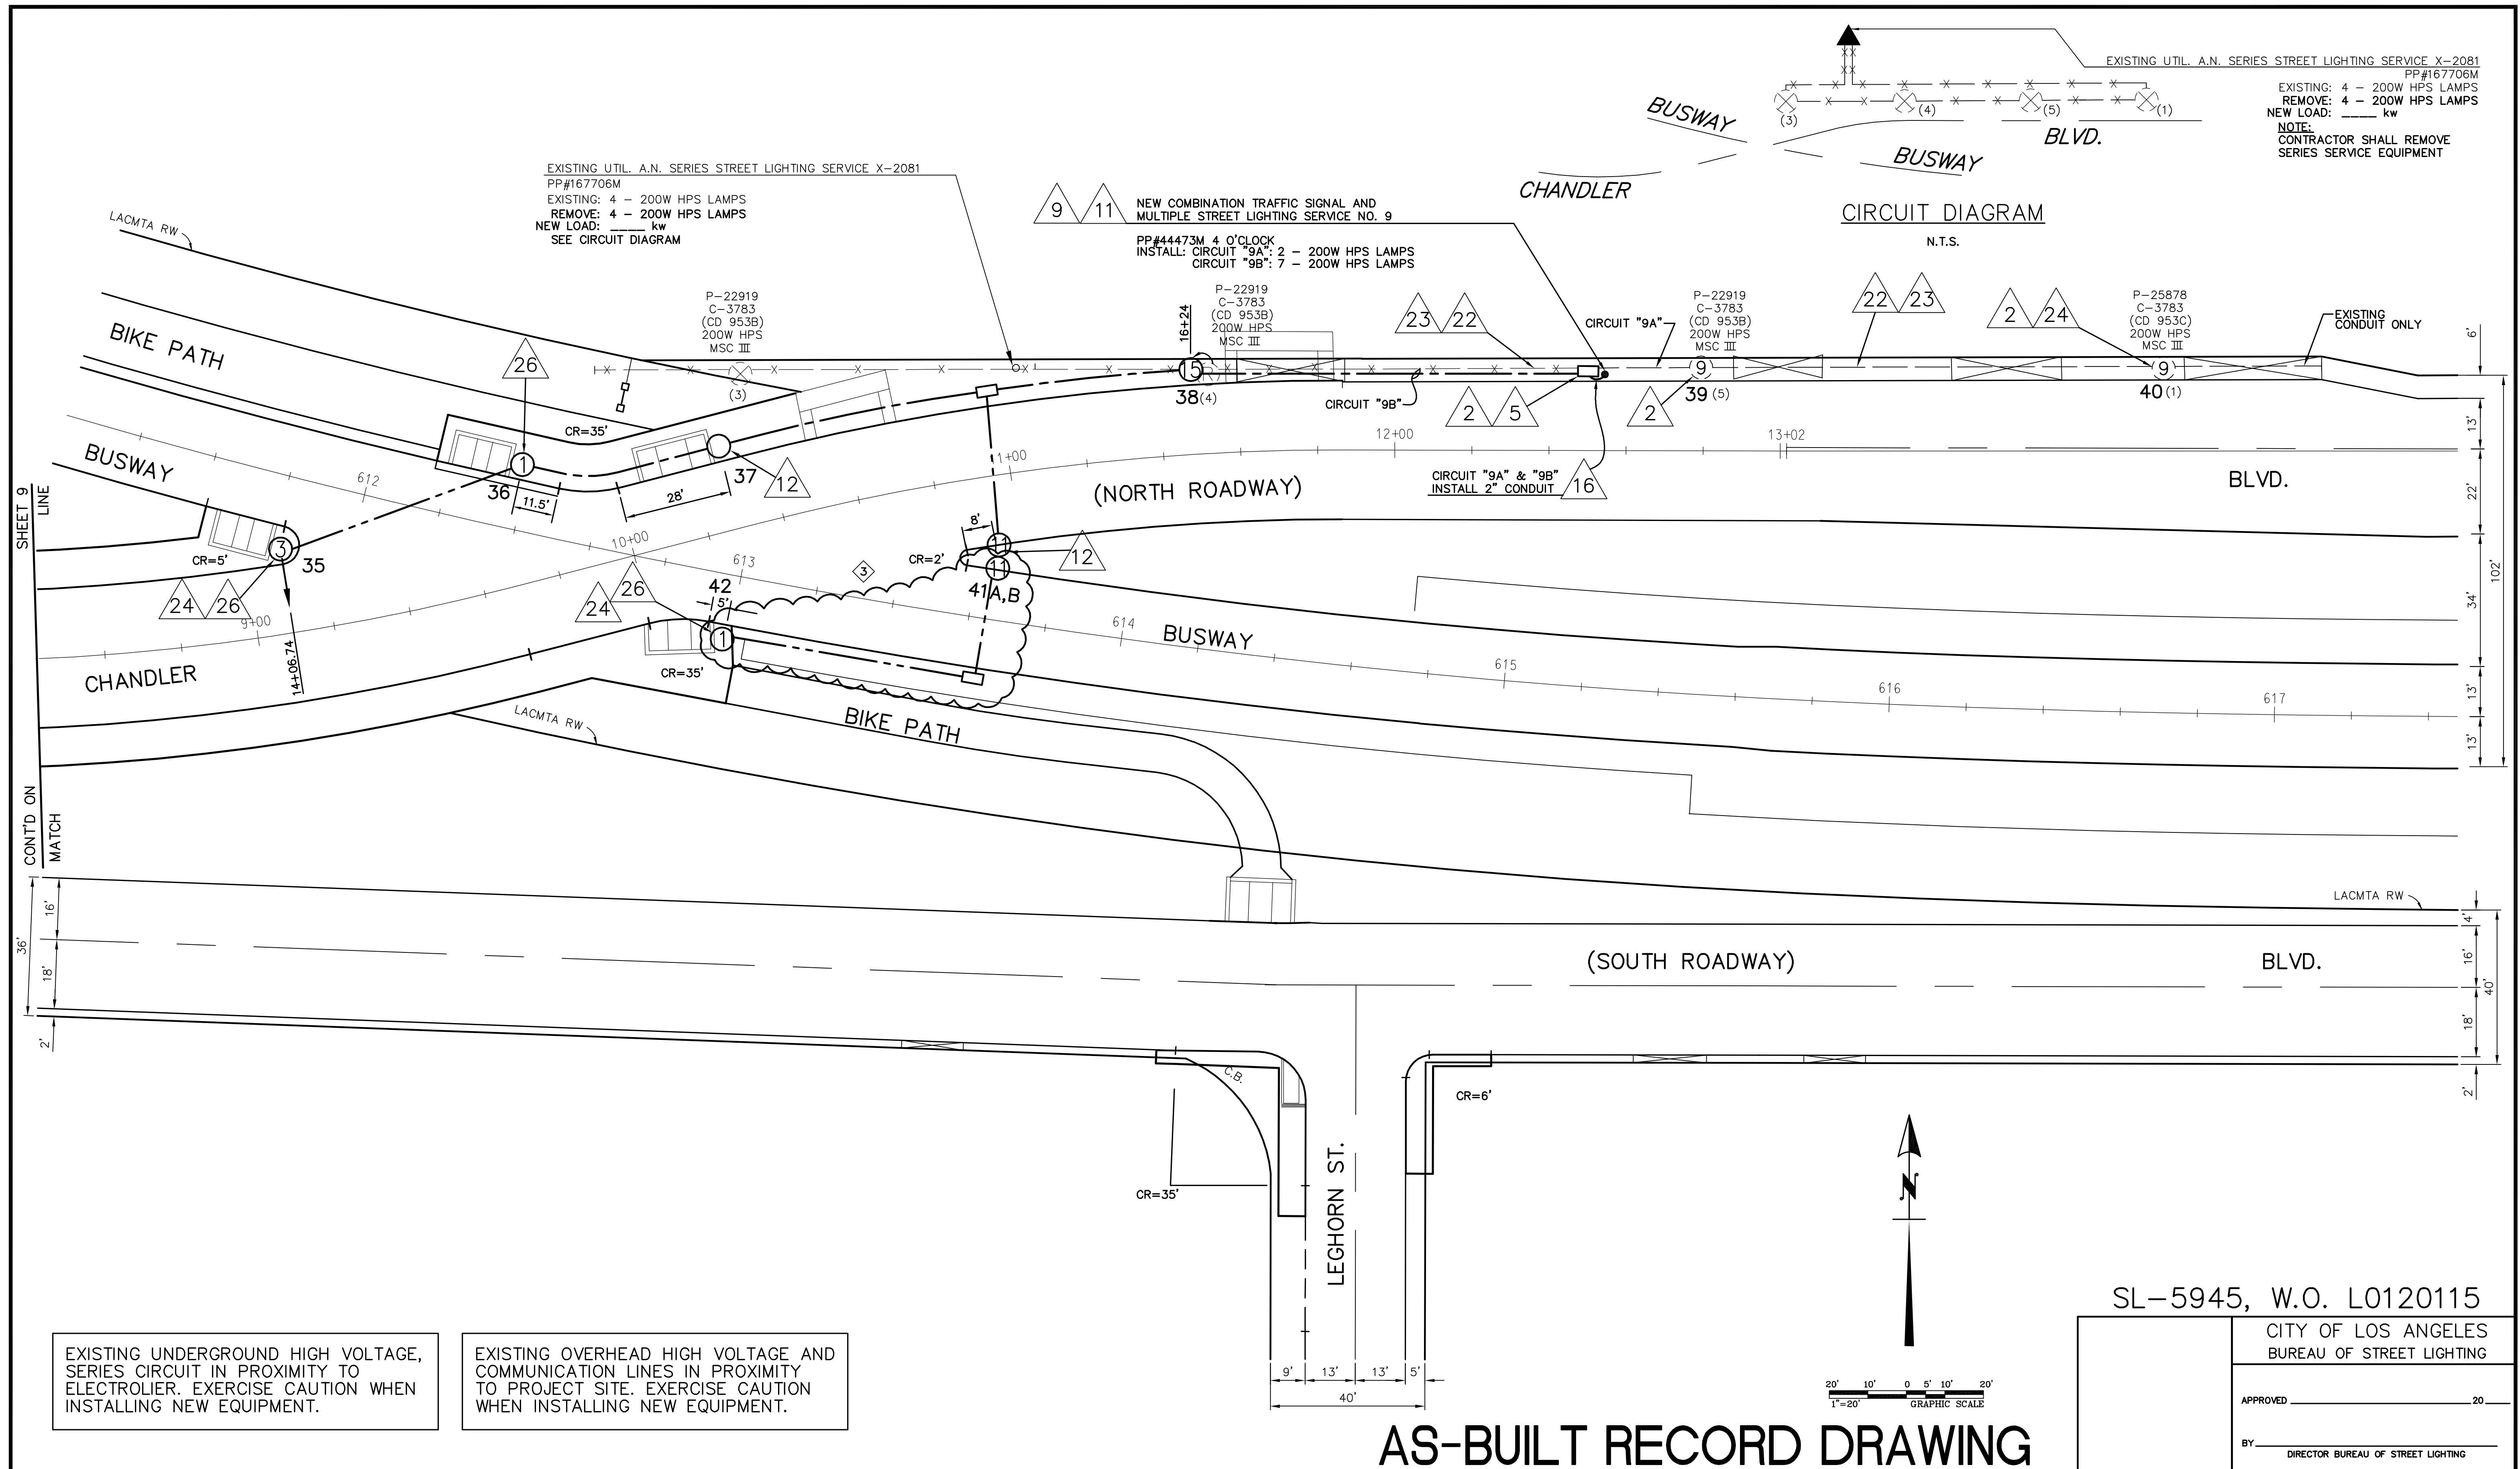

EXISTING UNDERGROUND HIGH VOLTAGE, SERIES CIRCUIT IN PROXIMITY TO ELECTROLIER. EXERCISE CAUTION WHEN INSTALLING NEW EQUIPMENT.										EXISTING OVERHEAD HIGH VOLTAGE AND COMMUNICATION LINES IN PROXIMITY TO PROJECT SITE. EXERCISE CAUTION WHEN INSTALLING NEW EQUIPMENT.									
AS-BUILT RECORD DRAWING										AS-BUILT RECORD DRAWING									
DESIGNED BY E. OKITSU										DRAWN BY J. BERNAL									
CHECKED BY D. YEH										IN CHARGE W. OKITSU									
DATE 06/11/04										DATE 06/11/04									
REV										DESCRIPTION									
3										AS-BUILT RECORD DRAWING									
2										SERVICE LOCATION CHANGE - IFC									
1										CHANGES PER DWP OVERHEAD CONFLICT									
0										ISSUED FOR CONSTRUCTION									
REV										DESCRIPTION									
3										AS-BUILT RECORD DRAWING									
2										SERVICE LOCATION CHANGE - IFC									
1										CHANGES PER DWP OVERHEAD CONFLICT									
0										ISSUED FOR CONSTRUCTION									
REV										DESCRIPTION									

LOS ANGELES COUNTY METROPOLITAN TRANSPORTATION AUTHORITY
SAN FERNANDO VALLEY EAST-WEST BRT PROJECT

WASHINGTON

SHIMMICK
OBAYASHI, JV

Katz, Okitsu & Associates
Traffic Engineers & Transportation Planners
1055 Corporate Center Drive, Suite 300
Monterey Park, California 91754-7642
Tel: (323) 260-4703 Fax: (323) 260-4705

NORTH HOLLYWOOD TO WARNER CENTER
GROUP 5 INTERSECTIONS
RESTORATION STREET LIGHTING
CHANDLER BLVD. & BUSWAY
(SHEET 10 OF 10)

SEGMENT NO
C0675
DRAWING NO
G5SL-010
SCALE
1" = 20'
SHEET NO
3