



S I G N A L S T A N D A R D S C H E D U L E					
No.	TYPE	FOUND. TYPE	PED. PUSH BUTN TYPE	PHASE	REMARKS
1	332 CAB.	F-332			ATSAC 2070 CONTROLLER IN 332 CAB.
2	CD954	F-2			15' M.A.
3	7	F-7	PTM	2	
4	CD954	F-2	6"	2	CUSTOM 12' M.A.
5	1	F-1	4"	1	
6	CD953C*	*			
7	CD953C-2*	*			SIGN DETAIL "A"
8	CD954	F-2	6"	1	CUSTOM 12' M.A.
9	1	F-1			

* For reference only; see Street Lighting sheet

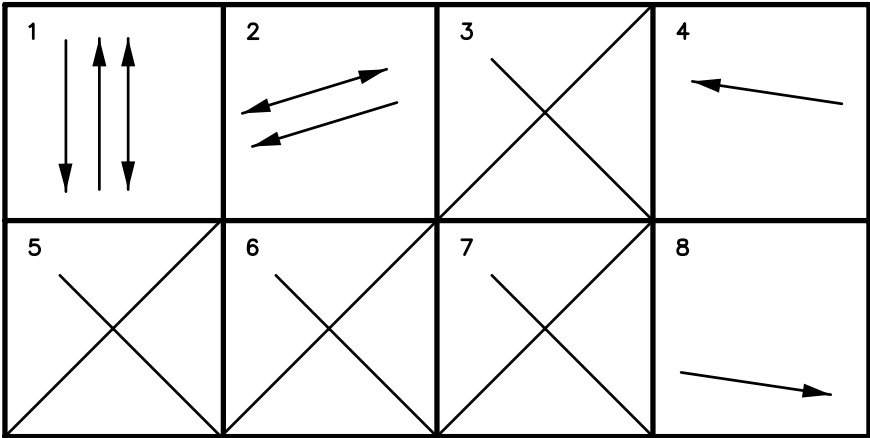

PROPOSED PHASE DIAGRAM

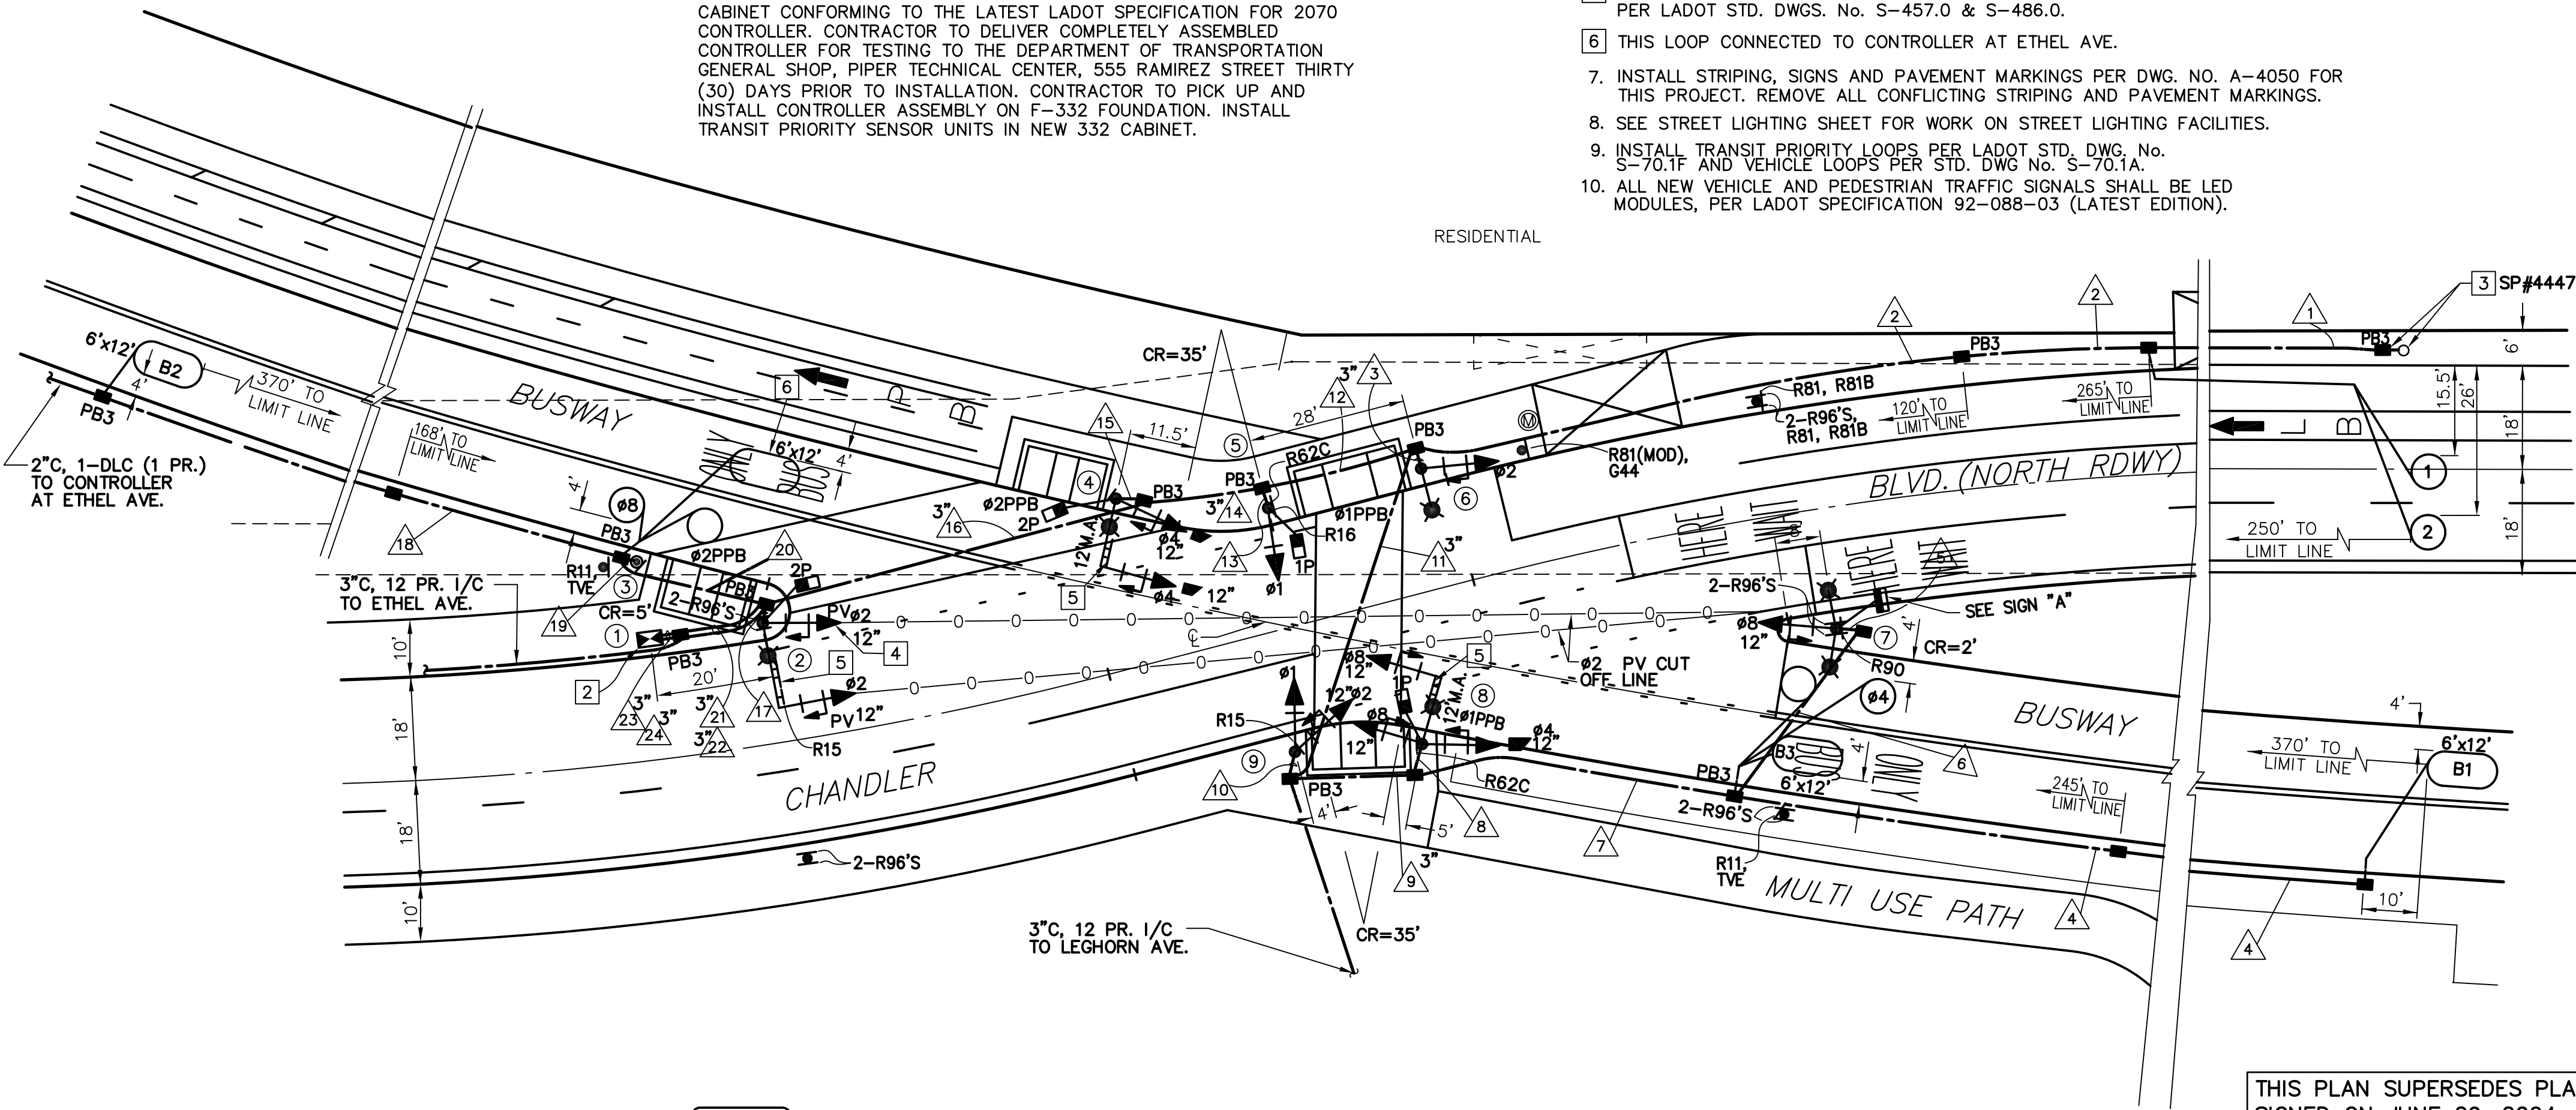

BUS COMING
LED SIGN
SIGN "A"
Not to Scale
LED SIGN SHALL BE PER
LADOT Std. Dwg. No. S-58.13A

NOTES:

- SEMI-ACTUATED OPERATION (ATSAC 2070 CONTROLLER WITH TRANSIT PRIORITY IN 332 CABINET)
 01 - BIKE & PED XING
 02 - CHANDLER BLVD WB & N/S PED XING
 04 - BRT NB
 08 - BRT SB
 VICTORY CORRIDOR EAST ATSAC SYSTEM
 DIRECT WIRE (CABLE) INTERCONNECT
- INSTALL ATSAC 2070 CONTROLLER IN 332 CABINET. THE CONTRACTOR SHALL PROVIDE A COMPLETE FUNCTIONING CONTROLLER ASSEMBLY AND CABINET CONFORMING TO THE LATEST LADOT SPECIFICATION FOR 2070 CONTROLLER. CONTRACTOR TO DELIVER COMPLETELY ASSEMBLED CONTROLLER FOR TESTING TO THE DEPARTMENT OF TRANSPORTATION GENERAL SHOP, PIPER TECHNICAL CENTER, 555 RAMIREZ STREET THIRTY (30) DAYS PRIOR TO INSTALLATION. CONTRACTOR TO PICK UP AND INSTALL CONTROLLER ASSEMBLY ON F-332 FOUNDATION. INSTALL TRANSIT PRIORITY SENSOR UNITS IN NEW 332 CABINET.

NOTES (CONT'D):

- INSTALL TWO-INCH (2") RISER (AT 4 O'CLOCK) ON SERVICE POLE No. 44473M. INSTALL SERVICE PER LADOT STD. DWG. NO. S-79.8. INSTALL 4 #6 SERVICE WIRES AND 60 AMP FUSE IN AN IN-LINE WATERPROOF FUSE HOLDER IN THE SERVICE PULLBOX. (ONE FOR CHANDLER BLVD./BUSWAY & ONE FOR CHANDLER BLVD./LEGHORN AVE. PER LADOT STD. DWG. NO. S-79.8. WORK ON ANY ELECTRICAL SERVICE EQUIPMENT TO BE DONE ONLY IN CONJUNCTION WITH THE DEPARTMENT OF WATER & POWER PERSONNEL. CONTACT DWP PERSONNEL. CONTACT DWP AT (213) 367-3003 SEVEN (7) WORKING DAYS PRIOR TO BEGINNING OF WORK.
- MOUNT PV HEAD AT 14' HEIGHT.
- CONTRACTOR SHALL PROVIDE AND INSTALL LARGE STREET NAME SIGNS PER LADOT STD. DWGS. No. S-457.0 & S-486.0.
- THIS LOOP CONNECTED TO CONTROLLER AT ETHEL AVE.
- INSTALL STRIPING, SIGNS AND PAVEMENT MARKINGS PER DWG. NO. A-4050 FOR THIS PROJECT. REMOVE ALL CONFLICTING STRIPING AND PAVEMENT MARKINGS.
- SEE STREET LIGHTING SHEET FOR WORK ON STREET LIGHTING FACILITIES.
- INSTALL TRANSIT PRIORITY LOOPS PER LADOT STD. DWG. NO. S-70.1F AND VEHICLE LOOPS PER STD. DWG. NO. S-70.1A.
- ALL NEW VEHICLE AND PEDESTRIAN TRAFFIC SIGNALS SHALL BE LED MODULES, PER LADOT SPECIFICATION 92-088-03 (LATEST EDITION).

ESTIMATED MATERIAL FURNISHED BY LADOT	
UNITS	MATERIAL

ESTIMATED SALVAGE MATERIAL TO BE RETURNED TO LADOT	
UNITS	MATERIAL


C O N D U C T O R S C H E D U L E		R U N																											
SIZE No.	CABLE / WIRE	1	2	3	4	5	6	7	8	9	10	11	12	13	14	15	16	17	18	19	20	21	22	23	24	25	26	27	28
M U L T I	5 CONDUCTOR CABLE 5 X #14	1	2		4		2		2	3	3																		
	9 CONDUCTOR CABLE 8 X #14 & 1 X #12 (COM)																												
	12 CONDUCTOR CABLE 11 X #14 & 1 X #12 (COM)				1	1														1									
	28 CONDUCTOR CABLE 27 X #14 & 1 X #10 (COM)								1	1	1		1	1						1	1								
6	SERVICE	2	2						2	2	2		2	2						2	2								
14	PED PUSH BUTTON								2											2									
12	DLC BUS LOOP (1PR.)			1	2		2	2	2	2	2		2	2						1	3		3						
16	DLC (2PR.)	1			1	1	1	2	2	2										1	3		3						
22	INTERCONNECT (12PR.)								1	1	1		1	1										1	2				
CONDUIT SIZE		2"	2"	2"	2"	2"	2"	2"	3"	2"	3"	3"	2"	3"	2"	3"	2"	1"	2"	3"	3"	3"							

NOTICE TO CONTRACTOR

- EXCEPT WHERE OTHERWISE INDICATED, MATERIALS AND INSTALLATION METHODS SHALL CONFORM TO THE LATEST EDITION, WITH SUPPLEMENTS, OF THE STANDARD SPECIFICATION FOR PUBLIC WORKS CONSTRUCTION, ADOPTED BY THE CITY OF LOS ANGELES BOARD OF PUBLIC WORKS (LAPBW), INCLUDING THE LATEST VERSION OF STANDARD PLAN S-610 ISSUED BY THE LAPBW, AND THE LATEST EDITION, WITH AMENDMENTS, OF THE SPECIAL PROVISIONS AND STANDARD DRAWINGS FOR THE INSTALLATION AND MODIFICATION OF TRAFFIC SIGNALS, ISSUED BY THE CITY OF LOS ANGELES DEPARTMENT OF TRANSPORTATION (LADOT).
- THE LADOT TRAFFIC SIGNAL INSPECTOR SHALL BE NOTIFIED AT (213) 792-7637. THE SENIOR MAINTENANCE SUPERVISOR AT (818) 756-7845, AND THE LADOT METRO RAIL ENGINEER AT (213) 485-2610 THREE (3) WORKING DAYS PRIOR TO THE BEGINNING OF CONSTRUCTION.
- NORMAL TRAFFIC CONTROL SHALL BE MAINTAINED FROM 6:00 A.M. TO 9:00 A.M. AND 3:00 P.M. TO 7:00 P.M. ON WEEKDAYS. HOURS AND DURATION WHEN TRAFFIC SIGNALS ARE DEACTIVATED AND/OR PLACED INTO FLASHING OPERATION REQUIRE THE PRIOR APPROVAL OF THE LADOT METRO RAIL ENGINEER. TRAFFIC SIGNAL DEACTIVATION AND/OR FLASHING OPERATION SHALL BE IMPLEMENTED BY A LADOT TRAFFIC SIGNAL ELECTRICIAN, IN COORDINATION WITH THE ATSAC CONTROL CENTER, AND SHALL BE REQUESTED THREE (3) WORKING DAYS IN ADVANCE THROUGH THE LADOT METRO RAIL ENGINEER, (213) 485-2610. FULL RESTORATION OF THE ATSAC SYSTEM MUST OCCUR WITHIN FIVE (5) WORKING DAYS AFTER DEACTIVATION.
- THE CONTRACTOR SHALL COORDINATE WITH THE LADOT SIGNAL SHOP AT (213) 847-2944 TO ARRANGE CONTROLLER DELIVERY. THE CONTRACTOR SHALL PROVIDE AND DELIVER A COMPLETE FUNCTIONING CONTROLLER ASSEMBLY AND CABINET TO THE LADOT SIGNAL SHOP THIRTY (30) CALENDAR DAYS PRIOR TO THE INSTALLATION DATE, AND PICK UP THE CONTROLLER WITHIN FIFTEEN (15) CALENDAR DAYS AFTER NOTIFICATION BY LADOT SIGNAL SHOP.
- ALL REMOVED TRAFFIC SIGNAL EQUIPMENT IDENTIFIED AS SALVAGED MATERIAL SHALL BE RETURNED TO LADOT. ARRANGEMENTS FOR RETURNING IDENTIFIED SIGN BRACKETS BY THE CONTRACTOR, EXCEPT WHERE OTHERWISE INDICATED, EXISTING LARGE STREET NAME SIGNS ON MAST ARM TYPE STANDARDS SHALL BE RELOCATED FROM THE VERTICAL POLE TO THE MAST ARM PER LADOT STANDARD DRAWING NO. S-457.0. WHEN CALLED OUT ON THIS PLAN, CONTRACTOR SHALL FURNISH AND INSTALL LARGE STREET NAME SIGNS AND SIGN BRACKETS FOR INSTALLATION ON MAST ARM PER LADOT STD. DWG. NO. S-457.0. ANY TRAFFIC SIGNING DAMAGED OR LOST BY THE CONTRACTOR SHALL BE REPLACED AT THE CONTRACTOR'S EXPENSE.
- THE CONTRACTOR SHALL FURNISH AND INSTALL, AS SHOWN ON THE PLANS, ALL TRAFFIC SIGNAL EQUIPMENT SUCH AS STANDARDS, MAST ARMS, SIGNAL HEADS, AND OTHER EQUIPMENT AS REQUIRED. ALL SUCH EQUIPMENT SHALL BE NEW. ALL SUCH EQUIPMENT SHALL BE IN ACCORDANCE WITH THE LATEST EDITION OF THE SIGNAL MANUAL. ALL VEHICLE HEAD EQUIPMENT SUPPLIED BY THE CONTRACTOR SHALL HAVE 1-1/2 INCH DIAMETER PIPE FIT MOUNTING HARDWARE, INCLUDING ALL TOP POST MOUNT HEADS. PED HEAD MODULE REPLACEMENTS SHOWN ON THE PLAN SHALL REQUIRE A COMPLETE INSTALLATION, INCLUDING NEW PED HEAD AND TERMINAL COMPARTMENT. LEFT TURN SIGNAL HEADS ON MAST ARMS WITH TWO OR MORE SIGNAL HEADS SHALL BE TOP MOUNTED.

M T A – S A N F E R N A N D O V A L L E Y R A P I D B U S S Y S T E M (N E W S I G N A L)

REVIEWED <i>November 3, 20 04</i> <i>Ina Van Der Laan</i> Transportation Engineer	RECOMMENDED <i>November 3, 20 04</i> <i>Fudy Wong</i> Senior Transportation Engineer	ACCEPTED <i>November 3, 20 04</i> <i>Thomas L. Jones</i> Principal Transportation Engineer
AS BUILT Date of Installation: <i>11-18-05</i> LADOT Inspector: <i>Allegria</i> Condition As Of: <i>11-18-05</i> LADOT Engineer: <i>J.P.</i> District: EAST VALLEY Thomas Guide: 582-02		
CITY OF LOS ANGELES DEPARTMENT OF TRANSPORTATION WAYNE K. TANDA, GENERAL MANAGER		
BUSWAY AND CHANDLER BLVD.		
References	File Name 32745-Q1.DWG	Intersection No. 32745
	Project No. 74720	
NOTICE: IF PLAN HAS NOT BEEN IMPLEMENTED WITHIN TWO (2) YEARS OF THE ACCEPTANCE DATE, IT MUST BE RESUBMITTED TO LADOT SIGNAL DESIGN SECTION FOR REVIEW AND APPROVAL.		

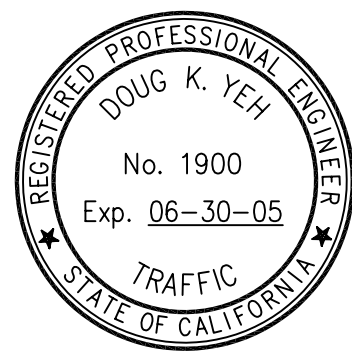


REV	DATE	BY	APP	REG NO	EXPIRES	SEAL HOLDER	DESCRIPTION
2	02-16-06	AXK					AS-BUILT RECORD DRAWING
1	10/11/04	GXF	WJO	52655	12/31/06	WALTER J. OKITSU	SERVICE LOCATION CHANGE - IFC
0	06/22/04	GXF	WJO	52655	12/31/06	WALTER J. OKITSU	ISSUED FOR CONSTRUCTION

DESIGNED BY
G. FIGUEROA
DRAWN BY
G. FIGUEROA
CHECKED BY
D. YEH
IN CHARGE
W. OKITSU
DATE
06-22-04



LOS ANGELES COUNTY METROPOLITAN TRANSPORTATION AUTHORITY
SAN FERNANDO VALLEY EAST-WEST BRT PROJECT

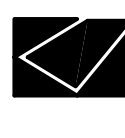

Katz, Okitsu & Associates
Traffic Engineers & Transportation Planners
1055 Corporate Center Drive, Suite 300
Monterey Park, California 91754-7642
Tel: (323) 260-4703 Fax: (323) 260-4705

NORTH HOLLYWOOD TO WARNER CENTER
GROUP 5 INTERSECTIONS
NEW TRAFFIC SIGNAL
BUSWAY AND
CHANDLER BLVD.

SEGMENT NO C-0675	
DRAWING NO G5TS-006	REV 2
SCALE 1" = 20'	
SHEET NO	