



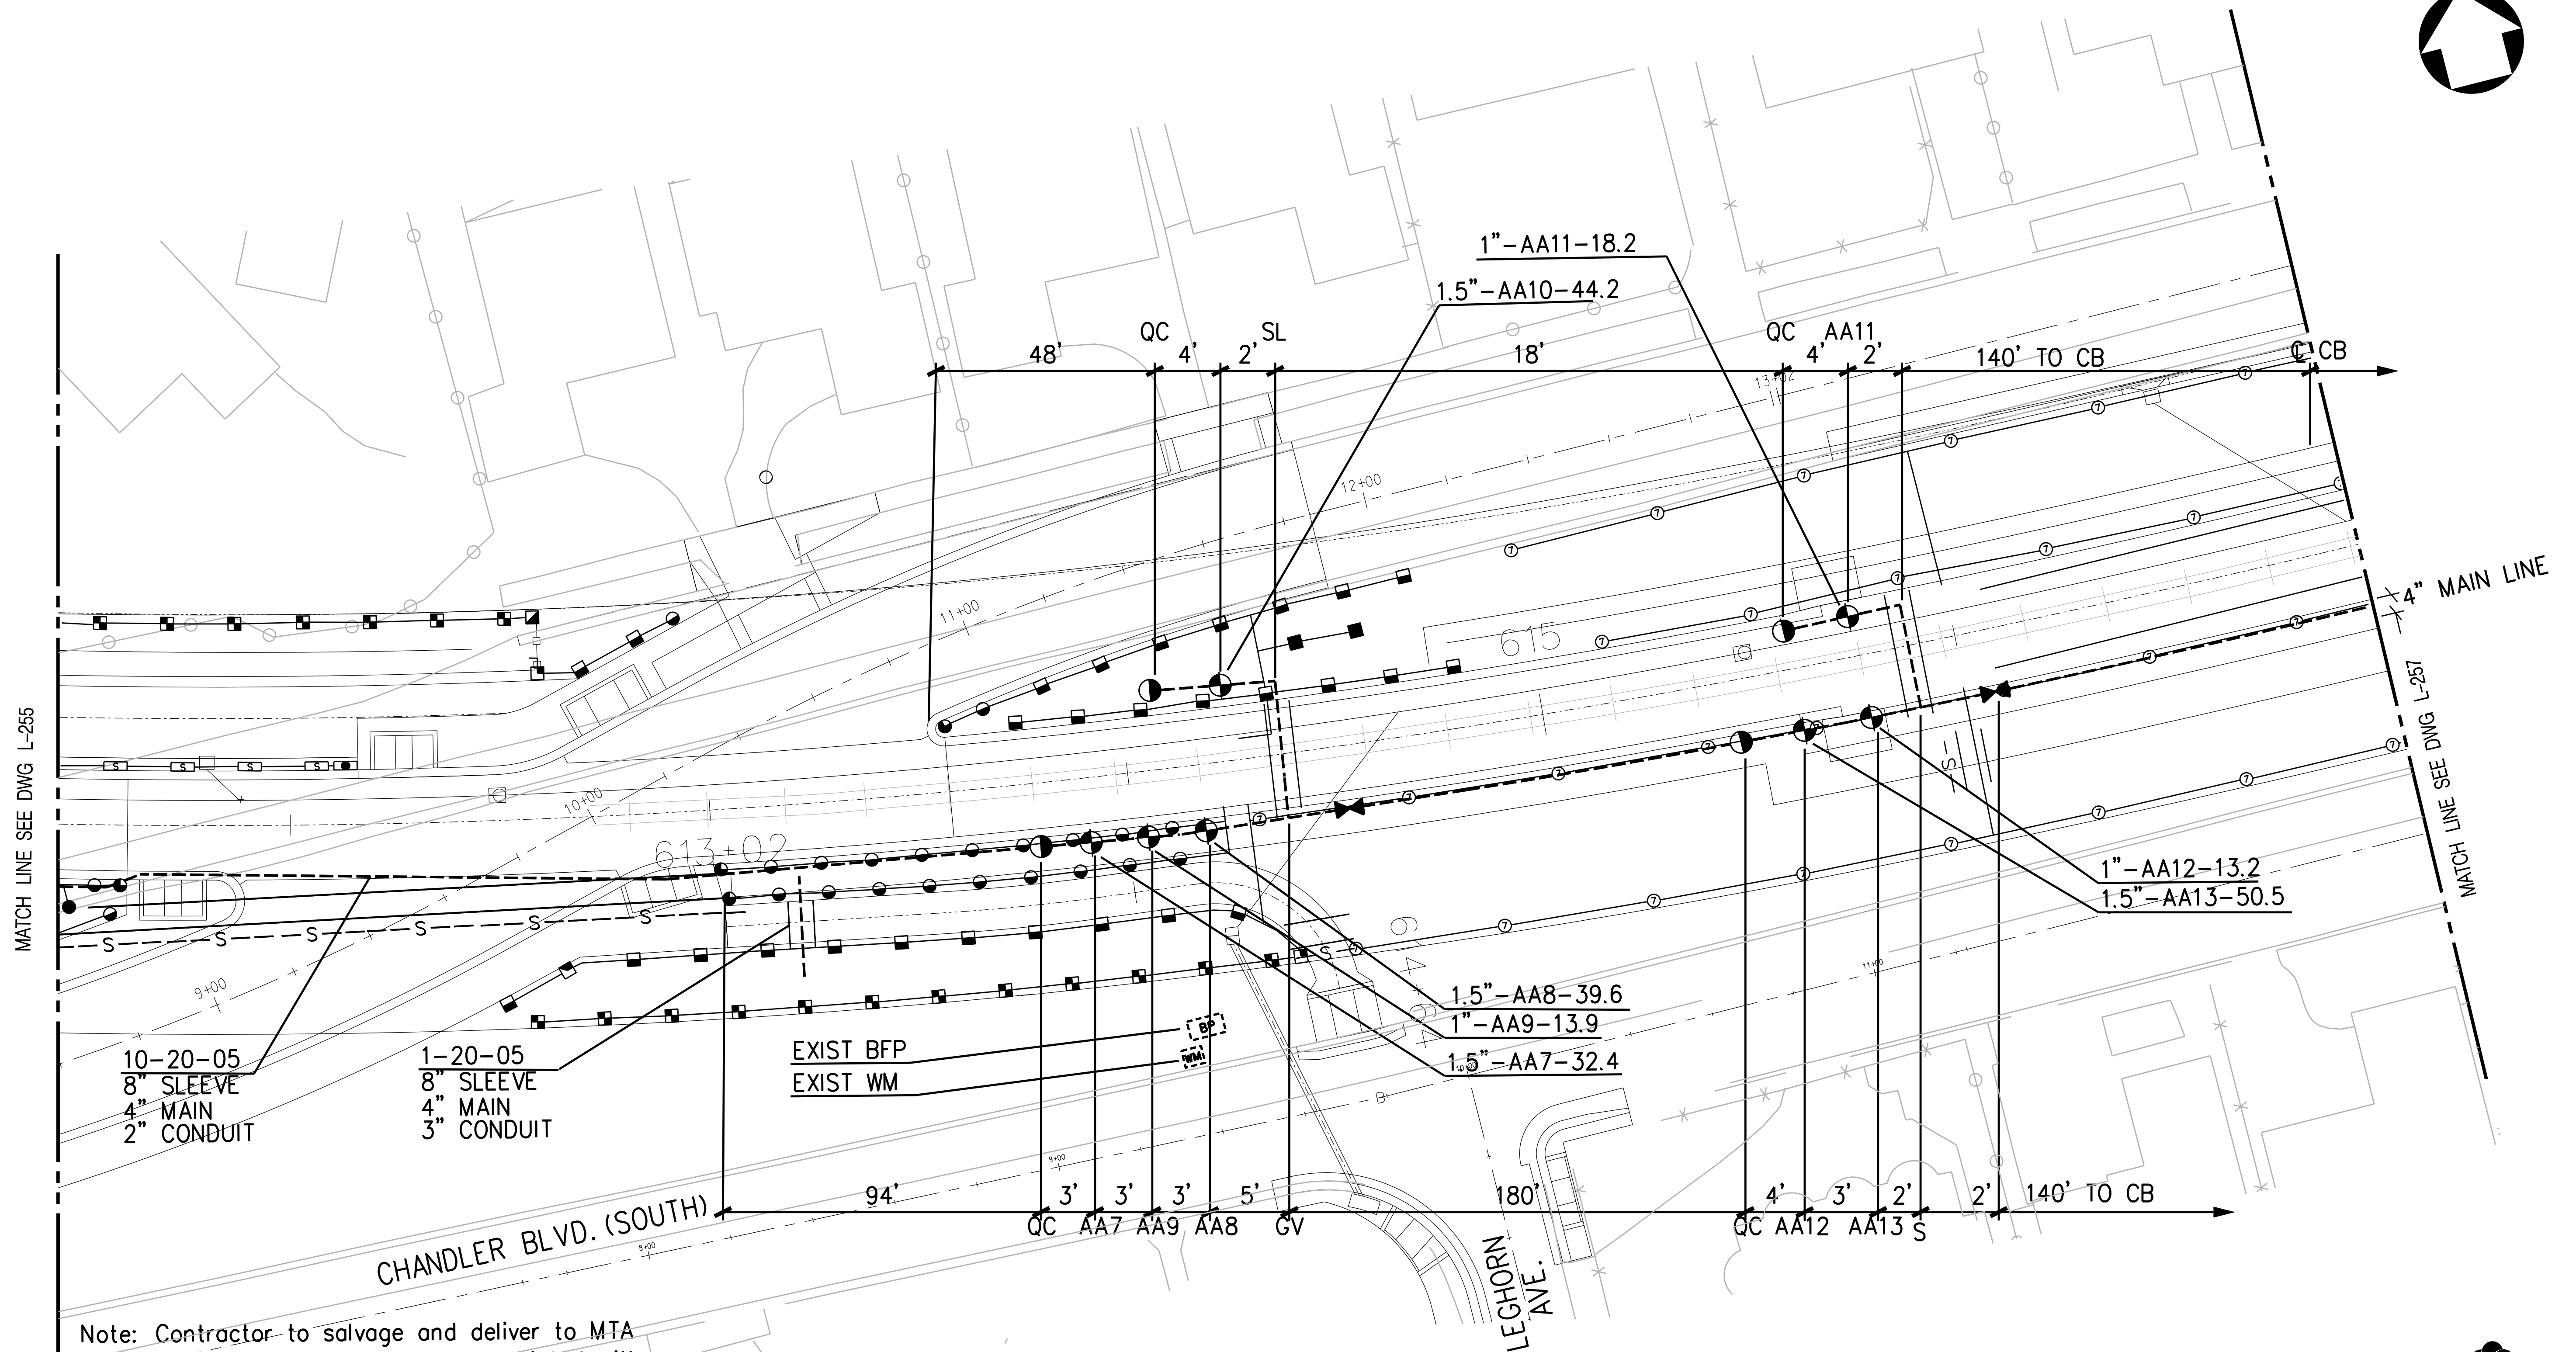


Note: Contractor to salvage and deliver to MTA backflow and P.O.C. components associated with existing tree irrigation system to the extent possible. Remove all other exposed components. Abandon under-ground pipe and fittings in place.

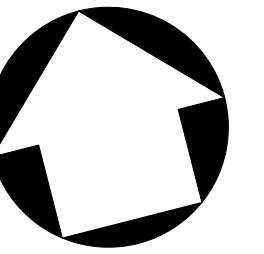

ISSUE FOR CONSTRUCTION

REV	DATE	BY	APP	REG NO	EXPIRES	SEAL HOLDER	DESCRIPTION
	3/12/08						AS-BUILTS
0	5/23/05						ISSUE FOR CONSTRUCTION

DESIGNED BY
MG
DRAWN BY
T&P
CHECKED BY
KLS
IN CHARGE
DT
DATE
5/23/2005

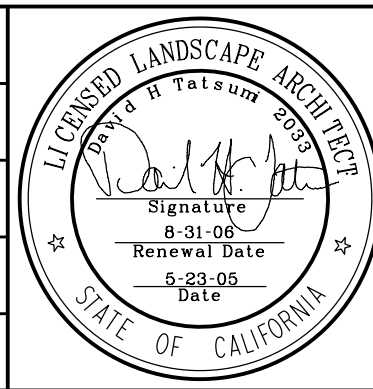

LOS ANGELES COUNTY METROPOLITAN TRANSPORTATION AUTHORITY
SAN FERNANDO VALLEY EAST-WEST BRT PROJECT

TATSUMI AND PARTNERS, INC.
LANDSCAPE ARCHITECTURE • PLANNING • DESIGN
5 CORPORATE PARK, SUITE 200
BAYVIEW, CA 94568-5866
949/250-9890 FAX 949/250-9891

SUBMITTED BY: DAVID H. TATSUMI
DATE:

NORTH HOLLYWOOD TO WARNER CENTER
IRRIGATION PLAN
STA 611+50 TO STA 617+00
SHEET 114 OF 136

CONTRACT NO
C0675
DRAWING NO
L-256
SCALE
1"=20'
SHEET NO

REV
0