


(E)

(E)

(E)

(E) = Existing
* For reference only; see Street Lighting sheet

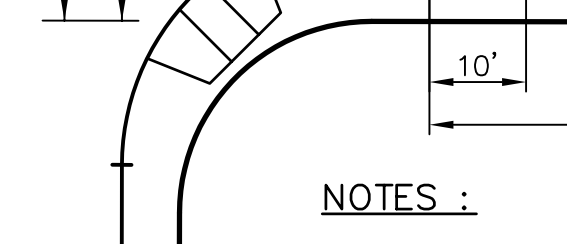

1. SEMI-ACTUATED OPERATION (ATSAC 2070 CONTROLLER IN 332 CABINET)

- Ø2 – CHANDLER BLVD WB & N/S PED XING
- Ø4 – ETHEL AVE SB & W/S PED XING
- Ø6 – CHANDLER BLVD EB & S/S PED XING
- Ø8 – ETHEL AVE NB & E/S PED XING

VICTORY CORRIDOR EAST ATSAC SYSTEM
DIRECT WIRE (CABLE) INTERCONNECT

2. REMOVE CONTROLLER, 337 CABINET, TYPE 8 STANDARD AND FOUNDATION; ABANDON CONDUITS.

3. INSTALL ATSAC 2070 CONTROLLER IN 332 CABINET. THE CONTRACTOR SHALL PROVIDE A COMPLETE FUNCTIONING CONTROLLER ASSEMBLY AND CABINET CONFORMING TO THE LATEST LADOT SPECIFICATION FOR 2070 CONTROLLER. CONTRACTOR TO DELIVER COMPLETELY ASSEMBLED CONTROLLER FOR TESTING TO THE DEPARTMENT OF TRANSPORTATION GENERAL SHOP, PIPER TECHNICAL CENTER, 555 RAMIREZ STREET THIRTY (30) DAYS PRIOR TO INSTALLATION. CONTRACTOR TO PICK UP AND INSTALL CONTROLLER ASSEMBLY ON F-332 FOUNDATION. INSTALL TRANSIT SENSOR UNITS IN NEW 332 CABINET.



NOTES (CONT):

- 4 REMOVE EXISTING STANDARD AND FOUNDATION; ABANDON CONDUITS.
- 5 REPLACE EXISTING SERVICE WIRES WITH 2 #6 WIRES. INSTALL A 60 AMP IN AN IN-LEAD TERPAC FUSEHOLDER IN THE PULLBOX PER LADOT STD. DWG. NO. S-79.8. WORK ON ANY ELECTRICAL EQUIPMENT TO BE DONE ONLY IN CONJUNCTION WITH THE DWP PERSONNEL. CONTACT DWP AT (213) 367-3003 SEVEN (7) WORKING DAYS PRIOR TO BEGINNING OF WORK.
- 6 CONTRACTOR SHALL PROVIDE AND INSTALL LARGE STREET NAME SIGNS PER LADOT STD. DWGS. NO. S-457.0 & S-486.0.

(E) = Existing

1. EXCEPT WHERE OTHERWISE INDICATED, MATERIALS AND INSTALLATION METHODS SHALL CONFORM TO THE LATEST EDITION, WITH SUPPLEMENTS, OF THE STANDARD SPECIFICATION FOR PUBLIC WORKS CONSTRUCTION, ADOPTED BY THE CITY OF LOS ANGELES BOARD OF PUBLIC WORKS (LBPW), INCLUDING THE LATEST VERSION OF STANDARD PLAN S-610 ISSUED BY THE LBPW, AND THE LATEST EDITION, WITH AMENDMENTS, OF THE SPECIAL PROVISIONS AND STANDARD DRAWINGS FOR THE INSTALLATION AND MODIFICATION OF TRAFFIC SIGNALS, ISSUED BY THE CITY OF LOS ANGELES DEPARTMENT OF TRANSPORTATION (LADOT).

2. THE LADOT TRAFFIC SIGNAL INSPECTOR SHALL BE NOTIFIED AT (213) 792-7637. THE SENIOR MAINTENANCE SUPERVISOR AT (818) 756-7845, AND THE LADOT METRO RAIL ENGINEER AT (213) 485-2610 THREE (3) WORKING DAYS PRIOR TO THE BEGINNING OF CONSTRUCTION.

3. NORMAL TRAFFIC CONTROL SHALL BE MAINTAINED FROM 6:00 A.M. TO 9:00 A.M. AND 3:00 P.M. TO 7:00 P.M. ON WEEKDAYS. HOURS AND DURATION WHEN TRAFFIC SIGNALS ARE DEACTIVATED AND/OR PLACED INTO FLASHING OPERATION REQUIRE THE PRIOR APPROVAL OF THE LADOT METRO RAIL ENGINEER. TRAFFIC SIGNAL DEACTIVATION AND FLASHING OPERATION SHALL BE IMPLEMENTED BY THE LADOT METRO RAIL ENGINEER IN COORDINATION WITH THE ATSCA SIGNAL CONTROL CENTER, AND SHALL BE REQUESTED THREE (3) WORKING DAYS IN ADVANCE THROUGH THE LADOT METRO RAIL ENGINEER, (213) 485-2610. FULL RESTORATION OF THE ATSCA SYSTEM MUST OCCUR WITHIN FIVE (5) WORKING DAYS AFTER DEACTIVATION.


4. THE CONTRACTOR SHALL COORDINATE WITH THE LADOT SIGNAL SHOP AT (213) 847-2944 TO ARRANGE CONTROLLER DELIVERY. THE CONTRACTOR SHALL PROVIDE AND DELIVER A COMPLETE FUNCTIONING CONTROLLER ASSEMBLY AND CABINET TO THE LADOT SIGNAL SHOP THIRTY (30) CALENDAR DAYS PRIOR TO THE INSTALLATION DATE, AND PICK UP THE CONTROLLER WITHIN FIFTEEN (15) CALENDAR DAYS AFTER NOTIFICATION BY LADOT SIGNAL SHOP.

5. ALL REMOVED TRAFFIC SIGNAL EQUIPMENT IDENTIFIED AS SALVAGED MATERIAL SHALL BE RETURNED TO LADOT. ARRANGEMENTS FOR RETURNING IDENTIFIED EQUIPMENT TO LADOT SHALL BE MADE FIVE (5) WORKING DAYS IN ADVANCE BY CONTACTING THE LADOT MATERIAL CONTROL DIVISION AT (213) 580-5477. THE CONTRACTOR SHALL OBTAIN A SALVAGE RECEIPT FROM LADOT AND FORWARD A COPY, SIGNED BY THE CONTRACTOR AND THE RECEIVING LADOT YARD TO LADOT METRO RAIL ENGINEER AT 205 S. BROADWAY, SUITE 300, L.A. CA 90012. ALL OTHER REMOVED SIGNAL EQUIPMENT SHALL BE RETAINED BY THE CONTRACTOR.

6. ALL EXISTING TRAFFIC CONTROL SIGNING SHALL BE MAINTAINED WITH STANDARD SIGN BRACKETS BY THE CONTRACTOR. EXCEPT WHERE OTHERWISE INDICATED, EXISTING LARGE STREET NAME SIGNS ON MAST ARM TYPE STANDARDS SHALL BE RELOCATED FROM THE VERTICAL POLE TO THE MAST ARM PER LDOT STANDARD DRAWING NO. S-457.0. WHEN CALLED OUT ON THIS PLAN, CONTRACTOR SHALL FURNISH AND INSTALL LARGE STREET NAME SIGNS AND SIGN BRACKETS FOR ALL SITUATIONS ON MAST ARM PER LDOT STD. DWG. NO. S-457.0. ANY TRAFFIC SIGNING DAMAGED OR LOST BY THE CONTRACTOR SHALL BE REPLACED AT THE CONTRACTOR'S EXPENSE.

7. THE CONTRACTOR SHALL FURNISH AND INSTALL, AS SHOWN ON THE PLANS, ALL TRAFFIC SIGNAL EQUIPMENT SUCH AS STANDARDS, MAST ARMS, SIGNAL HEADS, AND OTHER EQUIPMENT AS REQUIRED. ALL SUCH EQUIPMENT SHALL BE NEW. ALL SUCH EQUIPMENT SHALL BE IN ACCORDANCE WITH THE LATEST EDITION OF THE SIGNAL MANUAL. ALL VEHICLE HEAD EQUIPMENT SUPPLIED BY THE CONTRACTOR SHALL HAVE A 7/2 INCH MOUNTING FLANGE TO BE USED FOR MOUNTING. NO OTHER FORM OF MOUNTING, PED HEAD MOUNTED REPLACEMENTS SHOWN ON THE PLAN SHALL REQUIRE A COMPLETE INSTALLATION, INCLUDING NEW PED HEAD AND TERMINAL COMPARTMENT. LEFT TURN SIGNAL HEADS ON MAST ARMS WITH TWO OR MORE SIGNAL HEADS SHALL BE TOP MOUNTED


7. REUSE EXISTING 12 PAIR INTERCONNECT TO FULTON AVE.
8. JOIN CONDUIT AND EXTEND TO PULL BOX.
9. THIS LOOP CONNECTED TO CONTROLLER AT ETHEL AVE./BUSWAY.
10. REMOVE PPB. PLUG HOLES AS DIRECTED BY FIELD ENGINEER.
11. UN-COVER SIGNAL HEADS.
12. INSTALL STRIPING, SIGNS AND PAVEMENT MARKINGS PER DWG. NO. A-4050 FOR THIS PROJECT. REMOVE ALL CONFLICTING STRIPING AND PAVEMENT MARKINGS.
13. SEE STREET LIGHTING SHEET FOR WORK ON STREET LIGHTING FACILITIES.
14. INSTALL VEHICLE LOOPS PER STD. DWG No. S-70.1A.
15. ALL NEW VEHICLE AND PEDESTRIAN TRAFFIC SIGNALS SHALL BE LED MODULES, PER LADOT SPECIFICATION 92-088-03 (LATEST EDITION).

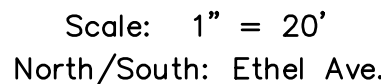

WASHINGTON



1055 Corporate Center Drive, Suite 300
Monterey Park, California 91754-7642
Tel: (323) 260-4703 Fax: (323) 260-4705

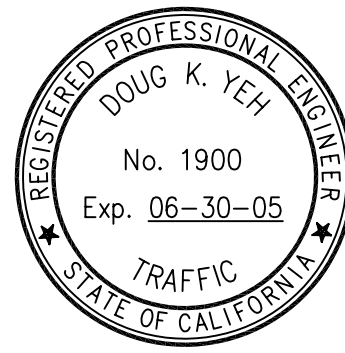

DESIGNED BY
G. FIGUEROA

DRAWN BY
G. FIGUEROA

CHECKED BY
D. YEH

IN CHARGE
W. OKITSU

DATE
06-11-04



 LOS ANGELES COUNTY METROPOLITAN TRANSPORTATION AUTHORITY SAN FERNANDO VALLEY EAST-WEST BRT PROJECT	 WASHINGTON	 Katz, Okitsu & Associates Traffic Engineers & Transportation Planners	1055 Corporate Center Drive, Suite 300 Monterey Park, California 91754-7642 Tel: (323) 280-4703 Fax: (323) 280-4705
--	---	---	--

MDTA – SAN FERNANDO VALLEY RAPID BUS SYSTEM (SIGNAL RESTORATION)			
REVIEWED _____ 20 _____ _____ Transportation Engineer	RECOMMENDED <u>June 22,</u> 20 <u>04</u> <u>Judy Wong</u> Senior Transportation Engineer	ACCEPTED <u>June 22,</u> 20 <u>04</u> <u>Thomas L. Jones</u> Principal Transportation Engineer	
AS BUILT		CITY OF LOS ANGELES DEPARTMENT OF TRANSPORTATION WAYNE K. TANDA, GENERAL MANAGER	
Date of Installation: <u>11-18-05</u> LADOT Inspector: <u>Alegria</u> Condition As Of: <u>11-18-05</u> LADOT Engineer: <u>J.P.</u> District: EAST VALLEY Thomas Guide 562-D2		TITLE CHANDLER BLVD. AND ETHEL AVE.	
References		File Name <u>32740-Q1.DWG</u>	Intersection No. <u>32740</u>
NOTICE: IF PLAN HAS NOT BEEN IMPLEMENTED WITHIN TWO (2) YEARS OF THE ACCEPTANCE DATE, IT MUST BE RESUBMITTED TO LADOT SIGNAL DESIGN SECTION FOR REVIEW AND APPROVAL.		Project No. <u>74720</u>	
NORTH HOLLYWOOD TO WARNER CENTER GROUP 5 INTERSECTIONS RESTORATION TRAFFIC SIGNAL CHANDLER BLVD. AND ETHEL AVE.		SEGMENT NO <u>C-0675</u>	
		DRAWING NO <u>G5TS-005</u>	REV <u>1</u>
		SCALE <u>1" = 20'</u>	
		SHEET NO	