



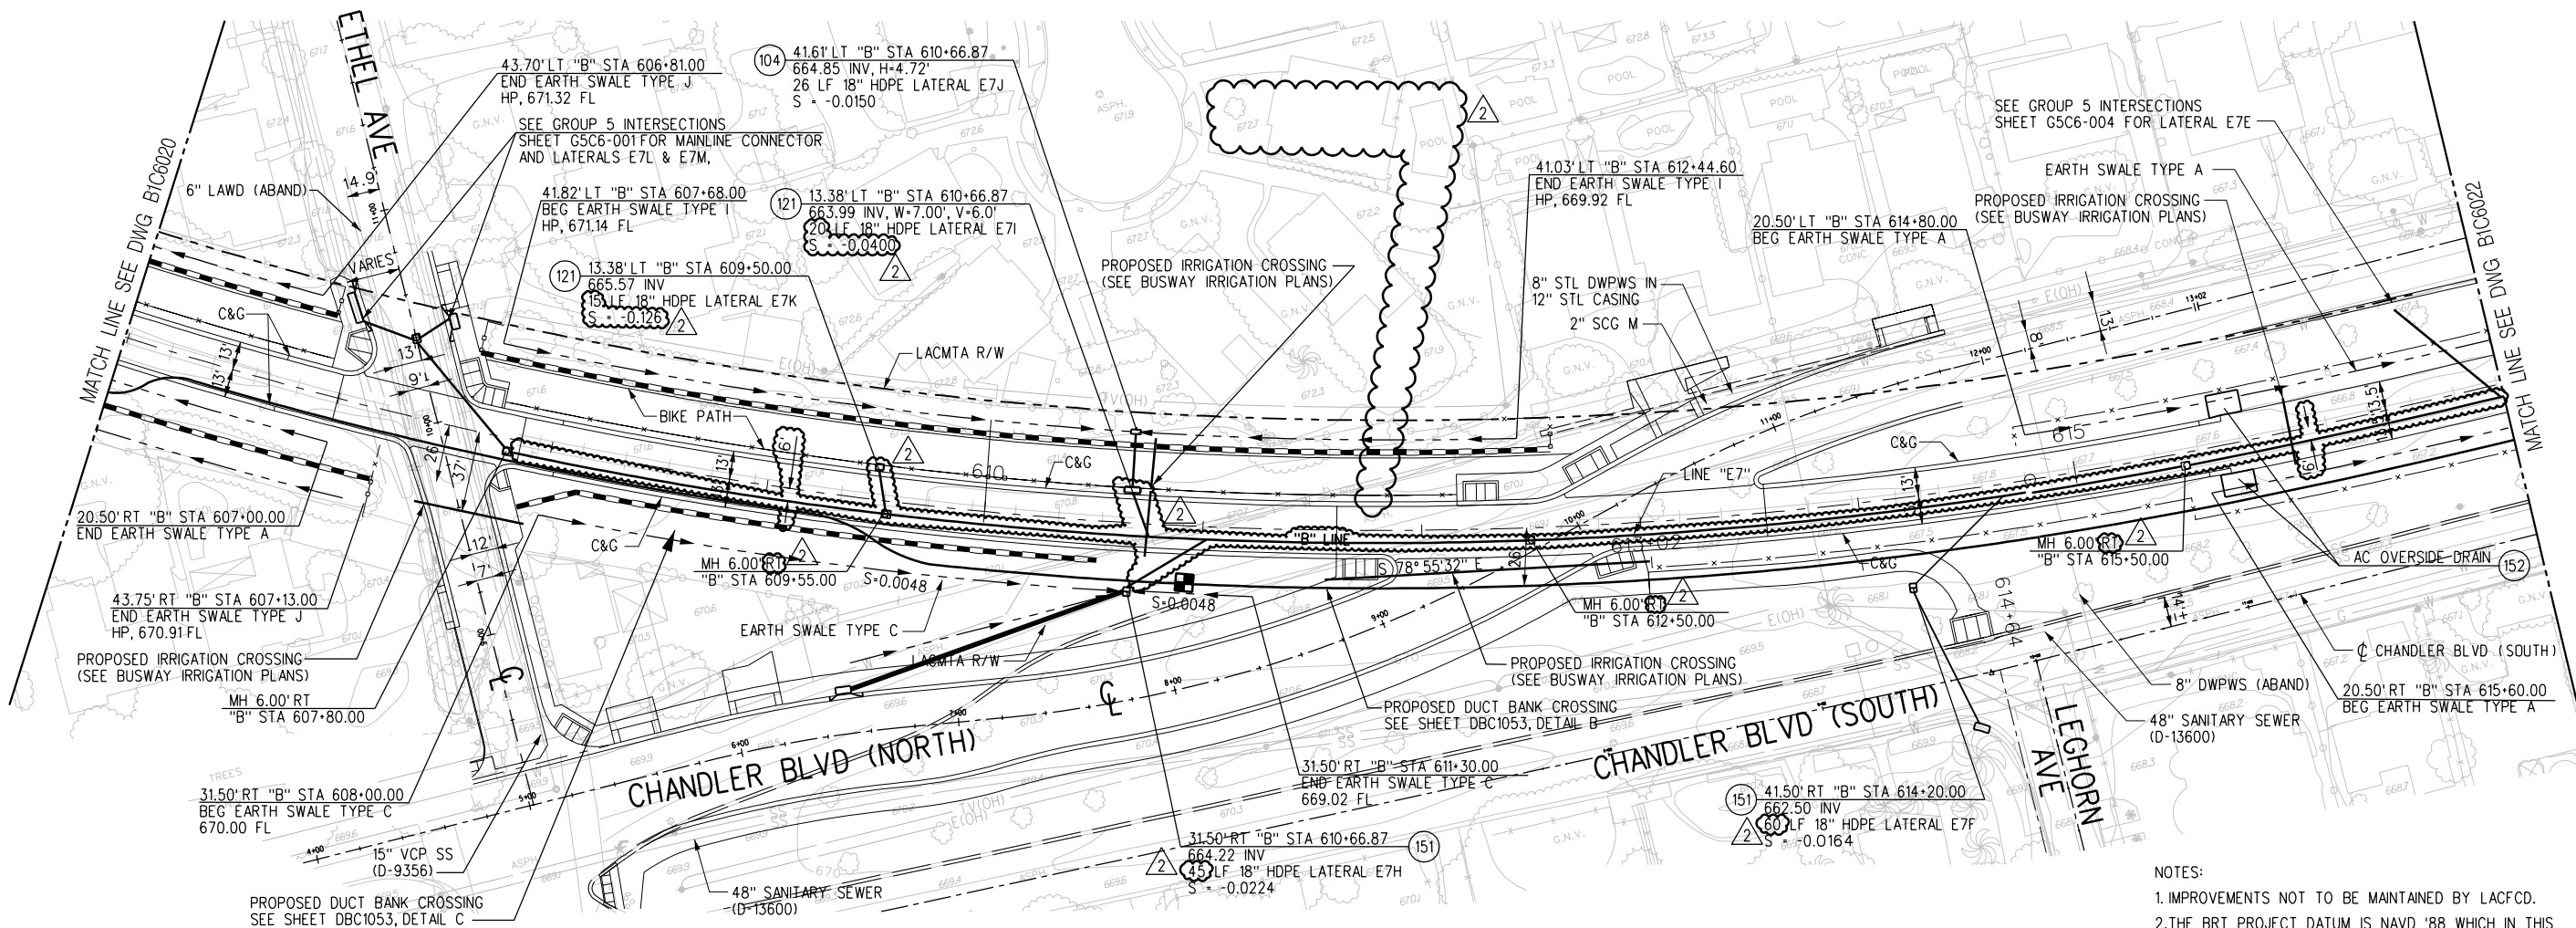


- NOTES:
1. IMPROVEMENTS NOT TO BE MAINTAINED BY LACFC.
 2. THE BRT PROJECT DATUM IS NAVD '88 WHICH IN THIS VICINITY IS APPROXIMATELY 2.22' HIGHER THAN LACFC PROJECT NO. 9203.
 3. MINIMUM PIPE STIFFNESS FOR THE 24" HDPE PIPE IS 34 PSIAS SET BY AASHTO M-294. SEE DRAWING NO. BIC6035 FOR BEDDING AND LOADING DETAILS.
 4. FOR SWALE AND DITCH SECTIONS SEE DRAINAGE DETAIL SHEETS.


PLAN

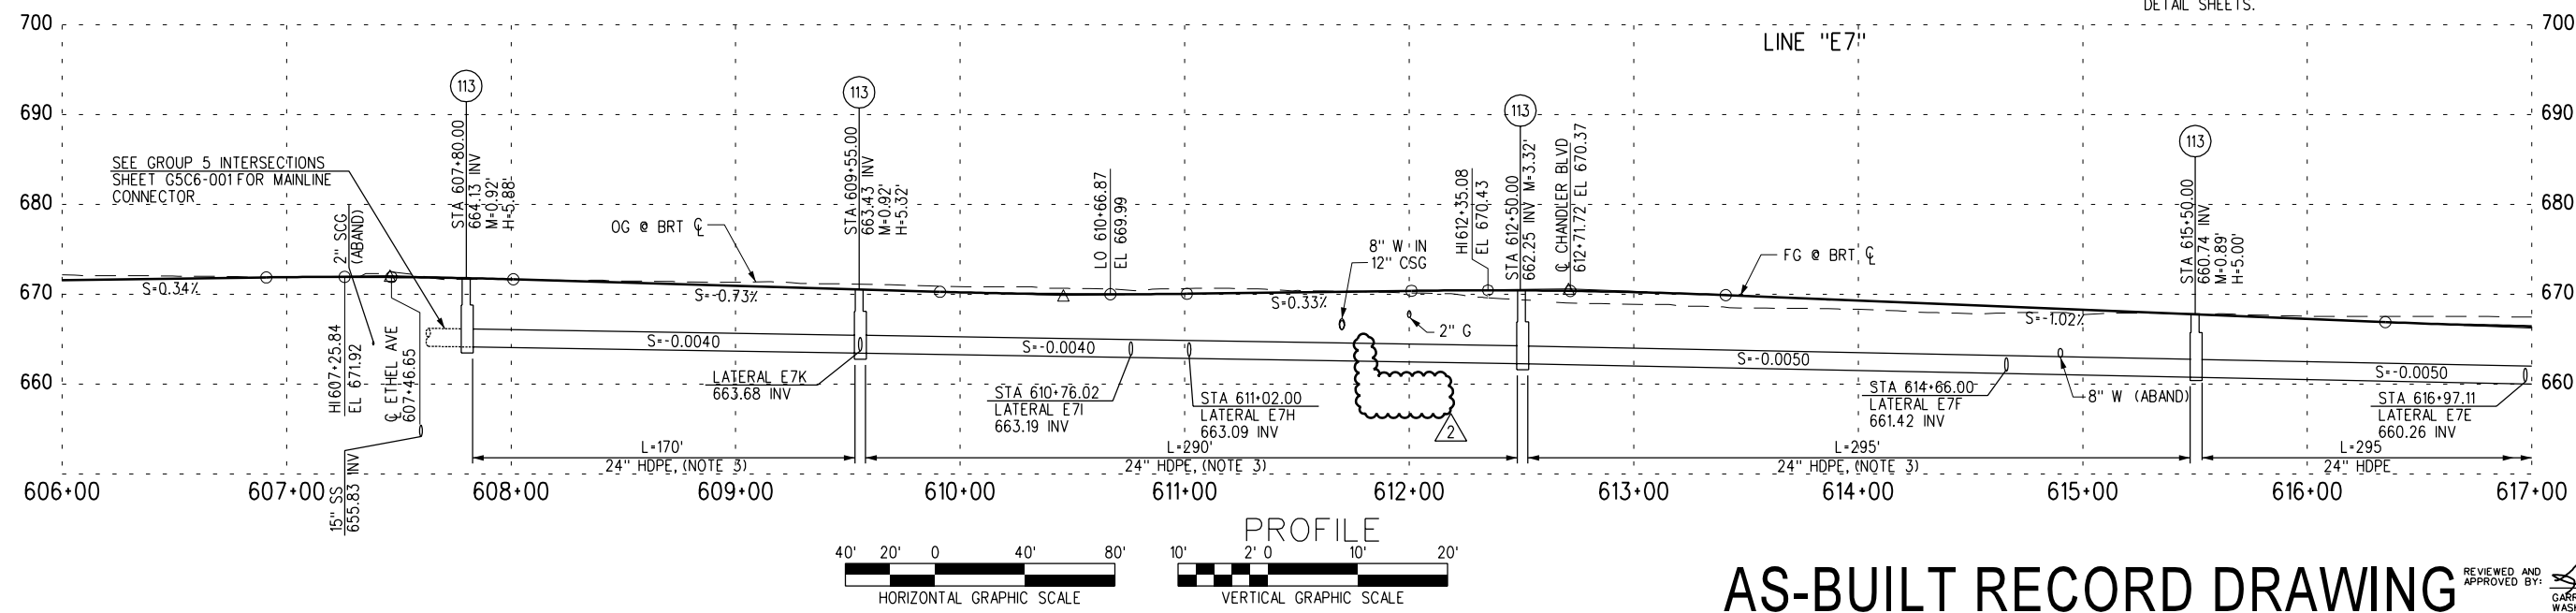

PROFILE

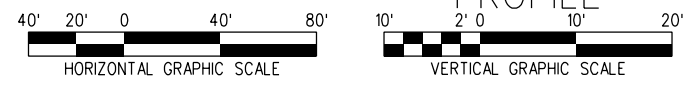


AS-BUILT RECORD DRAWING

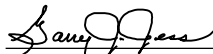REVIEWED AND APPROVED BY: 
GARRY J. JESS - PROJECT MANAGER
WASHINGTON GROUP INTERNATIONAL

REV	DATE	BY	APP	REG NO	EXPIRES	SEAL HOLDER	DESCRIPTION
2	10/18/05	AU	TG				AS-BUILT RECORD DRAWING
1	4/05/05	JLL	AKJ	C42345	03/31/06	ARVIND K. JOSHI	INCORPORATED RFI #411 - IFC
0	12/31/03	HAB	AKJ	C42345	03/31/06	ARVIND K. JOSHI	ISSUED FOR CONSTRUCTION

DESIGNED BY
H. BULLOCK
DRAWN BY
A. GOMEZ
CHECKED BY
D. ORTIZ
IN CHARGE
B. JONES
DATE
2/12/04

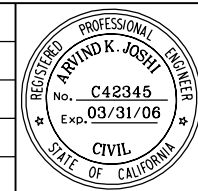



LOS ANGELES COUNTY METROPOLITAN TRANSPORTATION AUTHORITY
SAN FERNANDO VALLEY EAST-WEST BRT PROJECT



Washington Group International
WASHINGTON GROUP INTERNATIONAL, INC.
5805 SEPULVEDA BLVD., SUITE 500
VAN NUYS, CA 91411



SHIMMICK
OBYASHI, JV
5805 SEPULVEDA BLVD., SUITE 500
VAN NUYS, CA 91411

CONTRACT NO C0675	
DRAWING NO BIC6021	REV 2
SCALE HORIZ 1"=40' VERT 1"=10'	
SHEET NO	

m:\bri\irvine\as-builts (merged)\bic6021_AS-BUILT.plg 03/16/15 PM 01/12/2006