


1 PL. 376' 1-4" C-PC
PTS 77 OR EQUIV.
PM 1 DU 376'
R/C 4C
TL = POLE # 354198M TO MH "A" = VERIFY 376'

- 2 PL. 23' 2-2" C-PC
PTS 66 OR EQUIV.
PM 2 DU 23'
R/C 4C

- 3) PL 15' 1-2" C-PC
PTS 66 OR EQUIV.
PM 1 DU 15'
R/C 4C
TL = MH "A" TO WALL MOUNTED PULL BOX 5538 FULTON AVE = VERIFY 38'
D & E CAP AT P/L FOR SUB'S TO P/U

- 4 PL. 6' 1-2" C-PC
PTS 66 OR EQUIV.
PM 1 DU 6'
R/C 4C
TL = MH "A" TO P/L = VERIFY 29'
D & E CAP AT P/L FOR SUB'S TO P/U

- 5 PL. MH "A" _____
3' X 5' X 4' (T-16)
E/W BOLT DOWN / NON-SKID LID
R/C 4C

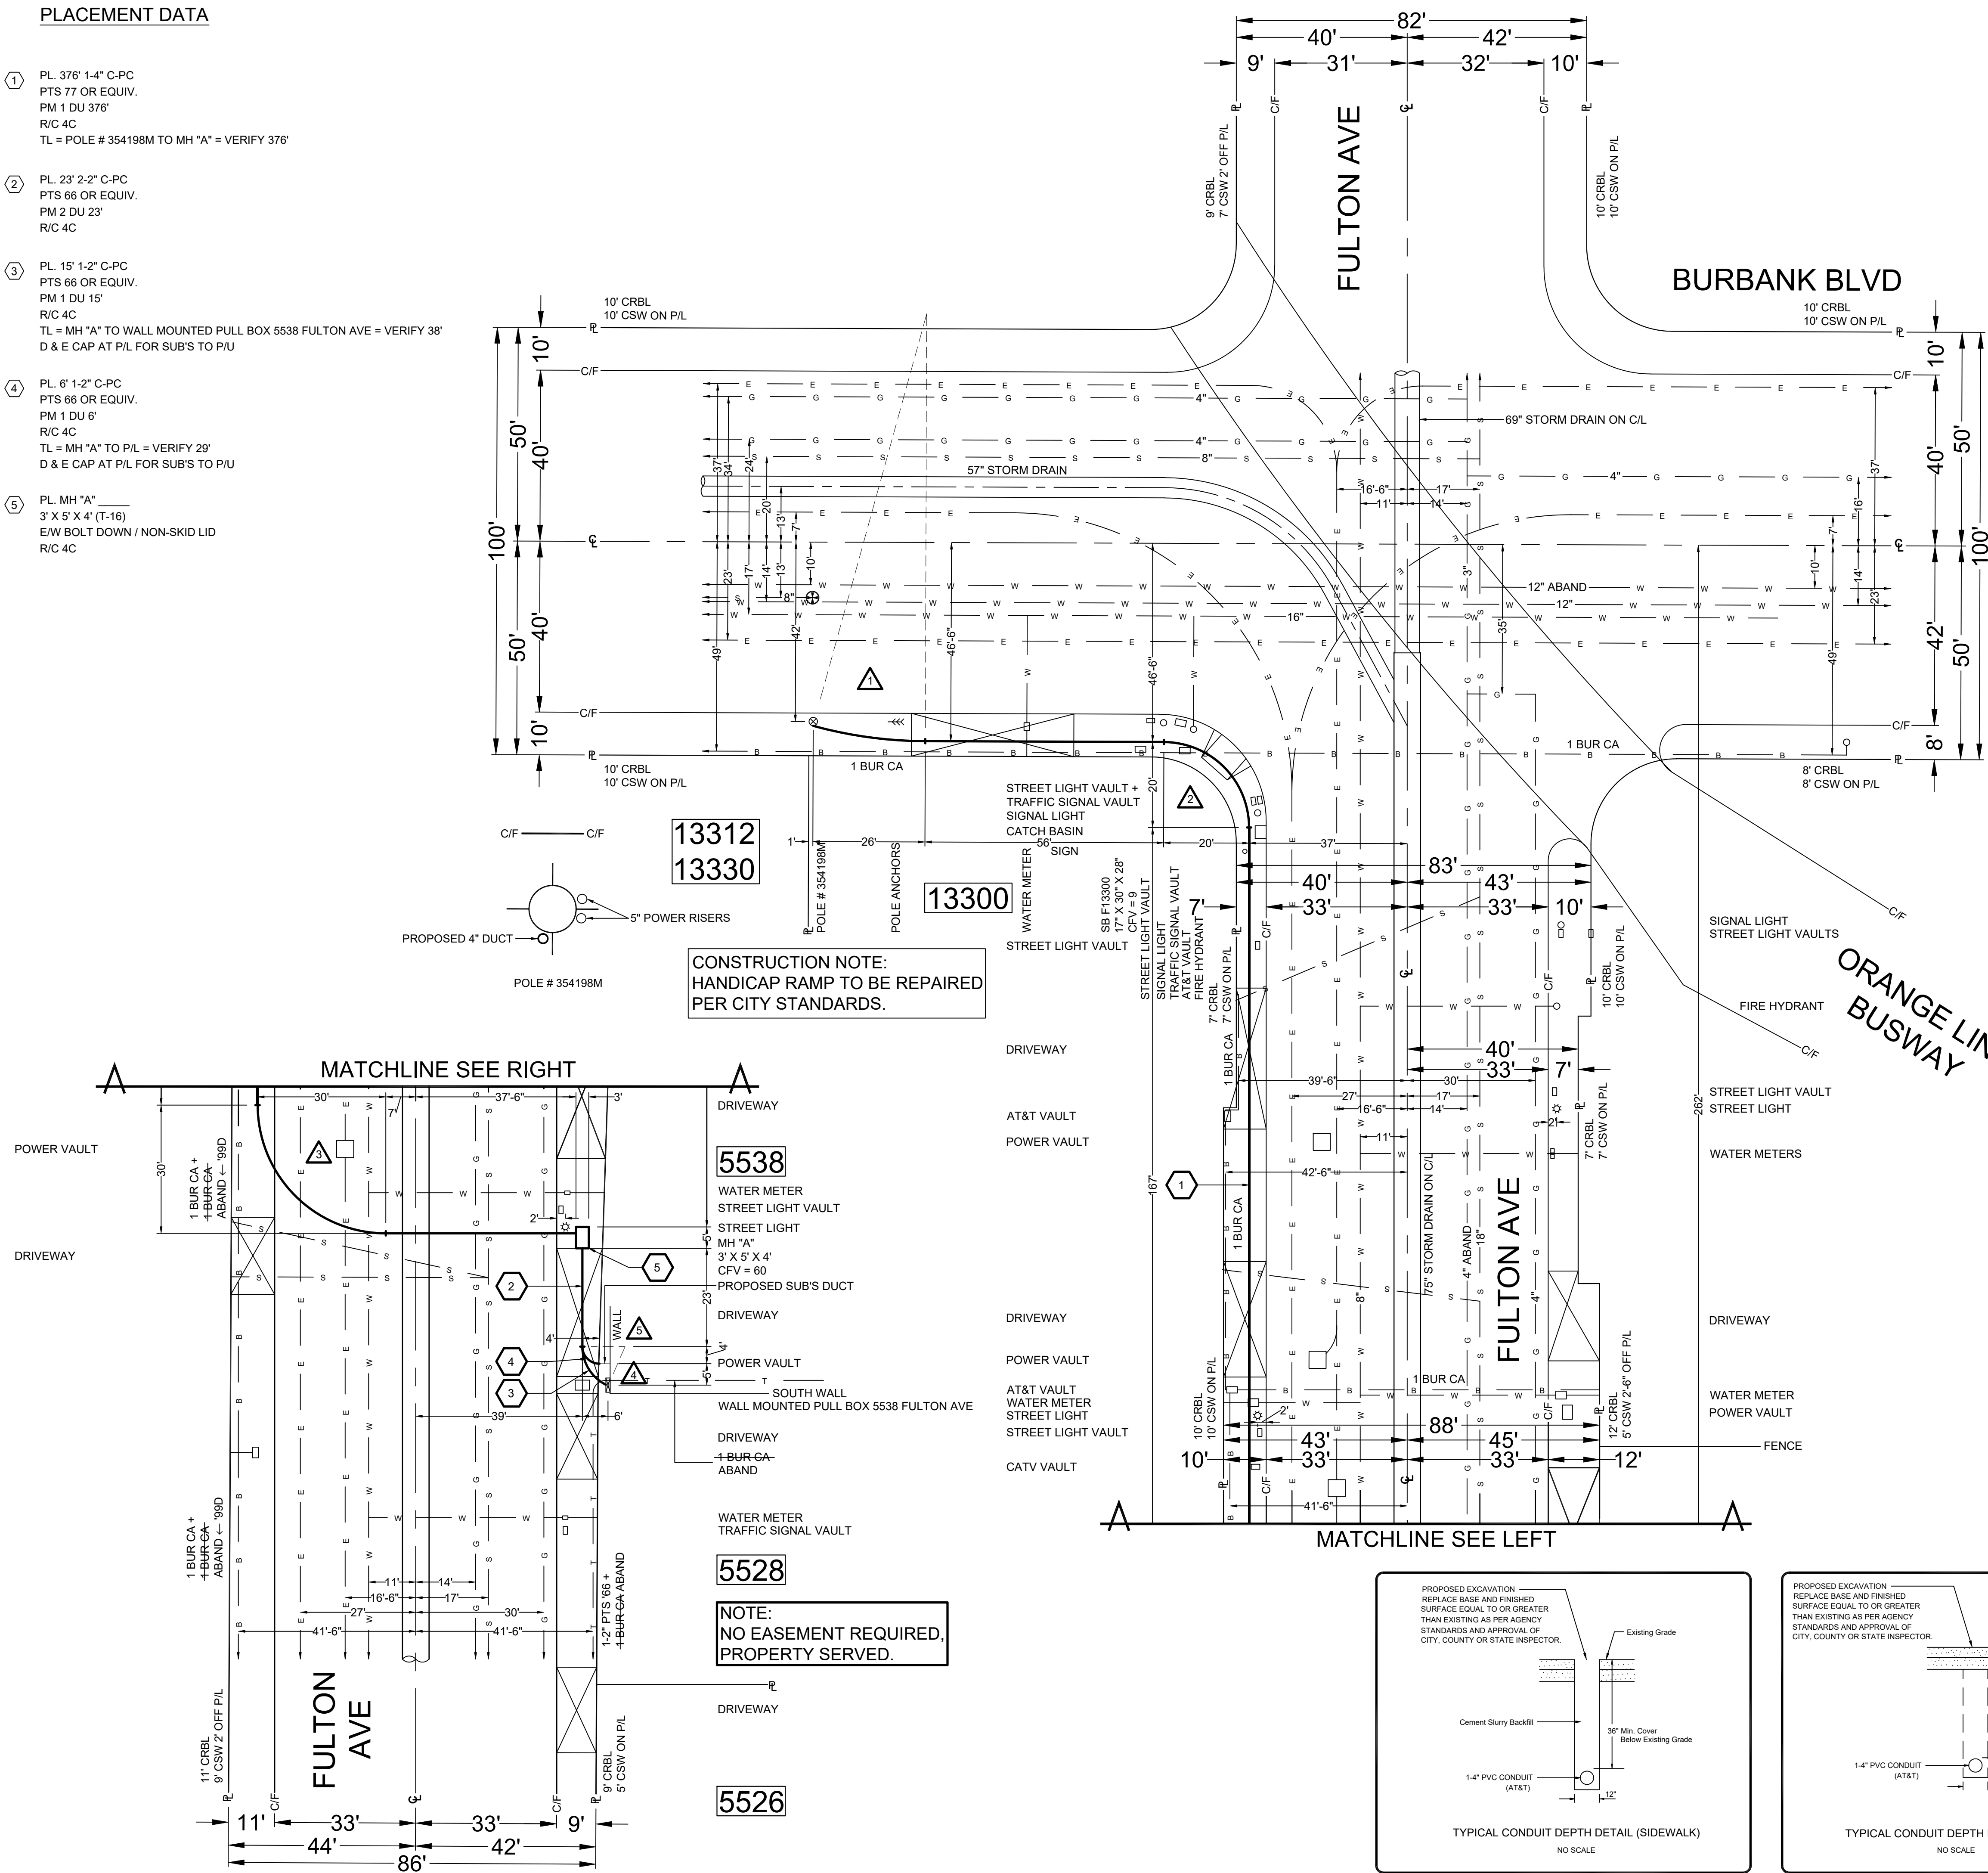

The contractor shall protect and maintain all street lighting facilities existing in the work area. Should any damage to the street lighting system occur, the contractor shall immediately notify the Bureau of Street Lighting, Field Operations Division, by telephoning (323) 913-4743. After 4:30 PM Monday through Thursday, or 3:30 PM on Friday, contact the Electric Trouble Board of the Department of Water and Power by telephoning (800) 821-5278 from the (213) area code, or (800) 821-5279 from the (818) area code.

The contract shall install all proposed facilities 12 inches clear of the street lighting foundations, pullboxes, and conduits, except where otherwise stated herein. Two business days prior to working near the street lighting circuit the contractor shall arrange for the presence of a City of Los Angeles Public Works inspector, (213) 580-5080 or (818) 374-1188, to verify all clearance requirements are met. Where a conflict exists between the street lighting facilities and the proposed improvements, approval for relocation of the street lighting facilities may be obtained by contacting the Street Lighting Engineer at (213) 847-1817.

The contractor shall proceed with extreme caution when working near the high voltage series circuit. Unauthorized work on the series circuit can result in severe injury or death. The contractor shall notify the Bureau of Street Lighting, Field Operations Division (323) 913-4743 two business days prior to working near the street lighting circuit.

This plan has been reviewed by the Bureau of Street Lighting and approved for the encroachment of new utilities within the Bureau of Street Lighting easement as specified hereon and within this plan: # of vault locations: _____ # of conduit locations: _____ linear footage of conduit: _____ ft	
Approved by: _____	
Director, Bureau of Street Lighting	Date

SEE C.P. DRAWING FOR LOCATION & TIES
OF STREET LIGHTS IN THE NEW CONSTRUCTION AREA

at&t

48 HOURS BEFORE YOU DIG
CALL

**UNDERGROUND
SERVICE ALERT**
of Southern California

1-800-422-4133

CONSTRUCTION REQUIREMENTS

1. MAINTAIN MINIMUM COVER OF 36" BELOW FLOW LINE.
2. VERIFY EXISTING SUBSTRUCTURES PRIOR TO EXCAVATION.
3. ALL 4" TO CONFORM TO PTS.-77 OR EQUIVALENT.
4. ALL 2" TO CONFORM TO PTS.-66 OR EQUIVALENT.
5. ALL BACKFILL TO BE SAND 12" BELOW AND 6" ABOVE.
6. DO NOT BACKFILL OVER ANY TELEPHONE BORED SPlice LOCATIONS UNTIL AUTHORIZED BY TELEPHONE COMPANY INSPECTOR.
7. PLACE # 6 TINNED GROUND WIRE AT BONDING POINTS. (SEE BONDING DETAIL)
8. PLACE PULL ROPE IN NEW CONDUIT.
9. DO NOT CUT CURB & GUTTER.
10. ALL SURFACES AND LANDSCAPES WHICH HAVE BEEN REMOVED OR DAMAGED IN THE COURSE OF CONSTRUCTION SHALL BE RECONSTRUCTED OR REPLACED TO AT LEAST EQUAL OR BETTER THAN THE PREVIOUS OR ADJACENT SURFACE.
11. ALL TRAFFIC CONTROL TO BE IN ACCORDANCE WITH THE CALIFORNIA MANUAL ON UNIFORM TRAFFIC CONTROL DEVICES (MUTCD) LATEST EDITION.
12. PER AT&T GUIDELINES, ALL HANDHOLES, SPlice BOXES, AND MANHOLES TO BE PURCHASED FROM EITHER NEWBASE OR UTILITY VAULT.

F.J.S. CABLE ENGINEERING, INC. # 12769

THIS PROJECT REQUIRES EXCAVATION, CONSTRUCTION WILL UTILIZE AND IMPLEMENT ALL BEST MANAGEMENT PRACTICES (BMP'S) AS REQUIRED TO ENSURE COMPLIANCE WITH AT&T POLICY LETTER ISSUE FEBRUARY 21, 2003 BY ENVIRONMENTAL MANAGEMENT CONCERNING STORM WATER PERMITTING AND STORM WATER POLLUTION PREVENTION PLANS (SWPPP'S) AND IN ACCORDANCE WITH THE CLEAN WATER ACT (1965) AND EPA REGULATIONS PUBLISHED IN 1990 AS MODIFIED BY THE PHASE II RULE IN 1990.

LOCATION: BURBANK BLVD S/S OF STREET 139' W/O C/L OF FULTON
AVE AND FULTON AVE W/S AND E/S OF STREET 299' S/O C/L OF
BURBANK BLVD

DESCRIPTION: PLACE 376' OF 1-4" DUCT FROM POLE # 354198M TO MH "A", PLACE 44' OF 2" DUCTS AND PLACE T-16

BACKFILL SHALL BE SOIL CEMENT SLURRY OR OTHER MATERIAL IN CONFORMANCE WITH CITY ENGINEER'S SPECIAL ORDER No. S0-06-0182 DATED JANUARY 28, 1982. (CITY OF L.A.)

RECOMMENDATION FOR BACKFILL SPECIAL ORDER # 06-0182

STREET TYPE	SOIL CLASS	PROPOSED BACKFILL
MAJOR	N/A	N/A
SECONDARY	N/A	N/A
LOCAL	N/A	N/A
ALLEY	N/A	N/A

CONDUIT RECORD: B402C177
FULTON AVE
BURBANK BLVD TO CHANDLER
BLVD
B402C64
BURBANK BLVD
VARNNA AVE TO 502' E/O C/L OF
FULTON AVE
SUB MAP #: 135C

STREET NAME N/A

MATERIAL	N/A	
----------	-----	--

LINEAR FEET	N/A
-------------	-----

EXCAVATION DATA

CITY OF:	LOS ANGELES (VALLEY)	
PLACING:	UG CONDUITS AND T-16	
EXCAVATION IN ASPHALT STREET	71' X 1' = 71 SQ F	
EXCAVATION IN ASPHALT SIDEWALK	90' X 1' = 90 SQ F	
EXCAVATION IN CONCRETE SIDEWALK	245' X 1' = 245 SQ F	
EXCAVATION IN BRICK SIDEWALK	5' X 1' = 5 SQ F	
EXCAVATION IN CONCRETE SIDEWALK	T-16 (7.5' X 4.5') = 34 SQ F	
TOTAL EXCAVATION:		445 SQ F
CITY OF:	PRIVATE PROPERTY	
PLACING:	UG CONDUIT	
EXCAVATION IN DIRT	3' X 1' = 3 SQ F	
TOTAL EXCAVATION:		3 SQ F
NUMBER OF CUTS:		

	DATE	ATTID	LAYOUT ENGINEER RAFAEL MOREIRA
DRAWN	7/15/09		TELEPHONE NUMBER 626-570-5466
CHECKED			EMAIL ADDRESS
APPROVED	7/20/09	MOREIRA	FACILITY ENGINEER NOEL LEW ZAPP
DATE	REVISIONS		TELEPHONE NUMBER 818-373-5921
			GEOID B4-02
			CENTRAL OFFICE VAN NUYS
			UNDERGROUND CONSTRUCTION PROJECT NUMBER
SCALE	1" = 20'	THOMAS GUIDE 562-D1	7419772
FILENAME:	B402-7419772.dwg		DRAWING: 1/1

CONDUIT CURVE DATA			
	ANGLE	RADIUS	LENGTH
	15° 12' 00"	100'	26'-6"
	90° 00' 00"	20'	31'-4"
	90° 00' 00"	30'	47'-1"
	66° 25' 00"	10'	11'-7"
	90° 00' 00"	4'	6'-3"