

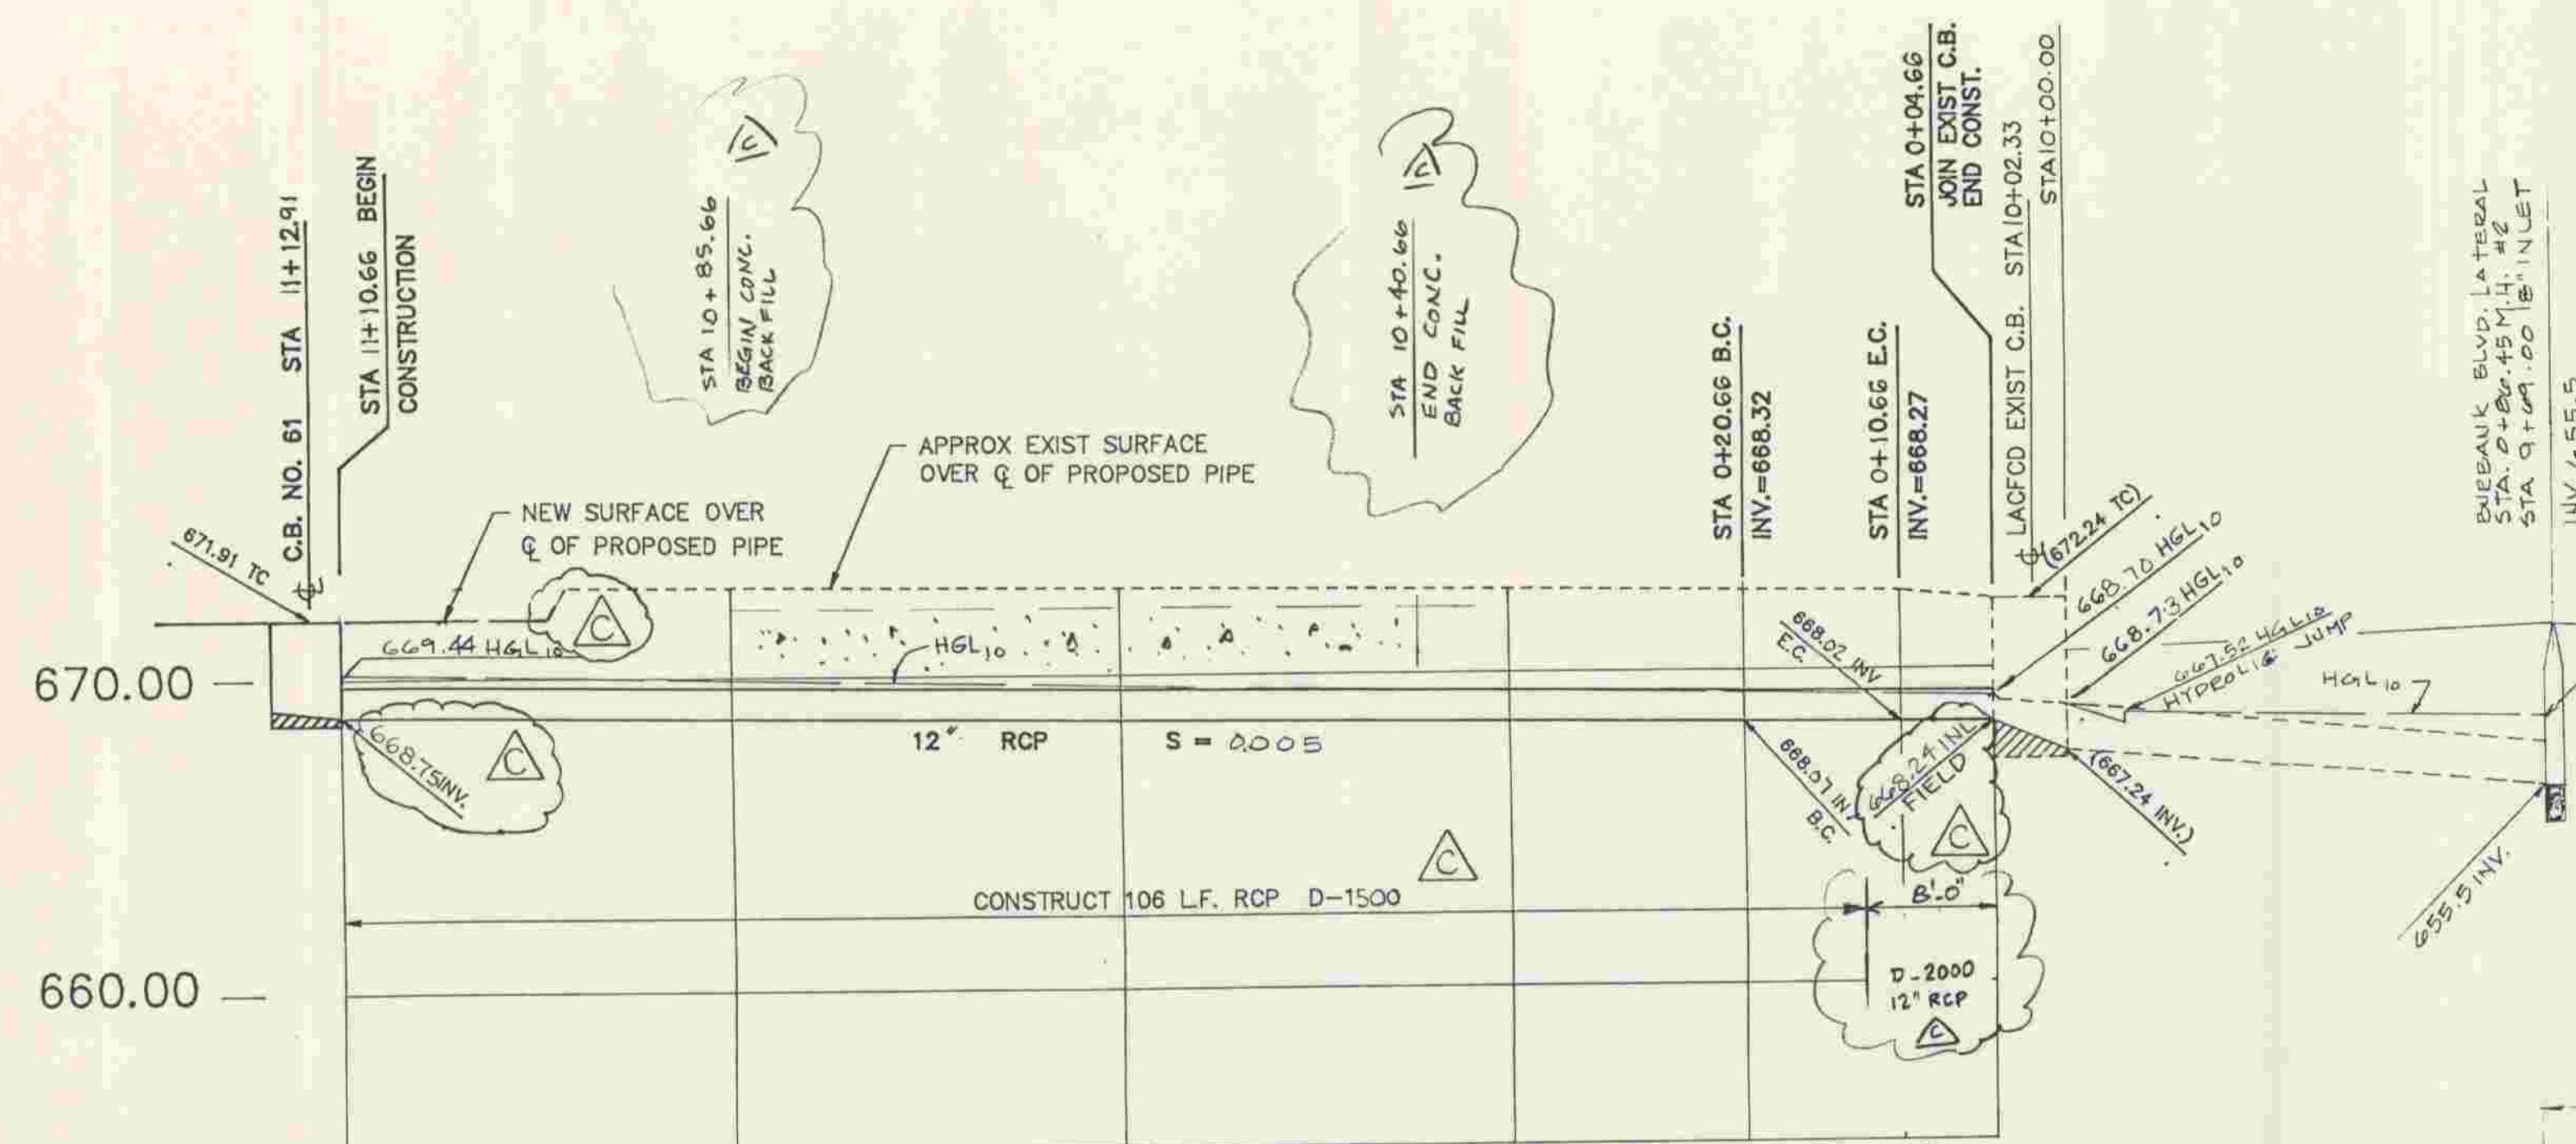


- ① — CONSTRUCT JUNCTION STRUCTURE PER LACFCD STD 2-D190, CASE 3
- ② — CONSTRUCT PRECAST CATCH BASIN NO. 61 PER CITY OF L.A. STD. PLAN S-361-0. $V=3'-2"$ (MIN.)
- ③ — CONSTRUCT 12" RCP (D-1500) STORM DRAIN, TRENCHING & BEDDING PER MANUFACTURER'S RECOMMENDATION'S
- ④ — CONSTRUCT L.D. PER LACFCD STD 2-D88, CASE C
- ⑤ — ENCASE 12" RCP DRAIN IN CONCRETE PER CITY OF L.A. STANDARD PLAN S-251-1 CASE 4 WITH CONCRETE BACKFILL
- ⑥ — 12" RCP (D-2000) STORM DRAIN IN PUBLIC RIGHT OF WAY.

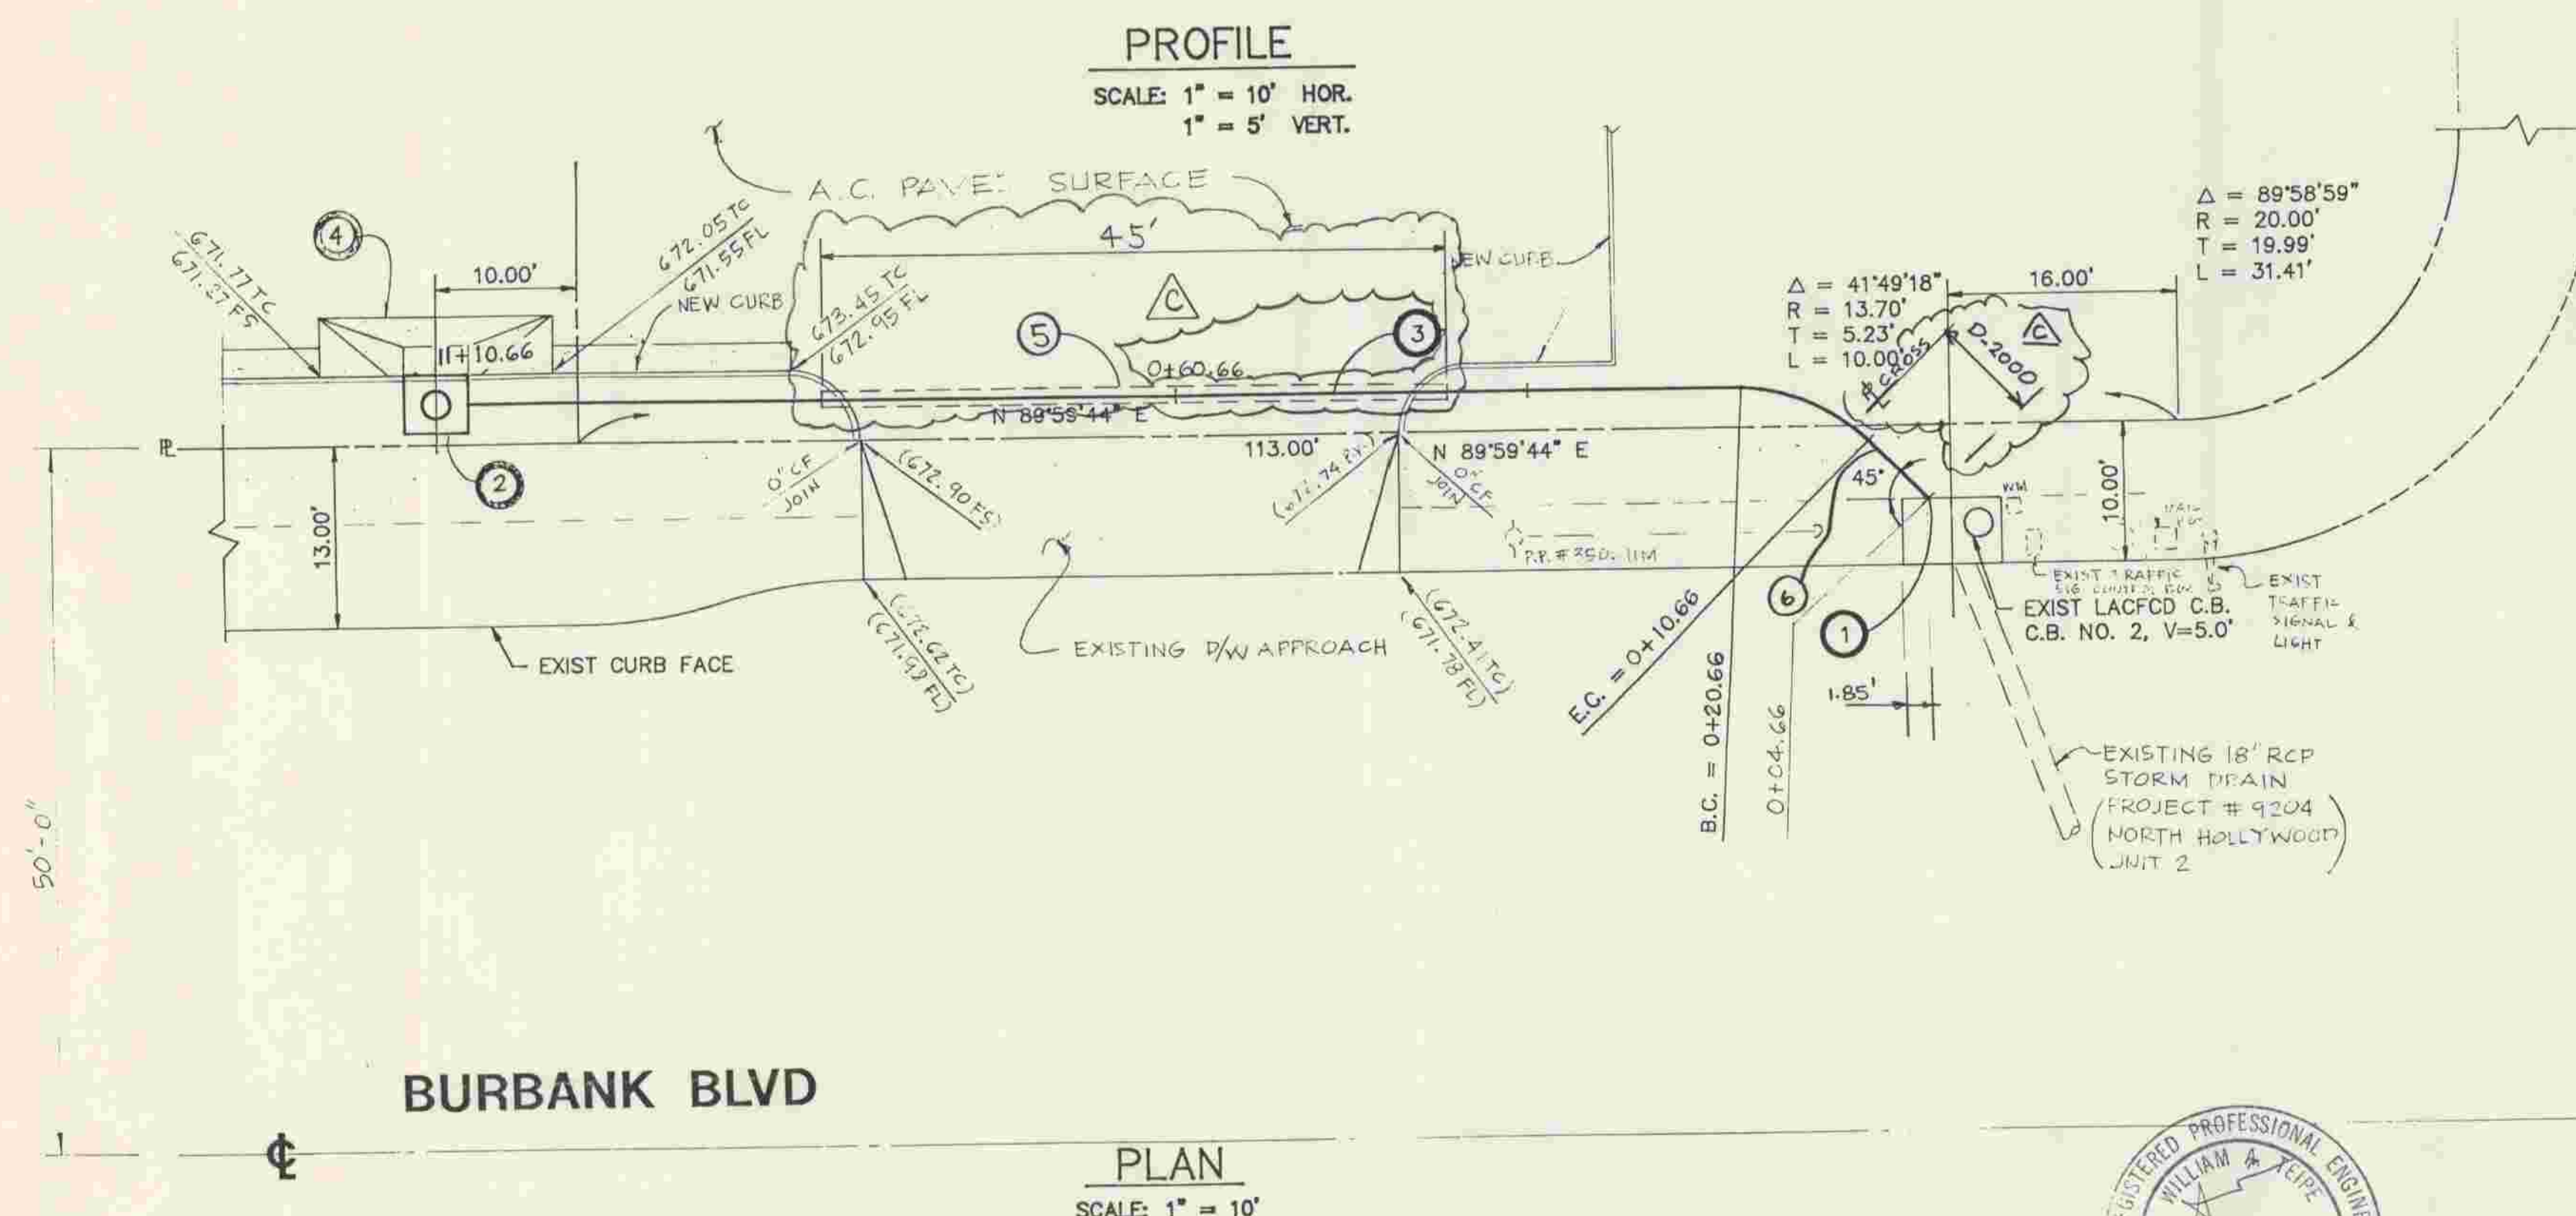

1. CONTRACTOR SHALL VERIFY HORIZONTAL AND VERTICAL LOCATION OF ALL EXISTING WATER AND SEWER MAINS WITHIN THE CONSTRUCTION ZONE OF THIS PROJECT PRIOR TO STARTING CONSTRUCTION.
2. CONTRACTOR SHALL OBTAIN ALL PERMITS REQUIRED BY THE CITY OF LOS ANGELES FOR CONSTRUCTION OF THIS PROJECT.
3. CONTRACTOR SHALL VERIFY LOCATION AND DEPTH, AND PROTECT IN PLACE ALL ELECTRICAL, TELEPHONE AND GAS FACILITIES WITHIN THE CONSTRUCTION ZONE OF THIS PROJECT PRIOR TO STARTING CONSTRUCTION, AND NOTIFY THE PROJECT ENGINEER OF ANY CONFLICTS.
4. CONTRACTOR SHALL COORDINATE WITH THE UTILITY COMPANIES THE LOCATIONS OF ALL UTILITIES WITHIN THE CONSTRUCTION ZONE BY CALLING UNDERGROUND ALERT AT 1-800-422-4133 PRIOR TO STARTING CONSTRUCTION.
5. CONTRACTOR SHALL CALL THE CITY OF LOS ANGELES PUBLIC WORKS DIVISION AND COUNTY OF LOS ANGELES PUBLIC WORKS DIVISION TWO (2) WORKING DAYS PRIOR TO ALL REQUIRED INSPECTION.
6. ALL WORK SHALL CONFORM TO THE STANDARDS AND SPECIFICATIONS OF THE COUNTY OF LOS ANGELES AND THE STANDARD SPECIFICATION FOR PUBLIC WORKS CONSTRUCTION 1988 EDITION UNLESS OTHERWISE SPECIFIED.
7. DISPOSAL OF EXCESS TRENCH MATERIAL SHALL BE AS DIRECTED IN GRADING PLANS.
8. CONTRACTOR SHALL AT HIS EXPENSE PROVIDE SOILS ENGINEER'S TRENCH CONSTRUCTION REPORTS AS REQUIRED BY COUNTY INSPECTOR.
9. CONNECTION TO BACK OF CATCH BASIN SHALL REQUIRE A SEPARATE PUBLIC WORKS STORM DRAIN TAP PERMIT AND A PERMIT FROM L.A. COUNTY DEPARTMENT OF PUBLIC WORKS. 2 HOURS SPECIAL INSPECTION FOR PUBLIC WORKS.

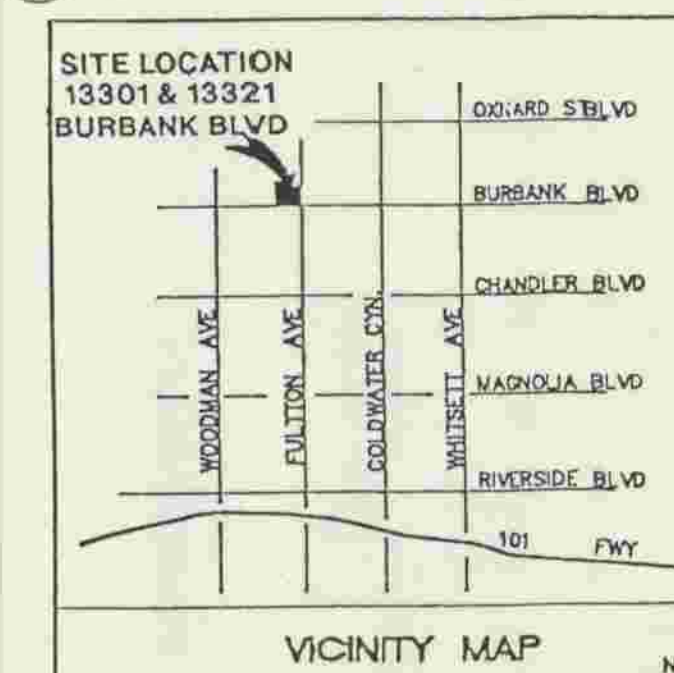

FULTON AVE

470-9204-F-15
FILE COPY



PRINTED
FEB 11 1992
TEPPE & ASSOCIATES

NUMBER	SHT.	REFERENCE DRAWING	CITY OF LOS ANGELES BENCH MARK NO. 08-09302 ELEV. 673.188 WIRE SPK IN NORTH CURB BURBANK BLVD, 125 FT EAST OF BC CURB RETURN EAST OF FULTON AVENUE.	WILLIAM A. TEIPE & ASSOCIATES, INC. CONSULTING ENGINEERS 3164 EAST LA PALMA AVENUE SUITE - C ANAHEIM, CA 92806 (714) 630-3312	DRAWN EL DATE 10/24/91 DESIGNED TG APPROVED WAT APPROVED WAT WT DWG NO. 9168-03 SCALE AS NOTED JOB NO. 9168 DRAWING 9168-004	IN THE CITY OF LOS ANGELES 12" RCP STORM DRAIN PLAN AND PROFILE 13301 & 13321 BURBANK BLVD. LOS ANGELES, CA REVISIONS
					C 2/11/92 REVISED PER FIELD CONFIRMATION AND PLAN CHECK COMMENTS MT B 12/24/91 REVISED TO REFLECT 10 YEAR ISDEM A 9/91 ISSUED FOR PLAN CHECK REV. DATE BY CHK. APP.	