



SIGNAL STANDARD SCHEDULE					
No.	TYPE	FOUND. TYPE	PED. PUSH BUTN TYPE	PHASE	REMARKS
(X) 1	332 CAB.	F-332 (E)			ATSAC 2070 CONTROLLER IN 332 CAB.
(X) 2	C-2	CIDH***			20' M.A., SIGN "A", VIDEO CAMERA
(E) 3	CD953C	*			
(X) 4	19-4-80	CIDH**			25' M.A., SIGN "A"
(X) 5	1A	F-1			
(X) 6	CD954	F-2			15' M.A.
(X) 7	CD953C	*			SIGN "A"
(E) 8	CD953C-7	F-2			15' M.A., SIGN "A"
(E) 9	CD953C	*			
(X) 10	19-4-80	CIDH**			25' M.A., SIGN "A"
(X) 11	1A	F-1			
(X) 12	CD954	F-2			15' M.A.
(X) 13	CD953C*	*			SIGN "A"


(E)=Existing
* For reference only, see Street Lighting sheet
** CIDH PILE Foundation Per Caltrans Latest Plans.
*** CIDH PILE Foundation Per LADOT Std. Dwg. No. S-52.1.4B.

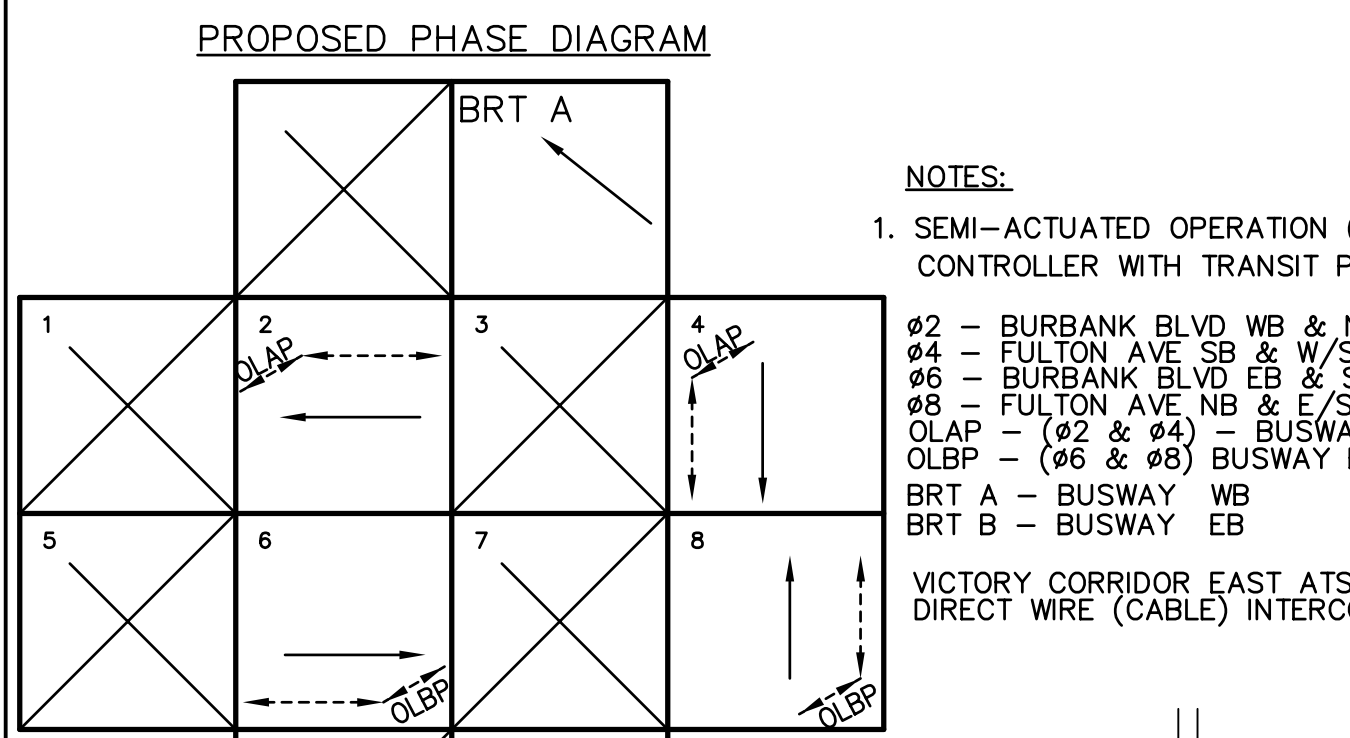

NOTES:
1. SEMI-ACTUATED OPERATION (ATSAC 2070 CONTROLLER WITH TRANSIT PRIORITY IN 332 CABINET)
02 - BURBANK BLVD WB & N/S PED XING
04 - FULTON AVE SB & W/S PED XING
06 - BURBANK BLVD EB & S/S PED XING
08 - FULTON AVE NB & E/S PED XING
OLAP - (02 & 04) - BUSWAY W/S PED XING
OLBP - (06 & 08) - BUSWAY E/S PED XING
BRT A - BUSWAY WB
BRT B - BUSWAY EB
VICTORY CORRIDOR EAST ATSAC SYSTEM DIRECT WIRE (CABLE) INTERCONNECT

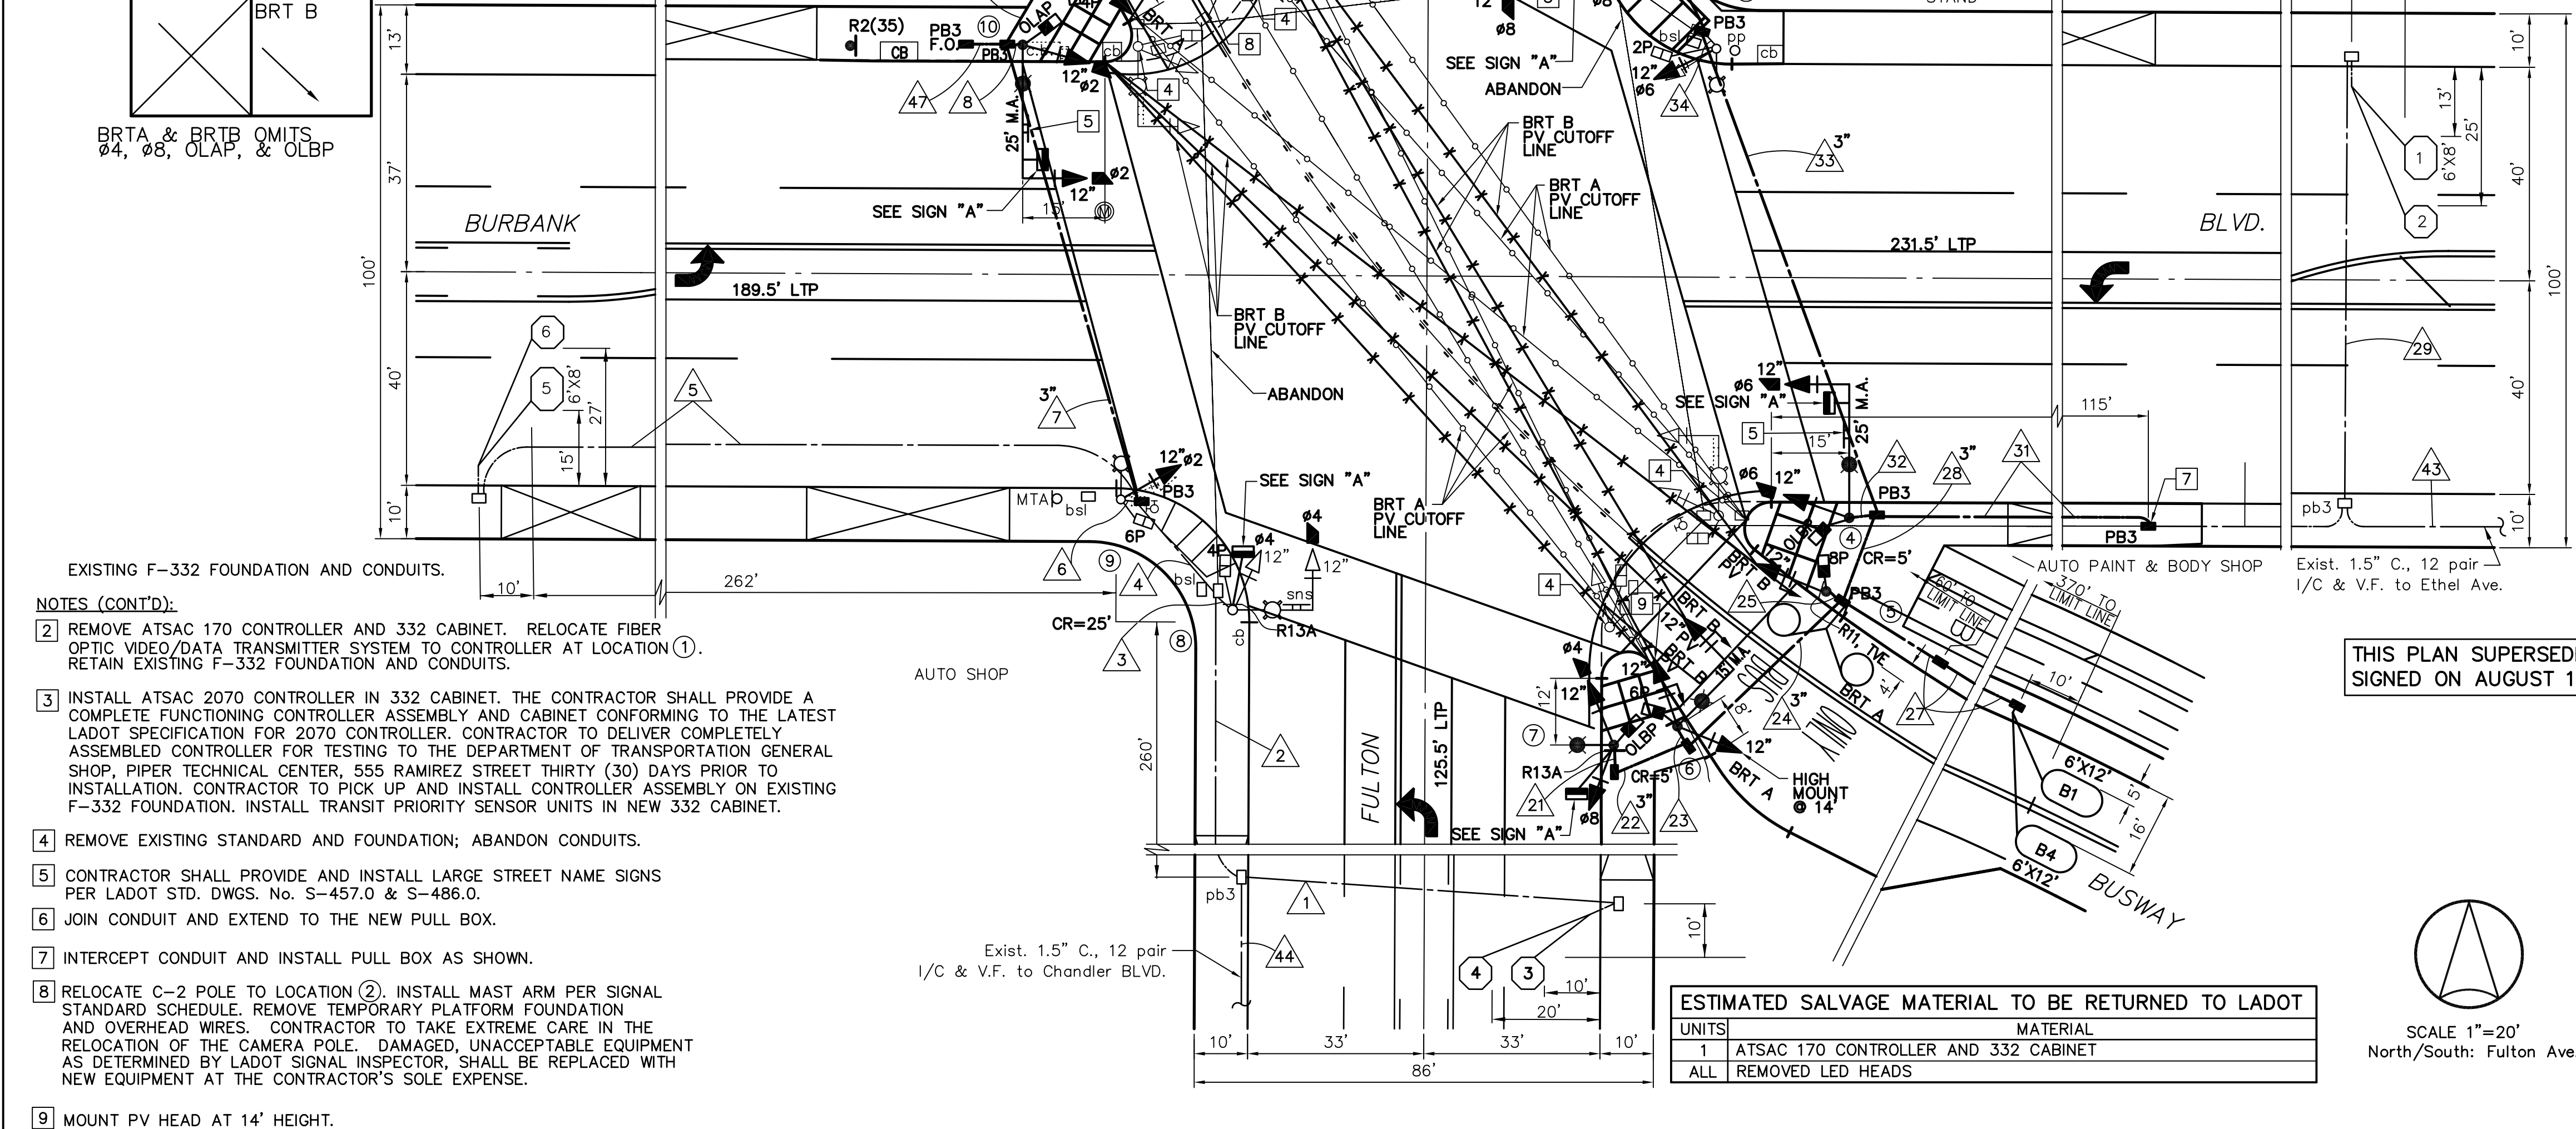

DESIGNED BY J. BERNAL DRAWN BY J. BERNAL CHECKED BY D. YEH IN CHARGE W. OKITSU DATE 06/30/04					
AS-BUILT RECORD DRAWING					
SERVICE RISER CHANGE - IFC					
SERVICE LOCATION CHANGE - IFC					
ISSUED FOR CONSTRUCTION					
REV	DATE	BY	APP	REG NO	EXPIRES
3	02-16-06	AXK			
2	01-17-05	JFB	WJO	52655	12/31/06
1	08-09-04	JFB	WJO	52655	12/31/06
0	06-30-04	JFB	WJO	52655	12/31/06
REV	DATE	BY	APP	REG NO	EXPIRES
3	02-16-06	AXK			
2	01-17-05	JFB	WJO	52655	12/31/06
1	08-09-04	JFB	WJO	52655	12/31/06
0	06-30-04	JFB	WJO	52655	12/31/06
REV	DATE	BY	APP	REG NO	EXPIRES
3	02-16-06	AXK			
2	01-17-05	JFB	WJO	52655	12/31/06
1	08-09-04	JFB	WJO	52655	12/31/06
0	06-30-04	JFB	WJO	52655	12/31/06

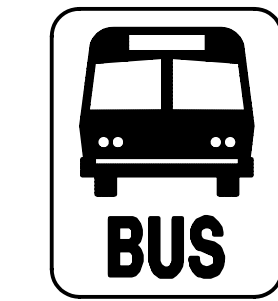

LED SIGN SIGN "A"
Not to Scale
LED SIGN SHALL BE PER
LADOT Std. Dwg. No. S-58.15

- NOTES (CONT'D):
- INSTALL TWO-INCH (2") RISER (AT 4 O'CLOCK) ON SERVICE POLE No. 265849M
 - INSTALL SERVICE PER LADOT STD. DWG. NO. S-79.8. INSTALL TWO (2) #6 SERVICE WIRES AND 60 AMP FUSE IN AN IN-LINE WATERPROOF FUSE HOLDER IN THE SERVICE PULLBOX. WORK ON ANY ELECTRICAL SERVICE EQUIPMENT TO BE DONE ONLY IN CONJUNCTION WITH THE DWP PERSONNEL. CONTACT DWP AT (213) 367-3003 SEVEN (7) WORKING DAYS PRIOR TO INSTALLATION OF SERVICE LINE.
 - INSTALL STRIPING, SIGNS AND PAVEMENT MARKINGS PER LADOT DWG. NO. A-4152 FOR THIS PROJECT. REMOVE ALL CONFLICTING STRIPING AND PAVEMENT MARKINGS.
 - SEE STREET LIGHTING SHEET FOR WORK ON STREET LIGHTING FACILITIES.
 - INSTALL TRANSIT PRIORITY LOOPS PER LADOT STD. DWG. NO. S-70.1F AND VEHICLE LOOPS PER STD. DWG. NO. S-70.1A.
 - ALL NEW VEHICLE AND PEDESTRIAN TRAFFIC SIGNALS SHALL BE LED MODULES, PER LADOT SPECIFICATION 92-088-03 (LATEST EDITION).


CONDUCTOR SCHEDULE		RUN		CONDUCTOR		SCHEDULE	
SIZE No.	CABLE / WIRE	RUN		CONDUCTOR		SCHEDULE	
5	CONDUCTOR CABLE 5 X #14	4	2	4	2	R	4
9	CONDUCTOR CABLE 8 X #14 & 1 X #12 (COM)					O	1
12	CONDUCTOR CABLE 11 X #14 & 1 X #12 (COM)	1				P	1
28	CONDUCTOR CABLE 27 X #14 & 1 X #10 (COM)					E	1
6	SERVICE (Exist.)						
12	DLC BUS LOOP (1 PAIR)						
16	DLC (2 PAIR)	1	1	1	1	O	1
22	I/C (12 PAIR)	1	1	1	1	N	1
	CCTV CABLE					L	1
	VIDEO FIBER (LOOSE TUBE)	1	1	1	2	Y	1
	VIDEO FIBER (TIGHT BUFFER)						
	CONDUIT SIZE	E	E	E	E	E	E

(E)=Existing

NOTICE TO CONTRACTOR

- EXCEPT WHERE OTHERWISE INDICATED, MATERIALS AND INSTALLATION METHODS SHALL CONFORM TO THE LATEST EDITION, WITH SUPPLEMENTS, OF THE STANDARD SPECIFICATION FOR PUBLIC WORKS CONSTRUCTION, ADOPTED BY THE CITY OF LOS ANGELES BOARD OF PUBLIC WORKS (LABPW), INCLUDING THE LATEST VERSION OF STANDARD PLAN S-610 ISSUED BY THE LABPW, AND THE LATEST EDITION, WITH AMENDMENTS, OF THE SPECIAL PROVISIONS AND STANDARD DRAWINGS FOR THE INSTALLATION AND MODIFICATION OF TRAFFIC SIGNALS, ISSUED BY THE CITY OF LOS ANGELES DEPARTMENT OF TRANSPORTATION (LADOT).
- THE LADOT TRAFFIC SIGNAL INSPECTOR SHALL BE NOTIFIED AT (213) 792-7637. THE SENIOR MAINTENANCE SUPERVISOR AT (818) 756-7845, AND THE LADOT METRO RAIL ENGINEER AT (213) 485-2610 THREE (3) WORKING DAYS PRIOR TO THE BEGINNING OF CONSTRUCTION.
- NORMAL TRAFFIC CONTROL SHALL BE MAINTAINED FROM 6:00 A.M. TO 9:00 A.M. AND 3:00 P.M. TO 7:00 P.M. ON WEEKDAYS. HOURS AND DURATION WHEN TRAFFIC SIGNALS ARE DEACTIVATED AND/OR PLACED INTO FLASHING OPERATION REQUIRE THE PRIOR APPROVAL OF THE LADOT METRO RAIL ENGINEER. TRAFFIC SIGNAL DEACTIVATION AND/OR FLASHING OPERATION SHALL BE IMPLEMENTED BY A LADOT TRAFFIC SIGNAL ELECTRICIAN, IN COORDINATION WITH THE ATSAC CONTROL CENTER, AND SHALL BE REQUESTED THREE (3) WORKING DAYS IN ADVANCE THROUGH THE LADOT METRO RAIL ENGINEER. (213) 485-2610. FULL RESTORATION OF THE ATSAC SYSTEM MUST OCCUR WITHIN FIVE (5) WORKING DAYS AFTER DEACTIVATION.
- THE CONTRACTOR SHALL COORDINATE WITH THE LADOT SIGNAL SHOP AT (213) 847-2944 TO ARRANGE CONTROLLER DELIVERY. THE CONTRACTOR SHALL PROVIDE AND DELIVER A COMPLETE FUNCTIONING CONTROLLER ASSEMBLY AND CABINET TO THE LADOT SIGNAL SHOP THIRTY (30) CALENDAR DAYS PRIOR TO THE INSTALLATION DATE, AND PICK UP THE CONTROLLER WITHIN FIFTEEN (15) CALENDAR DAYS AFTER NOTIFICATION BY LADOT SIGNAL SHOP.
- ALL REMOVED TRAFFIC SIGNAL EQUIPMENT IDENTIFIED AS SALVAGED MATERIAL SHALL BE RETURNED TO LADOT. ARRANGEMENTS FOR RETURNING IDENTIFIED EQUIPMENT TO LADOT SHALL BE MADE FIVE (5) WORKING DAYS IN ADVANCE BY CONTACTING THE LADOT MATERIAL CONTROL DIVISION AT (213) 580-5477. THE CONTRACTOR SHALL OBTAIN A SALVAGE RECEIPT FROM LADOT AND FORWARD A COPY, SIGNED BY THE CONTRACTOR, TO THE RECEIVING LADOT YARD TO LADOT METRO RAIL ENGINEER AT 205 S. BROADWAY, SUITE 300, L.A. CA 90012. ALL OTHER REMOVED SIGNAL EQUIPMENT SHALL BE RETAINED BY THE CONTRACTOR.
- ALL EXISTING TRAFFIC CONTROL SIGNING SHALL BE MAINTAINED WITH STANDARD SIGN BRACKETS BY THE CONTRACTOR. EXCEPT WHERE OTHERWISE INDICATED, EXISTING LARGE STREET NAME SIGNS ON MAST ARM TYPE STANDARDS SHALL BE RELOCATED FROM THE VERTICAL POLE TO THE MAST ARM PER LADOT STANDARD DRAWING NO. S-457.0. WHEN CALLED OUT ON THIS PLAN, CONTRACTOR SHALL FURNISH AND INSTALL LARGE STREET NAME SIGNS AND SIGN BRACKETS FOR INSTALLATION ON MAST ARM PER LADOT STD. DWG. NO. S-457.0. ANY TRAFFIC SIGNING DAMAGED OR LOST BY THE CONTRACTOR SHALL BE REPLACED AT THE CONTRACTOR'S EXPENSE.
- THE CONTRACTOR SHALL FURNISH AND INSTALL, AS SHOWN ON THE PLANS, ALL TRAFFIC SIGNAL EQUIPMENT SUCH AS STANDARDS, MAST ARMS, SIGNAL HEADS, AND OTHER EQUIPMENT AS REQUIRED. ALL SUCH EQUIPMENT SHALL BE NEW. ALL SUCH EQUIPMENT SHALL BE IN ACCORDANCE WITH THE LATEST EDITION OF THE SIGNAL MANUAL. ALL VEHICLE HEAD EQUIPMENT SUPPLIED BY THE CONTRACTOR SHALL HAVE 1-1/2 INCH DIAMETER PIPE FIT MOUNTING HARDWARE, INCLUDING ALL TOP POST MOUNT HEADS. PED HEAD MODULE REPLACEMENTS SHOWN ON THE PLAN SHALL REQUIRE A COMPLETE INSTALLATION, INCLUDING NEW PED HEAD AND TERMINAL COMPARTMENT. LEFT TURN SIGNAL HEADS ON MAST ARMS WITH TWO OR MORE SIGNAL HEADS SHALL BE TOP MOUNTED.

THIS PLAN SUPERSEDES PLAN
SIGNED ON AUGUST 19, 2004


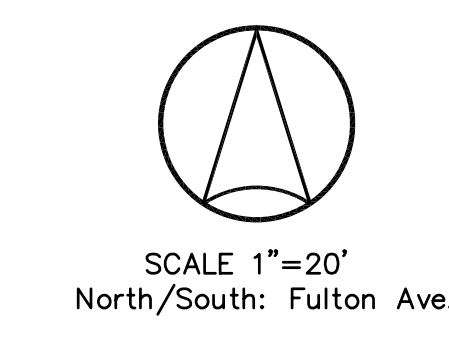


ESTIMATED SALVAGE MATERIAL TO BE RETURNED TO LADOT	
UNITS	MATERIAL
1	ATSAC 170 CONTROLLER AND 332 CABINET
ALL	REMOVED LED HEADS

MTA - SAN FERNANDO VALLEY RAPID BUS SYSTEM (SIGNAL RESTORATION)

REVIEWED <u>January 25, 20 04</u> <u>Ina Van Der Laan</u> Transportation Engineer	RECOMMENDED <u>January 25, 20 04</u> <u>Fudy Wong</u> Senior Transportation Engineer	ACCEPTED <u>January 25, 20 04</u> <u>Thomas L. Jones</u> Principal Transportation Engineer
AS BUILT		
Date of Installation: <u>11-18-05</u> LADOT Inspector: <u>Alegria</u>		
Condition As Of: <u>11-18-05</u> LADOT Engineer: <u>J.P.</u>		
District: <u>EAST VALLEY</u> Thomas Guide: <u>562-01</u>		
References Proj. No. 78002 Proj. No. 78003		
CITY OF LOS ANGELES DEPARTMENT OF TRANSPORTATION WAYNE K. TANDA, GENERAL MANAGER		
TITLE BURBANK BLVD., FULTON AVE. & BUSWAY		
File Name 32570-Q1.DWG	Intersection No. 32570	Project No. 74720
NOTICE: IF PLAN HAS NOT BEEN IMPLEMENTED WITHIN TWO (2) YEARS OF THE ACCEPTANCE DATE, IT MUST BE RESUBMITTED TO LADOT SIGNAL DESIGN SECTION FOR REVIEW AND APPROVAL.		

SEGMENT NO C-0675	
DRAWING NO G5TS-003	REV 3
SCALE 1" = 20'	
SHEET NO	

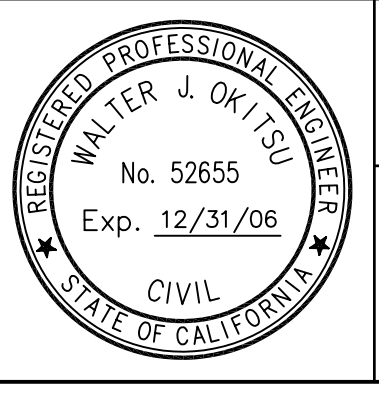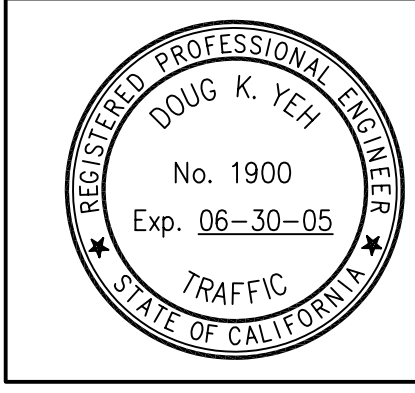

LOS ANGELES COUNTY METROPOLITAN TRANSPORTATION AUTHORITY
SAN FERNANDO VALLEY EAST-WEST BRT PROJECT

WASHINGTON

SHIMMICK
OBAYASHI, JV

Katz, Okitsu & Associates
Traffic Engineers & Transportation Planners
1055 Corporate Center Drive, Suite 300
Monterey Park, California 91754-7642
Tel: (323) 260-4703 Fax: (323) 260-4705