


THE CITY OF LOS ANGELES OR ITS OFFICERS OR AGENTS SHALL NOT BE RESPONSIBLE FOR THE ACCURACY OR COMPLETENESS OF ELECTRONIC COPIES OF THIS PLAN SHEET.




REVISION DATES
(DESIGN STAGE ONLY)

Sheet Version 2.01

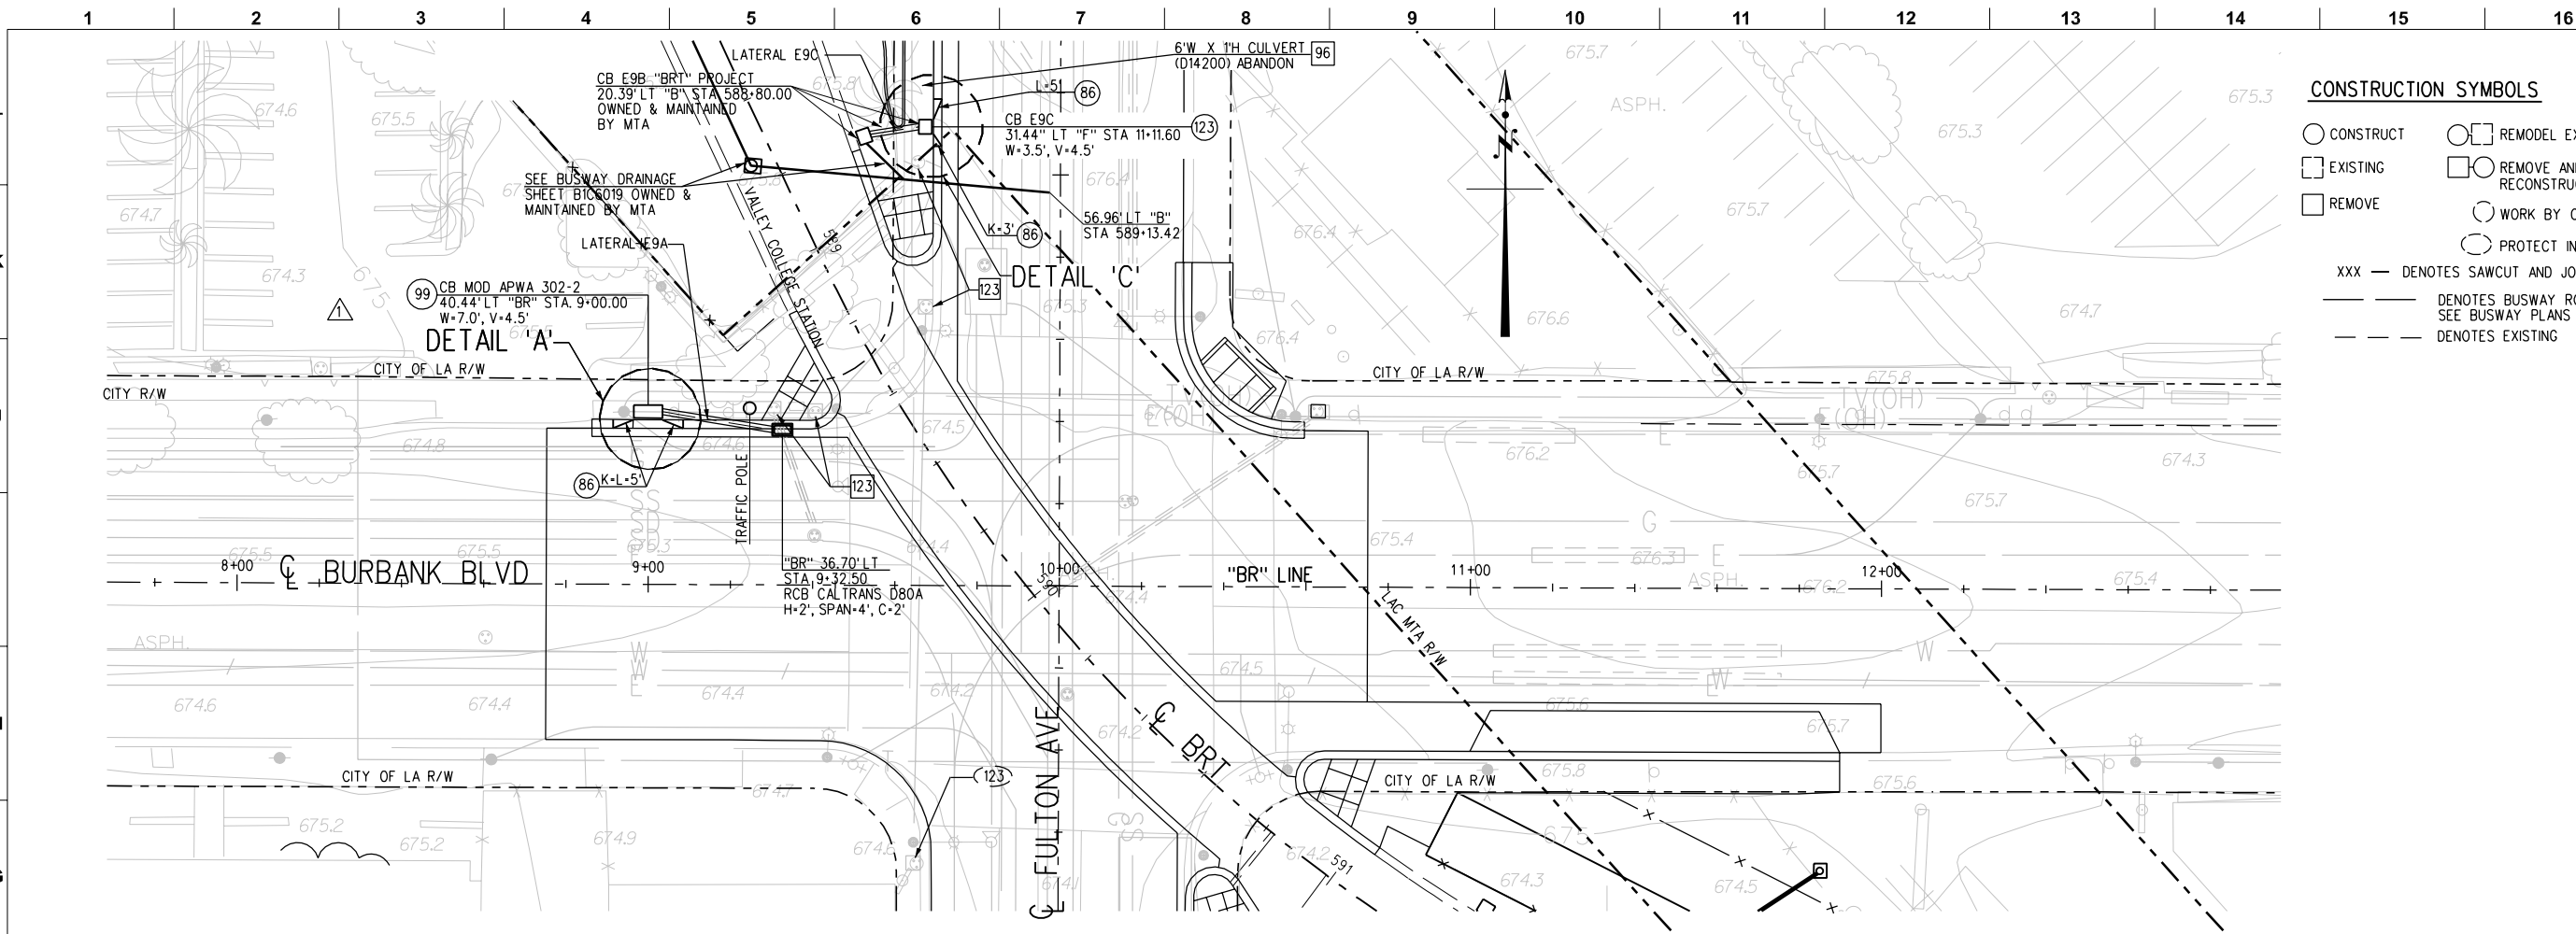


CONSTRUCTION SYMBOLS

- CONSTRUCT
- EXISTING
- REMOVE
- REMODEL EXISTING
- REMOVE AND RECONSTRUCT
- WORK BY OTHERS
- PROTECT IN PLACE
- XXX — DENOTES SAWCUT AND JOIN
- DENOTES BUSWAY ROUTE SEE BUSWAY PLANS
- - - DENOTES EXISTING

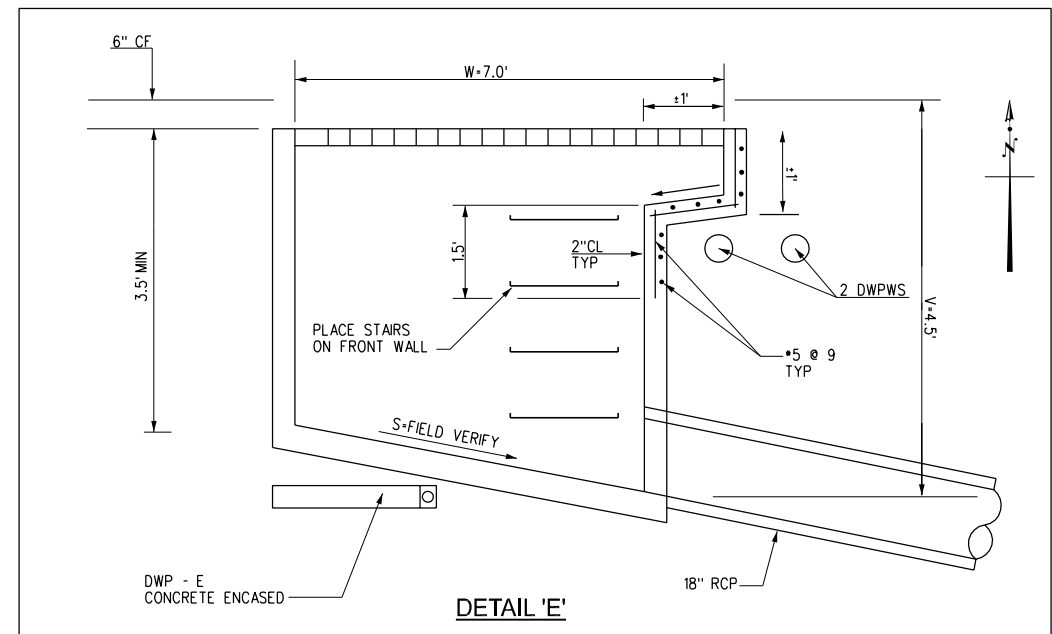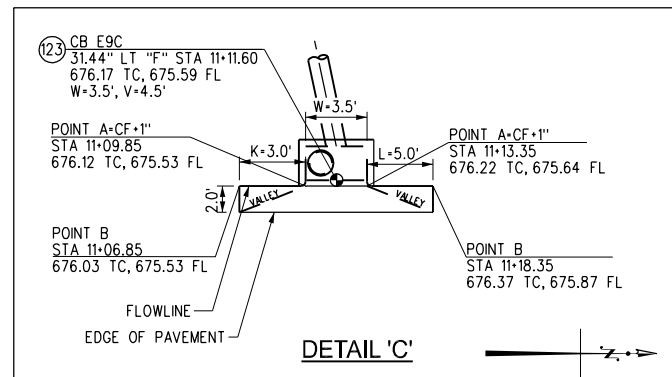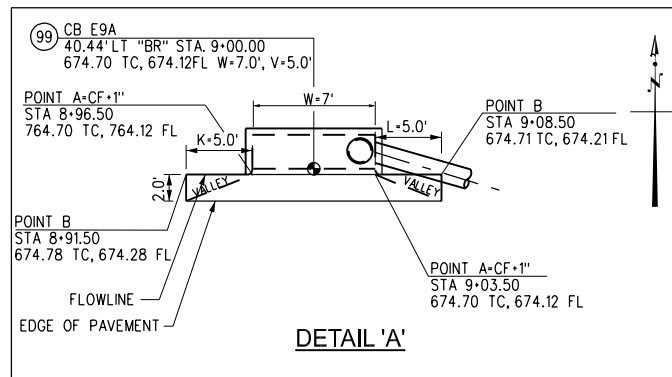

REV	DATE	BY	APP	REG NO	EXPIRES	SEAL HOLDER	DESCRIPTION
1	3/23/05	AKJ	AKJ	C42345	6/30/05	ARVIND K JOSHI	ISSUED FOR CONSTRUCTION
0	9/15/04	HAB	AKJ	C42345	6/30/05	ARVIND K JOSHI	ISSUED FOR CONSTRUCTION

DESIGNED BY
H. BULLOCK
DRAWN BY
N. HERNANDEZ
CHECKED BY
J. VALLE
IN CHARGE
A. JOSHI
DATE
3/23/05

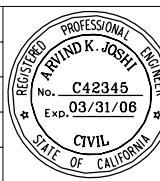

LOS ANGELES COUNTY METROPOLITAN TRANSPORTATION AUTHORITY
SAN FERNANDO VALLEY EAST-WEST BRT PROJECT
Washington Group International
SHIMMICK OBAYASHI, JV

AS-BUILT
STREET IMPROVEMENTS GROUP 5
STORM DRAIN WARP GUTTER DETAILS
FULTON AVE. AT BURBANK BLVD.
SHEET 2 OF 2

REVIEWED AND APPROVED BY: *Garry J. Lee*
GARRY J. LEE, PROJECT MANAGER
WASHINGTON GROUP INTERNATIONAL
CONTRACT NO. C0675
DRAWING NO. G5C6-002
SCALE: HORIZ. SCALE: 1"=20'
VERT. SCALE: 1"=4'
SHEET NO. 1

ENGINEERING

LA DPW

DATE: 9/15/04

DATE: 3/23/05

DATE: 11/29/05

BY: HAB

BY: AKJ

BY: WJ

ISSUED FOR CONSTRUCTION

ISSUED FOR CONSTRUCTION

AS-BUILT

WORK ACCEPTED

SERIAL NO.

INDEX NO.

B - PERMITS

BD/BC

APPROVALS:

DATE:

ST. TREES DIV.

ST. LIGHTING

D.O.T.

CITY ENGINEER

DATE

DATE

ACCEPTED BY:

DATE

DATE

PLANS

SAN FERNANDO VALLEY EAST-WEST PROJECT

PROJECT:

ADDRESS:

PROJECT NO.

DRAWING NO.

2

SHEET 2 OF 2 SHEETS

CITY OF LOS ANGELES

DEPARTMENT OF PUBLIC WORKS

BUREAU OF ENGINEERING