

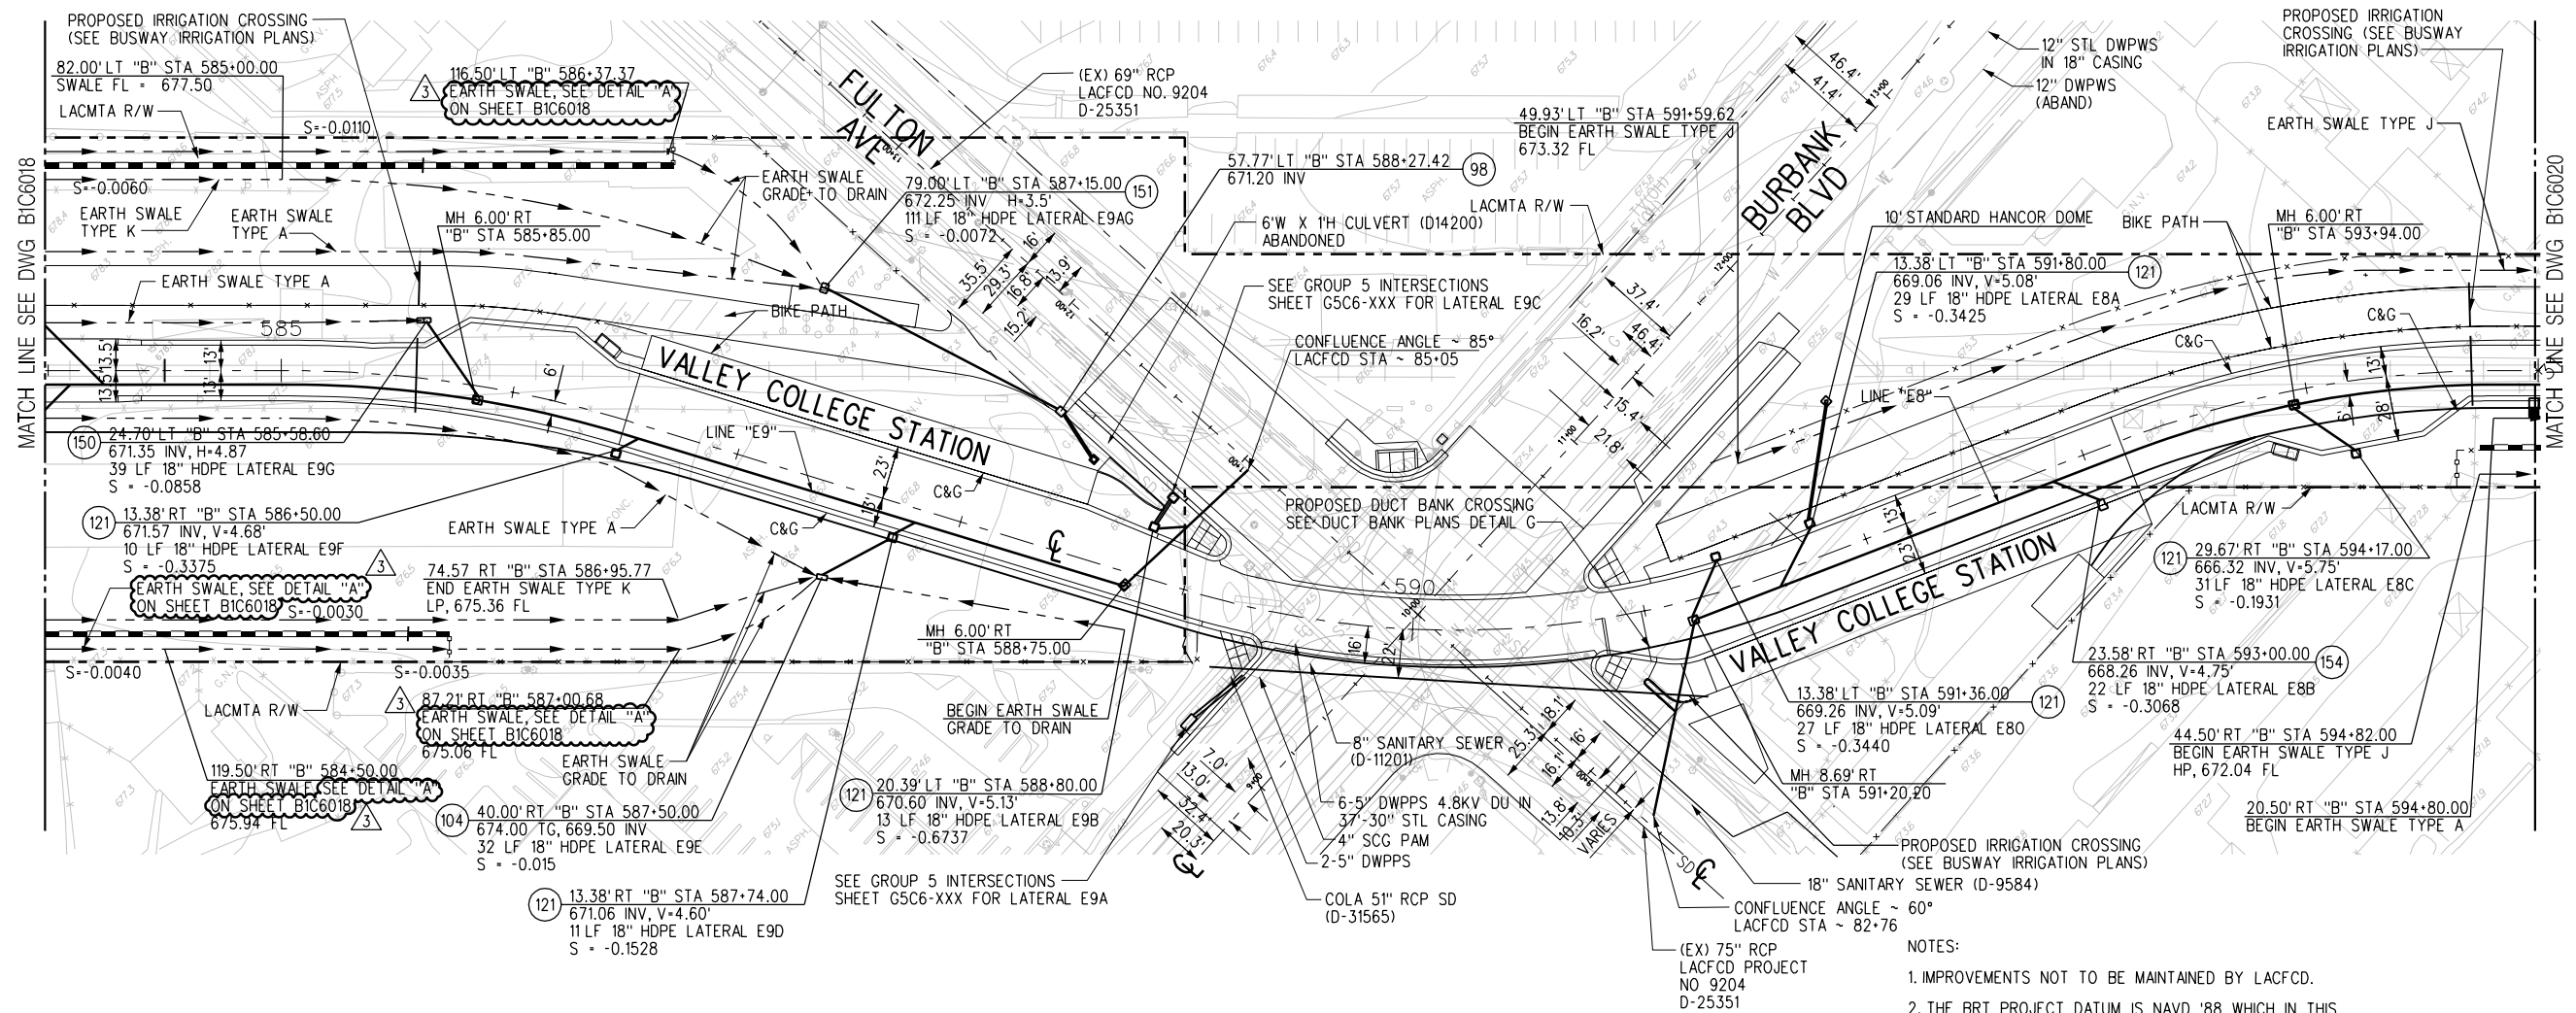


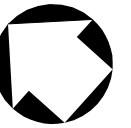

- NOTES:
- IMPROVEMENTS NOT TO BE MAINTAINED BY LACFCD.
 - THE BRT PROJECT DATUM IS NAVD '88 WHICH IN THIS VICINITY IS APPROXIMATELY 2.22' HIGHER THAN LACFCD PROJECT NO. 9204 AS-BUILT NGVD '29 DATUM.
 - MINIMUM PIPE STIFFNESS FOR THE 24" HDPE PIPE IS 34 PSIAS SET BY AASHTO M-294. SEE DRAWING NO. BIC6035 FOR BEDDING AND LOADING DETAILS.
 - FOR SWALE AND DITCH SECTIONS SEE DRAINAGE SHEETS.

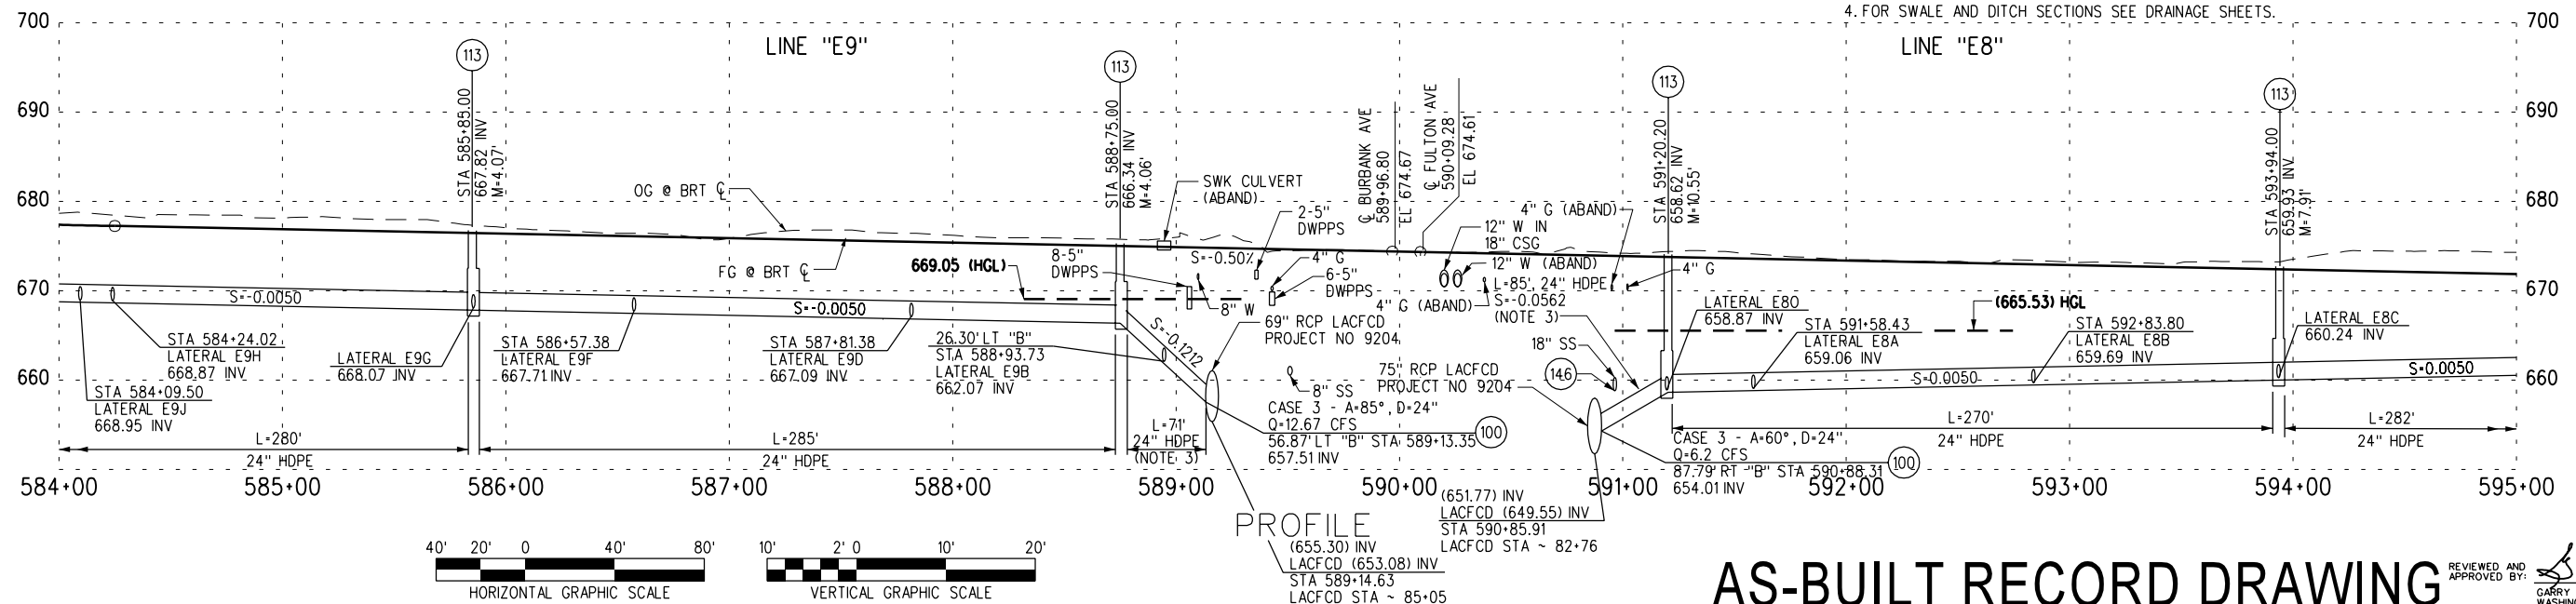


AS-BUILT RECORD DRAWING

REVIEWED AND APPROVED BY: 
GARRY J. JESS - PROJECT MANAGER
WASHINGTON GROUP INTERNATIONAL

REV	DATE	BY	APP	REG NO	EXPIRES	SEAL HOLDER	DESCRIPTION
3	10/18/05	AU	TG				
2	04/14/05	JLL	AKJ	C42345	03/31/06	ARVIND K. JOSHI	AS-BUILT RECORD DRAWING
1	03/4/04	BEJ	CC	C59517	12/31/05	BRETT E. JONES	INCORPORATED RFI #420 - IFC
0	12/31/03	HAB	AKJ	C42345	03/31/06	ARVIND K. JOSHI	FULTON/BURBANK SUPERELEVATION CHANGE
							ISSUED FOR CONSTRUCTION

DESIGNED BY
H. BULLOCK
DRAWN BY
A. GOMEZ
CHECKED BY
D. ORTIZ
IN CHARGE
B. JONES
DATE
2/12/04

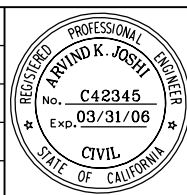



LOS ANGELES COUNTY METROPOLITAN TRANSPORTATION AUTHORITY
SAN FERNANDO VALLEY EAST-WEST BRT PROJECT



Washington Group International
WASHINGTON GROUP INTERNATIONAL, INC.
5805 SEPULVEDA BLVD., SUITE 500
VAN NUYS, CA 91411



**SHIMMICK
OBAYASHI, JV**
5805 SEPULVEDA BLVD., SUITE 500
VAN NUYS, CA 91411

BUSWAY SEGMENT 1 EAST
DRAINAGE PLAN & PROFILE
STA 584+00 TO STA 595+00
SHEET 7 OF 20

CONTRACT NO	C0675
DRAWING NO	BIC6019
SCALE	HORIZ 1"=40' VERT 1"=10'
SHEET NO	3