


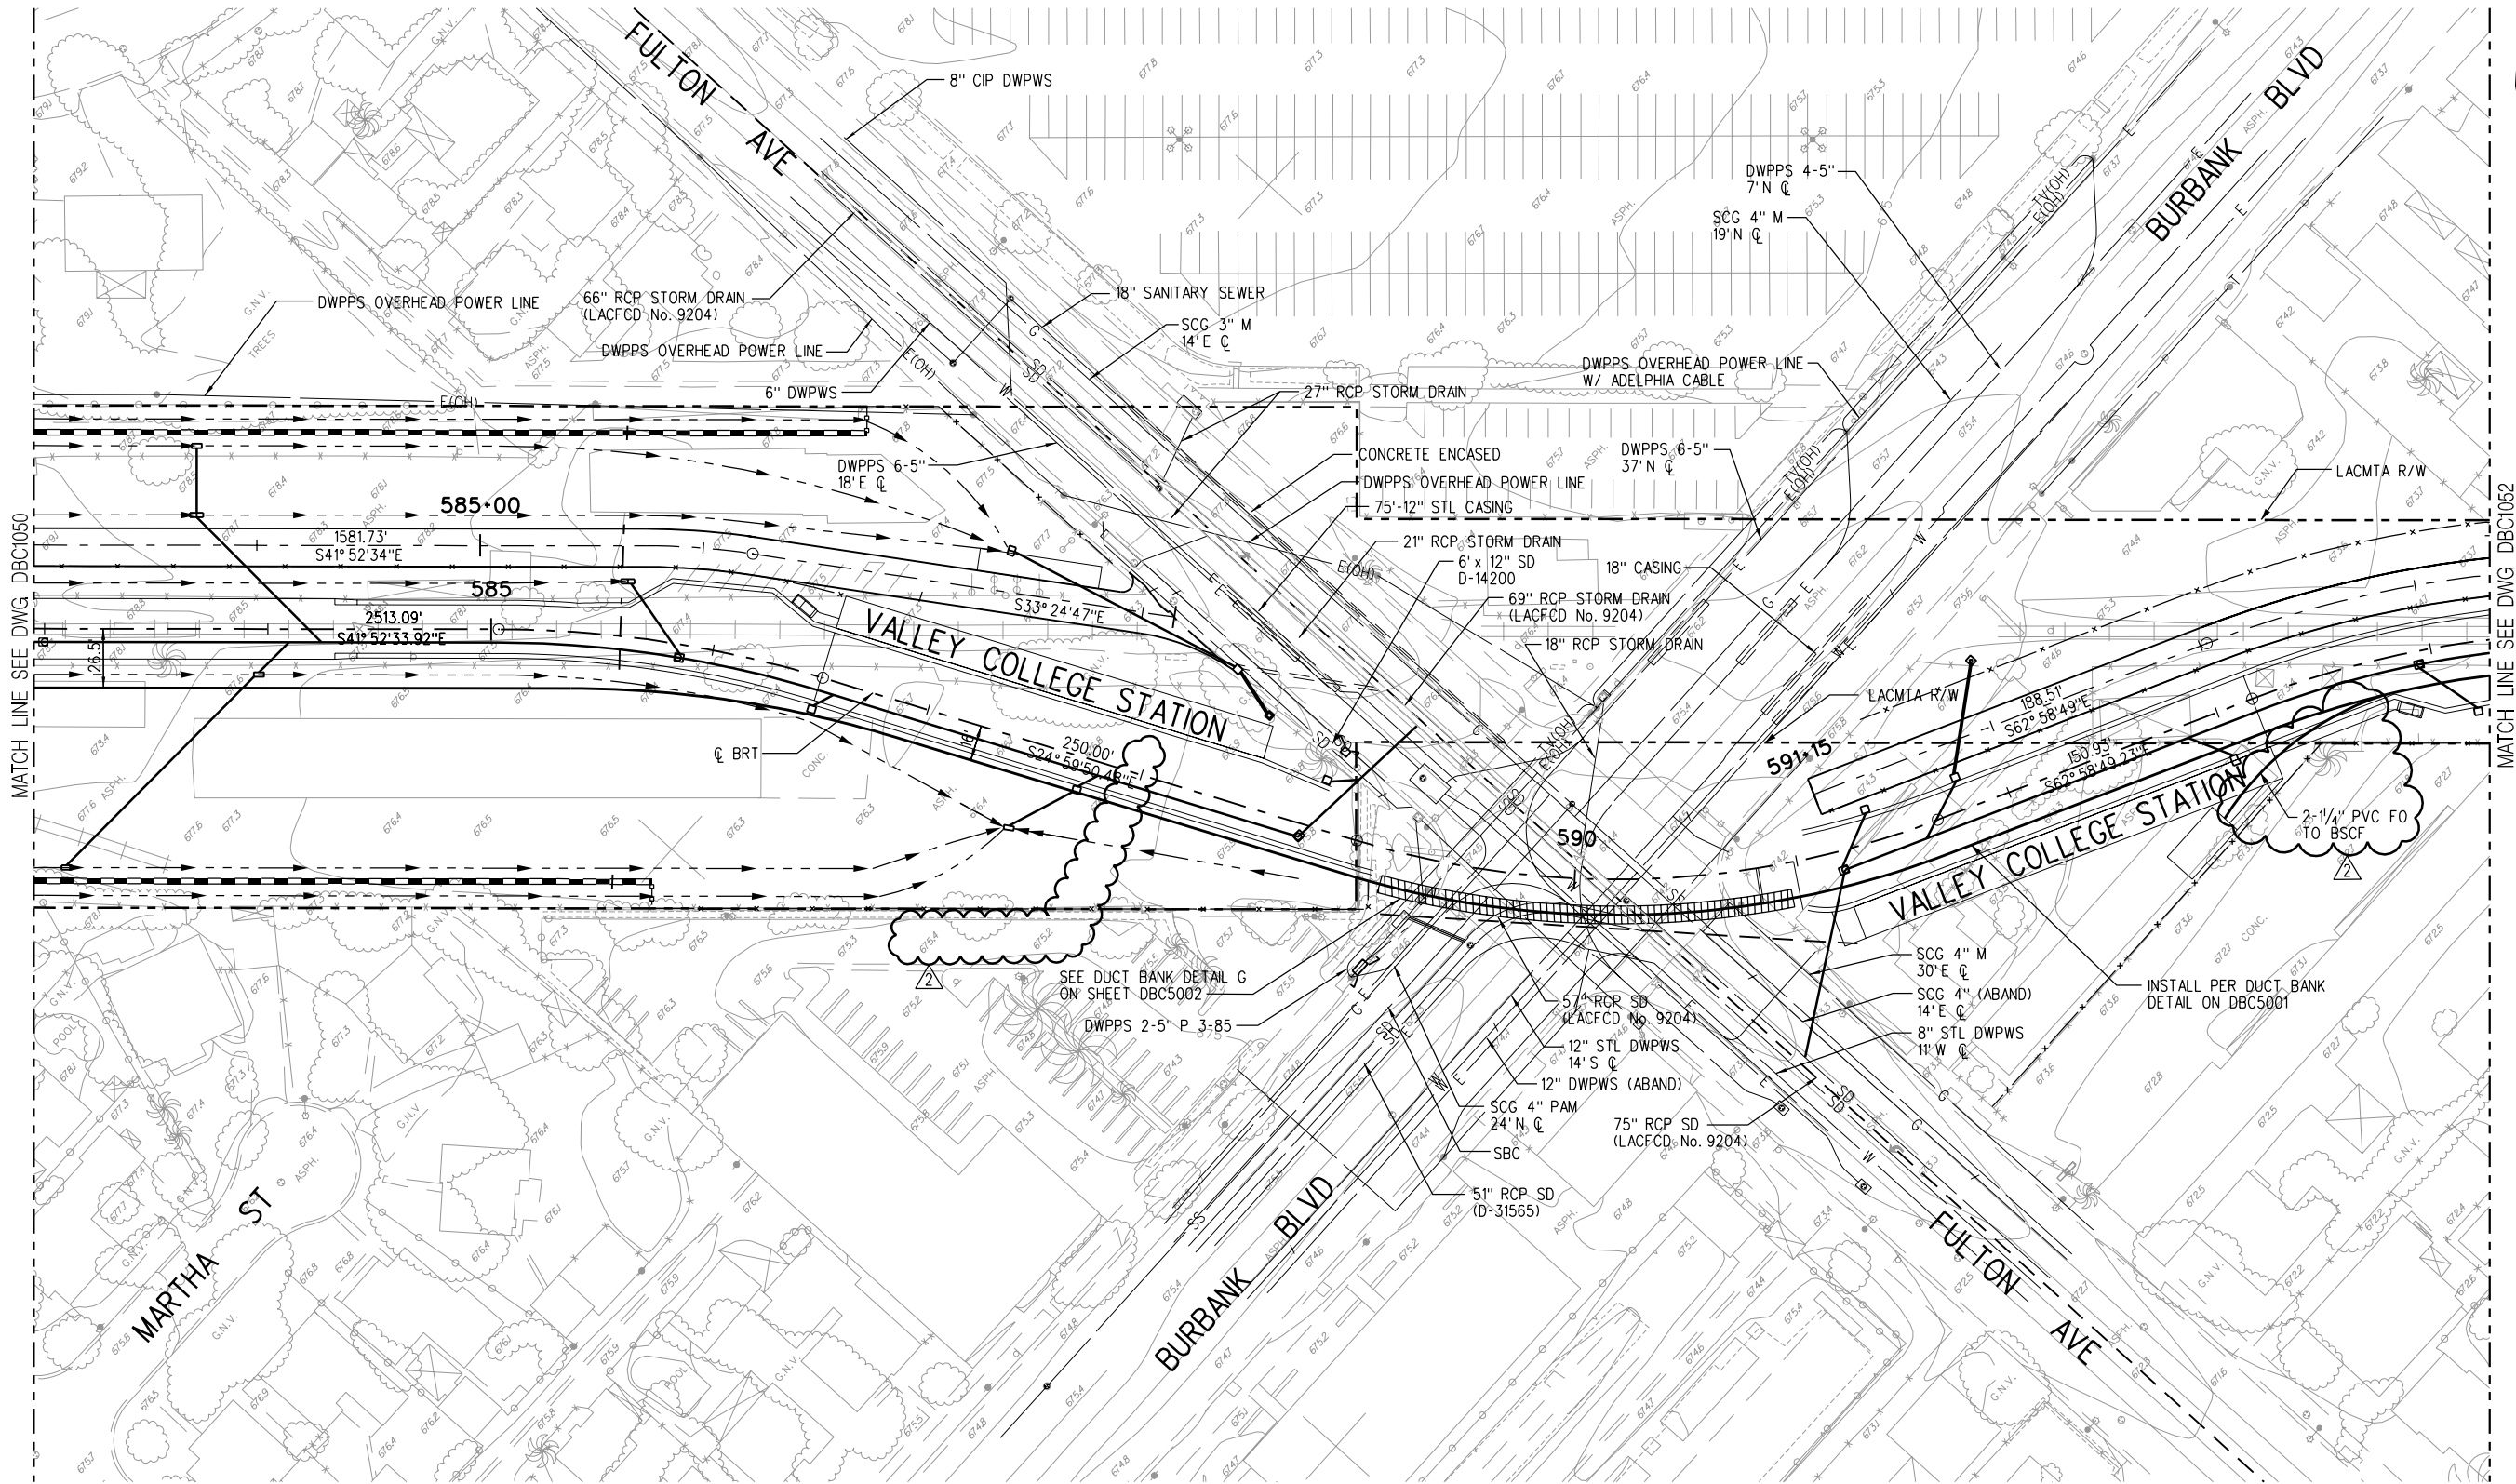

AS-BUILT RECORD DRAWING

REVIEWED AND APPROVED BY: *Garry J. Jess*
GARRY J. JESS - PROJECT MANAGER
WASHINGTON GROUP INTERNATIONAL

REV	DATE	BY	APP	REG NO	EXPIRES	SEAL HOLDER	DESCRIPTION
2	11/23/05	AU	TG				AS-BUILT RECORD DRAWING
1	3/10/04	AKJ	BEJ	C59517	12/31/04	BRETT E. JONES	INCORPORATED MTA COMMENTS - IFC
0	1/22/04	YX	BEJ	C59517	12/31/05	BRETT E. JONES	ISSUED FOR CONSTRUCTION - 1B

DESIGNED BY
S. YOUSEFIAN
DRAWN BY
A. GOMEZ
CHECKED BY
C. ANTICH
IN CHARGE
B. JONES
DATE
11/12/03



LOS ANGELES COUNTY METROPOLITAN TRANSPORTATION AUTHORITY
SAN FERNANDO VALLEY EAST-WEST BRT PROJECT

Washington Group International
WASHINGTON GROUP INTERNATIONAL, INC.
5805 SEPULVEDA BLVD., SUITE 500
VAN NUYS, CA 91411

SHIMMICK
OBAYASHI, JV
5805 SEPULVEDA BLVD., SUITE 500
VAN NUYS, CA 91411

CONTRACT NO C0675	
DRAWING NO DBC1051	REV 2
SCALE HORIZ. 1"=40'	
SHEET NO	

NORTH HOLLYWOOD TO
WARNER CENTER
MAIN LINE DUCT BANK
STA 582+95 TO STA 594+27