


EXISTING OVERHEAD HIGH VOLTAGE AND COMMUNICATION LINES IN PROXIMITY TO PROJECT SITE. EXERCISE CAUTION WHEN INSTALLING NEW EQUIPMENT.

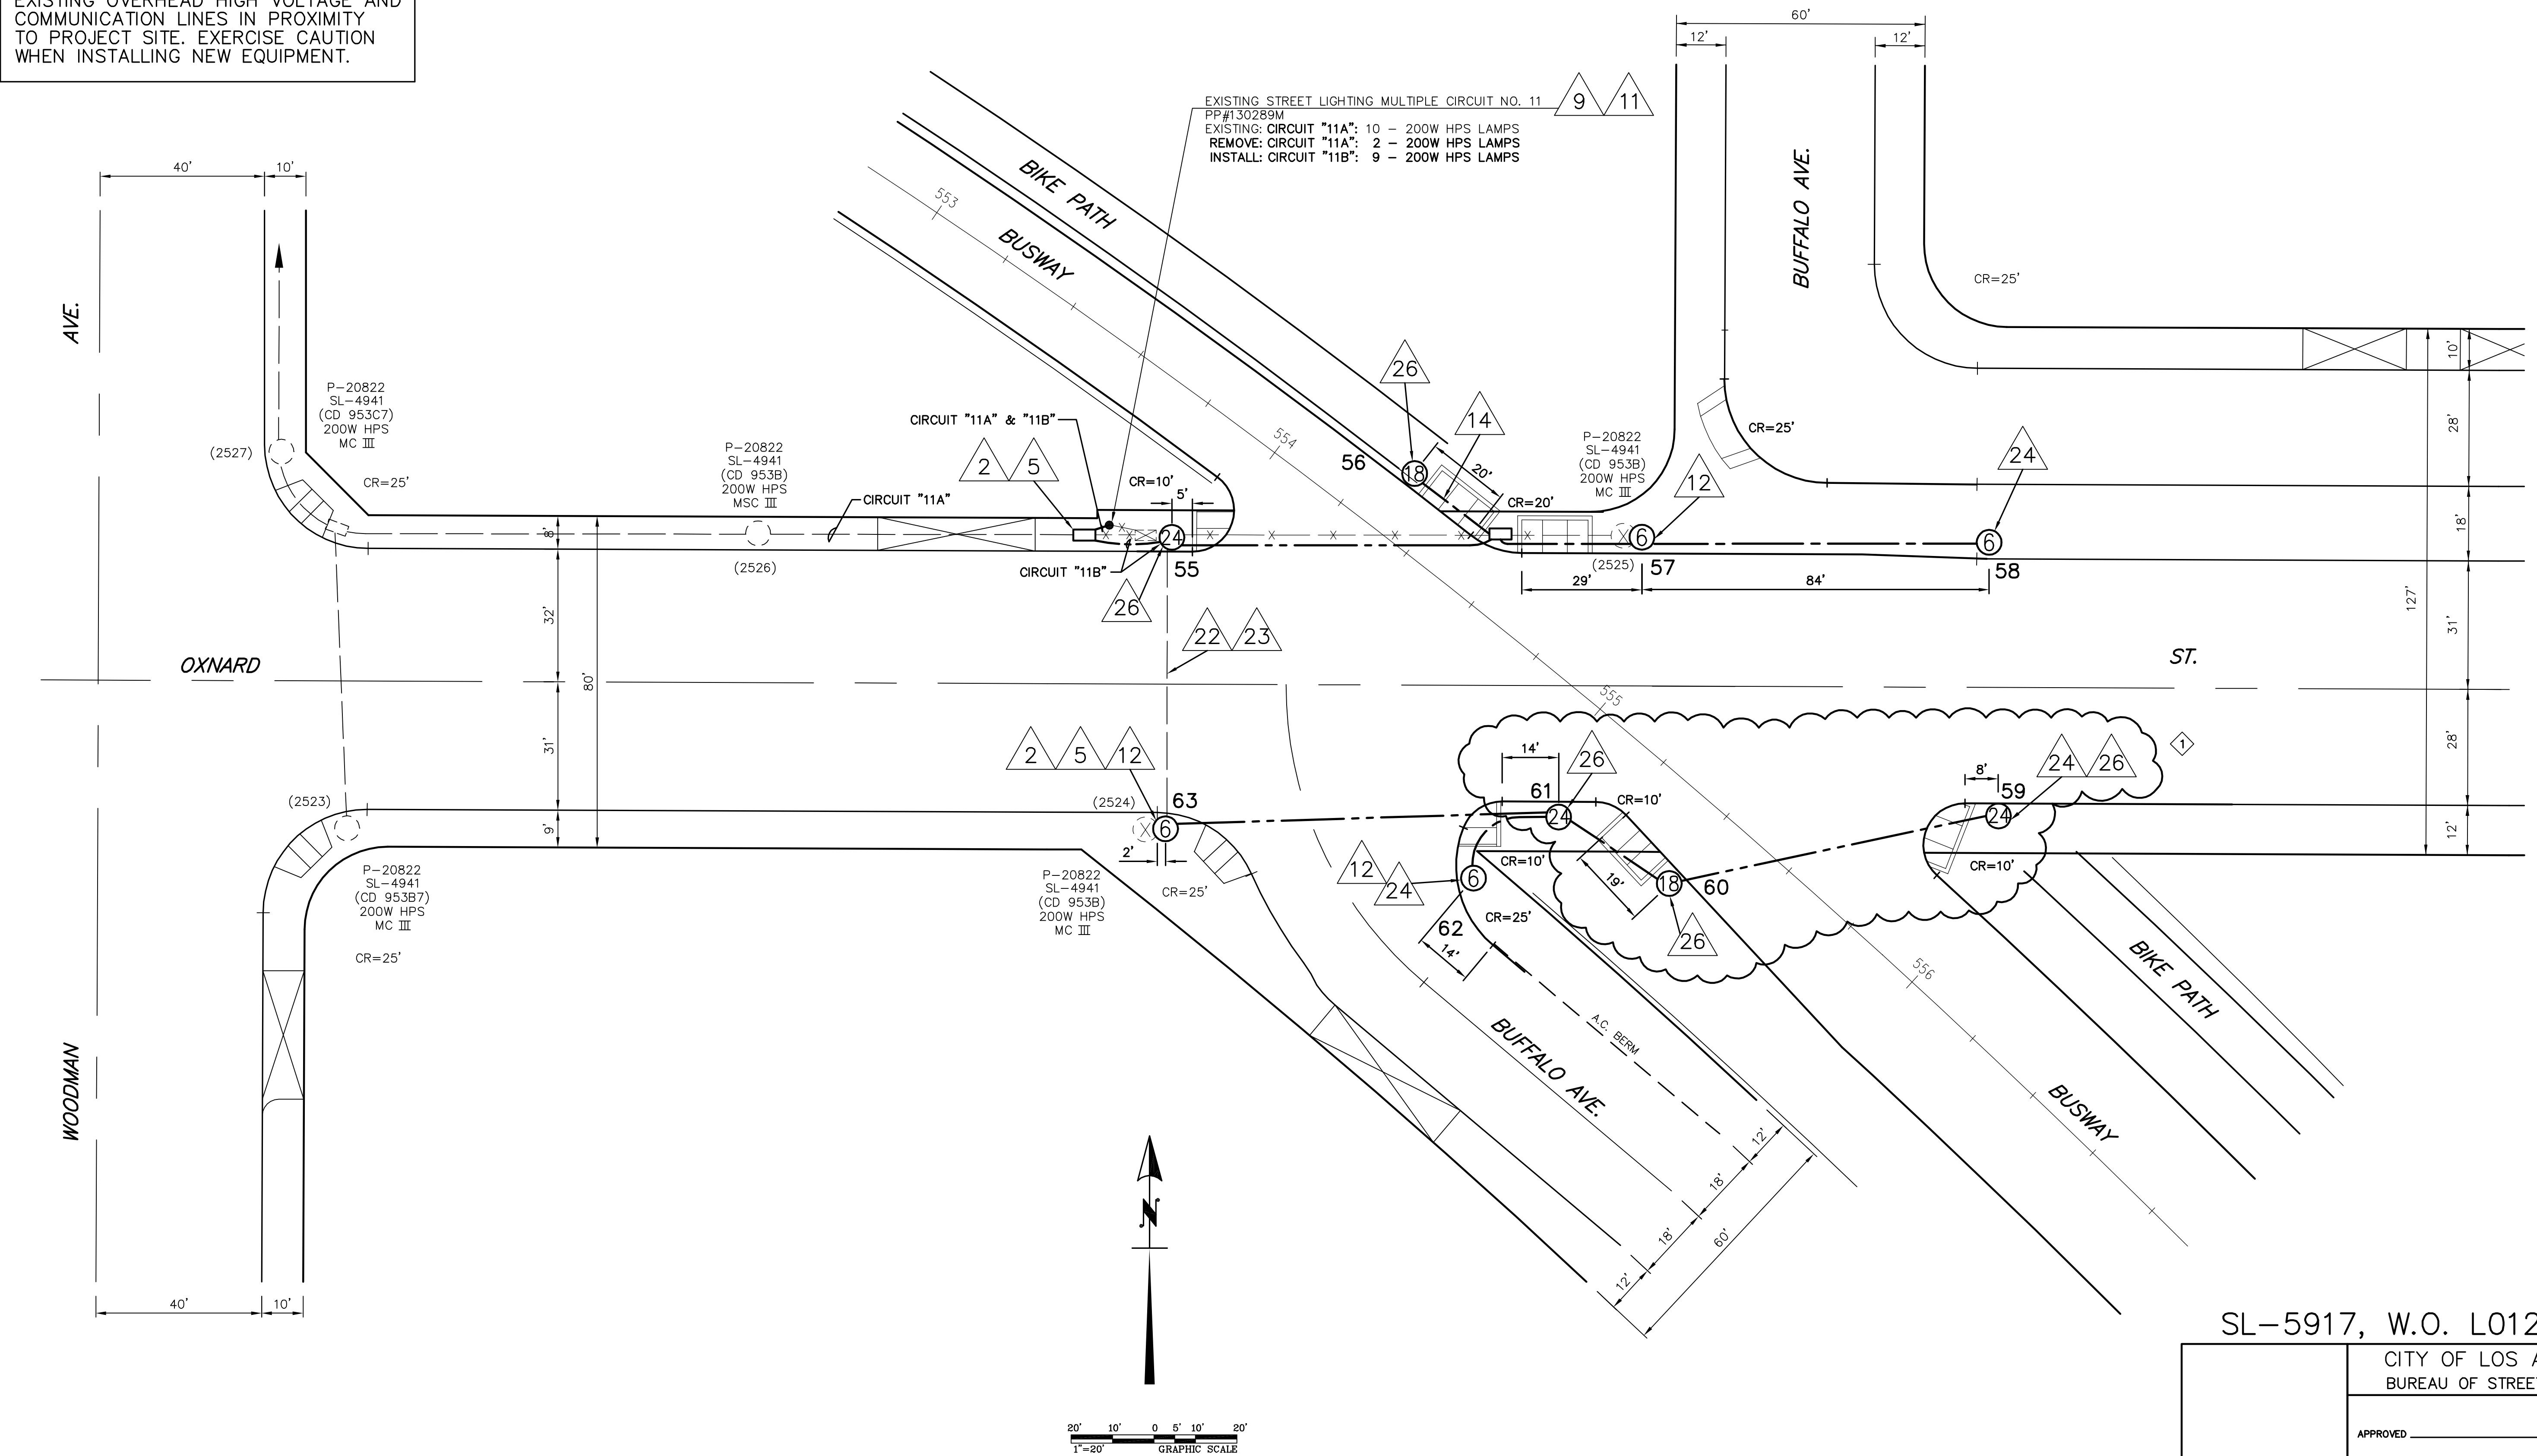

SL-5917, W.O. L0120115


CITY OF LOS ANGELES
BUREAU OF STREET LIGHTING

APPROVED _____ 20

BY _____
DIRECTOR BUREAU OF STREET LIGHTING

AS-BUILT RECORD DRAWING

LOS ANGELES COUNTY METROPOLITAN TRANSPORTATION AUTHORITY
SAN FERNANDO VALLEY EAST-WEST BRT PROJECT

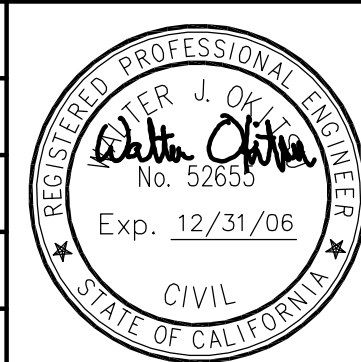

WASHINGTON



Katz, Okitsu & Associates
Traffic Engineers & Transportation Planners
1055 Corporate Center Drive, Suite 300
Monterey Park, California 91754-7642
Tel: (323) 260-4703 Fax: (323) 260-4705

NORTH HOLLYWOOD TO WARNER CENTER
GROUP 3 INTERSECTIONS
RESTORATION STREET LIGHTING
OXNARD ST./BUFFALO AVE.
& BUSWAY (SHEET 10 OF 10)

SEGMENT NO
C0675
DRAWING NO
G3SL-010
SCALE
1" = 20'
SHEET NO
1

REV	DATE	BY	APP	REG NO	EXPIRES	SEAL HOLDER	DESCRIPTION
1	02-10-06	AXK					AS-BUILT RECORD DRAWING
0	04-08-04	EKO	WJO	52655	12/31/06	WALTER J. OKITSU	ISSUED FOR CONSTRUCTION

DESIGNED BY
E. OKITSU
DRAWN BY
J. BERNAL
CHECKED BY
D. YEH
IN CHARGE
W. OKITSU
DATE
04-08-04