


SIGNAL STANDARD SCHEDULE					
No.	TYPE	FOUND. TYPE	PED. PUSH BUTN TYPE	PHASE	REMARKS
(X) 1	332 CAB.	F-332			ATSAT 2070 CONTROLLER IN 332 CABINET
(X) 2	CD954	F-2	6"	4	15' M.A.
(X) 3	1A	F-1			
(X) 4	CD954	F-2			CUSTOM 12' M.A.
(X) 5	CD954	F-2			15' M.A.
(X) 6	CD953C*	*			
(X) 7	CD953C*	*			
(X) 8	1A	F-1			
(X) 9	CD954	F-2			15' M.A.
(X) 10	1A	F-1			
(X) 11	CD954	F-2			CUSTOM 12' M.A.
(X) 12	16	F-2	6"	4	
(X) 13	CD953C*	*			

* For reference only; see Street Lighting sheet

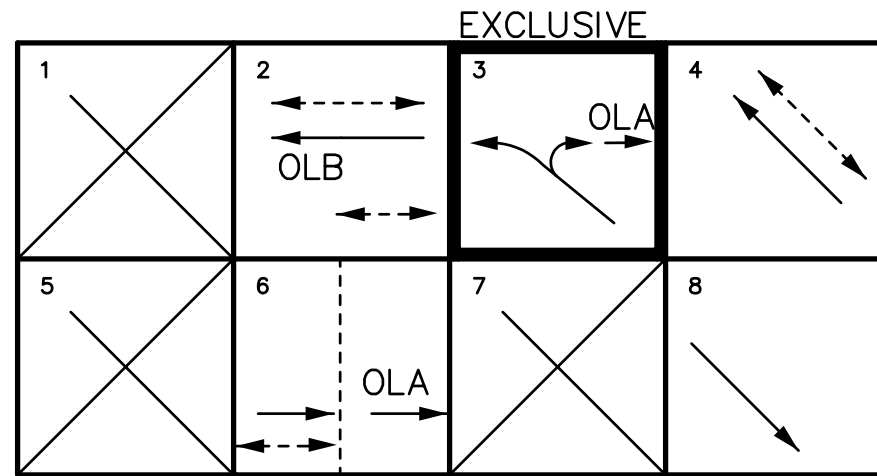

PROPOSED PHASE DIAGRAM
OLA & OLB ARE FOR SLOT CLEARANCE

NOTES:

- SEMI-ACTUATED OPERATION (ATSAC 2070 CONTROLLER WITH TRANSIT PRIORITY IN 332 CABINET)
 02 - N/S & S/S PED XINGS AT BUSWAY
 03 - BUFFALO AVE NB LT & RT
 04 - BUSWAY NB & E/S PED XING
 06 - OXNARD ST EB (APPROACH) & S/S PED XING AT BUFFALO AVE
 08 - BUSWAY SB
 OLA (#3 & #6) - OXNARD ST EB (DEPARTURE)
 OLB (#2) - OXNARD ST WB
 VICTORY CORRIDOR EAST ATSAC SYSTEM
 DIRECT WIRE (CABLE) INTERCONNECT


- INSTALL ATSAC 2070 CONTROLLER IN 332 CABINET. THE CONTRACTOR SHALL PROVIDE A COMPLETE FUNCTIONING CONTROLLER ASSEMBLY AND CABINET CONFORMING TO THE LATEST LADOT SPECIFICATION FOR 2070 CONTROLLER. CONTRACTOR TO DELIVER COMPLETELY ASSEMBLED CONTROLLER FOR TESTING TO THE DEPARTMENT OF TRANSPORTATION GENERAL SHOP, PIPER TECHNICAL CENTER, 555 RAMIREZ STREET THIRTY (30) DAYS PRIOR TO INSTALLATION. CONTRACTOR TO PICK UP AND INSTALL CONTROLLER ASSEMBLY ON F-332 FOUNDATION. INSTALL TRANSIT PRIORITY SENSOR UNITS IN THE NEW CABINET.

NOTES (CONT'D):


- INSTALL 2" CONDUIT INTO EXISTING SERVICE PULLBOX. INSTALL SERVICE PER LADOT STD. DWG. No. S-79.8. INSTALL 4 #6 SERVICE WIRES AND TWO-60 AMP FUSES IN AN IN-LINE WATERPROOF FUSEHOLDERS IN THE PULLBOX (ONE FOR BUFFALO AVE/OXNARD ST/BUSWAY AND ONE FOR BUSWAY/WOODMAN AVE). WORK ON ANY ELECTRICAL SERVICE EQUIPMENT TO BE DONE ONLY IN CONJUNCTION WITH THE DWP PERSONNEL. CONTACT DWP AT (213) 367-3003 SEVEN (7) WORKING DAYS PRIOR TO INSTALLATION OF SERVICE LINE.
- THIS LOOP CONNECTED TO CONTROLLER AT WOODMAN AVE/BUSWAY.
- JOIN CONDUIT AND EXTEND TO THE NEW PULL BOX. PROTECT EXISTING I/C & V.F. CABLES.
- THESE LOOPS CONNECTED TO CONTROLLER AT WOODMAN AVE/OXNARD ST.
- CONTRACTOR SHALL PROVIDE AND INSTALL LARGE STREET NAME SIGNS PER LADOT STD. DWGS. No. S-457.0 & S-486.0.
- MOUNT PV HEAD AT 14' HEIGHT.
- INSTALL STRIPING, SIGNS AND PAVEMENT MARKINGS PER LADOT DWG. No. A-3935 FOR THIS PROJECT. REMOVE ALL CONFLICTING STRIPING AND PAVEMENT MARKINGS.
- SEE STREET LIGHTING SHEET FOR WORK ON STREET LIGHTING FACILITIES.
- INSTALL TRANSIT PRIORITY LOOPS PER LADOT STD. DWG. No. S-70.1F AND VEHICLE LOOPS PER STD. DWG. No. S-70.1A.
- ALL NEW VEHICLE AND PEDESTRIAN TRAFFIC SIGNALS SHALL BE LED MODULES, PER LADOT SPECIFICATION 92-088-03 (LATEST EDITION).

ESTIMATED MATERIAL FURNISHED BY LADOT	
UNITS	MATERIAL

ESTIMATED SALVAGE MATERIAL TO BE RETURNED TO LADOT	
UNITS	MATERIAL

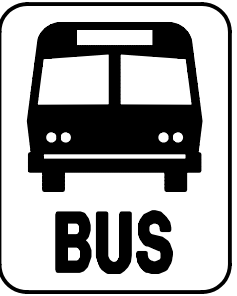

LED SIGN
SIGN "A"
Not to Scale
LED SIGN SHALL BE PER
LADOT Std. Dwg. No. S-58.15

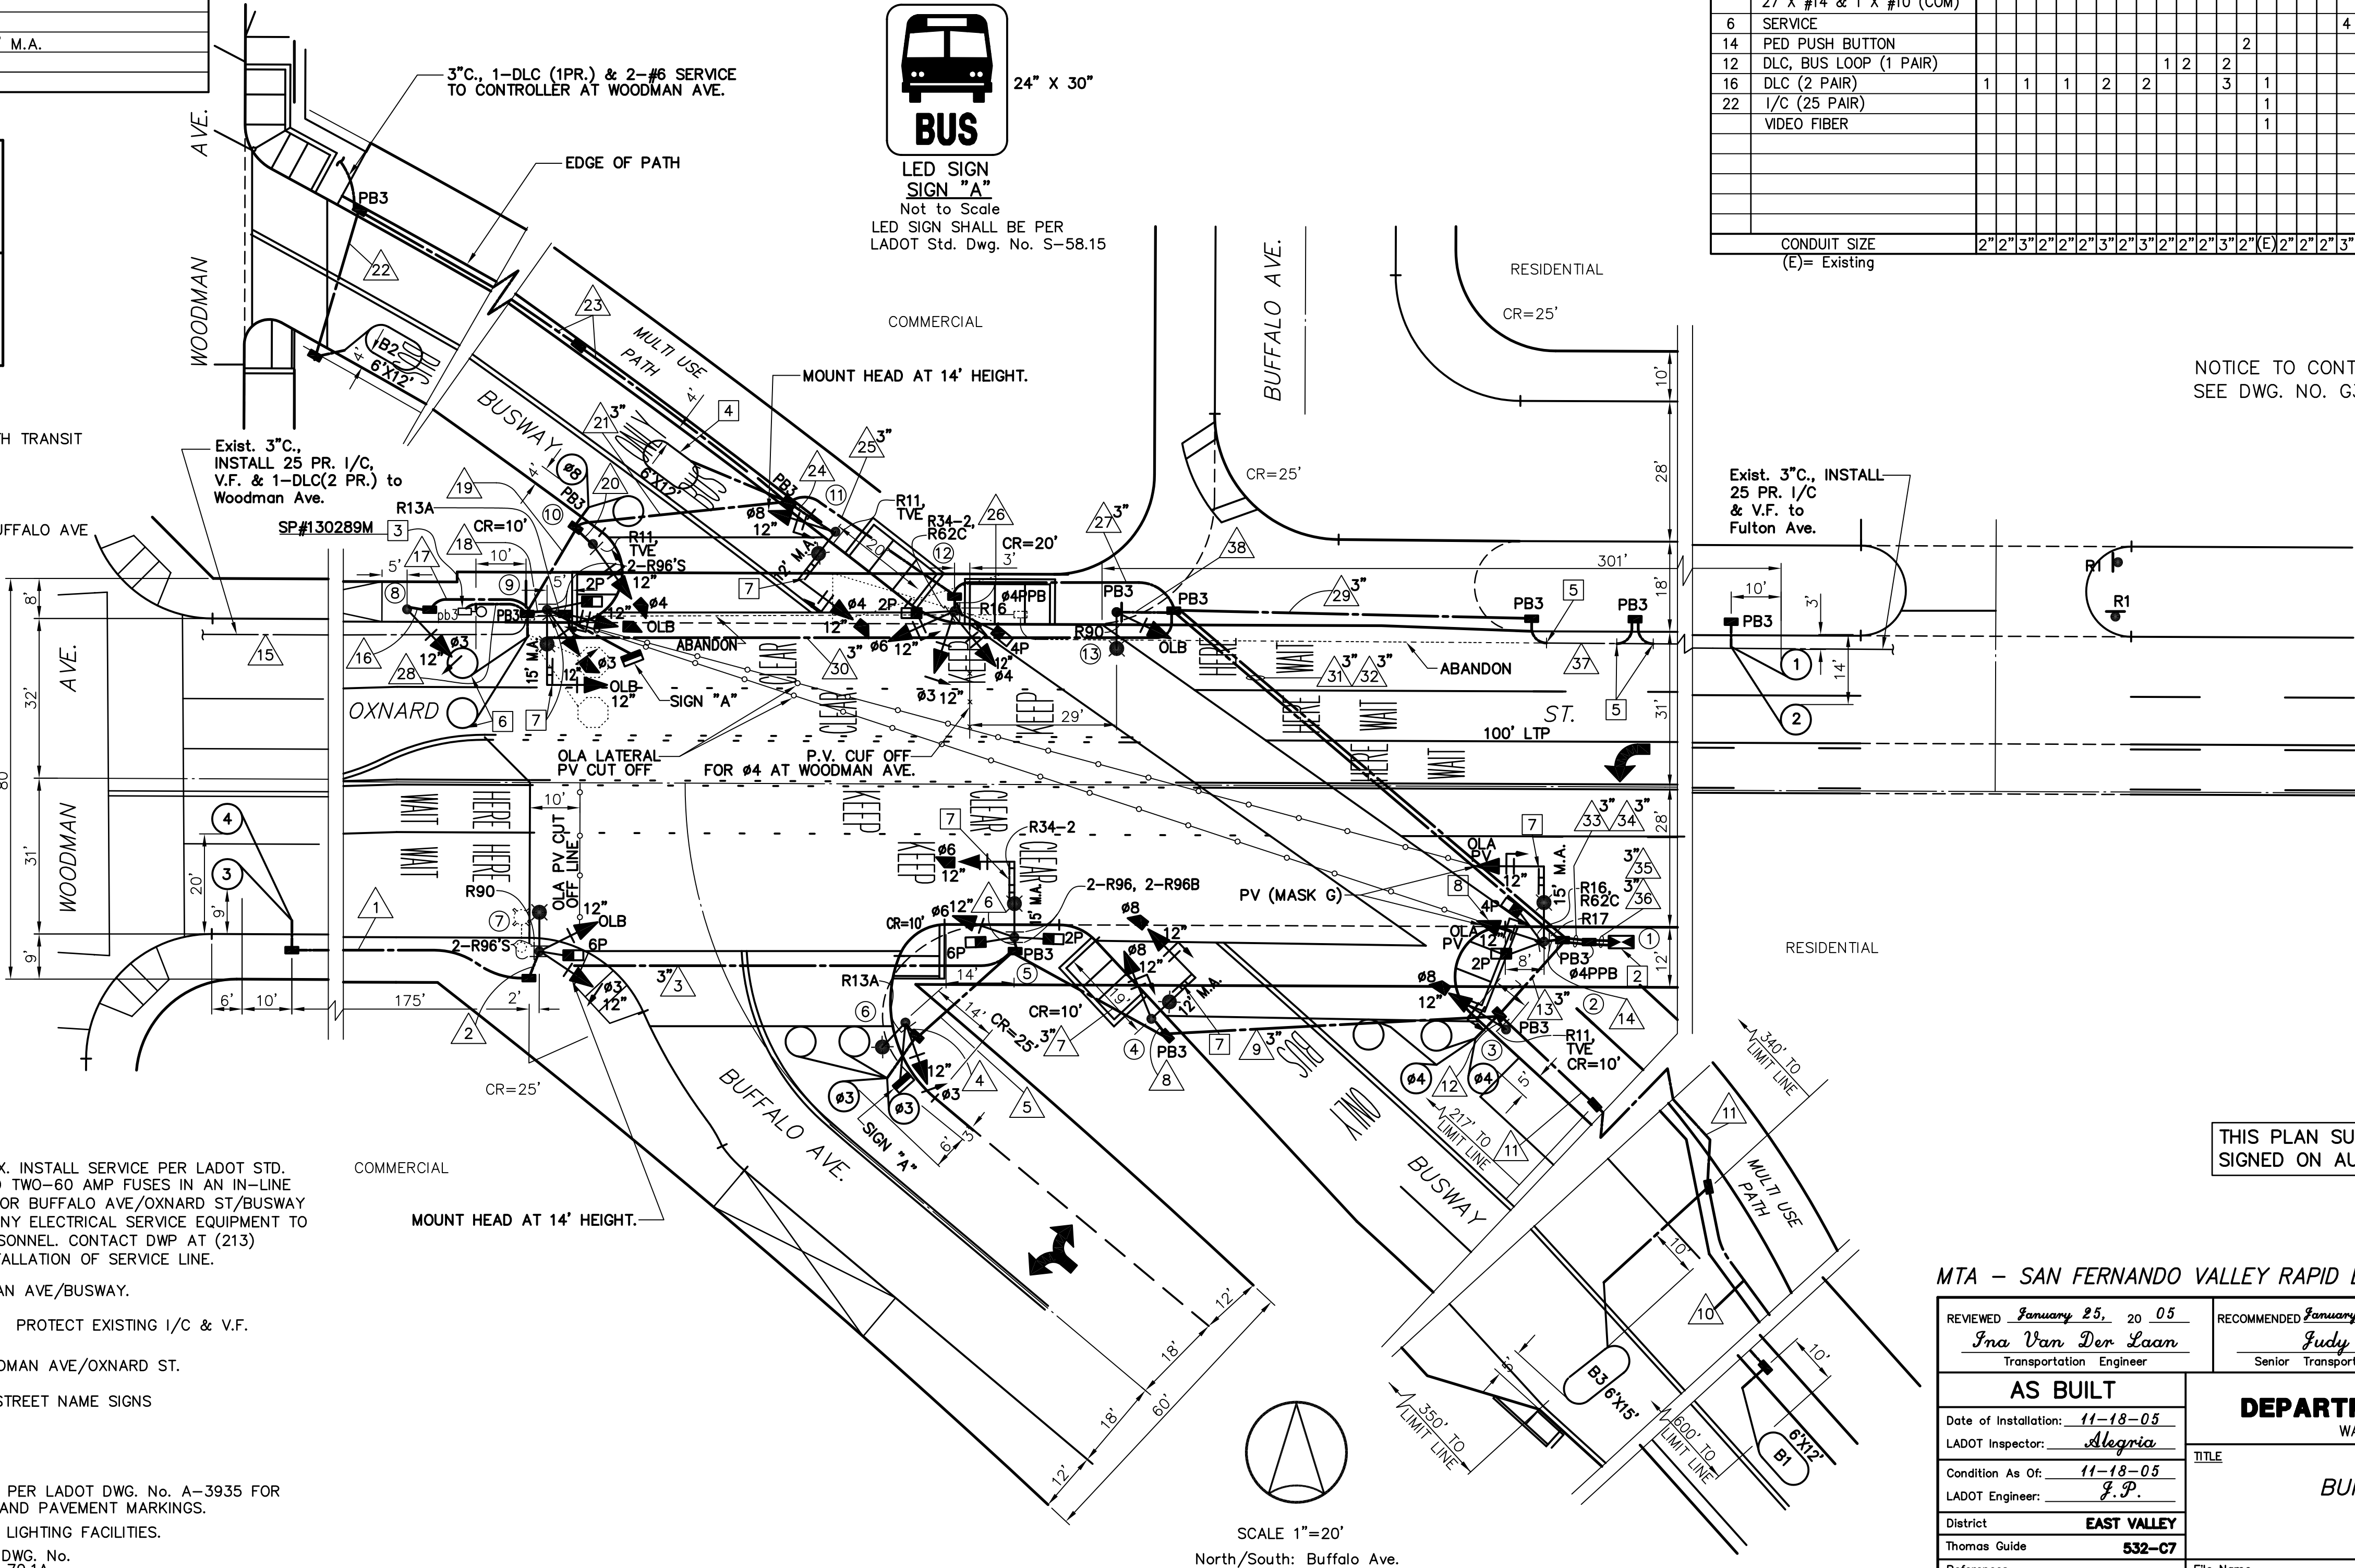

SCALE 1"=20'
North/South: Buffalo Ave.

NOTICE TO CONTRACTOR
SEE DWG. NO. G3TS-001

THIS PLAN SUPERSEDES PLAN
SIGNED ON AUGUST 19, 2004

CONDUCTOR SCHEDULE	
SIZE	CABLE / WIRE
5	CONDUCTOR CABLE
5	5 X #14
9	CONDUCTOR CABLE
8	8 X #14 & 1 X #12 (COM)
12	CONDUCTOR CABLE
11	11 X #14 & 1 X #12 (COM)
28	CONDUCTOR CABLE
27	27 X #14 & 1 X #10 (COM)
6	SERVICE
14	PED. PUSH BUTTON
12	DLC, BUS LOOP (1 PAIR)
16	DLC (2 PAIR)
22	I/C (25 PAIR)
	VIDEO FIBER
CONDUIT SIZE	
(E)= Existing	


MTA - SAN FERNANDO VALLEY RAPID BUS SYSTEM (NEW SIGNAL)

REVIEWED <i>January 25, 20 05</i> <i>Ina Van Der Laan</i> Transportation Engineer	RECOMMENDED <i>January 25, 20 05</i> <i>Judy Wong</i> Senior Transportation Engineer	ACCEPTED <i>January 25, 20 05</i> <i>Thomas L. Jones</i> Principal Transportation Engineer
AS BUILT Date of Installation: <i>11-18-05</i> LADOT Inspector: <i>Alegria</i> Condition As Of: <i>11-18-05</i> LADOT Engineer: <i>J.P.</i> District: EAST VALLEY Thomas Guide: 532-C7		
CITY OF LOS ANGELES DEPARTMENT OF TRANSPORTATION WAYNE K. TANDA, GENERAL MANAGER		
TITLE BUFFALO AVE., OXNARD ST. AND BUSWAY		
References	File Name 32221-P1.DWG	Intersection No. 32221
	Project No. 74720	
NOTICE: IF PLAN HAS NOT BEEN IMPLEMENTED WITHIN TWO (2) YEARS OF THE ACCEPTANCE DATE, IT MUST BE RESUBMITTED TO LADOT SIGNAL DESIGN SECTION FOR REVIEW AND APPROVAL.		



REV	DATE	BY	APP	REG NO	EXPIRES	SEAL HOLDER	DESCRIPTION
3	01-27-06	JFB					AS-BUILT RECORD DRAWING
2	01-17-05	JFB	WJO	52655	12/31/06	WALTER J. OKITSU	SERVICE POLE NUMBER CHANGE - IFC
1	08-09-04	JFB	WJO	52655	12/31/06	WALTER J. OKITSU	SERVICE LOCATION CHANGE - IFC
0	04-08-04	GXF	WJO	52655	12/31/06	WALTER J. OKITSU	ISSUED FOR CONSTRUCTION

DESIGNED BY G. FIGUEROA
DRAWN BY J. BERNAL
CHECKED BY D. YEH
IN CHARGE W. OKITSU
DATE 04-08-04

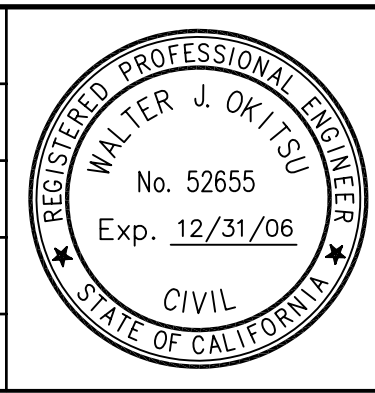

LOS ANGELES COUNTY METROPOLITAN TRANSPORTATION AUTHORITY
SAN FERNANDO VALLEY EAST-WEST BRT PROJECT

WASHINGTON

SHIMMICK OYASHI, JV

Katz, Okitsu & Associates
 Traffic Engineers & Transportation Planners
 1055 Corporate Center Drive, Suite 300
 Monterey Park, California 91754-7642
 Tel: (323) 260-4703 Fax: (323) 260-4705

NORTH HOLLYWOOD TO WARNER CENTER
GROUP 3 INTERSECTIONS
NEW TRAFFIC SIGNAL
BUFFALO AVE., OXNARD ST. AND BUSWAY

SEGMENT NO C-0675	REV 3
DRAWING NO G3TS-007	
SCALE 1" = 20'	
SHEET NO	