



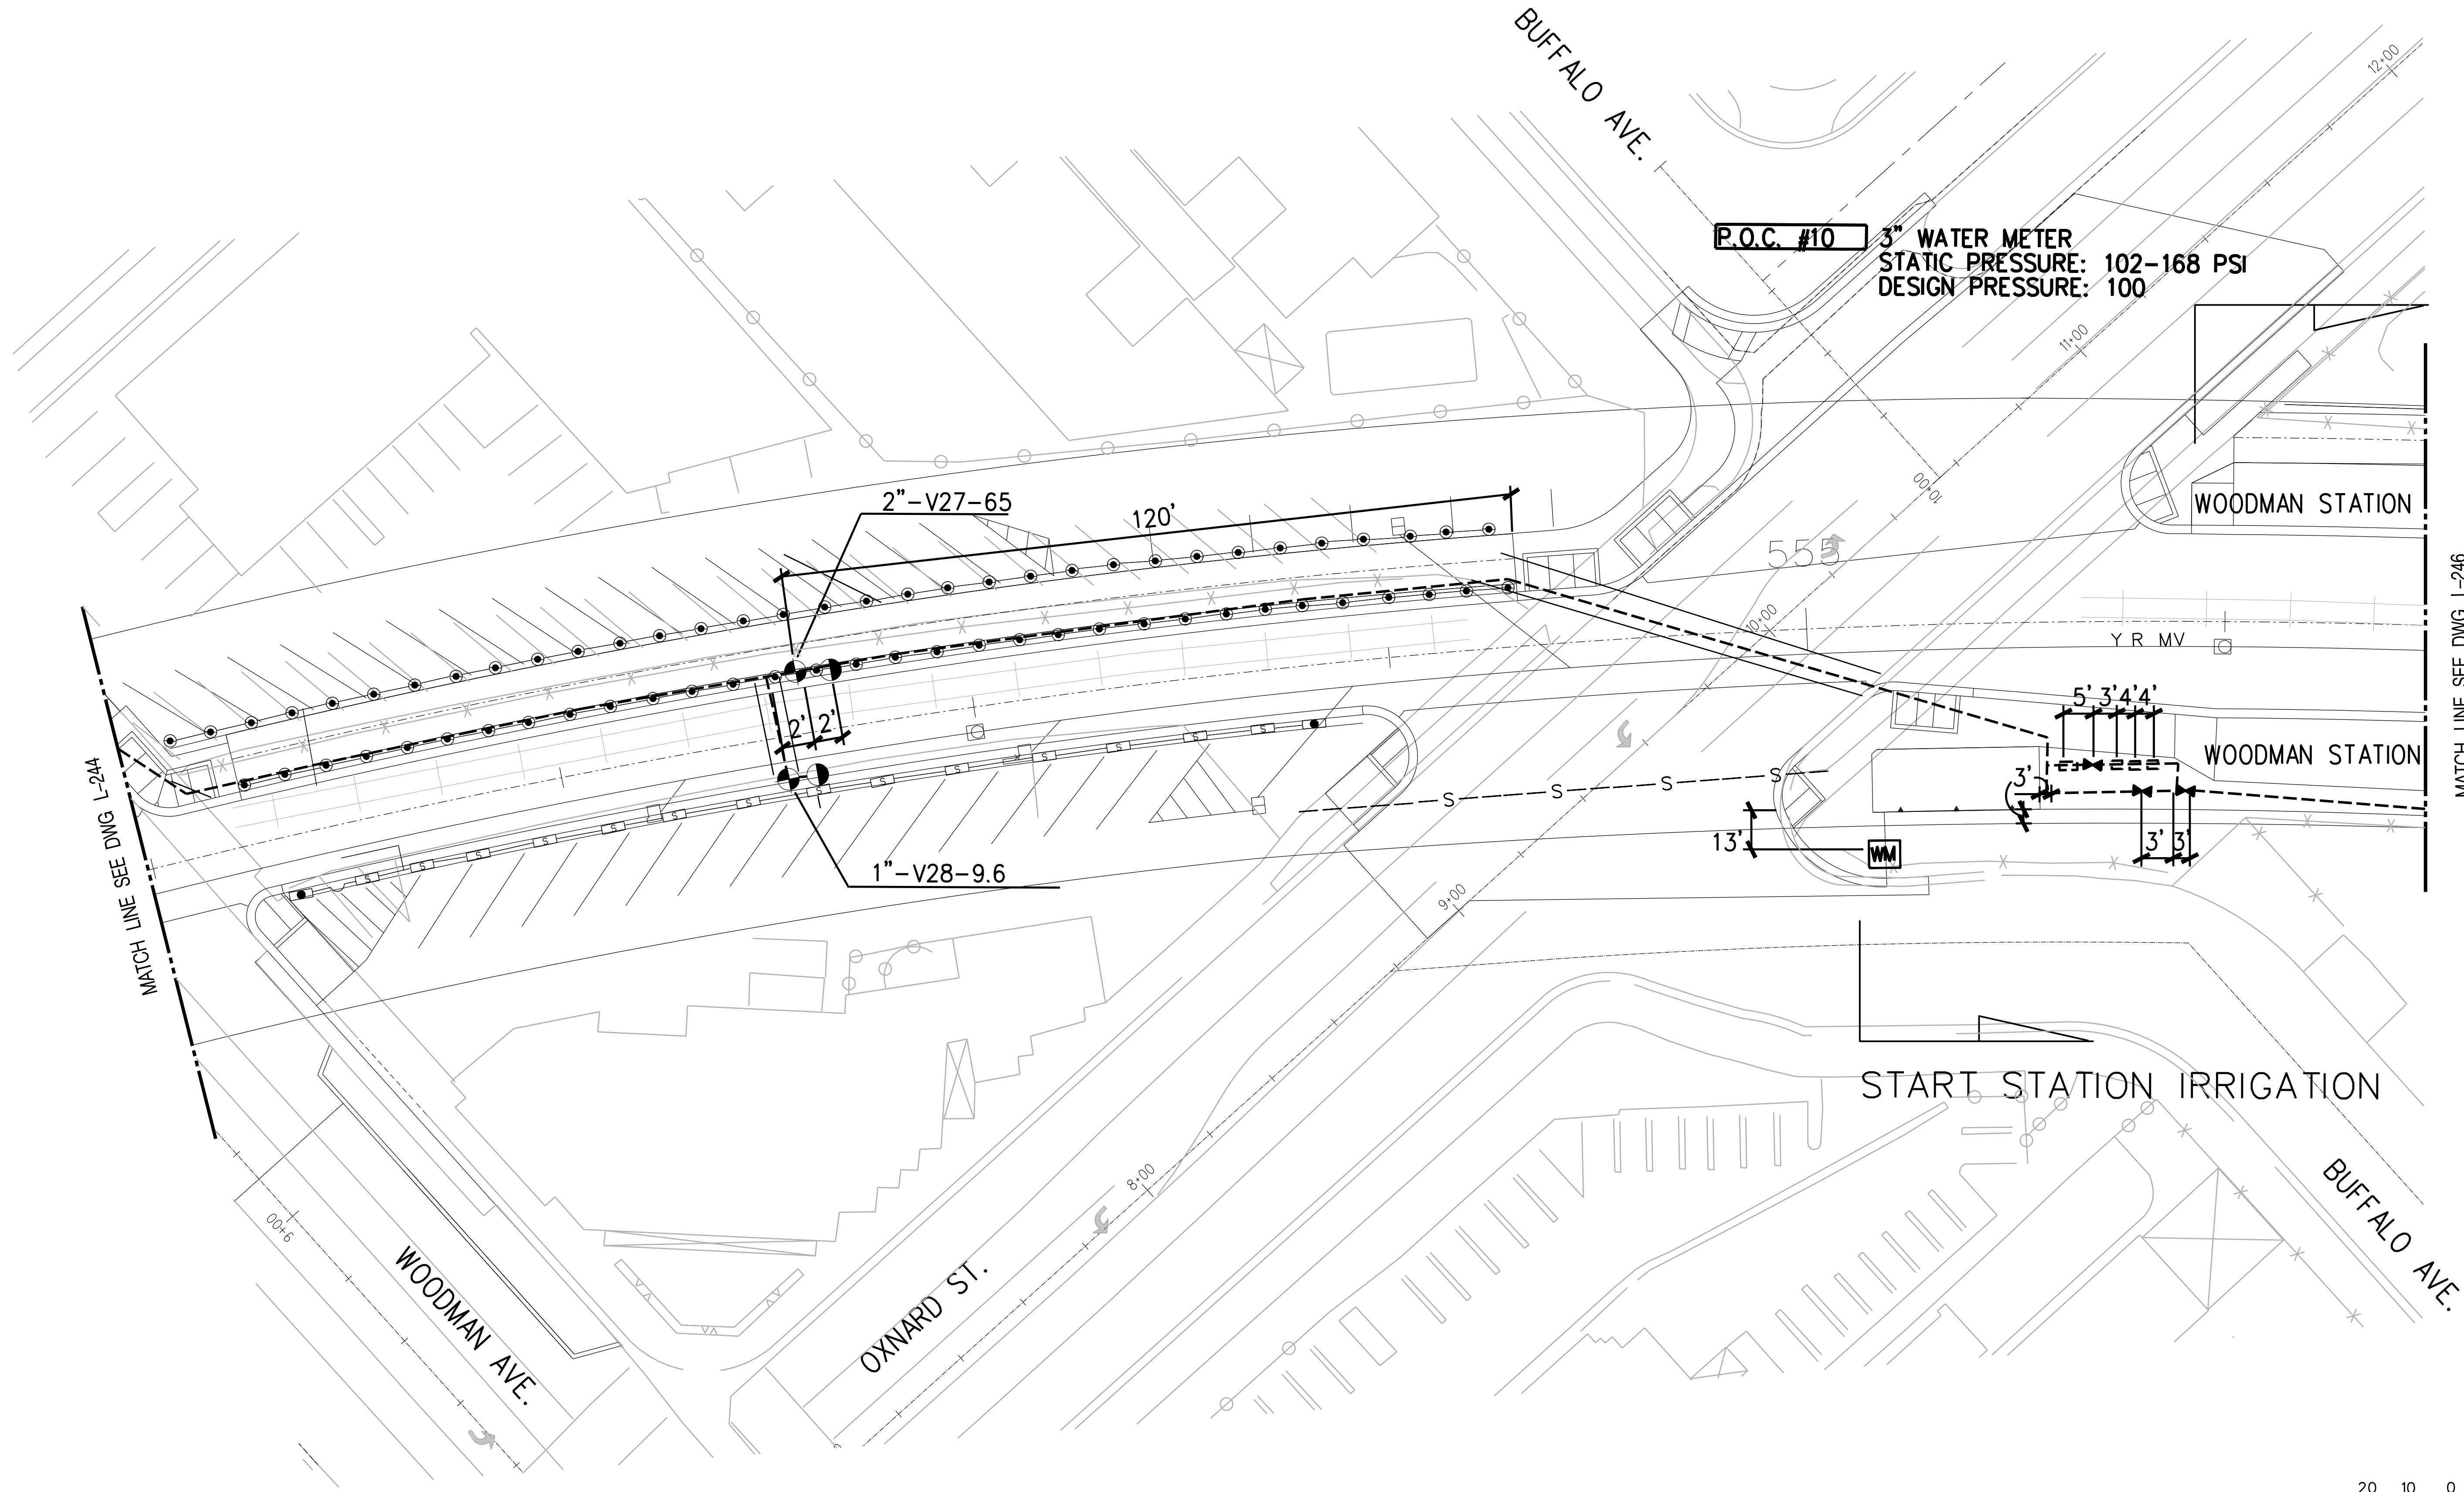


MATCH LINE SEE DWG L-246

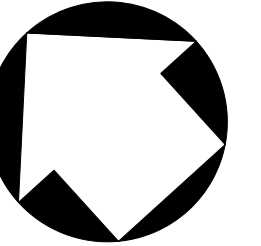

ISSUE FOR CONSTRUCTION

REV	DATE	BY	APP	REG NO	EXPIRES	SEAL HOLDER	DESCRIPTION
	3/12/08						AS-BUILTS
0	5/23/05						ISSUE FOR CONSTRUCTION

DESIGNED BY
MG
DRAWN BY
T&P
CHECKED BY
KLS
IN CHARGE
DT
DATE
5/23/2005

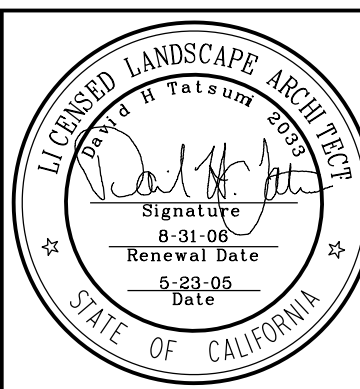

LOS ANGELES COUNTY METROPOLITAN TRANSPORTATION AUTHORITY
SAN FERNANDO VALLEY EAST-WEST BRT PROJECT

TATSUMI AND PARTNERS, INC.
LANDSCAPE ARCHITECTURE • PLANNING • DESIGN
5 CORPORATE PARK, SUITE 200
BURNING WOOD, CA 91306-5866
949/250-9890 FAX 949/250-9891

SUBMITTED BY: DAVID H. TATSUMI DATE:

NORTH HOLLYWOOD TO WARNER CENTER
IRRIGATION PLAN
STA 551+00 TO STA 556+50
SHEET 103 OF 136

CONTRACT NO	C0675
DRAWING NO	L- 245
SCALE	1"=20'
SHEET NO	

Mike. G