
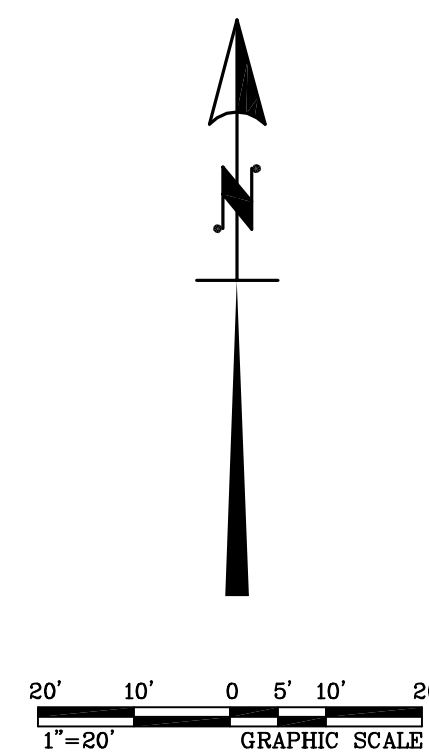


EXISTING OVERHEAD HIGH VOLTAGE AND COMMUNICATION LINES IN PROXIMITY TO PROJECT SITE. EXERCISE CAUTION WHEN INSTALLING NEW EQUIPMENT.

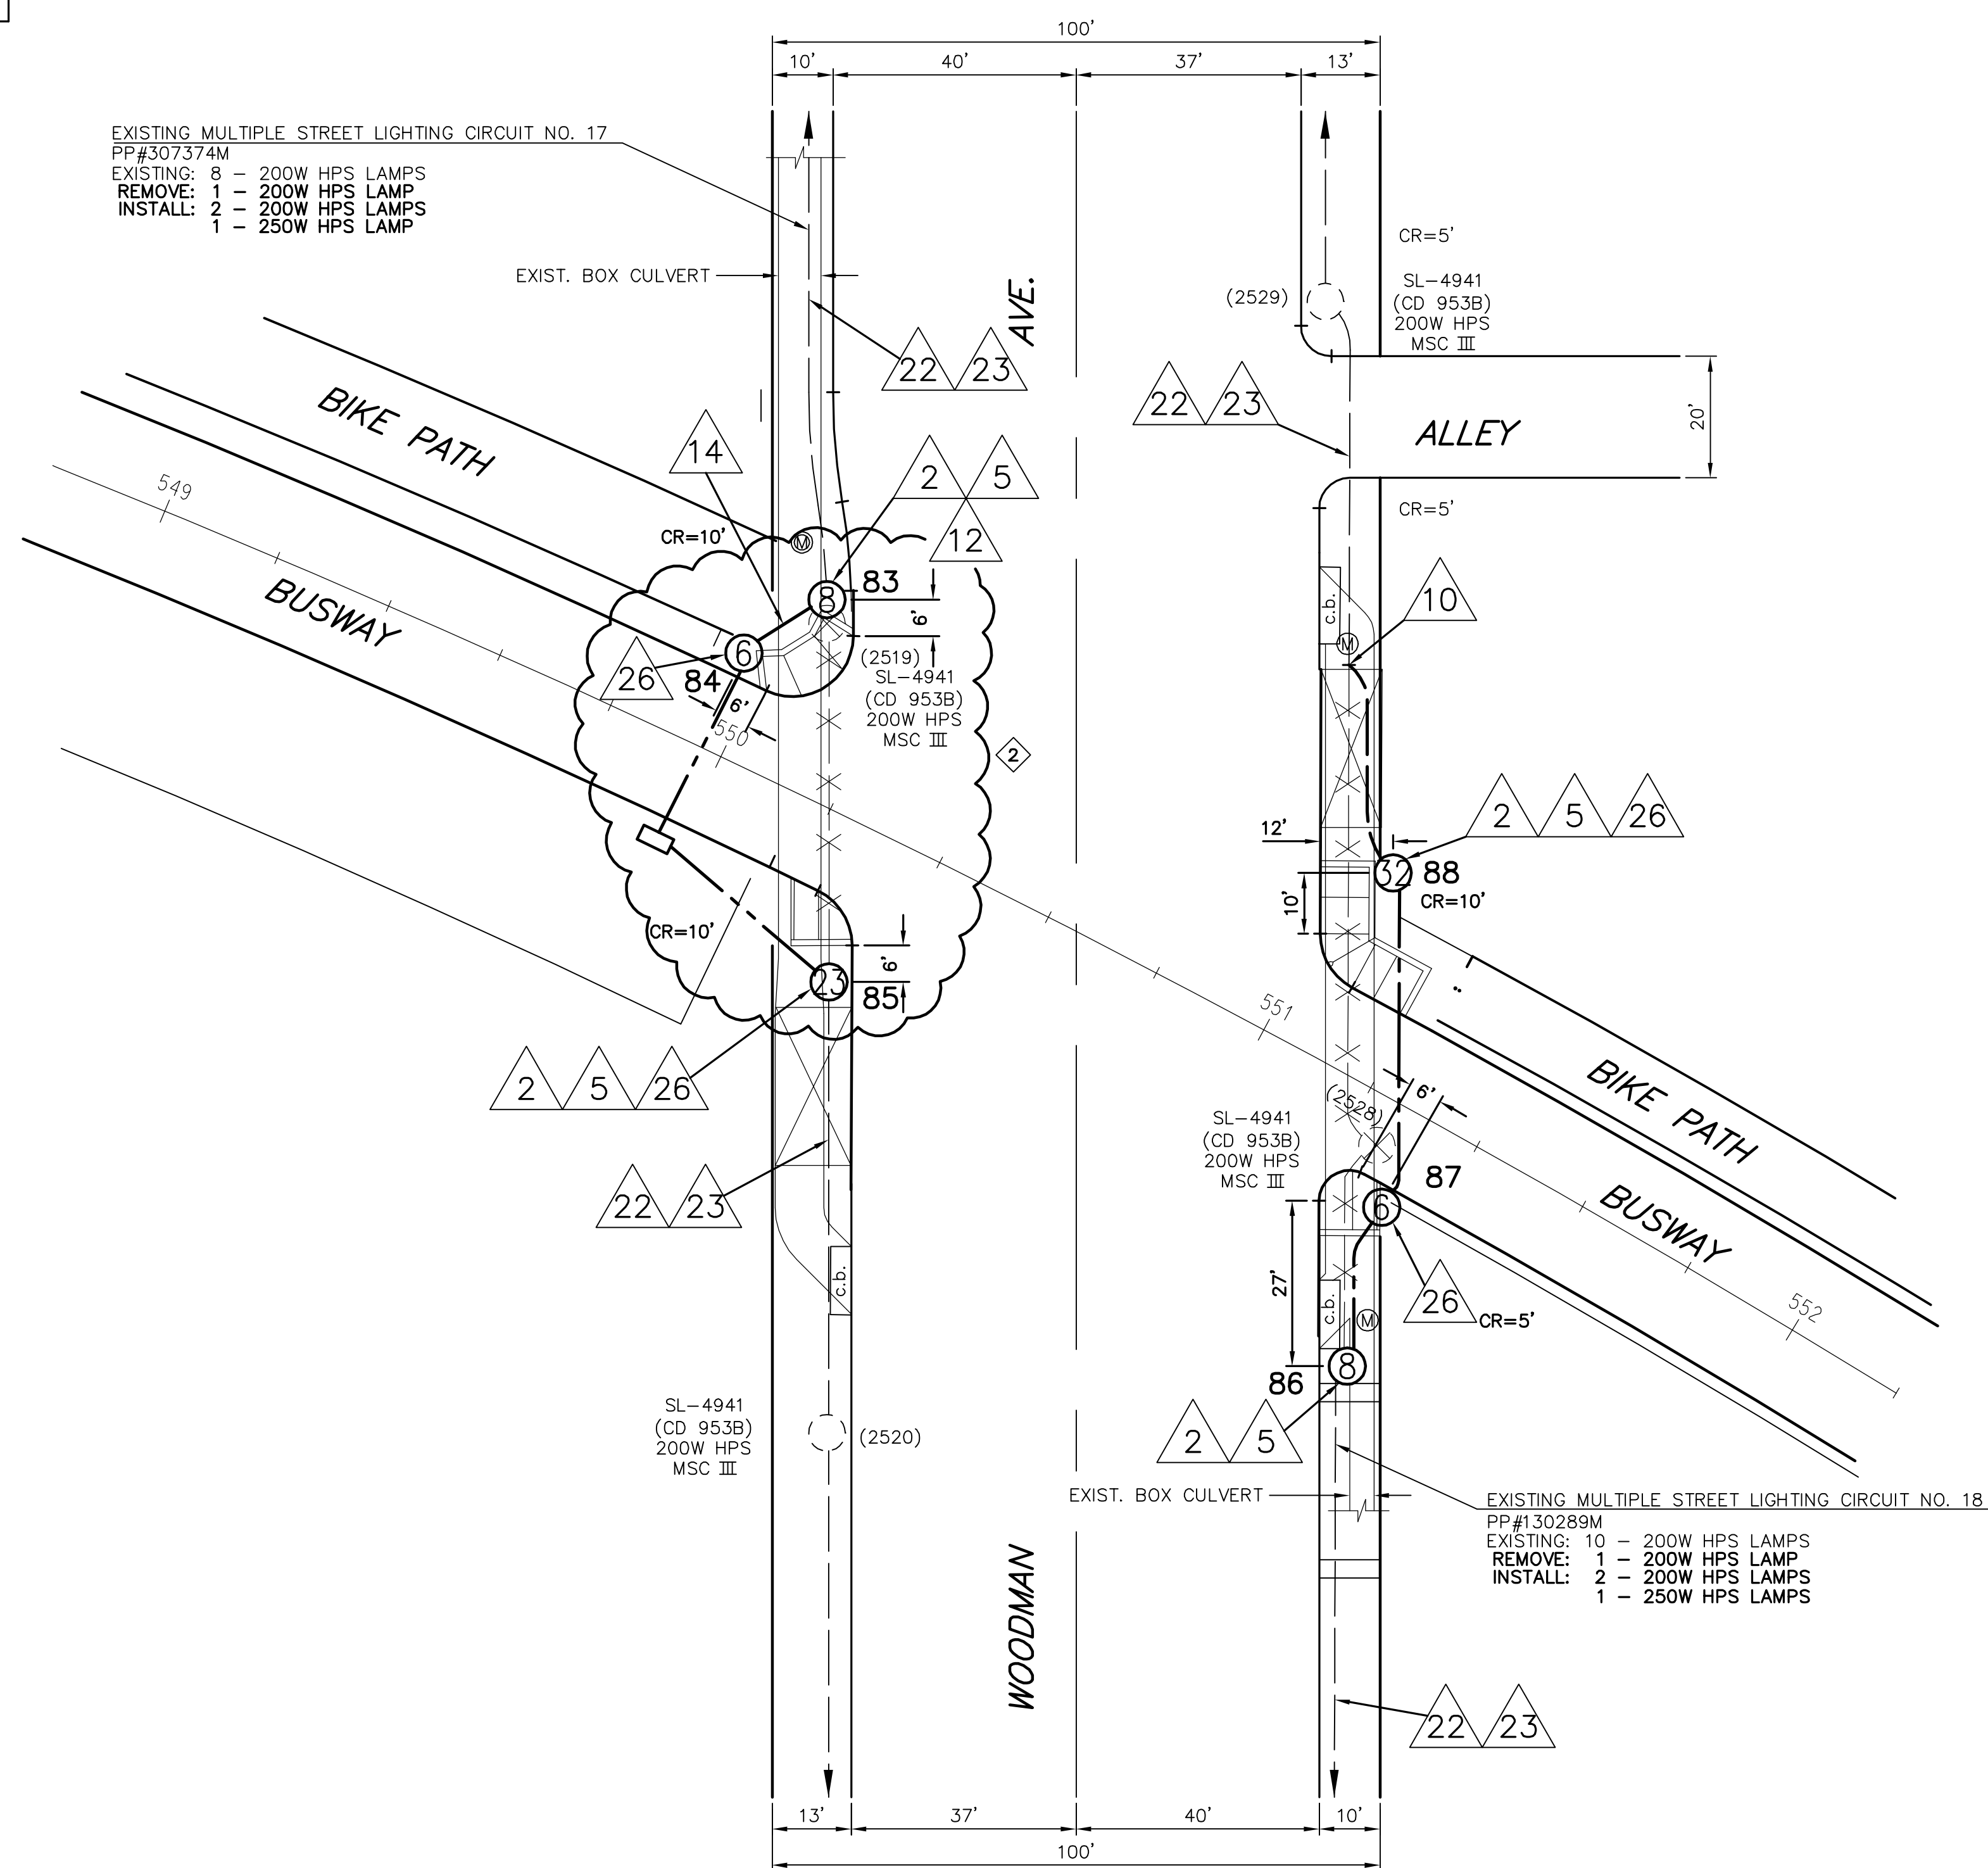

SL-5896, W.O. L0120115

CITY OF LOS ANGELES
BUREAU OF STREET LIGHTING

APPROVED _____ 20

BY _____
DIRECTOR BUREAU OF STREET LIGHTING


AS-BUILT RECORD DRAWING

LOS ANGELES COUNTY METROPOLITAN TRANSPORTATION AUTHORITY
SAN FERNANDO VALLEY EAST-WEST BRT PROJECT

NORTH HOLLYWOOD TO WARNER CENTER
GROUP 2 INTERSECTIONS
RESTORATION STREET LIGHTING
WOODMAN AVE. & BUSWAY
(SHEET 12 OF 12)

REV	DATE	BY	APP	REG NO	EXPIRES	SEAL HOLDER	DESCRIPTION
2	02-10-06	AXK					AS-BUILT RECORD DRAWING
1	03-17-04	EKO	WJO	52655	12/31/06	WALTER J. OKITSU	CHANGE PER SIGNAL PLAN
0	02-19-04	EKO	WJO	52655	12/31/06	WALTER J. OKITSU	ISSUED FOR CONSTRUCTION

DESIGNED BY
E. OKITSU
DRAWN BY
J. BERNAL
CHECKED BY
D. YEH
IN CHARGE
W. OKITSU
DATE
02-19-04

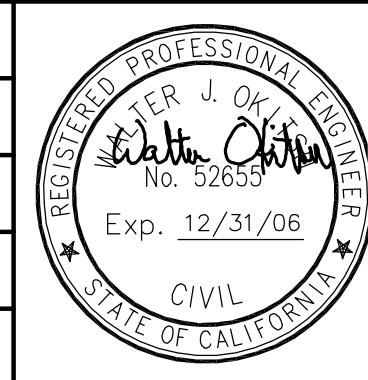

WASHINGTON



Katz, Okitsu & Associates
Traffic Engineers & Transportation Planners
1055 Corporate Center Drive, Suite 300
Monterey Park, California 91754-7642
Tel: (323) 260-4703 Fax: (323) 260-4705

SEGMENT NO	C0675
DRAWING NO	G2SL-012
SCALE	1" = 20'
SHEET NO	2