


SIGNAL STANDARD SCHEDULE					
No.	TYPE	FOUND. TYPE	PED. PUSH BUTN TYPE	PHASE	REMARKS
1	332 CAB.	F-332	*	4	ATSAC 2070 CONTROLLER IN 332 CAB.
2	CD953C*				
3	19-3-80	CIDH**			30' M.A., F=15'
4	1	F-1			
5	CD954	F-2			CUSTOM 12' M.A.
6	7	***	PTM	4	
7	CD954	F-2			20' M.A.
8	1	F-1			
9	CD954	F-2			CUSTOM 12' M.A.


* For reference only, see Street Lighting sheet
 ** CIDH PILE Foundation as per Caltrans Latest Standard Plans.
 *** See Alternate F-7 Foundation per Detail "A"

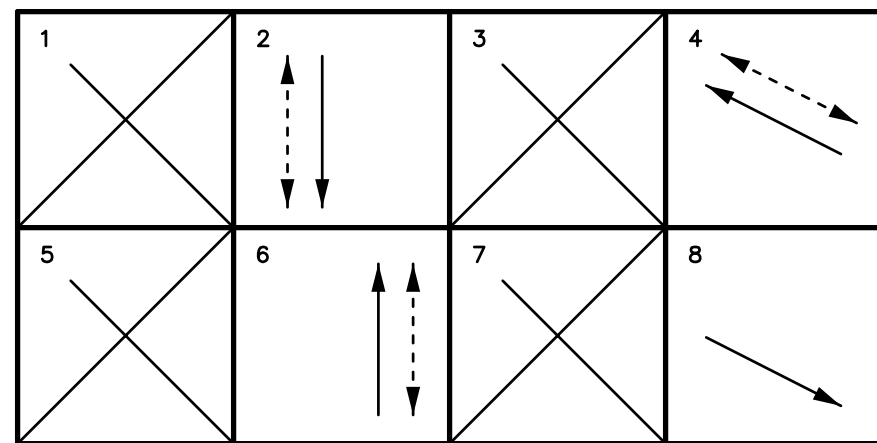

PROPOSED PHASE DIAGRAM

NOTES:

- SEMI-ACTUATED OPERATION (ATSAC 2070 CONTROLLER WITH TRANSIT PRIORITY IN 332 CABINET)
 #2 - WOODMAN AVE. SB & W/S PED XING
 #4 - BUSWAY WB & N/S PED XING
 #6 - WOODMAN AVE. NB & E/S PED XING
 #8 - BUSWAY EB
 VICTORY CORRIDOR EAST ATSAC SYSTEM
 DIRECT WIRE (CABLE) INTERCONNECT
- INSTALL ATSAC 2070 CONTROLLER IN 332 CABINET. THE CONTRACTOR SHALL PROVIDE A COMPLETE FUNCTIONING CONTROLLER ASSEMBLY AND CABINET CONFORMING TO THE LATEST LADOT SPECIFICATION FOR 2070 CONTROLLER. CONTRACTOR TO DELIVER COMPLETELY ASSEMBLED CONTROLLER FOR TESTING TO THE DEPARTMENT OF TRANSPORTATION GENERAL SHOP, PIPER TECHNICAL CENTER, 555 RAMIREZ STREET THIRTY (30) DAYS PRIOR TO INSTALLATION. CONTRACTOR TO PICK UP AND INSTALL CONTROLLER ASSEMBLY ON F-332 FOUNDATION.
- ~~CONTRACTOR SHALL PROVIDE AND INSTALL LARGE STREET NAME SIGNS PER LADOT STD. DWGS. No. S-457.0 & S-486.0.~~
- CONTRACTOR SHALL PROVIDE AND INSTALL LARGE STREET NAME SIGNS PER LADOT STD. DWGS. No. S-457.0 & S-486.0.
- JOIN CONDUIT AND EXTEND TO THE NEW PULL BOX.
- THESE LOOPS CONNECTED TO CONTROLLER AT OXNARD ST./WOODMAN AVE.
- THESE LOOPS CONNECTED TO CONTROLLER AT BUSWAY/OXNARD ST.
- INSTALL STRIPING, SIGNS AND PAVEMENT MARKINGS PER LADOT DWG. No. A-3928 FOR THIS PROJECT. REMOVE ALL CONFLICTING STRIPING AND PAVEMENT MARKINGS.
- SEE STREET LIGHTING SHEET FOR WORK ON STREET LIGHTING FACILITIES.
- INSTALL TRANSIT PRIORITY LOOPS PER LADOT STD. DWG. No. S-70.1F AND VEHICLE LOOPS PER STD. DWG. No. S-70.1A.
- ALL NEW VEHICLE AND PEDESTRIAN TRAFFIC SIGNALS SHALL BE LED MODULES, PER LADOT SPECIFICATION 92-088-03 (LATEST EDITION).

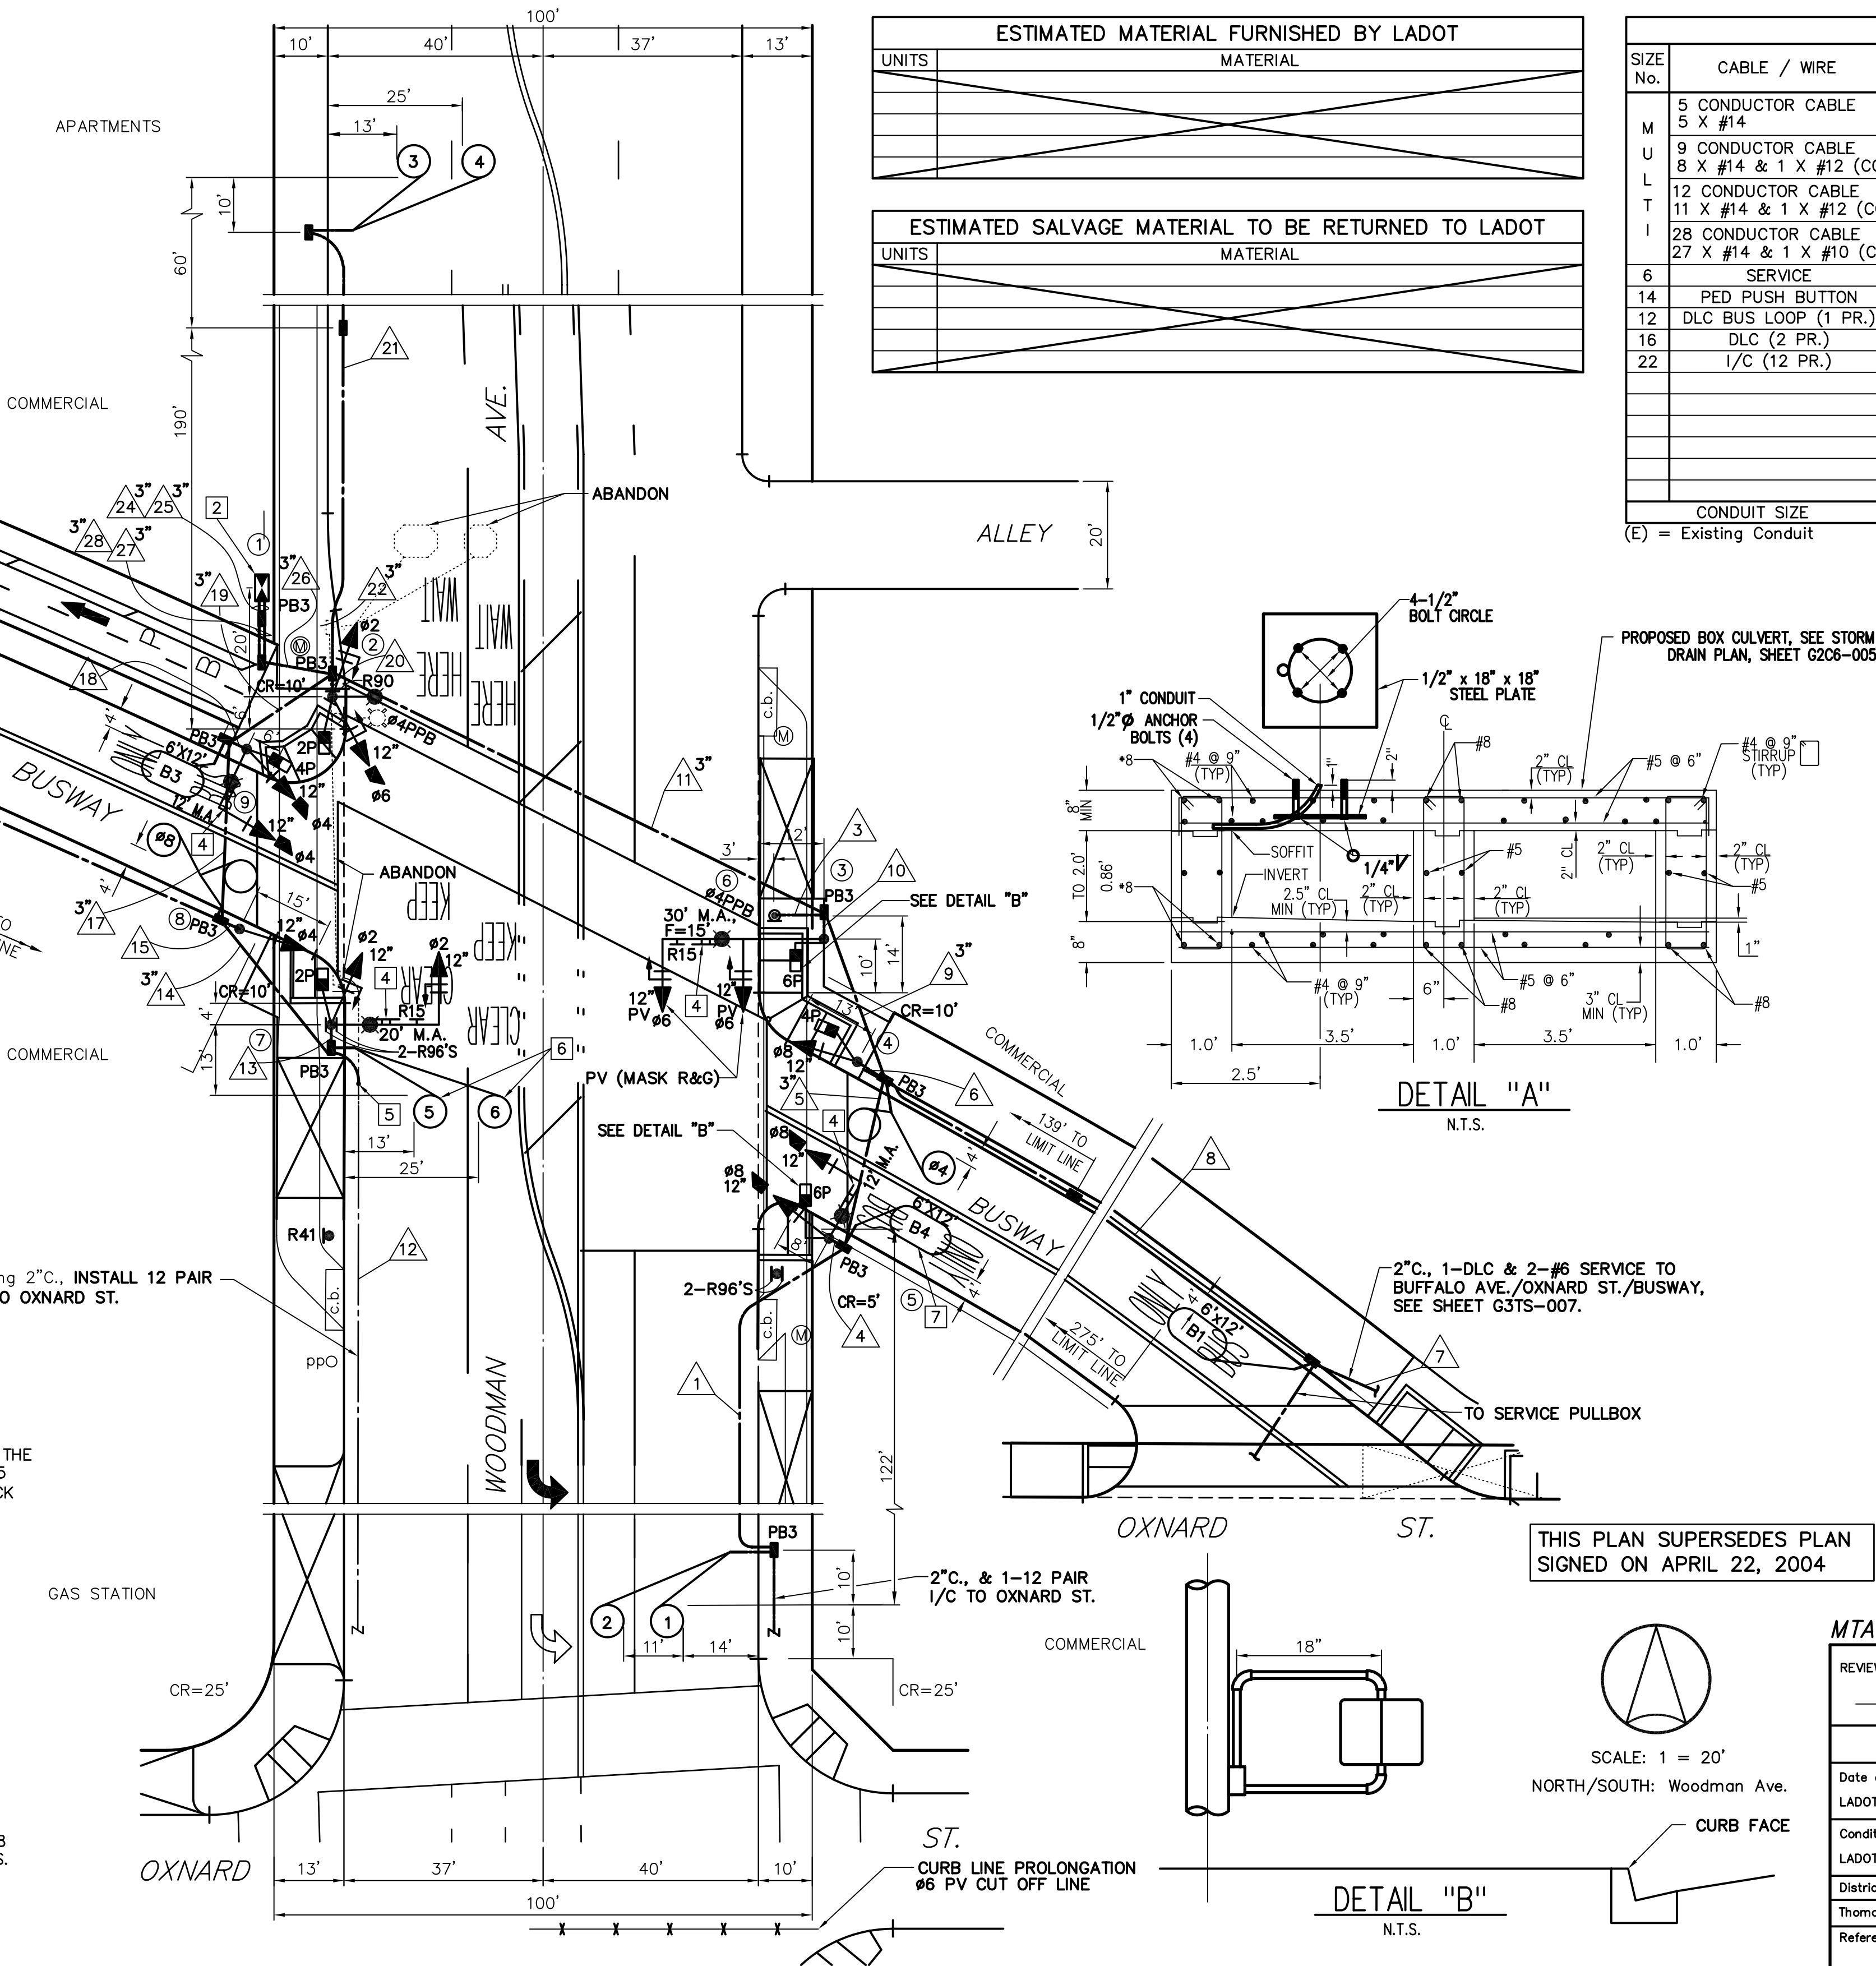

ESTIMATED MATERIAL FURNISHED BY LADOT	
UNITS	MATERIAL

ESTIMATED SALVAGE MATERIAL TO BE RETURNED TO LADOT	
UNITS	MATERIAL

CONDUCTOR SCHEDULE		R U N																											
SIZE No.	CABLE / WIRE																												
5	CONDUCTOR CABLE																												
5	X #14																												
9	CONDUCTOR CABLE																												
8	X #14 & 1 X #12 (COM)																												
12	CONDUCTOR CABLE																												
11	X #14 & 1 X #12 (COM)																												
28	CONDUCTOR CABLE																												
27	X #14 & 1 X #10 (COM)																												
6	SERVICE																												
14	PED. PUSH BUTTON																												
12	DLC BUS LOOP (1 PR.)																												
16	DLC (2 PR.)																												
22	I/C (12 PR.)																												
	CONDUIT SIZE	2"	2"	2"	3"	2"	2"	3"	2"	3"	2"	3"	2"	3"	2"	3"	2"	3"	2"	3"	2"	3"	2"	3"	2"	3"	2"	3"	2"
	(E) = Existing Conduit																												

- NOTICE TO CONTRACTOR
- EXCEPT WHERE OTHERWISE INDICATED, MATERIALS AND INSTALLATION METHODS SHALL CONFORM TO THE LATEST EDITION, WITH SUPPLEMENTS, OF THE STANDARD SPECIFICATION FOR PUBLIC WORKS CONSTRUCTION, ADOPTED BY THE CITY OF LOS ANGELES BOARD OF PUBLIC WORKS (LABPW), INCLUDING THE LATEST VERSION OF STANDARD PLAN S-610 ISSUED BY THE LABPW, AND THE LATEST EDITION, WITH AMENDMENTS, OF THE SPECIAL PROVISIONS AND STANDARD DRAWINGS FOR THE INSTALLATION AND MODIFICATION OF TRAFFIC SIGNALS, ISSUED BY THE CITY OF LOS ANGELES DEPARTMENT OF TRANSPORTATION (LADOT).
 - THE LADOT TRAFFIC SIGNAL INSPECTOR SHALL BE NOTIFIED AT (213) 792-7637. THE SENIOR MAINTENANCE SUPERVISOR AT (818) 756-7845, AND THE LADOT METRO RAIL ENGINEER AT (213) 485-2610 THREE (3) WORKING DAYS PRIOR TO THE BEGINNING OF CONSTRUCTION.
 - NORMAL TRAFFIC CONTROL SHALL BE MAINTAINED FROM 6:00 A.M. TO 9:00 A.M. AND 3:00 P.M. TO 7:00 P.M. ON WEEKDAYS. HOURS AND DURATION WHEN TRAFFIC SIGNALS ARE DEACTIVATED AND/OR PLACED INTO FLASHING OPERATION REQUIRE THE PRIOR APPROVAL OF THE LADOT METRO RAIL ENGINEER. TRAFFIC SIGNAL DEACTIVATION AND/OR FLASHING OPERATION SHALL BE IMPLEMENTED BY A LADOT TRAFFIC SIGNAL ELECTRICIAN, IN COORDINATION WITH THE ATSAC CONTROL CENTER, AND SHALL BE REQUESTED THREE (3) WORKING DAYS IN ADVANCE THROUGH THE LADOT METRO RAIL ENGINEER, (213) 485-2610. FULL RESTORATION OF THE ATSAC SYSTEM MUST OCCUR WITHIN FIVE (5) WORKING DAYS AFTER DEACTIVATION.
 - THE CONTRACTOR SHALL COORDINATE WITH THE LADOT SIGNAL SHOP AT (213) 847-2944 TO ARRANGE CONTROLLER DELIVERY. THE CONTRACTOR SHALL PROVIDE AND DELIVER A COMPLETE FUNCTIONING CONTROLLER ASSEMBLY AND CABINET TO THE LADOT SIGNAL SHOP THIRTY (30) CALENDAR DAYS PRIOR TO THE INSTALLATION DATE, AND PICK UP THE CONTROLLER WITHIN FIFTEEN (15) CALENDAR DAYS AFTER NOTIFICATION BY LADOT SIGNAL SHOP.
 - ALL REMOVED TRAFFIC SIGNAL EQUIPMENT IDENTIFIED AS SALVAGED MATERIAL SHALL BE RETURNED TO LADOT. ARRANGEMENTS FOR RETURNING IDENTIFIED EQUIPMENT TO LADOT SHALL BE MADE FIVE (5) WORKING DAYS IN ADVANCE BY CONTACTING THE LADOT MATERIAL CONTROL DIVISION AT (213) 580-5477. THE CONTRACTOR SHALL OBTAIN A SALVAGE RECEIPT FROM LADOT AND FORWARD A COPY, SIGNED BY THE CONTRACTOR AND THE RECEIVING LADOT YARD TO LADOT METRO RAIL ENGINEER AT 205 S. BROADWAY, SUITE 300, L.A. CA 90012. ALL OTHER REMOVED SIGNAL EQUIPMENT SHALL BE RETAINED BY THE CONTRACTOR.
 - ALL EXISTING TRAFFIC CONTROL SIGNING SHALL BE MAINTAINED WITH STANDARD SIGN BRACKETS BY THE CONTRACTOR. EXCEPT WHERE OTHERWISE INDICATED, EXISTING LARGE STREET NAME SIGNS ON MAST ARM TYPE STANDARDS SHALL BE RELOCATED FROM THE VERTICAL POLE TO THE MAST ARM PER LADOT STANDARD DRAWING NO. S-457.0. WHEN CALLED OUT ON THIS PLAN, CONTRACTOR SHALL FURNISH AND INSTALL LARGE STREET NAME SIGNS AND SIGN BRACKETS FOR INSTALLATION ON MAST ARM PER LADOT STD. DWG. No. S-457.0. ANY TRAFFIC SIGNING DAMAGED OR LOST BY THE CONTRACTOR SHALL BE REPLACED AT THE CONTRACTOR'S EXPENSE.
 - THE CONTRACTOR SHALL FURNISH AND INSTALL, AS SHOWN ON THE PLANS, ALL TRAFFIC SIGNAL EQUIPMENT SUCH AS STANDARDS, MAST ARMS, SIGNAL HEADS, AND OTHER EQUIPMENT AS REQUIRED. ALL SUCH EQUIPMENT SHALL BE NEW. ALL SUCH EQUIPMENT SHALL BE IN ACCORDANCE WITH THE LATEST EDITION OF THE SIGNAL MANUAL. ALL VEHICLE HEAD EQUIPMENT SUPPLIED BY THE CONTRACTOR SHALL HAVE 1-1/2 INCH DIAMETER PIPE FIT MOUNTING HARDWARE, INCLUDING ALL TOP POST MOUNT HEADS. PED HEAD MODULE REPLACEMENTS SHOWN ON THE PLAN SHALL REQUIRE A COMPLETE INSTALLATION, INCLUDING NEW PED HEAD AND TERMINAL COMPARTMENT. LEFT TURN SIGNAL HEADS ON MAST ARMS WITH TWO OR MORE SIGNAL HEADS SHALL BE TOP MOUNTED.


MTA - SAN FERNANDO VALLEY RAPID BUS SYSTEM (NEW SIGNAL)

REVIEWED	20	RECOMMENDED	20	ACCEPTED	August 19, 2004
Transportation Engineer		Senior Transportation Engineer		Principal Transportation Engineer	Thomas L. Jones
AS BUILT		CITY OF LOS ANGELES DEPARTMENT OF TRANSPORTATION WAYNE K. TANDA, GENERAL MANAGER			
Date of Installation:	11-18-05	TITLE			
LADOT Inspector:	Alegria	BUSWAY & WOODMAN AVE.			
Condition As Of:	11-18-05				
LADOT Engineer:	J.P.				
District:	East Valley				
Thomas Guide:	532-C7				
References		File Name	Intersection No.	Project No.	
		33222-P1.DWG	33222	74720	
NOTICE: IF PLAN HAS NOT BEEN IMPLEMENTED WITHIN TWO (2) YEARS OF THE ACCEPTANCE DATE, IT MUST BE RESUBMITTED TO LADOT SIGNAL DESIGN SECTION FOR REVIEW AND APPROVAL.					




REV	DATE	BY	APP	REG NO	EXPRES	SEAL HOLDER	DESCRIPTION
3	01-16-06	JFB					AS-BUILT RECORD DRAWING
2	08-09-04	JFB	WJO	52655	12/31/06	WALTER J. OKITSU	SERVICE LOCATION CHANGE - IFC
1	03-17-04	GXF	WJO	52655	12/31/06	WALTER J. OKITSU	TRAFFIC SIGNAL POLE REVISIONS - IFC
0	02-19-04	GXF	WJO	52655	12/31/06	WALTER J. OKITSU	ISSUED FOR CONSTRUCTION

DESIGNED BY	G. FIGUEROA
DRAWN BY	G. FIGUEROA
CHECKED BY	D. YEH
IN CHARGE	W. OKITSU
DATE	02-19-04

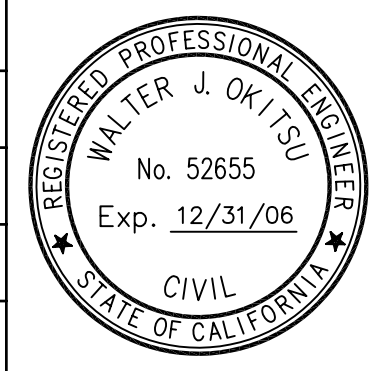

LOS ANGELES COUNTY METROPOLITAN TRANSPORTATION AUTHORITY
 SAN FERNANDO VALLEY EAST-WEST BRT PROJECT

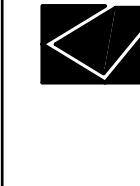

Katz, Okitsu & Associates
 Traffic Engineers & Transportation Planners
 1055 Corporate Center Drive, Suite 300
 Monterey Park, California 91754-7642
 Tel: (323) 260-4703 Fax: (323) 260-4705

NORTH HOLLYWOOD TO WARNER CENTER GROUP 2 INTERSECTIONS BUSWAY AND WOODMAN AVE.		SEGMENT NO	C-0675
DRAWING NO	G2TS-009	REV	3
SCALE	1" = 20'		
SHEET NO			