



CONSTRUCTION NOTES:

- THE CONTRACTOR SHALL BE RESPONSIBLE FOR LABOR AND MATERIAL INVOLVED IN THE REMOVAL, MARKOUT, AND INSTALLATION OF ALL STRIPING, PAVEMENT MARKINGS, CURB MARKINGS, AND SIGNS SHOWN HEREON. REMOVAL OF MARKINGS SHALL BE PERFORMED BEFORE MARKOUT AND INSTALLATION OF NEW STRIPING, AND SHALL BE BY SANDBLASTING/GRINDING IN ACCORDANCE WITH LADOT SPECIFICATION NO. 76-016-10. MARKOUT SHALL BE BY SPRAY PAINT OR HEAVY PAINT BRUSH MARKINGS OVER A PULLED ROPE IN THE RESPECTIVE WHITE OR YELLOW COLORS OF THE PROPOSED STRIPING. FINAL STRIPING AND PAVEMENT MARKINGS SHALL BE IN HOT APPLIED ALKYD THERMOPLASTIC IN ACCORDANCE WITH LADOT SPECIFICATIONS NO. S-51-005-10 AND 76-012-15.
- THE INSTALLATION OF THERMOPLASTIC STRIPING MAY PROCEED ONLY AFTER INSPECTION AND APPROVAL OF MARKOUT BY THE LADOT MAJOR CONSTRUCTION TRAFFIC MANAGEMENT DIVISION. THE CONTRACTOR SHALL CORRECT ALL ERRORS IN MARKOUT REQUESTED BY LADOT. UPON APPROVAL OF MARKOUT, THE CONTRACTOR SHALL FULLY INSTALL THE THERMOPLASTIC STRIPING, PAVEMENT MARKINGS, (CURB MARKINGS, AND SIGNS-AS APPLICABLE) WITHIN THE FOLLOWING THREE (3) WORKING DAYS. THE CONTRACTOR SHALL NOTIFY THE LADOT MAJOR CONSTRUCTION TRAFFIC MANAGEMENT IN WRITING, (213) 485-2610 AT THE FOLLOWING POINTS IN TIME, AND FOR THE FOLLOWING PURPOSES:
  - TEN (10) WORKING DAYS IN ADVANCE OF MARKOUT.
  - UPON COMPLETION OF MARKOUT (INCLUDING ANY MARKOUT CORRECTIONS) FOR INSPECTION AND APPROVAL.
  - UPON COMPLETION OF THERMOPLASTIC STRIPING (INCLUDING ANY THERMOPLASTIC STRIPING CORRECTIONS) FOR INSPECTION AND FINAL STRIPING APPROVAL.
- DURING ALL PHASES OF CONSTRUCTION, TEMPORARY RAISED OVERLAY PAVEMENT MARKERS SHALL BE MAINTAINED ADJACENT TO ANY TEMPORARY CENTERLINE, MARKOUT CENTERLINE, OR SCAR OF THE SANDBLASTED CENTERLINE, AS APPLICABLE, AS PER LADOT STANDARD PLAN NO. S-453.0.
- THE FIELD CONDITIONS SHOWN AS EXISTING ON THIS PLAN MAY CHANGE BETWEEN THE PLAN APPROVAL DATE AND THE IMPLEMENTATION DATE. THE CONTRACTOR MAY BE REQUIRED TO INSTALL OR REMOVE STRIPING, PAVEMENT MARKINGS, SIGNS, OR OTHER TRAFFIC CONTROL DEVICES BEYOND THOSE INDICATED ON THIS PLAN, IN ORDER TO FACILITATE THESE CHANGES IN FIELD CONDITIONS AND/OR TO BE IN COMPLIANCE WITH LADOT STANDARDS AND SPECIFICATIONS. IF THIS PLAN HAS NOT BEEN INSTALLED WITHIN TWO (2) YEARS OF THE APPROVAL DATE, IT SHALL BE RESUBMITTED TO LADOT GEOMETRIC DESIGN SECTION FOR REAPPROVAL PRIOR TO PROCEEDING TO CONSTRUCTION.
- THE CLEARANCE FROM THE BOTTOM EDGE OF THE BIKE PATH SIGNS TO THE PATH SURFACE DIRECTLY UNDER THE SIGN SHALL BE A MINIMUM OF EIGHT (8) FEET.
- ALL WORK AND MATERIAL FOR THE BIKE PATH AND MULTI-USE PATH ARE SUBJECT TO INSPECTION BY L.A. CITY.

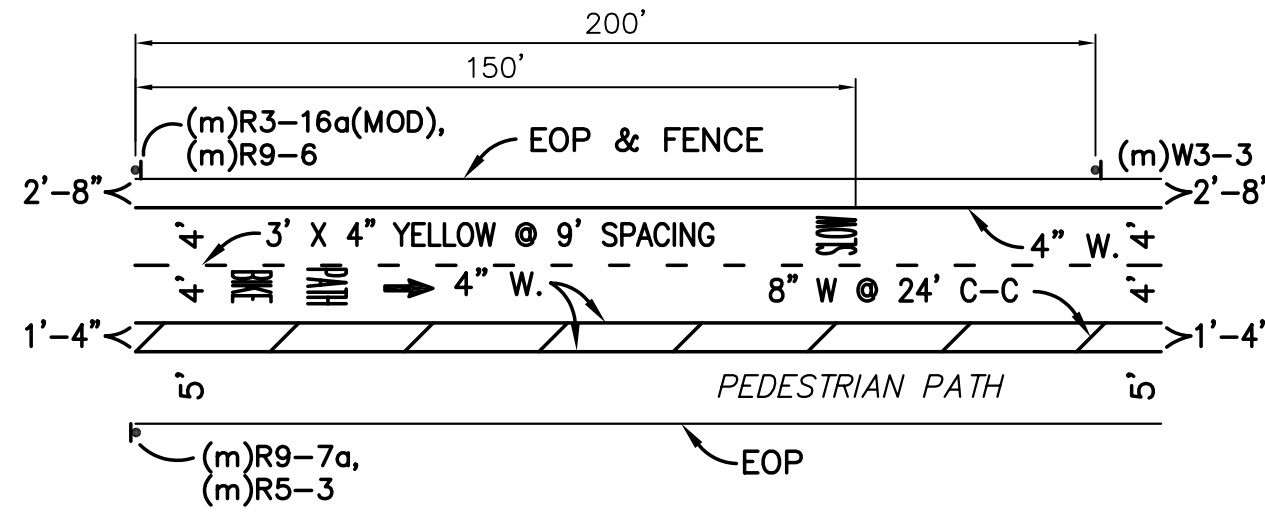

DETAIL "A"  
PED/BIKE PATH (17' BIKE PATH)

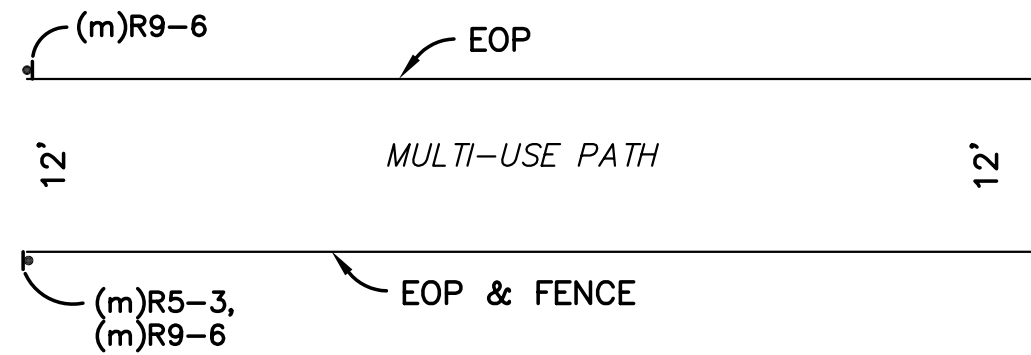

DETAIL "B"  
TYPICAL MULTI-USE PATH

NOTES:

- PAINT REMOVAL REQUIRED.
- INSTALL P.V.M.T. MARKINGS AS SHOWN.
- LENGTH OF PROJECT THIS SHEET ±280'.

LEGEND

- = EXISTING STRIPING & MARKINGS TO REMAIN.  
 = EXISTING STRIPING & MARKINGS TO BE REMOVED.  
 = PROPOSED STRIPING & MARKINGS.
- = EXISTING SIGN AND POST.  
 = EXISTING SIGN AND POST TO BE REMOVED OR RELOCATED.  
 = PROPOSED SIGN AND POST.
- = SIGNALIZED INTERSECTION.
- = EXISTING RED CURB MARKINGS TO REMAIN.  
 = EXISTING RED CURB MARKINGS TO BE REMOVED.  
 = PROPOSED RED CURB MARKINGS.
- = (EXISTING BIKE PATH MARKINGS).  
 = (EXISTING BIKE PATH MARKINGS TO BE REMOVED).  
 = (PROPOSED BIKE PATH MARKINGS).
- (m) = (MUTCD) STANDARD SIGN.
- TVE = "TRANSIT VEHICLE EXEMPT" SIGN.

BIKE/PED PATH SIGN LEGEND

NO SCALE



(m)R3-16a(MOD)



(m)R5-3




(m)R9-6



(m)R9-7




(m)R9-7a

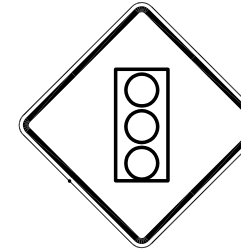

(m)W3-3

NOTICE TO CONTRACTORS (BIKE/PED PATH):

- STRIPING**  
A BROKEN 4" WIDE, 3' LONG, WITH 9' SPACING YELLOW STRIPE SHALL BE APPLIED ALONG THE CENTER OF THE BIKE PATH.
- PAVEMENT MARKINGS**  
PAVEMENT MARKINGS SHALL BE PAINTED WHITE IN ACCORDANCE WITH LADOT STANDARD DRAWING NO. S-459.0, S-461.0, AND S-498.0.
- PAINT MATERIAL**  
RAPID DRY WATER BORNE PAINT IN CONFORMANCE WITH CALTRANS PAINT SPECIFICATION NO. 8010-20B SHALL BE USED FOR ALL BIKE PATH STRIPING AND PAVEMENT MARKINGS. APPLICATION OF THE PAINT SHALL BE IN ACCORDANCE WITH CALTRANS STANDARD SPECIFICATIONS, SECTION 84.
- SIGNS AND SIGN POSTS**  
SIGN POST INSTALLATION SHALL BE IN ACCORDANCE WITH LADOT STANDARD DRAWING NO. S-452.0, AND SHALL BE PLACED AS SHOWN ON PLANS. BOTTOM OF SIGNS SHALL BE AT LEAST 8' ABOVE THE BIKE PATH GRADE. THE CONTRACTOR SHALL PROVIDE LADOT ACTUAL SIZE TEMPLATES FOR ALL SIGNS SHOWN AND OBTAIN LADOT'S APPROVAL OF THE SIGN TEMPLATES BEFORE FABRICATION.
- THE CONTRACTOR SHALL NOTIFY LADOT, BIKEWAYS SECTION, (213) 482-6980, FIVE (5) WORKING DAYS PRIOR TO MARK OUT FOR INSPECTION. NO INSTALLATION OF STRIPING, PAVEMENT MARKINGS, OR SIGNS SHALL START PRIOR TO INSPECTION AND APPROVAL BY LADOT AND THE CITY INSPECTOR. UPON COMPLETION OF FINAL STRIPING, THE CONTRACTOR SHALL AGAIN NOTIFY THE BIKEWAYS SECTION FOR FINAL APPROVAL.

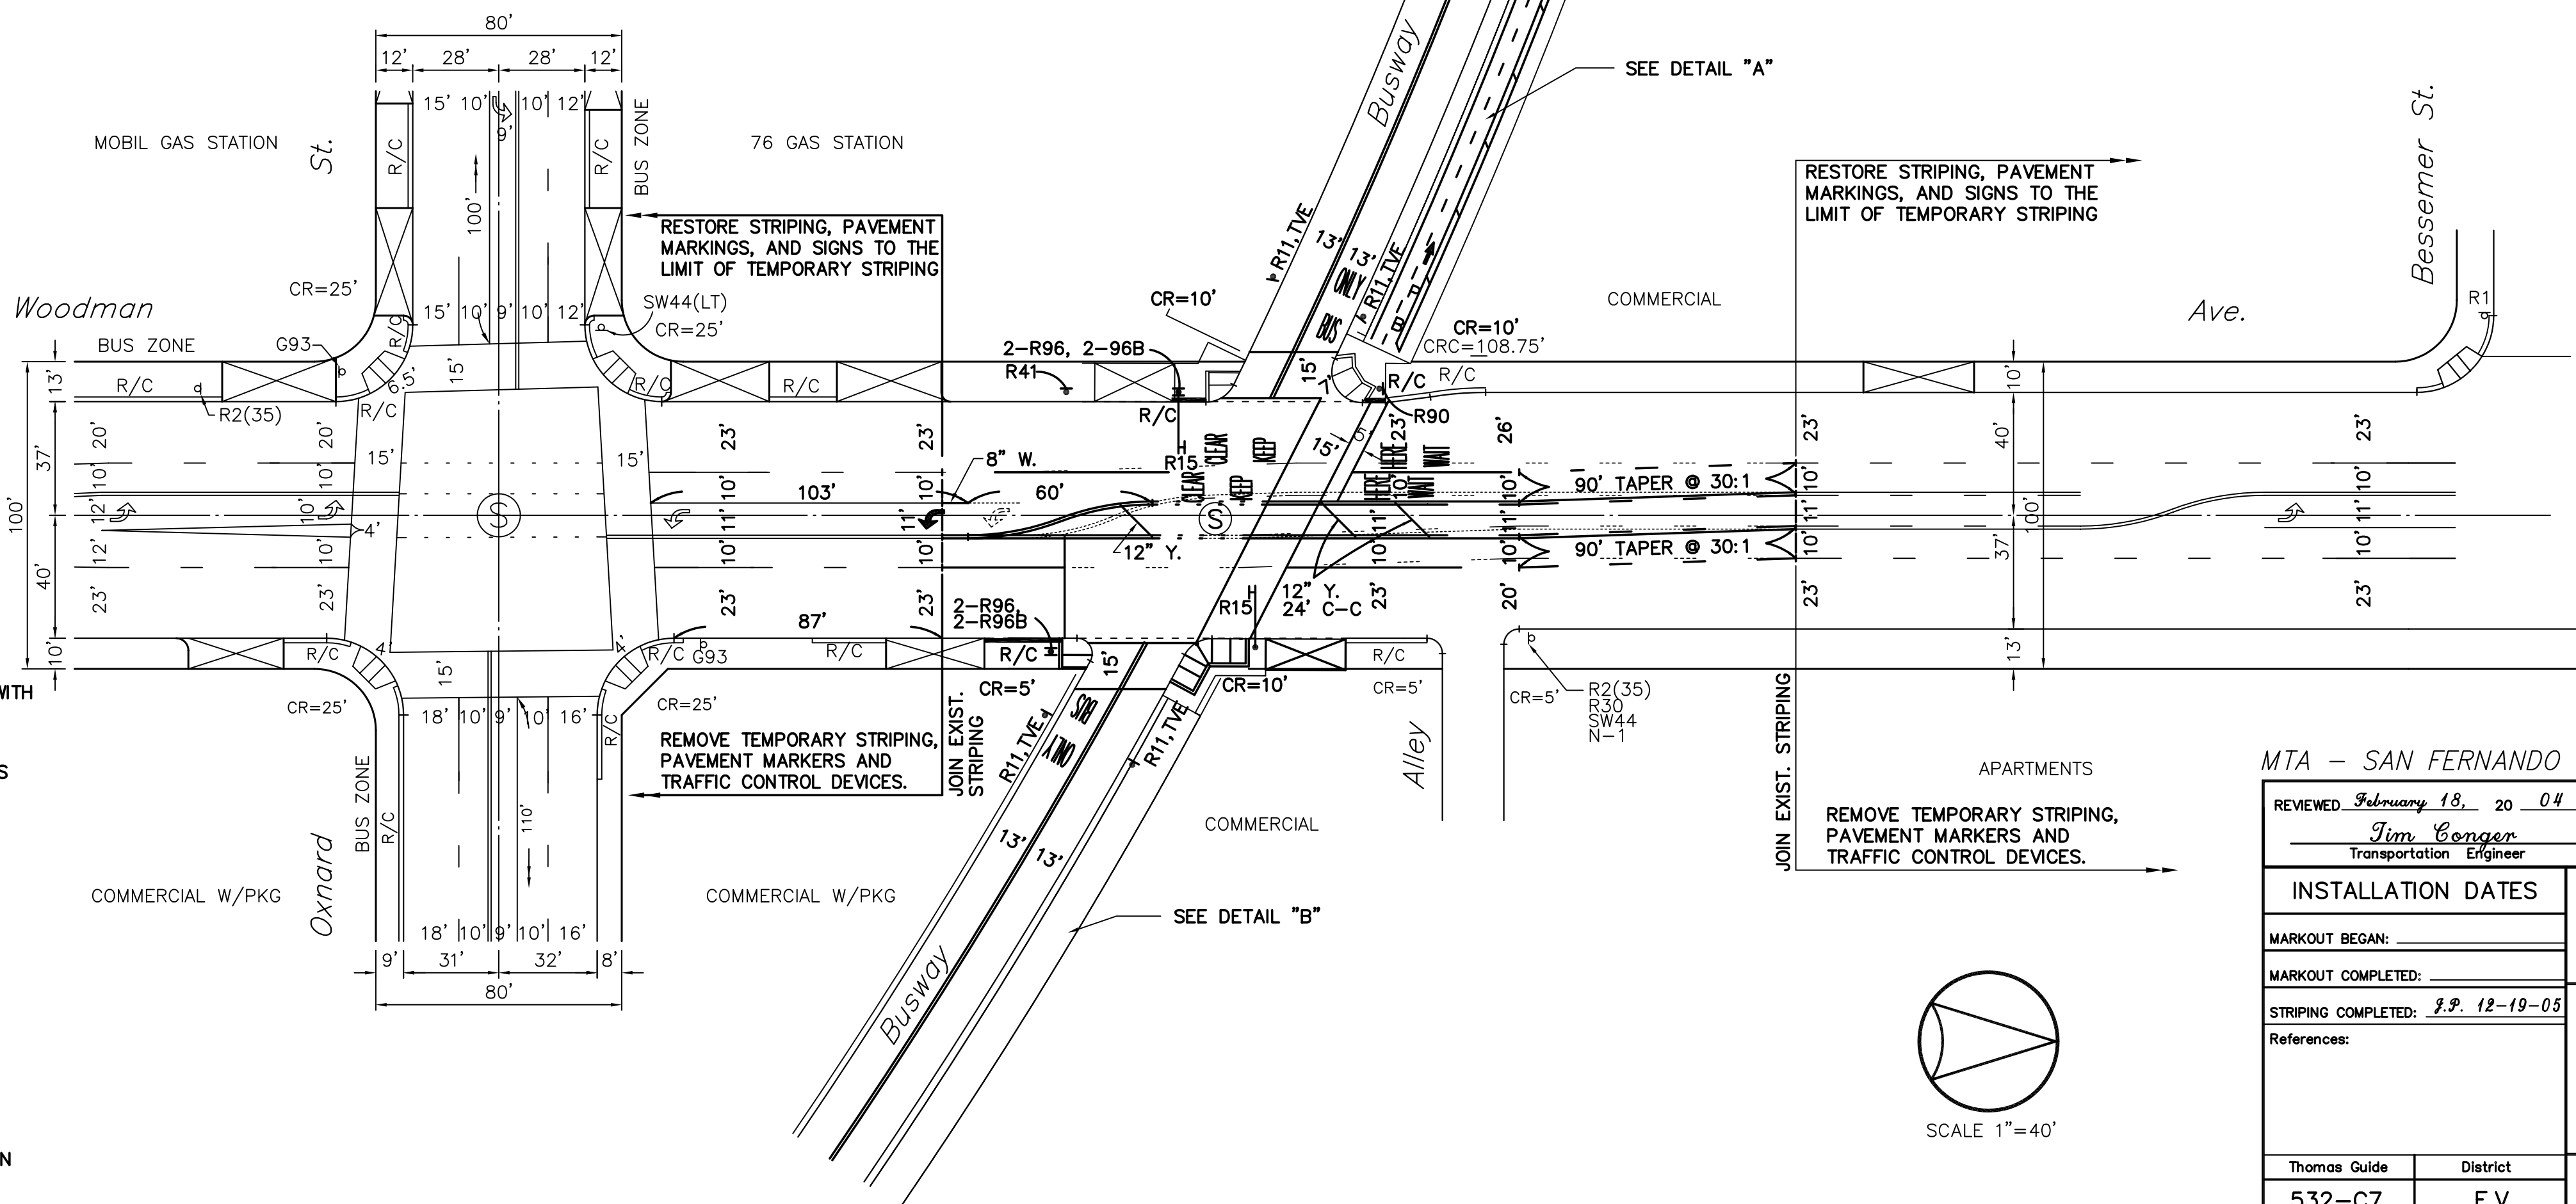

MTA - SAN FERNANDO VALLEY RAPID BUS SYSTEM

|                                       |                                                                                        |                                                      |
|---------------------------------------|----------------------------------------------------------------------------------------|------------------------------------------------------|
| REVIEWED: February 18, 20 04          | RECOMMENDED: 20                                                                        | ACCEPTED: February 18, 20 04                         |
| Tom Conger<br>Transportation Engineer | Senior Transportation Engineer                                                         | Thomas L. Jones<br>Principal Transportation Engineer |
| INSTALLATION DATES                    | CITY OF LOS ANGELES<br>DEPARTMENT OF TRANSPORTATION<br>WAYNE K. TANDA, GENERAL MANAGER |                                                      |
| MARKOUT BEGAN:                        |                                                                                        |                                                      |
| MARKOUT COMPLETED:                    |                                                                                        |                                                      |
| STRIPING COMPLETED: 8.8.12-19-05      |                                                                                        |                                                      |
| References:                           |                                                                                        |                                                      |
| Thomas Guide                          | District                                                                               | PROJECT NO.                                          |
| 532-C7                                | E.V.                                                                                   | 74720                                                |
| DRAWING NO.                           |                                                                                        | 1                                                    |
| A-3928                                |                                                                                        | 1                                                    |



| REV | DATE     | BY  | APP | REG NO | EXPIRES  | SEAL HOLDER      | DESCRIPTION             |
|-----|----------|-----|-----|--------|----------|------------------|-------------------------|
| 1   | 01-16-06 | JFB |     |        |          |                  | AS-BUILT RECORD DRAWING |
| 0   | 02-19-04 | JFB | WJO | 52655  | 12/31/06 | WALTER J. OKITSU | ISSUED FOR CONSTRUCTION |

DESIGNED BY  
J. BERNAL  
DRAWN BY  
J. BERNAL  
CHECKED BY  
D. YEH  
IN CHARGE  
W. OKITSU  
DATE  
02-19-04



LOS ANGELES COUNTY METROPOLITAN TRANSPORTATION AUTHORITY  
SAN FERNANDO VALLEY EAST-WEST BRT PROJECT



Katz, Okitsu & Associates  
Traffic Engineers & Transportation Planners  
1055 Corporate Center Drive, Suite 300  
Monterey Park, California 91754-7642  
Tel: (323) 260-4703 Fax: (323) 260-4705

NORTH HOLLYWOOD TO WARNER CENTER  
GROUP 2 INTERSECTIONS  
RESTORATION SIGNING & STRIPING  
WOODMAN AVE.  
OXNARD ST. TO BESSEMER ST.

|            |          |
|------------|----------|
| SEGMENT NO | C-0675   |
| DRAWING NO | G2SS-008 |
| REV        | 0        |
| SCALE      | 1" = 40' |
| SHEET NO   |          |