






THE CITY OF LOS ANGELES OR ITS OFFICERS OR AGENTS SHALL NOT BE RESPONSIBLE FOR THE ACCURACY OR COMPLETENESS OF ELECTRONIC COPIES OF THIS PLAN SHEET.

REVISION DATES
(DESIGN STAGE ONLY)

Sheet Version 2.01

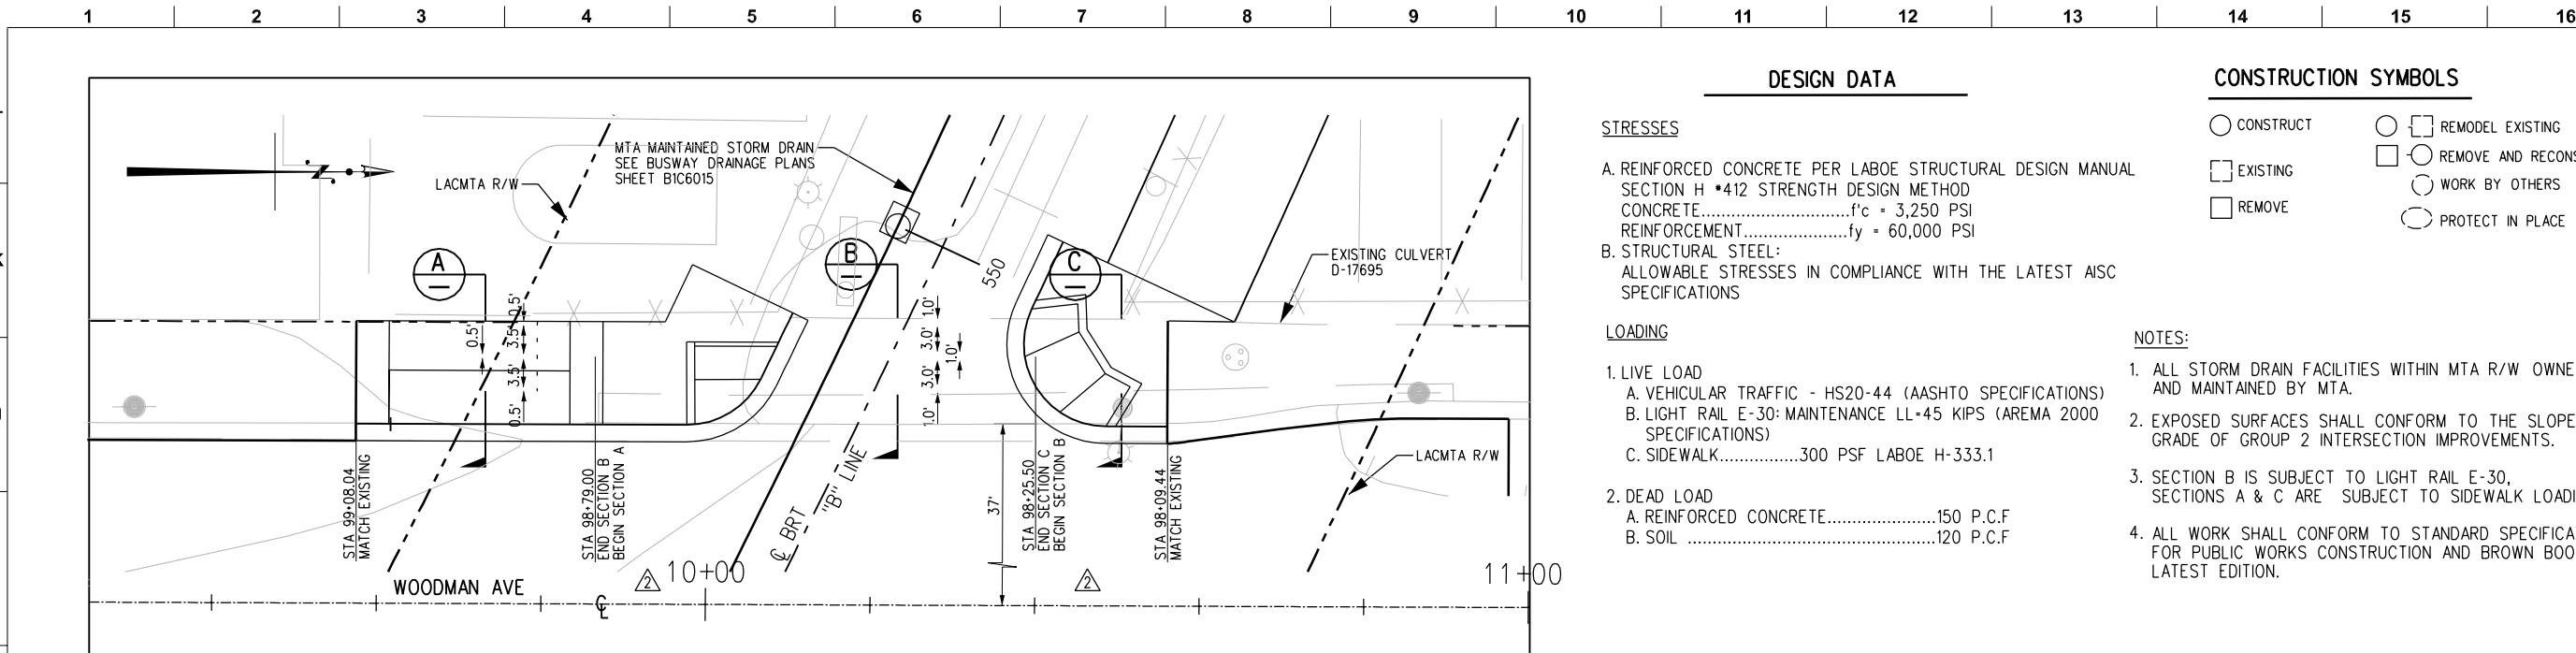

WEST SIDE CULVERT
SCALE: 1" = 10'

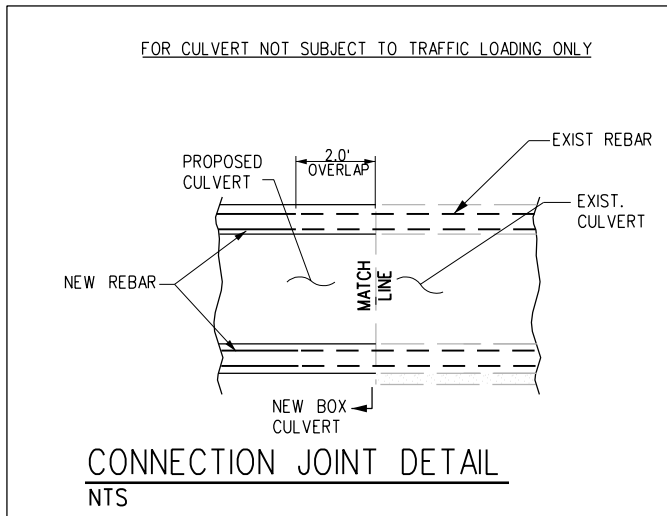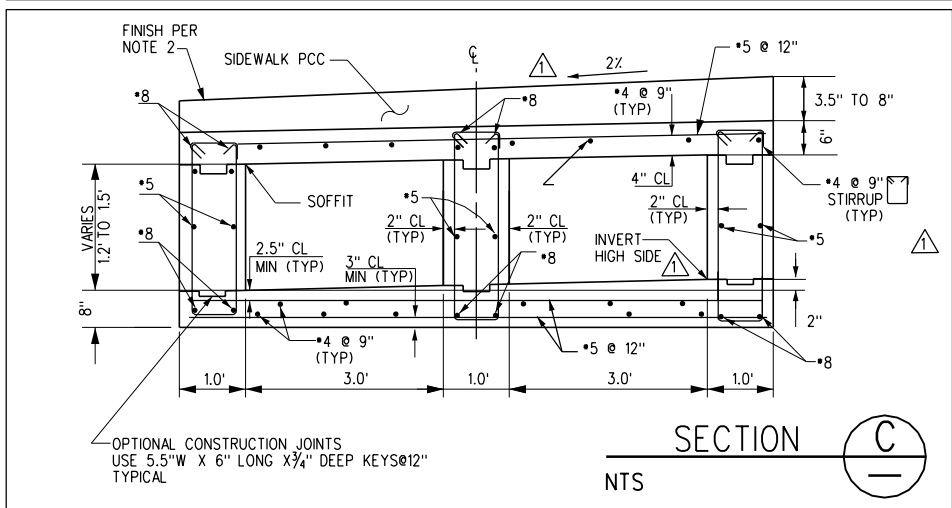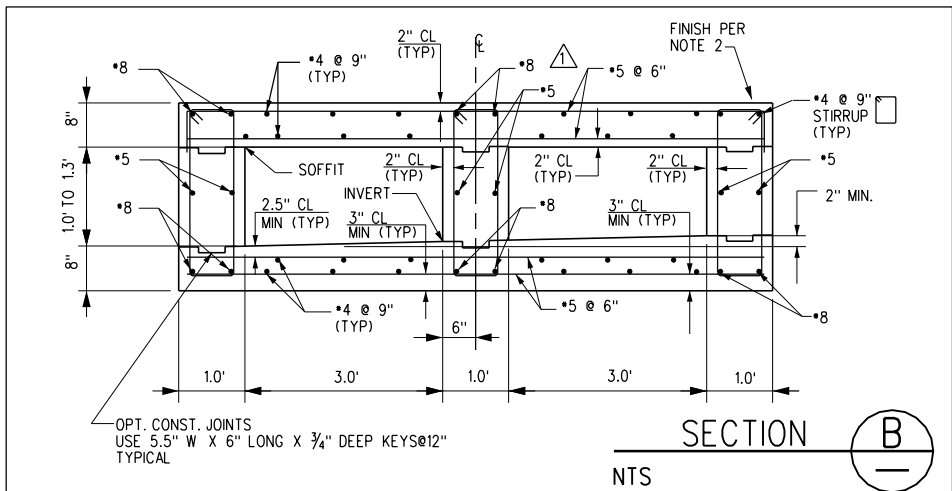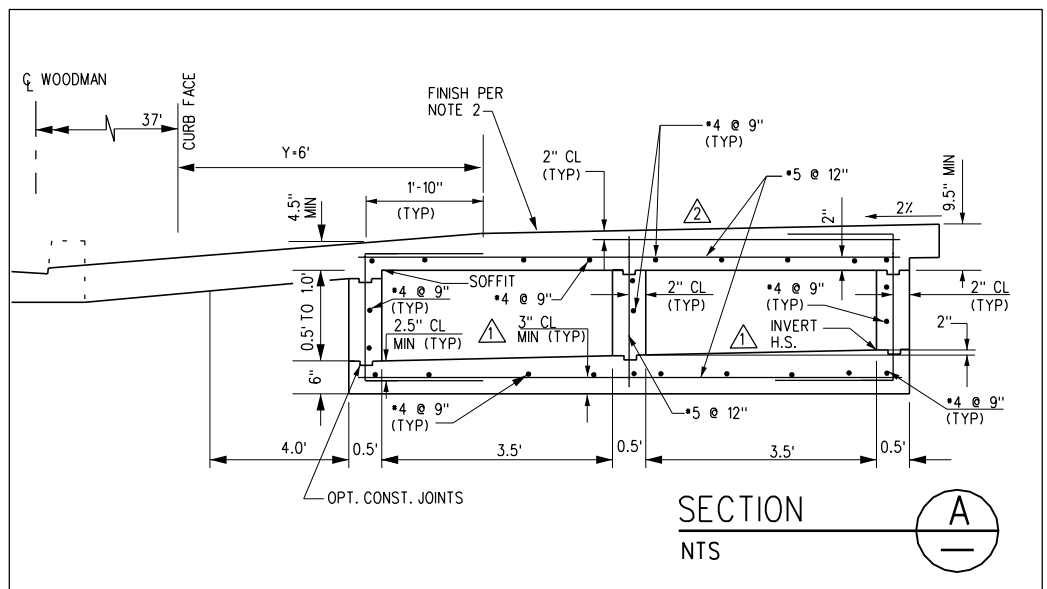

DESIGN DATA

STRESSES

- A. REINFORCED CONCRETE PER LABOE STRUCTURAL DESIGN MANUAL
SECTION H #412 STRENGTH DESIGN METHOD
CONCRETE.....f'c = 3,250 PSI
REINFORCEMENT.....fy = 60,000 PSI
B. STRUCTURAL STEEL:
ALLOWABLE STRESSES IN COMPLIANCE WITH THE LATEST AISC SPECIFICATIONS

LOADING

1. LIVE LOAD
A. VEHICULAR TRAFFIC - HS20-44 (AASHTO SPECIFICATIONS)
B. LIGHT RAIL E-30: MAINTENANCE LL-45 KIPS (AREMA 2000 SPECIFICATIONS)
C. SIDEWALK.....300 PSF LABOE H-333.1
2. DEAD LOAD
A. REINFORCED CONCRETE.....150 P.C.F
B. SOIL120 P.C.F

CONSTRUCTION SYMBOLS


- CONSTRUCT
□ EXISTING
□ REMOVE
○ □ REMODEL EXISTING
□ ○ REMOVE AND RECONSTRUCT
○ WORK BY OTHERS
○ PROTECT IN PLACE

NOTES:

1. ALL STORM DRAIN FACILITIES WITHIN MTA R/W OWNED AND MAINTAINED BY MTA.
2. EXPOSED SURFACES SHALL CONFORM TO THE SLOPE AND GRADE OF GROUP 2 INTERSECTION IMPROVEMENTS.
3. SECTION B IS SUBJECT TO LIGHT RAIL E-30, SECTIONS A & C ARE SUBJECT TO SIDEWALK LOADING.
4. ALL WORK SHALL CONFORM TO STANDARD SPECIFICATIONS FOR PUBLIC WORKS CONSTRUCTION AND BROWN BOOK, LATEST EDITION.

REV	DATE	BY	APP	REG NO	EXPIRES	SEAL HOLDER	DESCRIPTION
1	04/01/04	DAO	KJH	C56818	6/30/05	DAVID A. ORTIZ	INCORPORATED GENERAL REVISIONS-IFC
0	2/20/04	DAO	KJH	C56818	6/30/05	DAVID A. ORTIZ	ISSUED FOR CONSTRUCTION

DESIGNED BY
H. BULLOCK
DRAWN BY
A. GOMEZ
CHECKED BY
D. ORTIZ
IN CHARGE
B. E. JONES
DATE
01-14-04

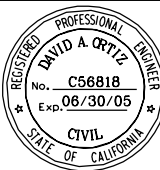

LOS ANGELES COUNTY METROPOLITAN TRANSPORTATION AUTHORITY
SAN FERNANDO VALLEY EAST-WEST BRT PROJECT
Washington Group International
SHIMMICK OBAYASHI, JV

AS-BUILT

DRAINAGE STORMDRAIN
STREET IMPROVEMENTS GROUP 2
STORM DRAIN SECTIONS & DETAILS
WOODMAN AVE

REVIEWED AND APPROVED BY:
GARRY J. JESS, PROJECT MANAGER
WASHINGTON GROUP INTERNATIONAL
CONTRACT NO
C0675
DRAWING NO
G2C6-004
SCALE
AS NOTED
SHEET NO

BUREAU OF ENGINEERING

APPROVALS: DATE: 2/20/04
ST TREES DIV: 04/01/04
ST LIGHTING: 11/10/05
D.O.T: 11/10/05

ISSUED FOR CONSTRUCTION: 2/20/04
INCORPORATED GENERAL REVISIONS: 04/01/04
AS-BUILT: 11/10/05

WORK ACCEPTED: 11/10/05

INDEX NO. 4

PROJECT: SAN FERNANDO VALLEY EAST-WEST PROJECT

PLANS

PROJECT NO. 0675

DRAWING NO. G2C6-004

SCALE AS NOTED

SHEET NO 4

SHEET 4 OF 6 SHEETS

