

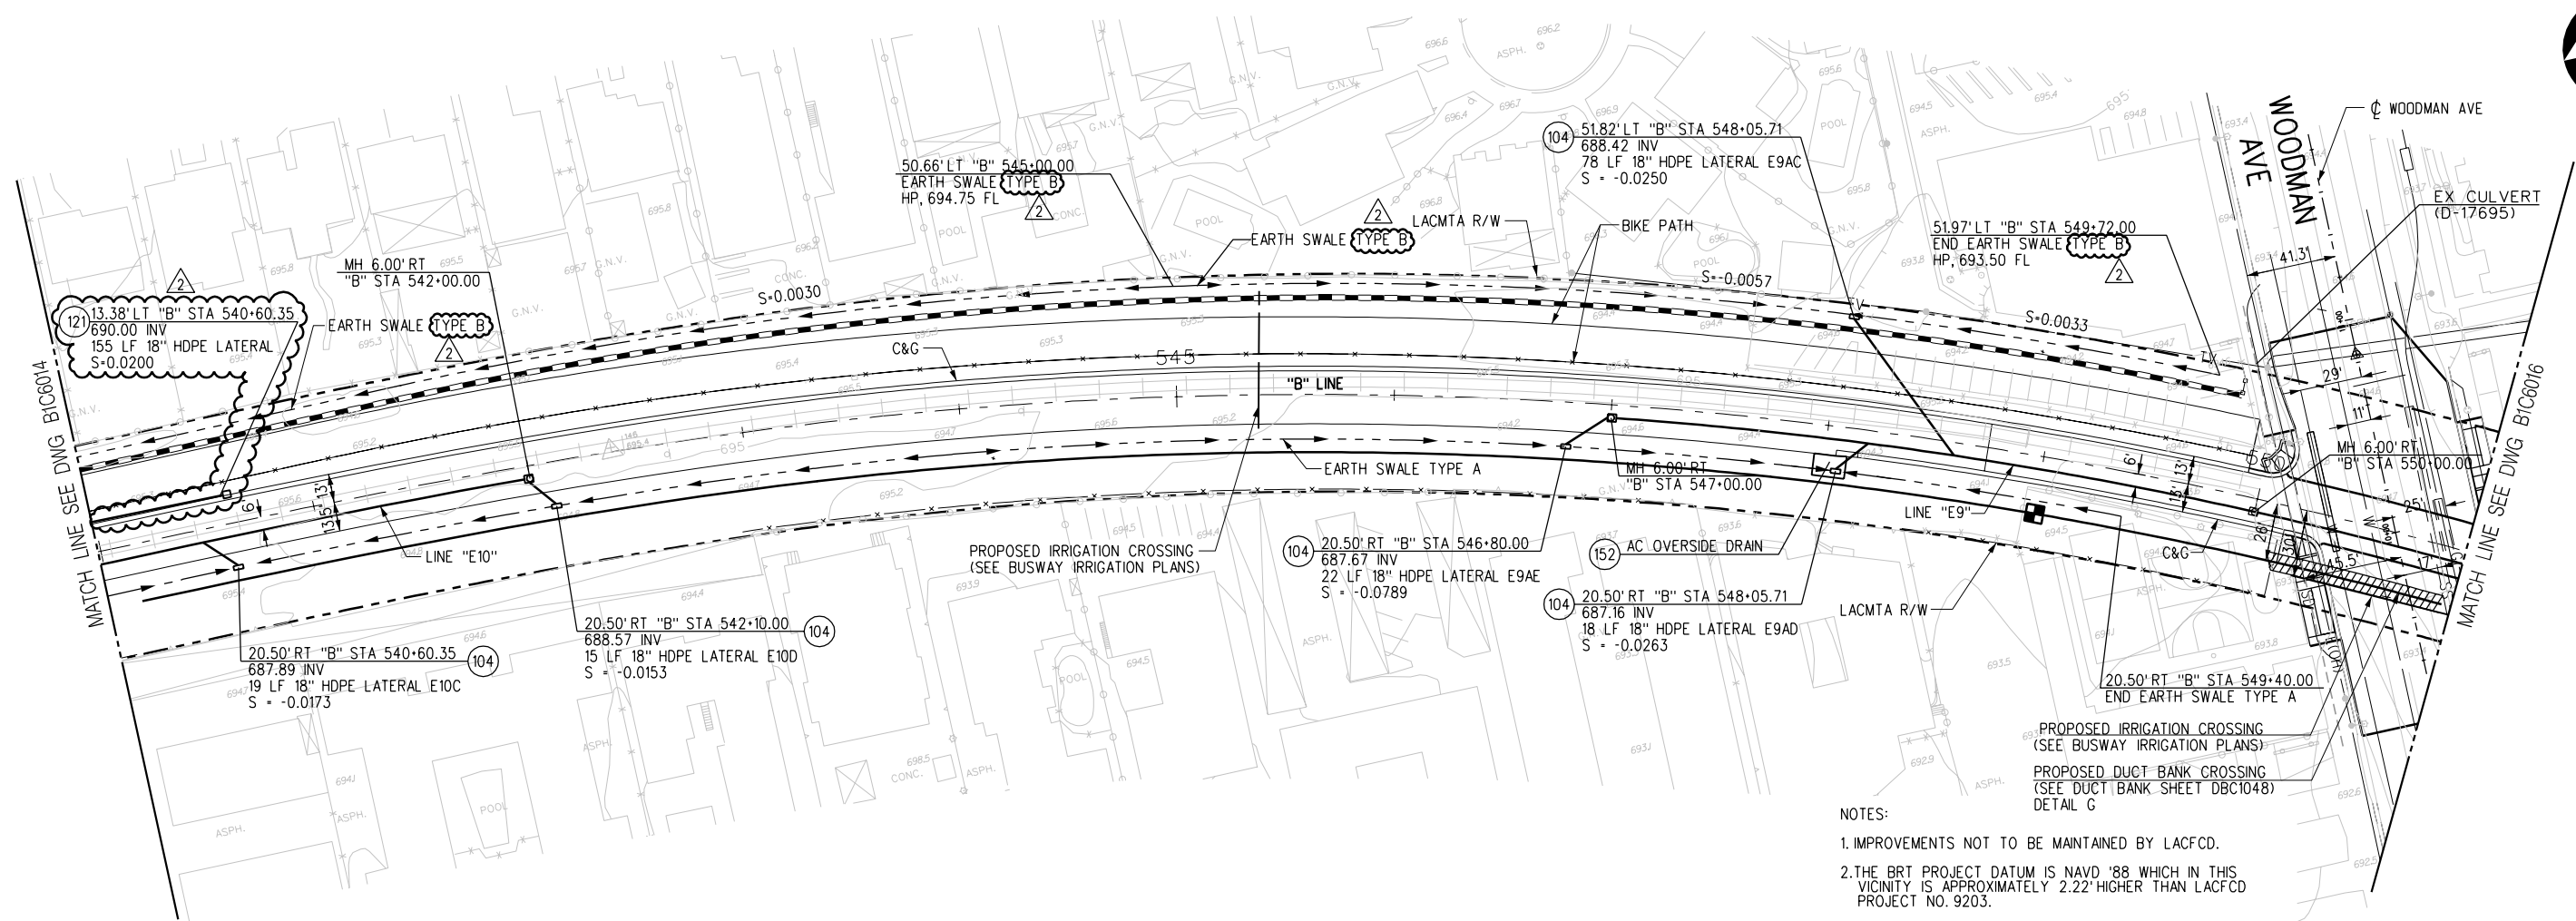
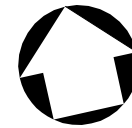


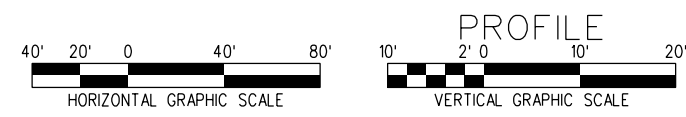

- NOTES:
- IMPROVEMENTS NOT TO BE MAINTAINED BY LACFCD.
 - THE BRT PROJECT DATUM IS NAVD '88 WHICH IN THIS VICINITY IS APPROXIMATELY 2.22' HIGHER THAN LACFCD PROJECT NO. 9203.
 - MINIMUM PIPE STIFFNESS FOR THE 24" HDPE PIPE IS 34 PSIAS SET BY AASHTO M-294. SEE DRAWING NO. B1C6035 FOR BEDDING AND LOADING DETAILS.
 - FOR SWALE AND DITCH SECTIONS SEE DRAINAGE DETAIL SHEETS.

PLAN

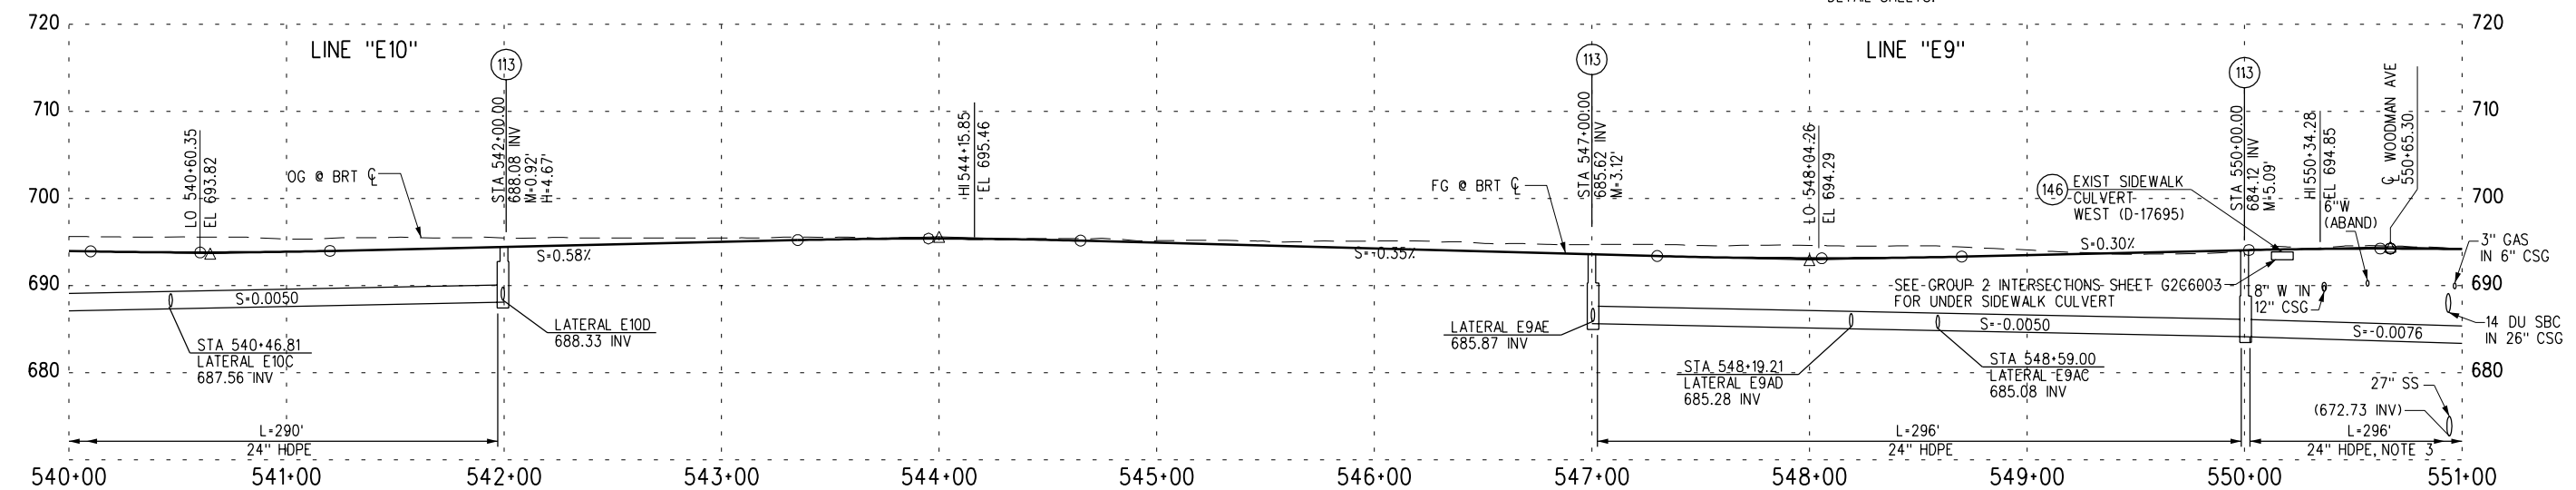

AS-BUILT RECORD DRAWING

REV	DATE	BY	APP	REG NO	EXPIRES	SEAL HOLDER	DESCRIPTION
2	10/17/05	AU	TG				AS-BUILT RECORD DRAWING
1	4/05/05	JLL	AKJ	C42345	03/31/06	ARVIND K. JOSHI	INCORPORATED RF1*409 - IFC
0	12/31/03	HAB	AKJ	C42345	03/31/06	ARVIND K. JOSHI	ISSUED FOR CONSTRUCTION

DESIGNED BY
H. BULLOCK
DRAWN BY
A. GOMEZ
CHECKED BY
D. ORTIZ
IN CHARGE
B. JONES
DATE
2/12/04



LOS ANGELES COUNTY METROPOLITAN TRANSPORTATION AUTHORITY
SAN FERNANDO VALLEY EAST-WEST BRT PROJECT

WASHINGTON GROUP INTERNATIONAL
5805 SEPULVEDA BLVD., SUITE 500
VAN NUYS, CA 91411

SHIMMICK
OBAYASHI, JV
5805 SEPULVEDA BLVD., SUITE 500
VAN NUYS, CA 91411

BUSWAY SEGMENT 1 EAST
DRAINAGE PLAN & PROFILE
STA 540+00 TO STA 551+00
SHEET 3 OF 20

CONTRACT NO
C0675
DRAWING NO
B1C6015
SCALE
HORIZ 1"=40'
VERT 1"=10'
SHEET NO
2

REVIEWED AND APPROVED BY:
GARRY J. JESS - PROJECT MANAGER
WASHINGTON GROUP INTERNATIONAL