




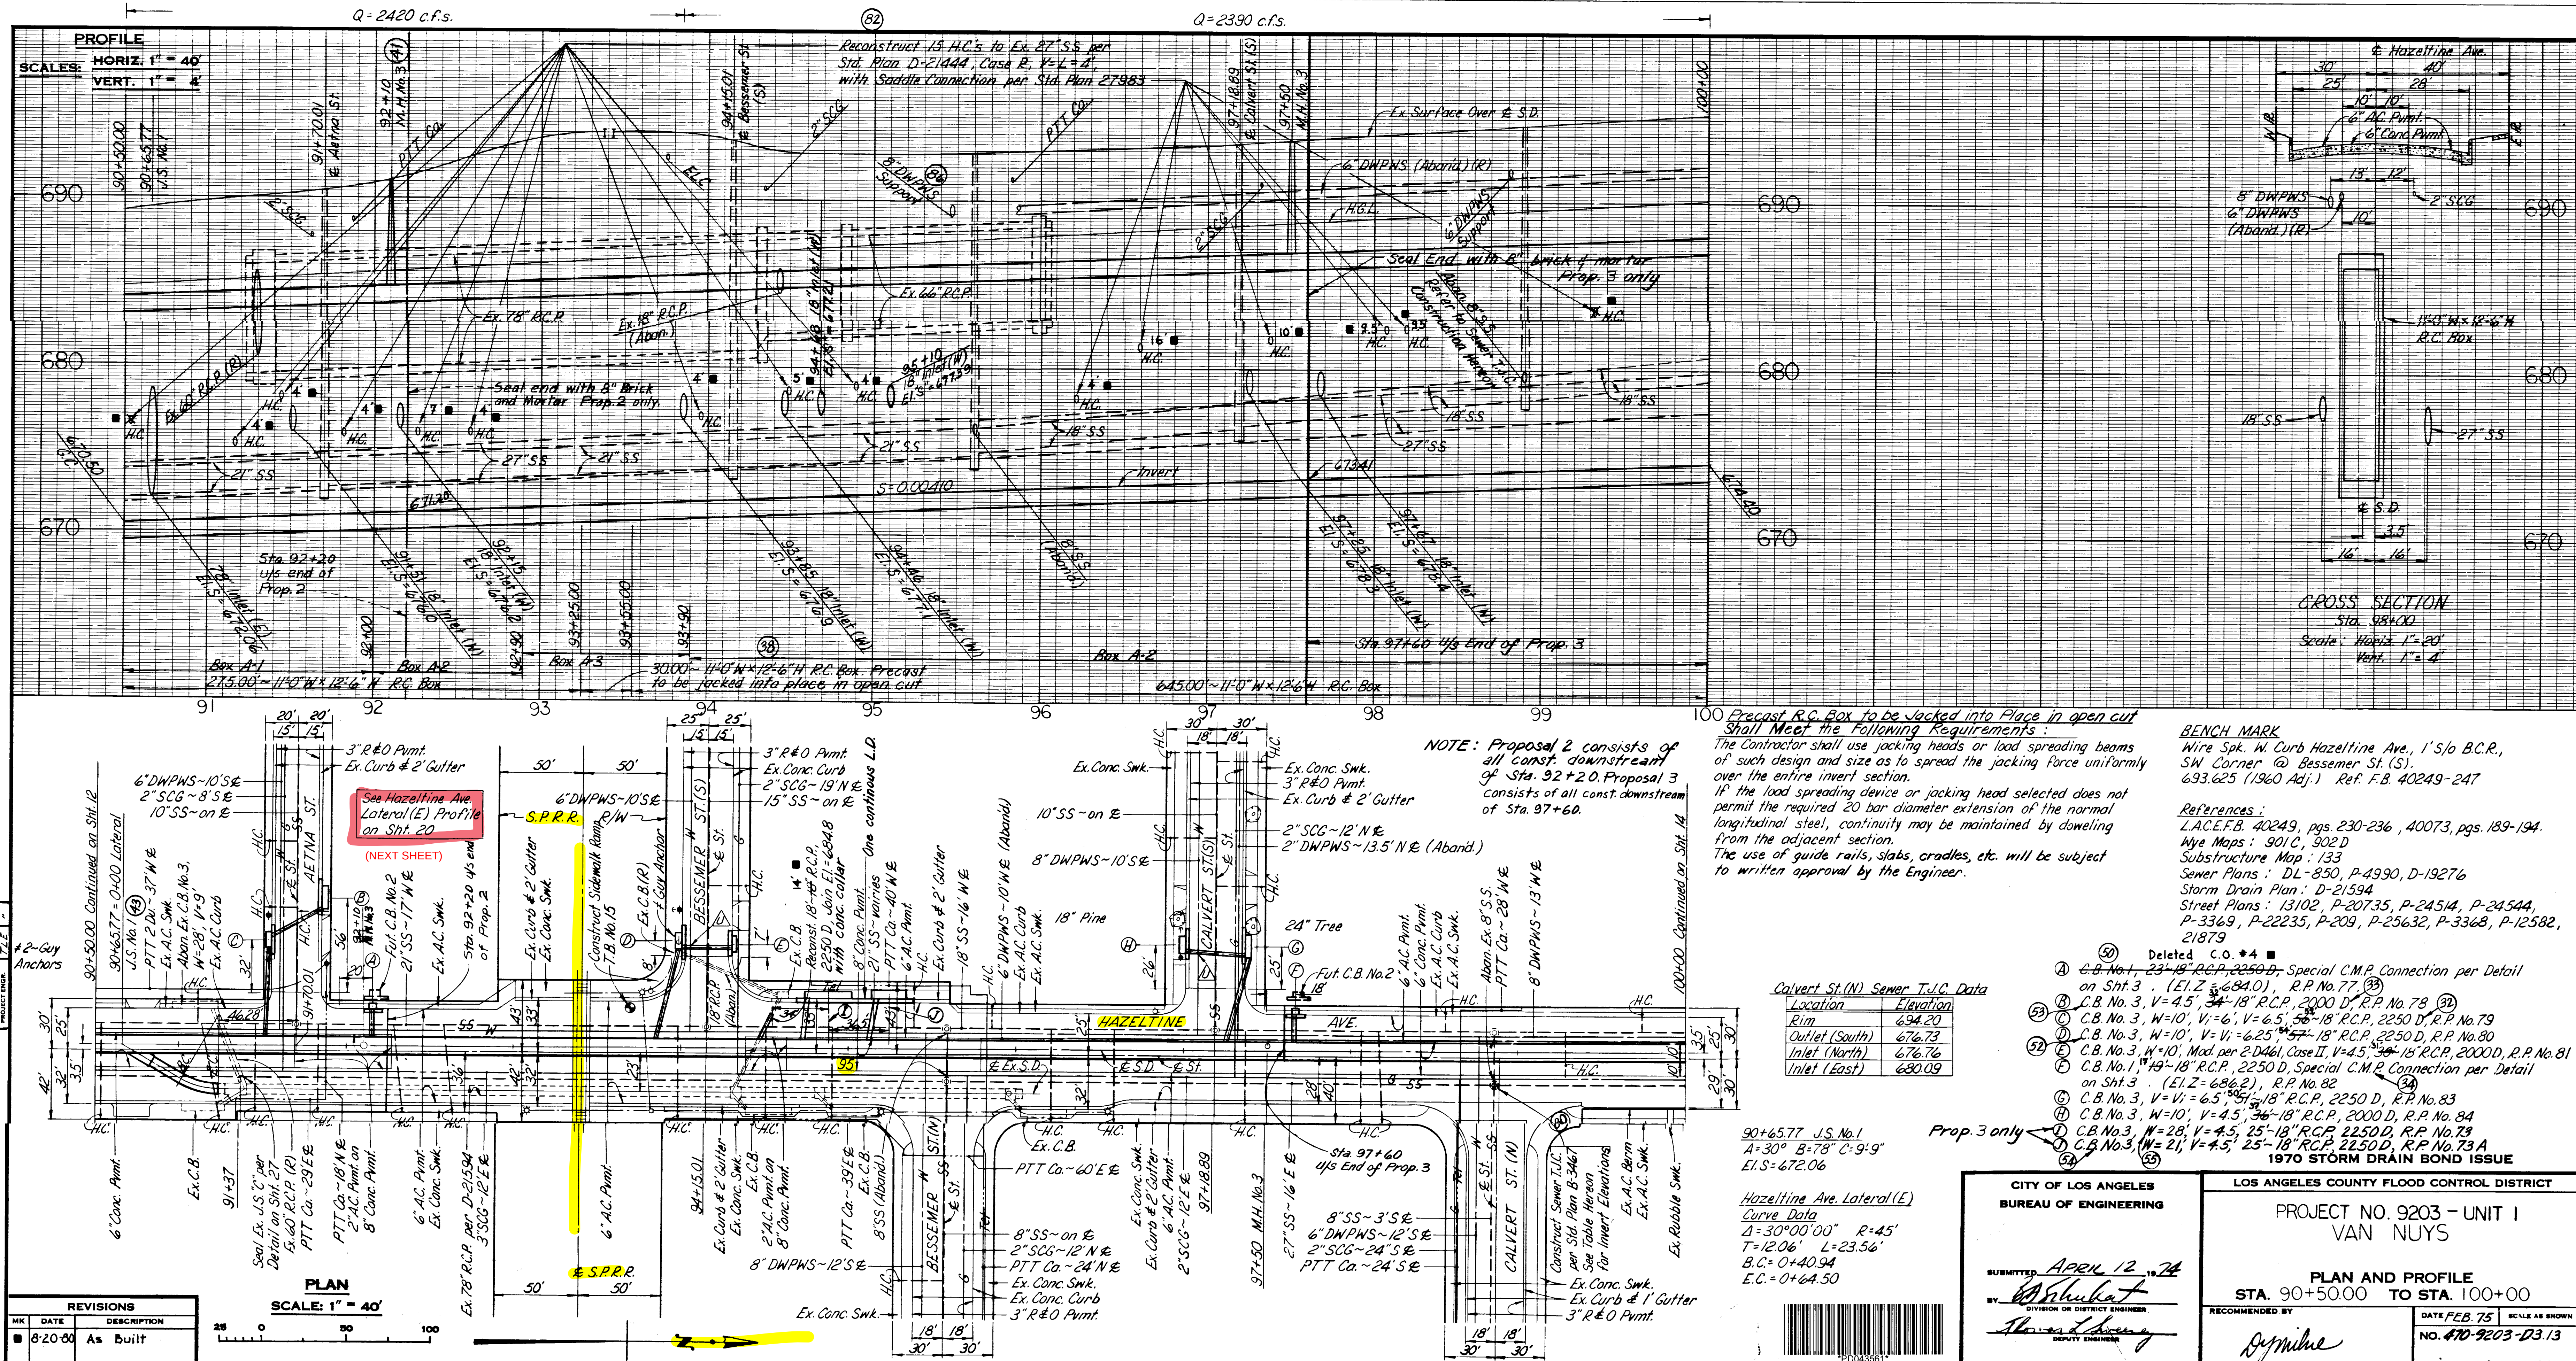

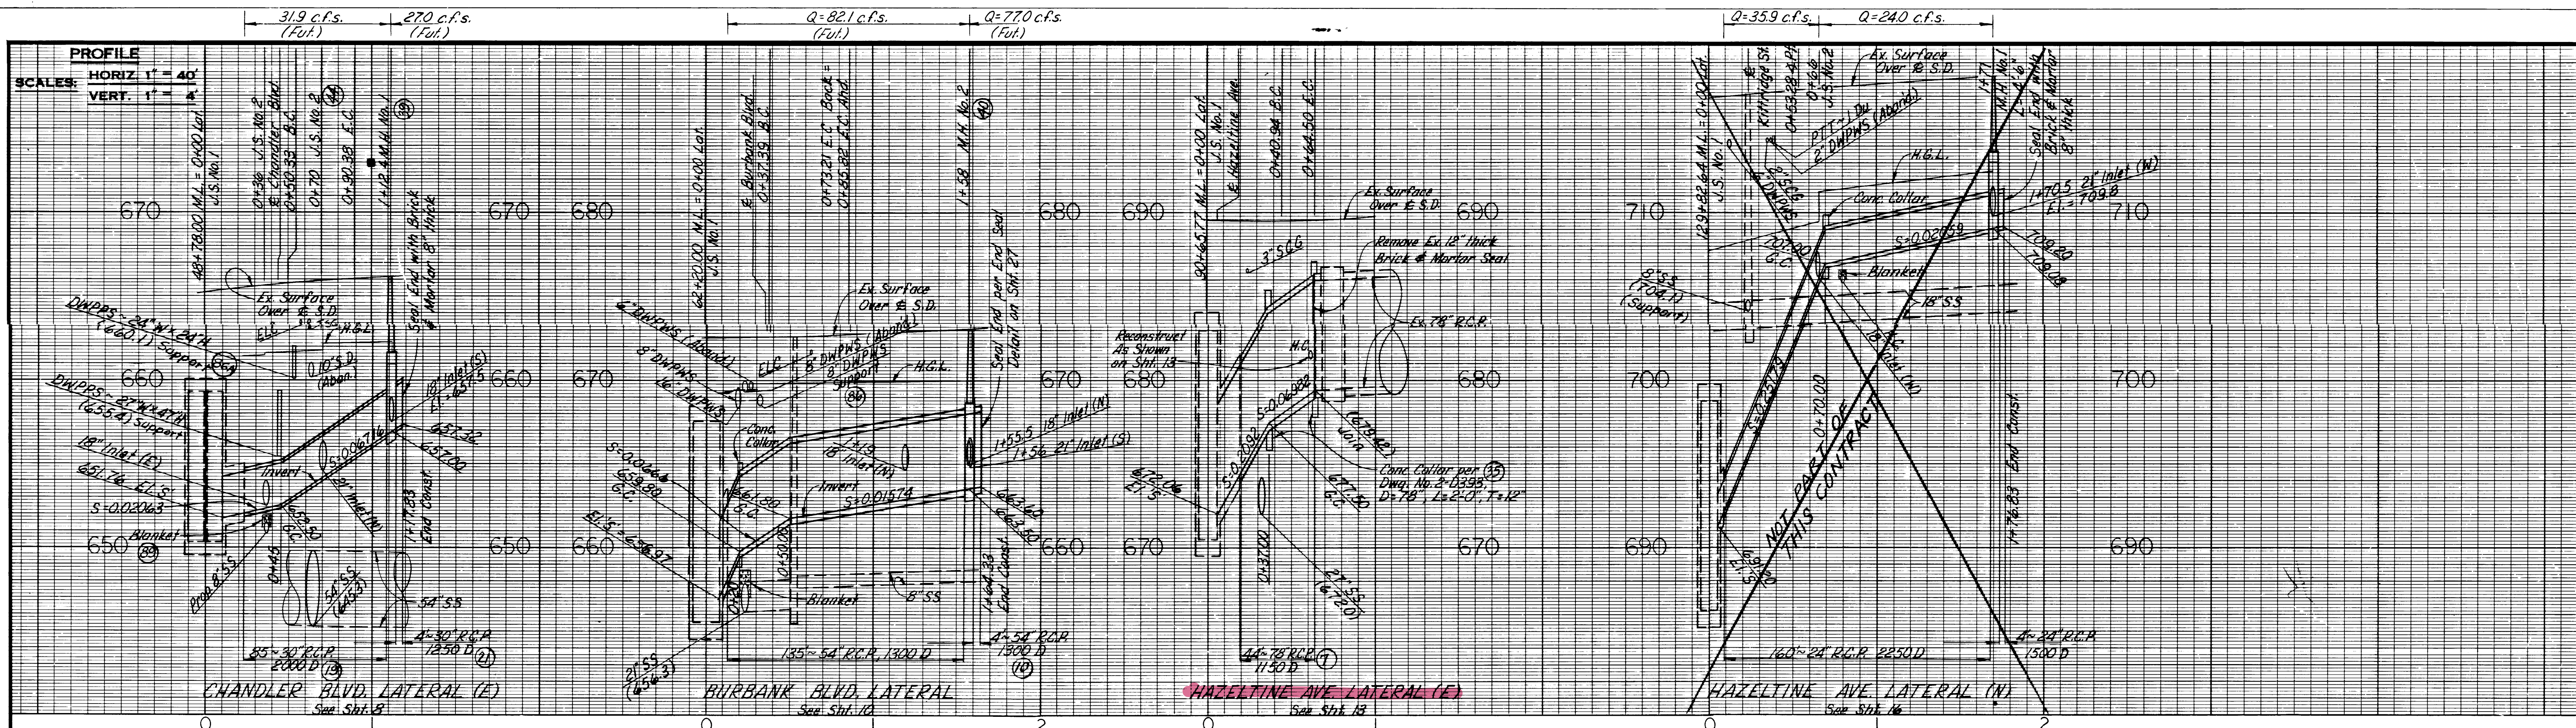

INITIAL DATE	REV	DATE
DESIGNED BY	REV	DATE
DRAWN BY	REV	DATE
CHECKED BY	REV	DATE
PROJECT ENGINEER	REV	DATE

REVISIONS		
NO.	DATE	DESCRIPTION
1	8-21-80	As Built

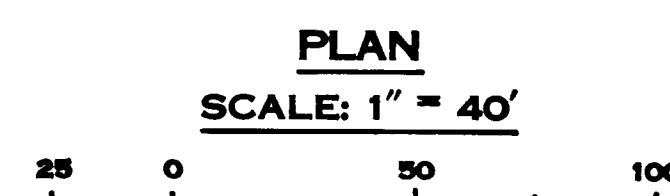

1970 STORM DRAIN BOND ISSUE

CITY OF LOS ANGELES BUREAU OF ENGINEERING	LOS ANGELES COUNTY FLOOD CONTROL DISTRICT	
	PROJECT NO. 9203 - UNIT I VAN NUYS PROFILES OF LATERALS	
SUBMITTED: APR 12, 1974 BY: [Signature] DIVISION OR DISTRICT ENGINEER	RECOMMENDED BY: [Signature] DIVISION ENGINEER (DESIGN)	DATE: FEB. 75 NO. 470-9203-D320 SHEET 20 OF 30

"AS BUILT" DRAWING