



** CIDH PILE Foundation per Caltrans Latest Standard Plans.



1. SEMI-ACTUATED OPERATION (ATSAC 2070 CONTROLLER WITH
TIMING PRIORITY IN 332 CABINET)
- 01 - TIMING ONLY
- 02 - HAZELTINE AVE SB & W/S PED XING AT BESSEMER ST
- 03 - BESSEMER ST EB W/ST & LT (EXCLUSIVE)
- 04 - BUSWAY WB & N/S PED XING
- 06 - HAZELTINE AVE NB, W/S & E/S PED XINGS AT BUSWAY
- 08 - BUSWAY EB
- 0LA - (01, 02, & 03) HAZELTINE AVE SB AT BUSWAY
- 0LB - (06) HAZELTINE AVE NB AT BESSEMER ST
- 0LC - (01) HAZELTINE AVE NB LT AT BESSEMER ST
- VICTORY CORRIDOR EAST ATSAC SYSTEM
- DIRECT WIRE (CABLE) INTERCONNECT
-  6.00

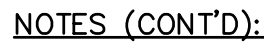

3. INSTALL ATSC 2070 CONTROLLER IN 332 CABINET. THE CONTRACTOR SHALL PROVIDE A COMPLETE FUNCTIONING CONTROLLER ASSEMBLY AND CABINET CONFORMING TO THE LATEST LADOT SPECIFICATION FOR 2070 CONTROLLER. CONTRACTOR TO DELIVER COMPLETELY ASSEMBLED CONTROLLER FOR TESTING TO THE DEPARTMENT OF TRANSPORTATION GENERAL SHOP, PIPER TECHNICAL CENTER, 555 RAMIREZ STREET THIRTY (30) DAYS PRIOR TO INSTALLATION. CONTRACTOR TO PICK UP AND INSTALL CONTROLLER ASSEMBLY ON F-332 FOUNDATION. INSTALL TRANSIT PRIORITY SENSOR UNITS IN THE NEW 332 CABINET.
4. INSTALL TWO-INCH (2") RISER ON 2 O'CLOCK POSITION OF SERVICE POLE No. SP35760K. INSTALL SERVICE PER LADOT STD. DWG. No. S-79.8. INSTALL 2 #6 SERVICE WIRES AND 60 AMP FUSE IN AN IN-LINE WATERPROOF FUSEHOLDER IN THE PULLBOX. WORK ON ANY ELECTRICAL SERVICE EQUIPMENT TO BE DONE ONLY IN CONJUNCTION WITH THE DWP PERSONNEL. CONTACT DWP AT (213) 367-3003 SEVEN (7) WORKING DAYS PRIOR TO INSTALLATION OF SERVICE LINE.
5. CONTRACTOR SHALL PROVIDE AND INSTALL LARGE STREET NAME SIGNS PER LADOT STD. DWGS. No. S-457.0 & S-486.0.
6. THIS LOOP CONNECTED TO CONTROLLER AT OXNARD ST.
7. INTERCEPT CONDUIT AND INSTALL PULL BOX AS SHOWN.
8. MOUNT PV HEAD AT 14' HEIGHT.
9. REMOVE R1 & LIMIT LINE AT BESSEMER ST. UPON ACTIVATION OF THE SIGNAL.
10. INSTALL & ALIGN LOUVERED INDICATIONS FOR BICYCLISTS AS DIRECTED BY TRAFFIC SIGNAL INSPECTOR.
11. INSTALL STRIPING, SIGNS AND PAVEMENT MARKINGS PER LADOT DWG. No. A-3934 FOR THIS PROJECT. REMOVE ALL CONFLICTING STRIPING AND PAVEMENT MARKINGS.
12. SEE STREET LIGHTING SHEET FOR WORK ON STREET LIGHTING FACILITIES.
13. INSTALL TRANSIT PRIORITY LOOPS PER LADOT STD. DWG. No. S-70.1F AND VEHICLE LOOPS PER STD. DWG No. S-70.1A.
14. ALL NEW VEHICLE AND PEDESTRIAN TRAFFIC SIGNALS SHALL BE LED MODULES, PER LADOT SPECIFICATION 92-088-03 (LATEST EDITION).

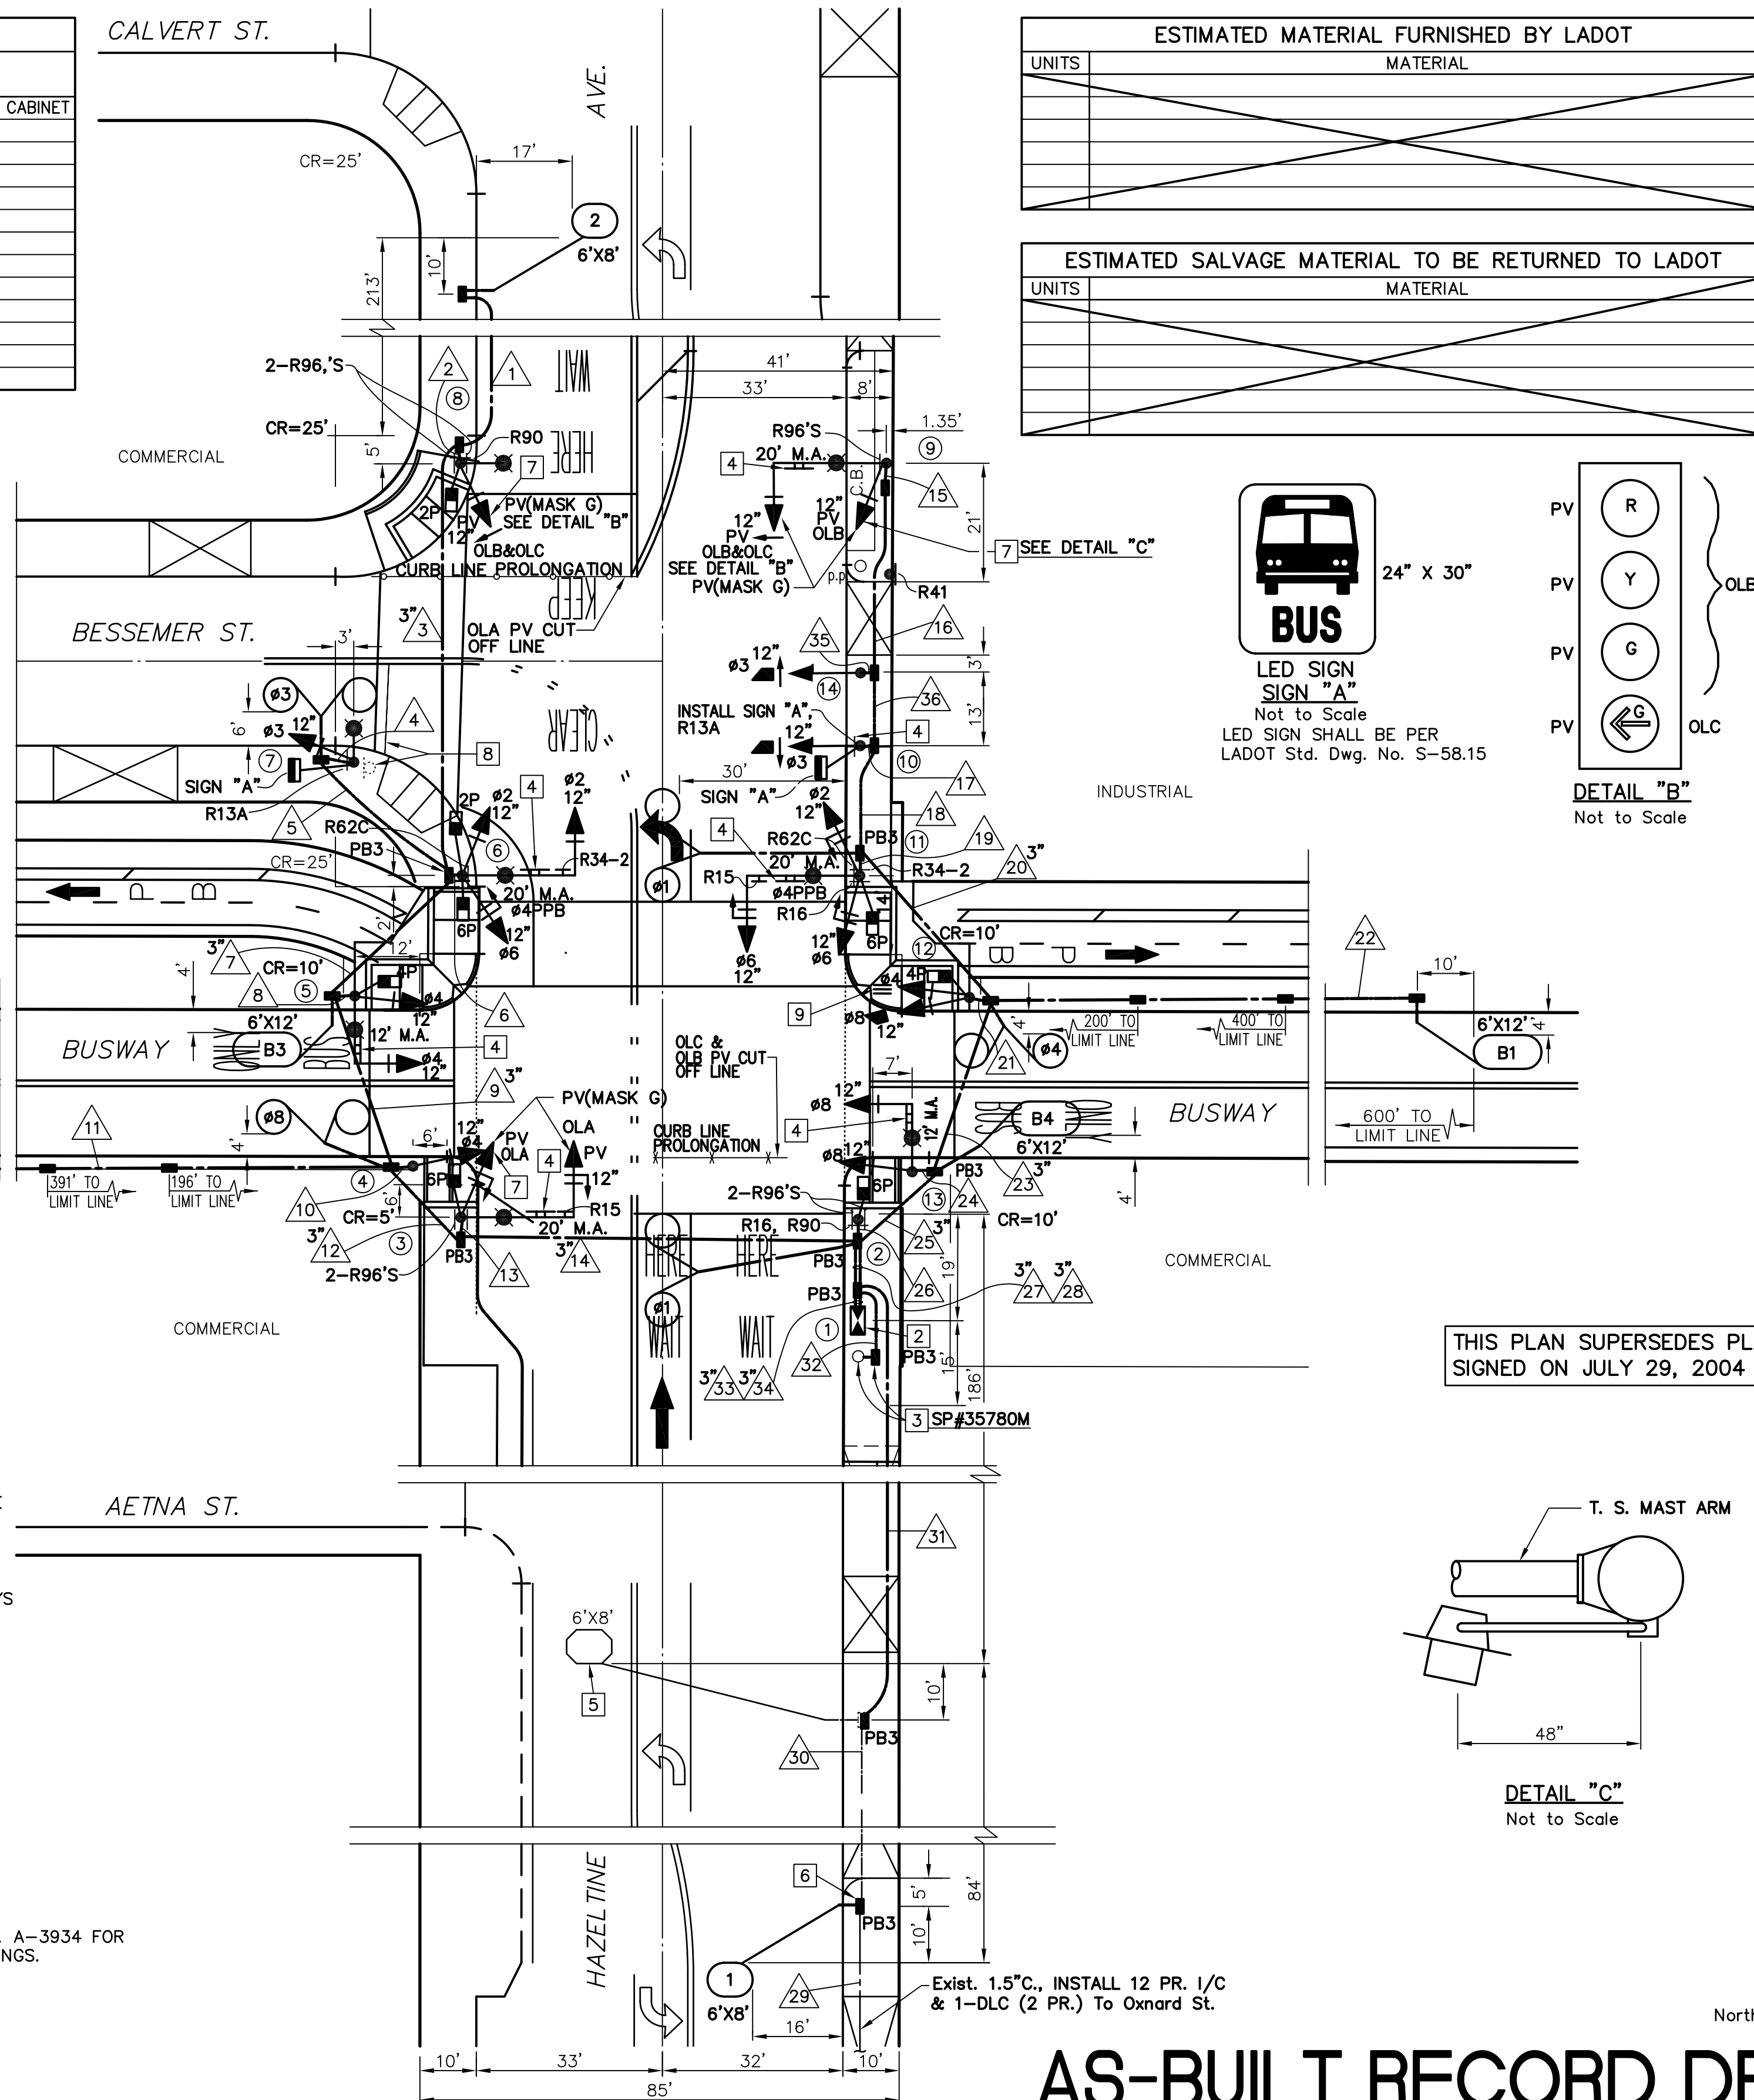[illegible]

NOTICE TO CONTRACTOR

1. EXCEPT WHERE OTHERWISE INDICATED, MATERIALS AND INSTALLATION METHODS SHALL CONFORM TO THE LATEST EDITION, WITH SUPPLEMENTS, OF THE STANDARD SPECIFICATION FOR PUBLIC WORKS CONSTRUCTION, ADOPTED BY THE CITY OF LOS ANGELES BOARD OF PUBLIC WORKS (LBPW), INCLUDING THE LATEST VERSION OF STANDARD PLANS S-610 SPECIFIED BY THE LBPW, AND THE LATEST EDITION, WITH SUPPLEMENTS, OF THE STANDARD SPECIFICATIONS AND STANDARD DRAWINGS FOR THE INSTALLATION AND MODIFICATION OF TRAFFIC SIGNALS, ISSUED BY THE CITY OF LOS ANGELES DEPARTMENT OF TRANSPORTATION (LADOT).
2. THE LADOT TRAFFIC SIGNAL INSPECTOR SHALL BE NOTIFIED AT (213) 792-7637. THE SENIOR MAINTENANCE SUPERVISOR AT (818) 756-7845, AND THE LADOT METRO RAIL ENGINEER AT (213) 485-2610 THREE (3) WORKING DAYS PRIOR TO THE BEGINNING OF CONSTRUCTION.
3. NORMAL TRAFFIC CONTROL SHALL BE MAINTAINED FROM 6:00 A.M. TO 9:00 A.M. AND 3:00 P.M. TO 7:00 P.M. ON WEEKDAYS. HOURS AND DURATION WHEN TRAFFIC SIGNALS ARE DEACTIVATED AND/OR PLACED INTO FLASHING OPERATION REQUIRE THE PRIOR APPROVAL OF THE LADOT METRO RAIL ENGINEER. TRAFFIC SIGNAL DEACTIVATION AND/OR FLASHING OPERATION SHALL BE IMPLEMENTED BY THE LADOT TRAFFIC SIGNAL ELECTRICIAN IN COORDINATION WITH THE ATSC CONTROL CENTER, AND SHALL BE REQUESTED THREE (3) WORKING DAYS IN ADVANCE THROUGH THE LADOT METRO RAIL ENGINEER, (213) 485-2610. FULL RESTORATION OF THE ATSC SYSTEM MUST OCCUR WITHIN FIVE (5) WORKING DAYS AFTER DEACTIVATION.
4. THE CONTRACTOR SHALL COORDINATE WITH THE LADOT SIGNAL SHOP AT (213) 847-2944 TO ARRANGE CONTROLLER DELIVERY. THE CONTRACTOR SHALL PROVIDE AND DELIVER A COMPLETE FUNCTIONING CONTROLLER ASSEMBLY AND CABINET TO THE LADOT SIGNAL SHOP THIRTY (30) CALENDAR DAYS PRIOR TO THE INSTALLATION DATE, AND PICK UP THE CONTROLLER WITHIN FIFTEEN (15) CALENDAR DAYS AFTER NOTIFICATION BY LADOT SIGNAL SHOP.
5. ALL REMOVED TRAFFIC SIGNAL EQUIPMENT IDENTIFIED AS SALVAGED MATERIAL SHALL BE RETURNED TO LADOT. ARRANGEMENTS FOR RETURNING IDENTIFIED EQUIPMENT TO LADOT SHALL BE MADE FIVE (5) WORKING DAYS IN ADVANCE BY CONTACTING THE LADOT MATERIAL CONTROL DIVISION AT (213) 580-5477. THE CONTRACTOR SHALL OBTAIN A SALVAGE RECEIPT FROM LADOT AND FORWARD A COPY, SIGNED BY THE CONTRACTOR AND THE RECEIVING LADOT YARD TO LADOT METRO RAIL ENGINEER AT 205 S. BROADWAY, SUITE 300, L.A. CA 90012. ALL OTHER REMOVED SIGNAL EQUIPMENT SHALL BE RETAINED BY THE CONTRACTOR.
6. ALL EXISTING TRAFFIC CONTROL SIGNING SHALL BE MAINTAINED WITH STANDARD SIGN BRACKETS BY THE CONTRACTOR. EXCEPT WHERE OTHERWISE INDICATED, EXISTING LARGE STREET NAME SIGNS ON MAST ARM TYPE STANDARDS SHALL BE REMOVED FROM THE OVERCABLE LANE WITH THE MOST POSTION OF STANDARD DRAWING NO. S-457.0, WHEN CALLED OUT ON THE PLAN. CONTRACTOR SHALL FURNISH AND INSTALL LARGE STREET NAME SIGNS AND SIGN BRACKETS FOR INSTALLATION ON MAST ARM PER LADOT STD. DWG. NO. S-457.0. ANY TRAFFIC SIGNING DAMAGED OR LOST BY THE CONTRACTOR SHALL BE REPLACED AT THE CONTRACTOR'S EXPENSE.
7. THE CONTRACTOR SHALL FURNISH AND INSTALL, AS SHOWN ON THE PLANS, ALL TRAFFIC SIGNAL EQUIPMENT SUCH AS STANDARDS, MAST ARMS, SIGNAL HEADS, AND OTHER EQUIPMENT AS REQUIRED. ALL SUCH EQUIPMENT SHALL BE NEW. ALL SIGNAL EQUIPMENT SHALL BE INSTALLED IN ACCORDANCE WITH THE INSTALLATION OF TRAFFIC SIGNAL MANUAL. ALL VEHICLE HEAD EQUIPMENT SUPPLIED BY THE CONTRACTOR SHALL HAVE 1 1/2 INCH DIAMETER PIPE FIT MOUNTING HARDWARE, INCLUDING ALL TOP POST MOUNT HEADS. PED HEAD MODULE REPLACEMENTS SHOWN ON THE PLAN SHALL REQUIRE A COMPLETE INSTALLATION, INCLUDING NEW PED HEAD AND TERMINAL COMPARTMENT. LEFT TURN SIGNAL HEADS ON MAST ARMS WITH TWO OR MORE SIGNAL HEADS SHALL BE TOP MOUNTED.

MTA - SAN FERNANDO VALLEY RAPID BUS SYSTEM (NEW SIGNAL)

REVIEWED <u>January 24,</u> 20 <u>05</u> <u>Fna Van Der Laan</u> Transportation Engineer	RECOMMENDED <u>January 25,</u> 20 <u>05</u> <u>Fudy Wong</u> Senior Transportation Engineer	ACCEPTED <u>January 25,</u> 20 <u>05</u> <u>Thomas L. Jones</u> Principal Transportation Engineer
AS BUILT	CITY OF LOS ANGELES DEPARTMENT OF TRANSPORTATION WAYNE K. TANDA, GENERAL MANAGER	
Date of Installation: <u>11-18-05</u> LA DOT Inspector: <u>Algebra</u>	TITLE BESSEMER ST., HAZELTINE AVE. AND BUSWAY	
Condition As Of: <u>11-18-05</u> LA DOT Engineer: <u>J.P.</u>		
District EAST VALLEY Thomas Guide 532-B7		
References	File Name 32208-P1.DWG	Intersection No. 32208
	Project No. 74720	
NOTICE: IF PLAN HAS NOT BEEN IMPLEMENTED WITHIN TWO (2) YEARS OF THE ACCEPTANCE DATE, IT MUST BE RESUBMITTED TO LA DOT SIGNAL DESIGN SECTION FOR REVIEW AND APPROVAL.		

NORTH HOLLYWOOD TO WARNER CENTER
GROUP 3 INTERSECTIONS
NEW TRAFFIC SIGNAL
BESSEMER ST., HAZELTINE AVE.
AND BUSWAY

SEGMENT NO C-0675	
DRAWING NO G3TS-005	REV 3
SCALE 1" = 20'	
SHEET NO	



3	02-10-06	JFB					AS-BUILT RECORD DRAWING
2	01-17-05	JFB	WJO	52655	12/31/06	WALTER J. OKITSU	SERVICE RISER CHANGE - IFC
1	07-21-04	JFB	WJO	52655	12/31/06	WALTER J. OKITSU	SIGNAL POLE CHANGE - IFC
0	04-15-04	GXF	WJO	52655	12/31/06	WALTER J. OKITSU	ISSUED FOR CONSTRUCTION
REV	DATE	BY	APP	REG NO	EXPRES	SEAL HOLDER	DESCRIPTION

DESIGNED BY	G. FIGUEROA
DRAWN BY	J. BERNAL
CHECKED BY	D. YEH
IN CHARGE	W. OKITSU
DATE	04-15-04



LOS ANGELES COUNTY METROPOLITAN TRANSPORTATION AUTHORITY
SAN FERNANDO VALLEY EAST-WEST BRT PROJECT



 **Katz, Okitsu & Associates**
Traffic Engineers & Transportation Planners
1055 Corporate Center Drive, Suite 300
Monterey Park, California 91754-7642
Tel: (323) 260-4703 Fax: (323) 260-4705