


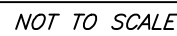

NOT TO SCALE



NEW MAIN AND CONSTRUCTION
PROCEDURES EXCEED STATE D.P.H.
REQUIREMENTS FOR SPECIAL PIPE AS
PER "CRITERIA FOR THE SEPARATION OF
WATER MAINS & SANITARY SEWERS"

USE VGX15 FOR
3" EQ. & SMALLER SERVICES
RENEWALS & RETAPS
IN CONJUNCTION WITH
6" MAINLINE / W.O.# VGX14

USE VGX16 FOR
4" & LARGER SERVICES
RENEWALS & RETAPS



DISTRICT: EAST VALLEY		MAX. STATIC PRESSURE: 209 (PSI)		SUBS		DRAWING COMPLETED		 CITY OF LOS ANGELES DEPARTMENT OF WATER AND POWER P.O. BOX 51111, LOS ANGELES, CALIFORNIA 90051 WATER DISTRIBUTION BUSINESS UNIT BREDNA LINDSEY - DIRECTOR	
S C O : 201710-4-06		CORROSION INDEX: MOD		☐ S.D. ☐ S.S. ☐ GAS ☐ TEL. ☐ F.W.R. ☐ T.V. ☐ WTR. ☐ OIL ☐ T.S. ☐ S.L. ☐ MISC.		DATE: <u>11-30-2017</u> DRAWN: <u>P. WEBB</u> CHECKED: <u>M. LAM</u> APPROVED: <u>M. DOWNS</u>		DESIGNED: P. WEBB PHONE: (213) 367-1242	
PERMIT APPL.: VAN NUYS		PROJECT: HAZELTINE AVE. N/O OXNARD		JOB COMPLETED DATE: _____ SUPV: _____ SUPT.: <u>J. COX</u>		HAZELTINE AVENUE WATER REPLACEMENT OXNARD ST. TO VICTORY BL.			
SERVICE NO.: _____		BACKFILL ☐ SAND ☐ NATIVE ☒ SLURRY		AS CONSTRUCTED DWG DATE: _____ DRAWN: _____ CHECKED: <u>E. KITCHING</u>		PIPE LOCATION REPORT:		SHEET 1 OF 4	
GATE SECTION: 181-152		SOIL TYPE: ML		COVER NOTED IN BOXES					
THOMAS GUIDE: PG. 532-B7		WORK ORDER(S): VGX13(ENGR); VGX14(8"); VGX15(SML SVCS); VGX16(LG SVCS)							
WATER SERVICE MAP(S): 176-153; 178-153; 180-153									

TRENCH WIDTH = 2 FT.	
EXCAVATION DATA	
ASPHALT	SQ. FT.
CONCRETE	SQ. FT.
DIRT	SQ. FT.
RESURFACING DATA	
ASPHALT	SQ. FT.
CONCRETE	SQ. FT.

FOR 3" EQ & SMALLER SERVICES, USE WORK ORDER
VGX15 FOR RENEWALS & RETAPS. APPROXIMATE
NUMBER OF SMALL SERVICES IS 30 (12 THIS SHT.).

VGX14 (BT) INSTALL: PIPE (CALVERT ST. WEST)

- 6' - 8" x 0.33" DI-A PW CL RG PIPE
1 - 8" CAST TRANS MECH CPLG (DI-DI)
- ABANDON:**
13' - 8" x 0.33" DI-A RG PIPE PLR#108030(2013)
1 - 8" x 250# DI-A FLG GATE VALVE (#616)
1 - 8" HE GATE VALVE (#292-SHUT)

VGX14 (BT) INSTALL F-53095

- 1 - 6" x 6" DI-A TEE (B-B-F)
1 - 6" x 250# DI-A FLG GATE VALVE (#284)
1 - 6" DI-A FLG/BELL ADAPTOR
13' - 6" x 0.31" DI-A PW CL RG PIPE
1 - 2-1/2" x 4" DOUBLE FIRE HYDRANT ASSY
- VFE05
REMOVE F-53095**
1 - 2-1/2" x 4" DFH CLOW
1 - 6" RG GATE VALVE (#284) PLR#102530('95)

VGX16 RE-ESTABLISH 4" FIRE SERVICE (#577872)

- 1 - 8" x 4" DI-A RG TEE (B-B-B)
1 - 4" x 0.29" x 18" L DI-A PW CL RG NIPPLE
1 - 4" x 250# DI-A RG GATE VALVE (#590)
2 - 4" x 45" DI-A RG BEND (B-B)
1 - 4" CAST TRANS. MECHANICAL COUPLING
12' - 4" x 0.29" DI-A PW CL RG PIPE
- REMOVE: 4" SERVICE TAP**
1 - 8" x 4" DI FLANGED CLAMP
1 - 4" x 250# DI-A FLG GATE VALVE (#590)
PLR#105381(2006)

VGX14 (BT) INSTALL F-53094

- 1 - 8" x 6" DI-A TEE (B-B-F)
1 - 6" x 250# DI-A FLG GATE VALVE (#283)
1 - 6" DI-A FLG/BELL ADAPTOR
14' - 6" x 0.31" DI-A PW CL RG PIPE
1 - 2-1/2" x 4" DOUBLE FIRE HYDRANT ASSY
- VFE05
REMOVE F-53094**
1 - 2-1/2" x 4" DFH CLOW
1 - 6" RG GATE VALVE (#283) PLR#102530('95)

VGX14 (BT) INSTALL: PIPE (BESSEMER ST. EAST)

- 12' - 8" x 0.33" DI-A PW CL RG PIPE
1 - 8" x 250# DI-A RG GATE VALVE (#288)
2 - 8" x 45" DI-A RG BEND (B-B)
1 - 8" CAST TRANS MECH CPLG (DI-CI)
- ABANDON:**
5' - 8" CI PIPE PLR#38354('31)
1 - 6" HE GATE VALVE (#288)

NOTE:
*- COVER FOR EX. 21" & 18" CONC. ENC. SAN. SEWER
IN HAZELTINE (16' W/E) IS APPROXIMATELY 10' TO 13'.
**-COVER FOR EX. 10.5'-11'W x 12'H RCB S.D. IN
HAZELTINE (3.5' W/E) IS APPROXIMATELY 5' TO 13'.

VGX14 (BT) INSTALL: PIPE (BESSEMER ST. WEST)

- 6' - 6" x 0.31" DI-A PW CL RG PIPE
1 - 6" CAST TRANS MECH CPLG (DI-DI)
- ABANDON:**
13' - 6" x 0.31" DI-A RG PIPE PLR#108030(2013)
1 - 6" x 250# DI-A FLG GATE VALVE (#622)
1 - 6" HE GATE VALVE (#287-SHUT)

NOTES:
(1) INSTALL 8 MIL CLEAR POLYETHYLENE WRAP ON ALL D.I. & C.I. PIPE & FITTINGS.
(2) USE TBS-CLSM PER BROWN BOOK SECTION 201-6 FOR TRENCH BACKFILL.
(3) ALL VALVES ARE TO BE TAGGED UPON INSTALLATION.
(4) TRENCHING, BACKFILL AND PAVING TO BE PERFORMED PER STANDARD PLAN S-477.
SLURRY TO PLACED TO BOTTOM OF FINAL PAVING - EXEMPTION FROM S-477.
(5) CENTERLINE DIMENSIONS ARE SHOWN FOR INFORMATIONAL PURPOSES ONLY AND
ARE NOT TO BE RELIED UPON FOR EXACT LOCATIONS OF UNDERGROUND UTILITIES
OR SUBSTRUCTURES.

VGX14 (BT) INSTALL: PIPE (HAZELTINE AVE.)


- 781' - 8" x 0.33" DI-A PW CL RG PIPE
5 - 8" x 250# DI-A RG GATE VALVE (GV #'s 426, 325, 326, 289 & 282)
5 - 8" x 0.33" x 18" LONG DI-A NIPPLE
4 - 8" x 45" DI-A RG BEND (B-B)
8 - 8" x 18" DI-A RG LS OFFSET (B-S)
2 - 8" x 8" DI-A RG TEE (B-B-B)
2 - 8" x 6" DI-A RG TEE (B-B-B)
1 - 8" CAST TRANS MECH CPLG (DI-CI)
- ABANDON:**
783' - 8" C.I. PIPE PLR#37857('29)
4 - 8" x 200# HE GATE VALVE (GV#'s 426, 325, 326 & 289) PLR#104918(2003);
PLR#104949(2003)
1 - 6" HE GATE VALVE (GV#282)
PLR#102530('95)
1 - 1" A.V. (GV#334) PLR#104918(2003)

VGX14 (BT) INSTALL F-52785

- 1 - 6" x 6" DI-A TEE (B-B-F)
1 - 6" x 250# DI-A FLG GATE VALVE (#385)
1 - 6" DI-A FLG/BELL ADAPTOR
5' - 6" x 0.31" DI-A PW CL RG PIPE
1 - 2-1/2" x 4" DOUBLE FIRE HYDRANT ASSY


VFE05 REMOVE F-52785

- 1 - 2-1/2" x 4" DFH CLOW
1 - 6" RG GATE VALVE (#385) PLR#104949('03)

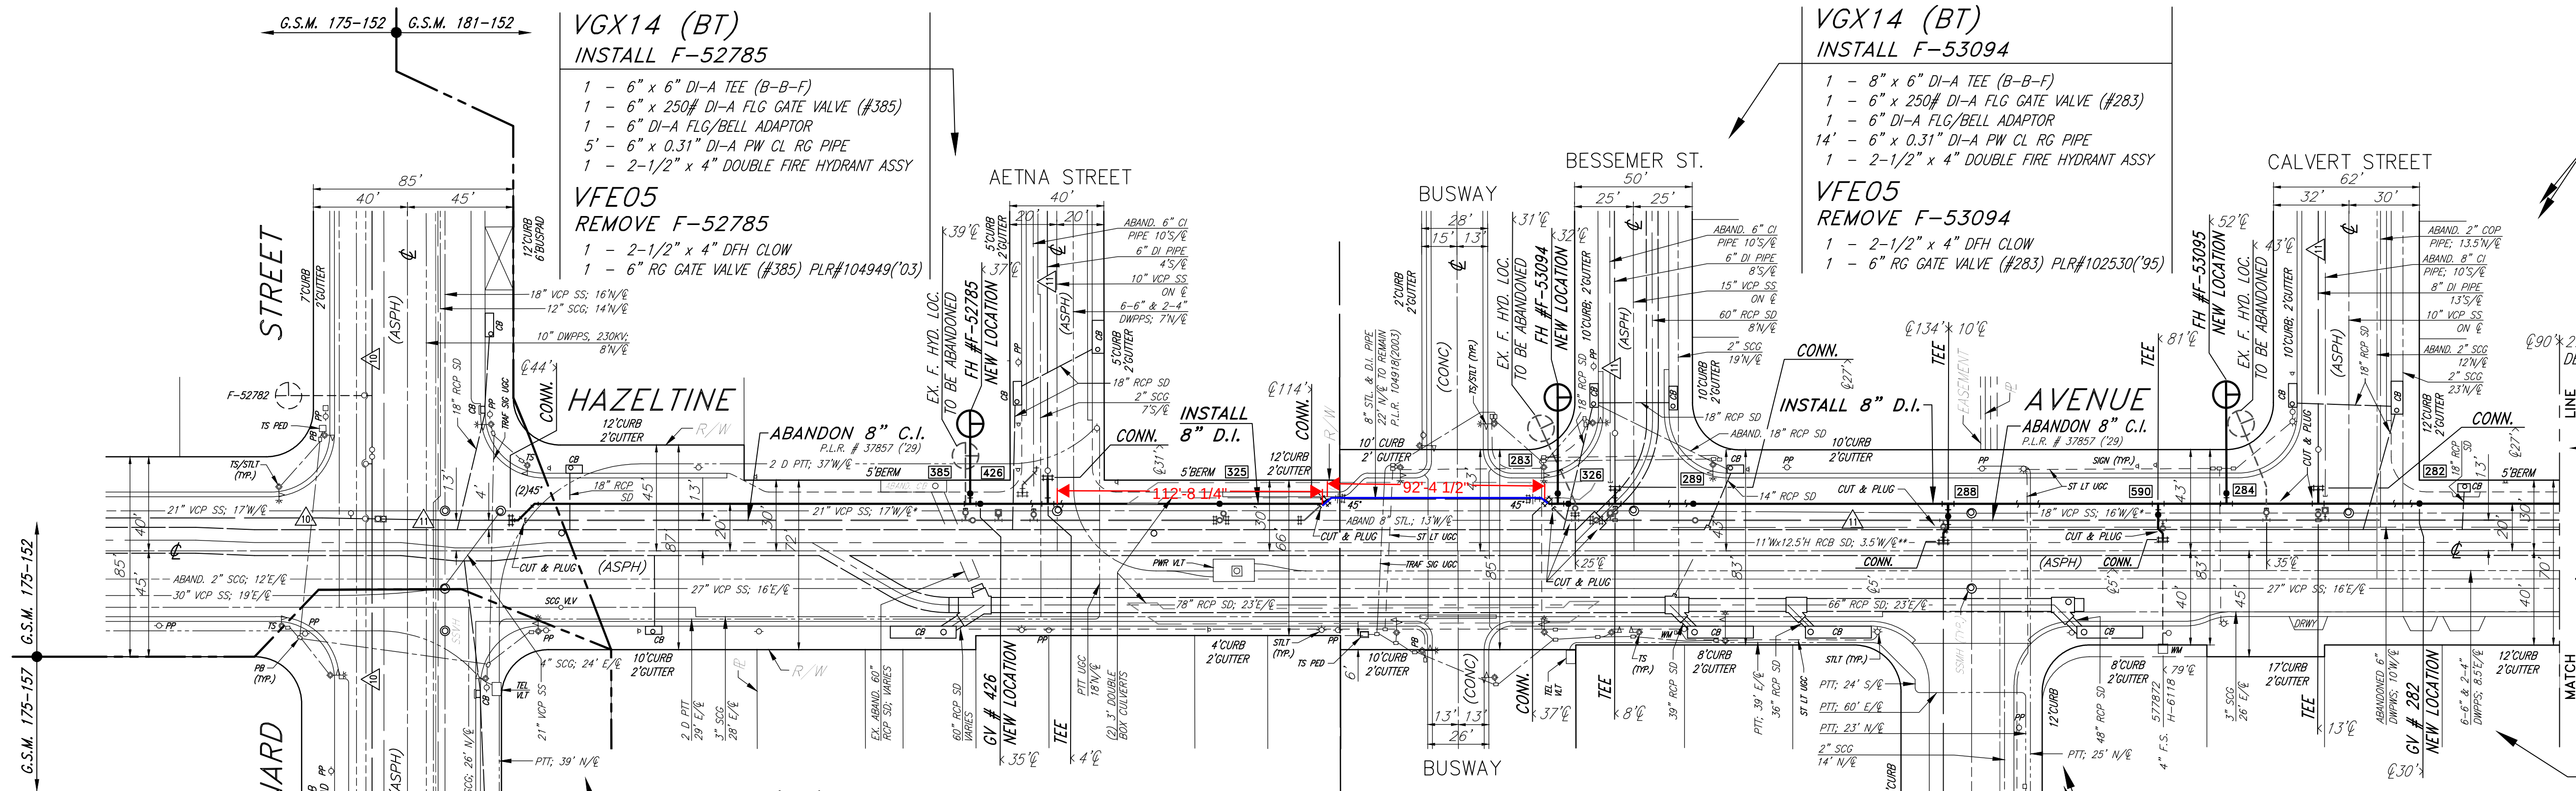

VGX14 (BT) INSTALL: PIPE (AETNA STREET)

- 11' - 6" x 0.31" DI-A PW CL RG PIPE
1 - 6" CAST TRANS MECH CPLG (DI-DI)
- ABANDON:**
18' - 6" CI PIPE PLR#37928('30)
1 - 6" HE GATE VALVE (GV#286)

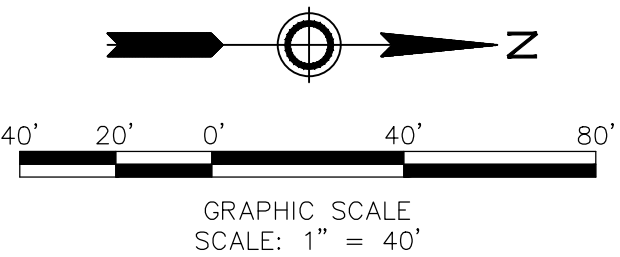

This mainline design was prepared with consideration of the need to save water.


DISTRICT: EAST VALLEY	MAX. STATIC PRESSURE: 209 (PSI)	SUBS: ☐ S.D. ☐ S.S. ☐ GAS ☐ TEL. ☐ PWR. ☐ T.V. ☐ WTR. ☐ OIL ☐ T.S. ☐ S.L. ☐ MISC.	DRAWING COMPLETED: DATE: 2-23-2018 DRAWN: P. WEBB CHECKED: M. LAM APPROVED: M. DOWNS	CITY OF LOS ANGELES DEPARTMENT OF WATER AND POWER P.O. BOX 51111, LOS ANGELES, CALIFORNIA 90051 WATER DISTRIBUTION BUSINESS UNIT BREAUNA LINDSEY - DIRECTOR DESIGNED: P. WEBB PHONE: (213) 367-1242
S C O : 201710-4-06	PERMIT APPL.: VAN NUYS	PROJECT: HAZELTINE AVE. N/O OXNARD	JOB COMPLETED: DATE: _____ SUPV.: _____ SUPT.: J. COX	
SERVICE NO.: 181-152	THOMAS GUIDE: PG. 532-B7	BACKFILL: ☐ SAND ☐ NATIVE ☒ SLURRY	AS CONSTRUCTED DWG	HAZELTINE AVENUE WATER REPLACEMENT OXNARD ST. TO CALVERT ST.
WATER SERVICE MAP(S): 176-153; 178-153; 180-153	SOIL TYPE: ML	WORK ORDER(S): VGX13(ENGR); VGX15(SML SVCS); VGX16(LG SVCS)	COVER NOTED IN BOXES	
SUB-133E, 180-153-3 WYE-177B153-NW			P-25632 CD#2,6 ZIP 91401	VGX14_Hazeltine-MLRP_Victory-Oxnard_Rev1.dwg

PLOT DATE: 2/23/2018 12:19 PM



VFE05
REMOVE F-53074
1 - 2-1/2" x 4" DFH CLOW
1 - 6" RG GATE VALVE (#123) PLR#102530('95)




ABANDON:
20' - 6" CI PIPE PLR#37965('30)
1 - 6" HE GATE VALVE (GV#295)

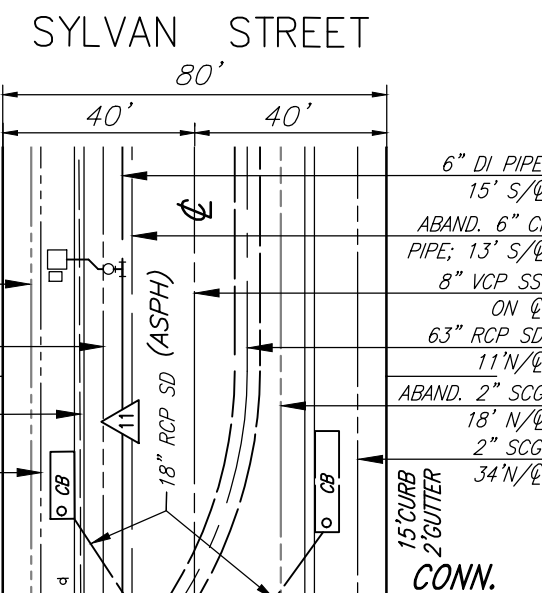

ABANDON:
10' - 6" x 0.31" DI-A RG PIPE PLR#10xxxxx(2018,
14' - 6" CI PIPE PLR#37995('30) & #92921('76)

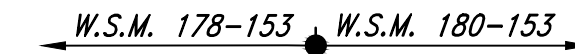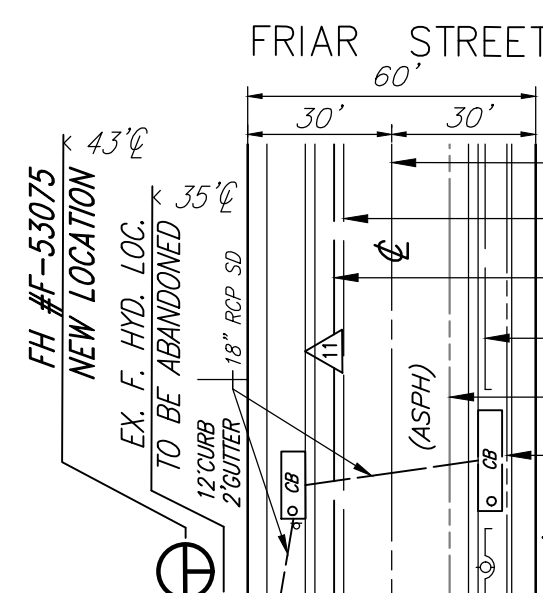

FOR 3" EQ & SMALLER SERVICES, USE WORK ORDER
VGX19 FOR RENEWALS & RETAPS. APPROXIMATE
NUMBER OF SMALL SERVICES IS 30 (9 THIS SHT.).

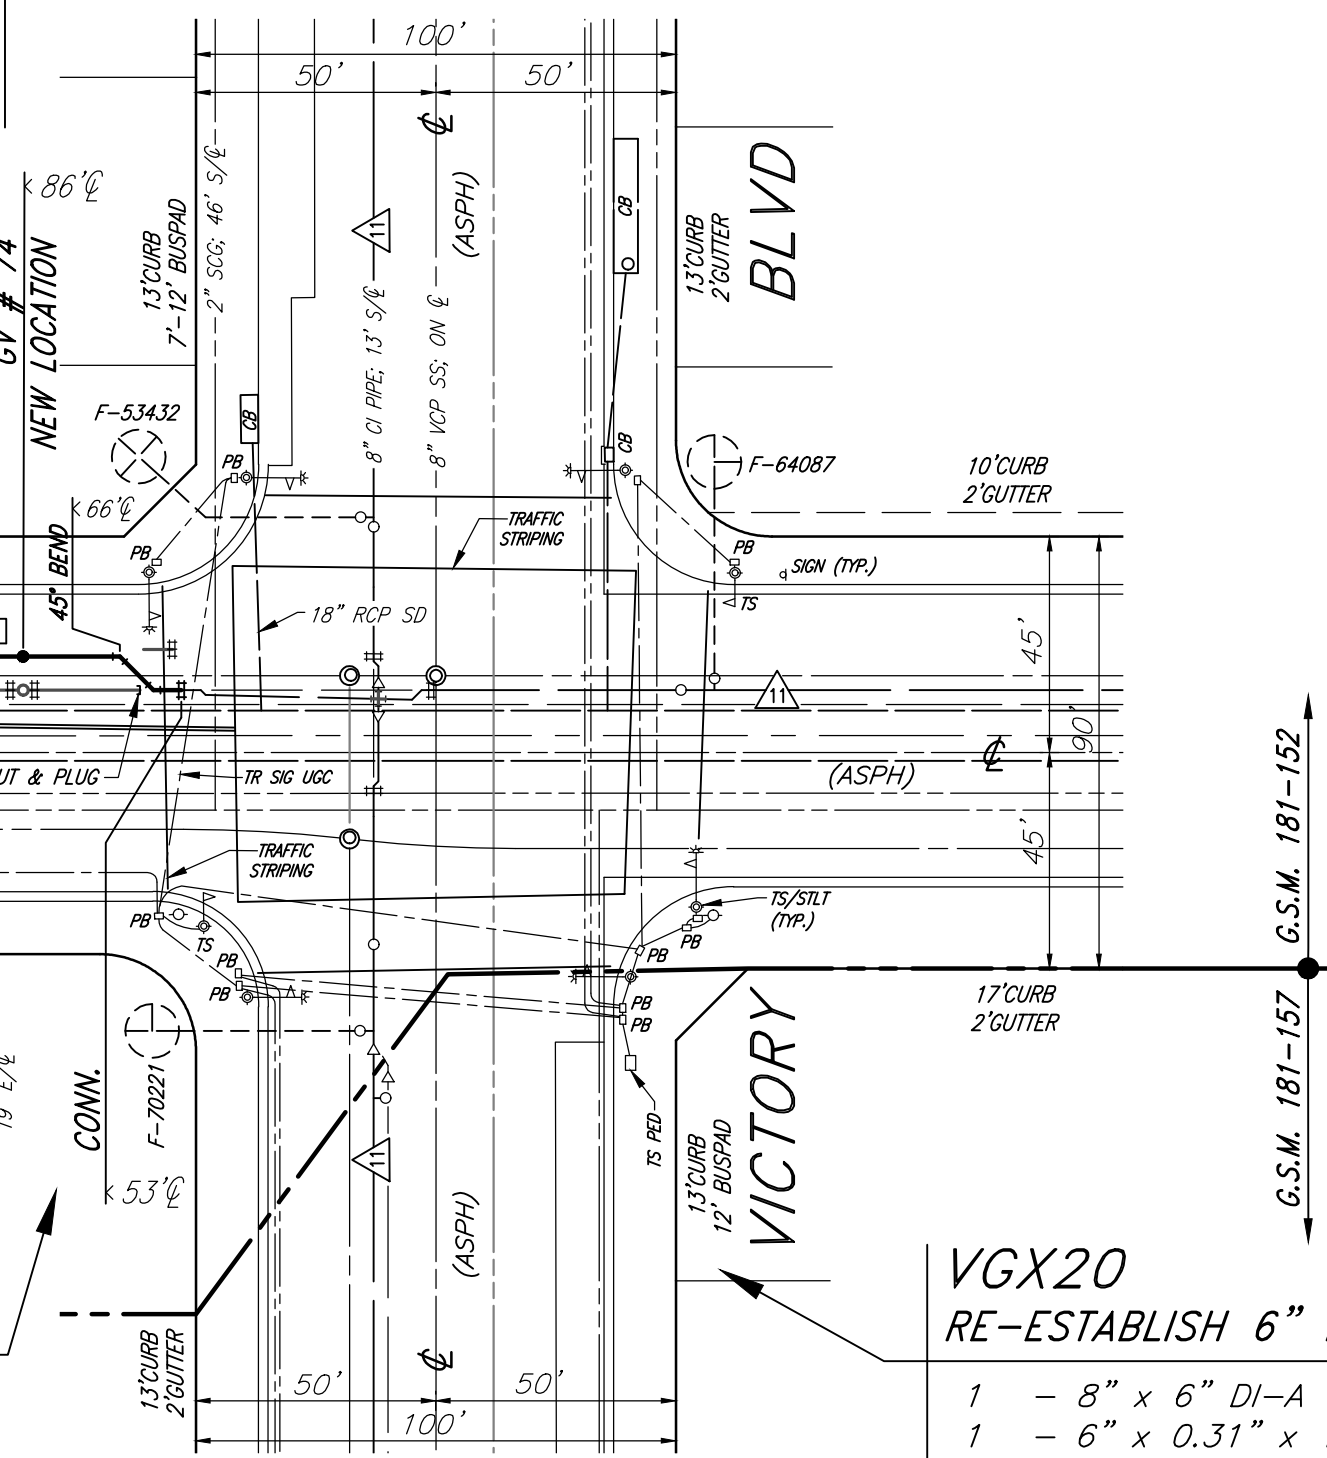


ABANDON:
5' - 6" CI PIPE PLR#39788('39)
1 - 6" HE GATE VALVE (#297) PLR#37857('29)

VFE05
REMOVE F-53075
1 - 2-1/2" x 4" DFH CLOW
1 - 6" RG GATE VALVE (#187) PLR#102530('95,

ABANDON:
843' - 8" C.I. PIPE PLR#37994('30); 102530('95)
2 - 8" HE GATE VALVE (GV#'s 291 & 74)
PLR#102530('95); 100653('91)

REMOVE: 6" SERVICE TAP

<i>1</i>	<i>- 8" x 6" DI FLANGED CLAMP</i>
<i>1</i>	<i>- 6" x 250# DI-A FLG GATE VALVE (#582)</i>

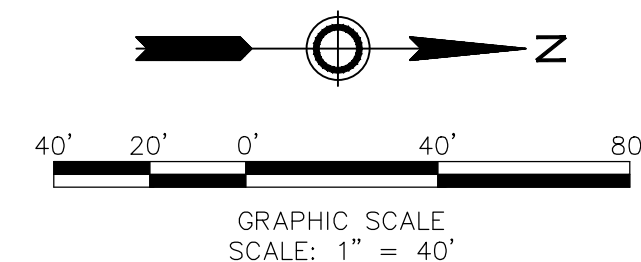

This mainline design was prepared with consideration of the need to save water.

SAVE WATER

NOTES:

- (1) INSTALL 8 MIL CLEAR POLYETHYLENE WRAP ON ALL D.I. & C.I. PIPE & FITTINGS.
- (2) USE TBS-CLSM PER BROWN BOOK SECTION 201-6 FOR TRENCH BACKFILL.
- (3) ALL VALVES ARE TO BE TAGGED UPON INSTALLATION.
- (4) TRENCHING, BACKFILL AND PAVING TO BE PERFORMED PER STANDARD PLAN S-477. SLURRY TO PLACED TO BOTTOM OF FINAL PAVING - EXEMPTION FROM S-477.
- (5) CENTERLINE DIMENSIONS ARE SHOWN FOR INFORMATIONAL PURPOSES ONLY AND ARE NOT TO BE RELIED UPON FOR EXACT LOCATIONS OF UNDERGROUND UTILITIES OR SUBSTRUCTURES.

NOTE:

*- COVER FOR EX. 21" & 18" CONC. ENC. SAN. SEWER
IN HAZELTINE (16' W/C) IS APPROXIMATELY 10' TO 13'.

**--COVER FOR EX. 10.5'-11'W x 12'H RCB S.D. IN HAZELTINE (3.5' W/C) IS APPROXIMATELY 5' TO 13'.

DISTRICT: EAST VALLEY S C O : 201710-4-06 PERMIT APPL.: VAN NUYS PROJECT: HAZELTINE AVE. N/o OXNARD SERVICE NO.: GATE SECTION: 181-152 THOMAS GUIDE: PG. 532-B7 WATER SERVICE MAP(S): 176-153; 178-153; 180-153 WORK ORDER(S): VGX14(ENGR); VGX14(8"); VGX15(SML SVCS); VGX16(LG SVCS)	MAX. STATIC PRESSURE: 209 (PSI) CORROSION INDEX: MOD BACKFILL: ☐ SAND ☐ NATIVE ☒ SLURRY SOIL TYPE: ML	SUBS: ☐ S.D. ☐ S.S. ☐ GAS ☐ TEL. ☐ PWR. ☐ T.V. ☐ WTR. ☐ OIL ☐ T.S. ☐ S.L. ☐ MISC.	DRAWING COMPLETED DATE: 2-23-2018 DRAWN: P. WEBB CHECKED: M. LAM APPROVED: M. DOWNS JOB COMPLETED DATE: _____ SUPV: _____ SUPT: J. COX AS CONSTRUCTED DWG DATE: _____ DRAWN: _____ CHECKED: E. KITCHING COVER NOTED IN BOXES	 CITY OF LOS ANGELES DEPARTMENT OF WATER AND POWER P.O. BOX 51111, LOS ANGELES, CALIFORNIA 90051 WATER DISTRIBUTION BUSINESS UNIT BREGINA LINDSEY - DIRECTOR DESIGNED: P. WEBB PHONE: (213) 367-1241 HAZELTINE AVENUE WATER REPLACEMENT SYLVAN ST. TO VICTORY BL. PIPE LOCATION REPORT: _____ SHEET 4 OF 4
---	---	---	---	--