


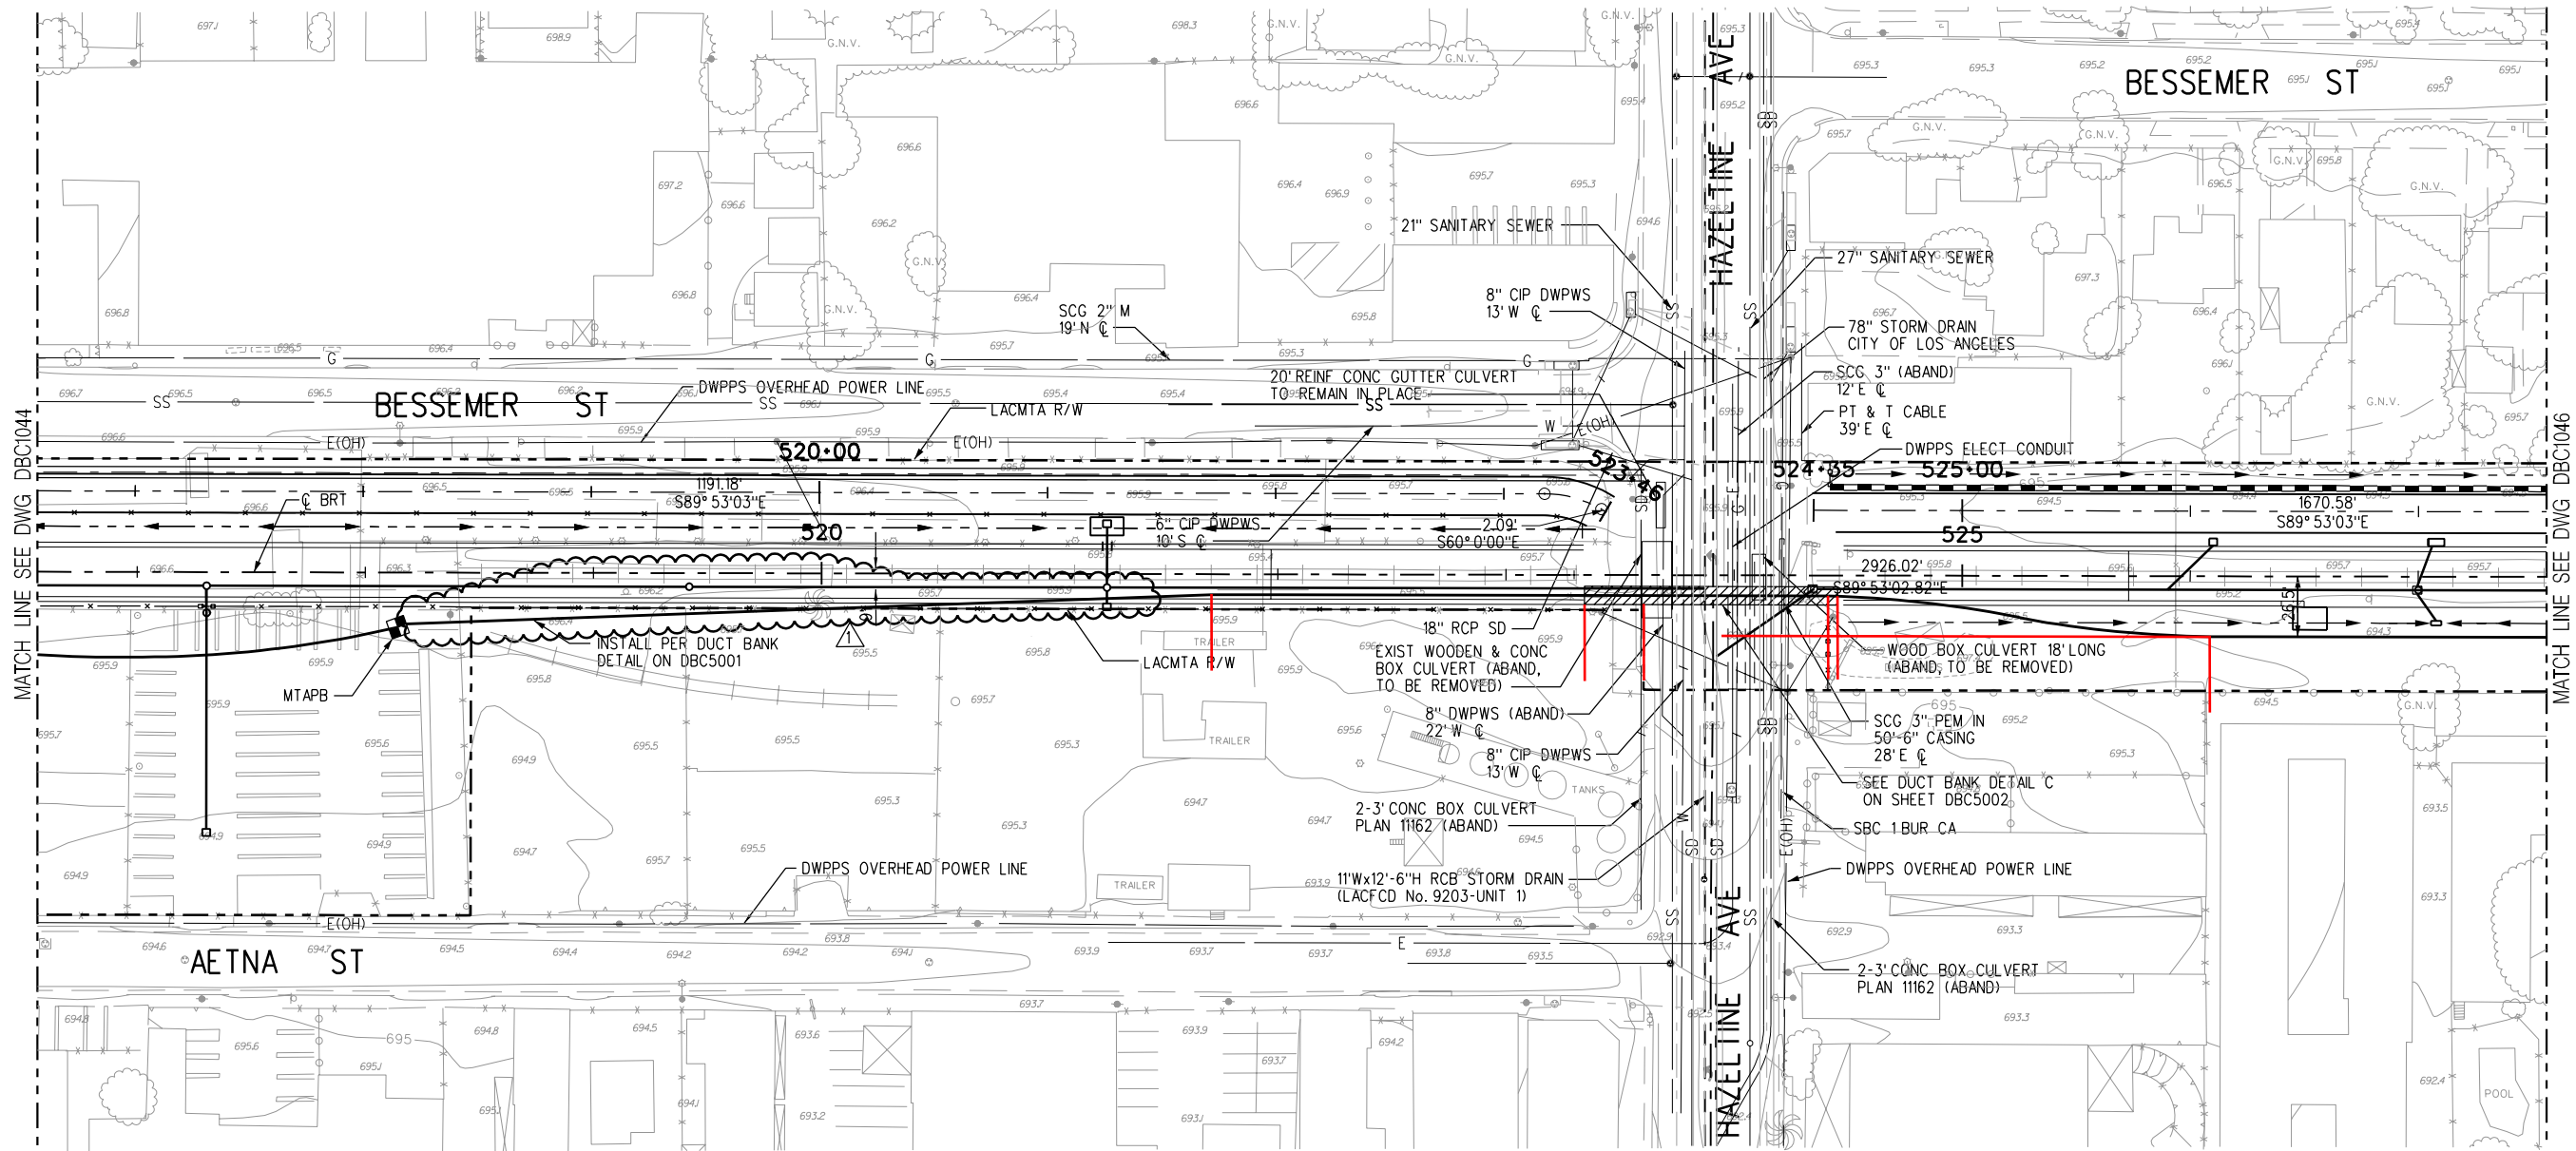


AS-BUILT RECORD DRAWING

REVIEWED AND APPROVED BY: 
GARRY J. JESS - PROJECT MANAGER
WASHINGTON GROUP INTERNATIONAL

REV	DATE	BY	APP	REG NO	EXPIRES	SEAL HOLDER	DESCRIPTION
1	11/23/05	AU	TG				AS-BUILT RECORD DRAWING
0	3/15/04	BEJ	AKJ	C42345	03/31/06	ARVIND K. JOSHI	IFC SEGMENT 2

DESIGNED BY
S. YOUSEFIAN
DRAWN BY
A. GOMEZ
CHECKED BY
P. ANTICH
IN CHARGE
B. JONES
DATE
11/12/03

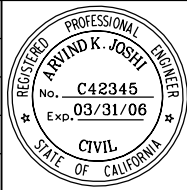

**LOS ANGELES COUNTY METROPOLITAN TRANSPORTATION AUTHORITY**
SAN FERNANDO VALLEY EAST-WEST BRT PROJECT

**Washington Group International**
WASHINGTON GROUP INTERNATIONAL, INC.
5805 SEPULVEDA BLVD., SUITE 500
VAN NUYS, CA 91411

**SHIMMICK
OBIYASHI, JV**
5805 SEPULVEDA BLVD., SUITE 500
VAN NUYS, CA 91411

NORTH HOLLYWOOD TO
WARNER CENTER
MAIN LINE DUCT BANK
STA 516+57 TO STA 527+57

CONTRACT NO	C0675
DRAWING NO	DBC1045
SCALE	HORIZ. 1"=40'
SHEET NO	1